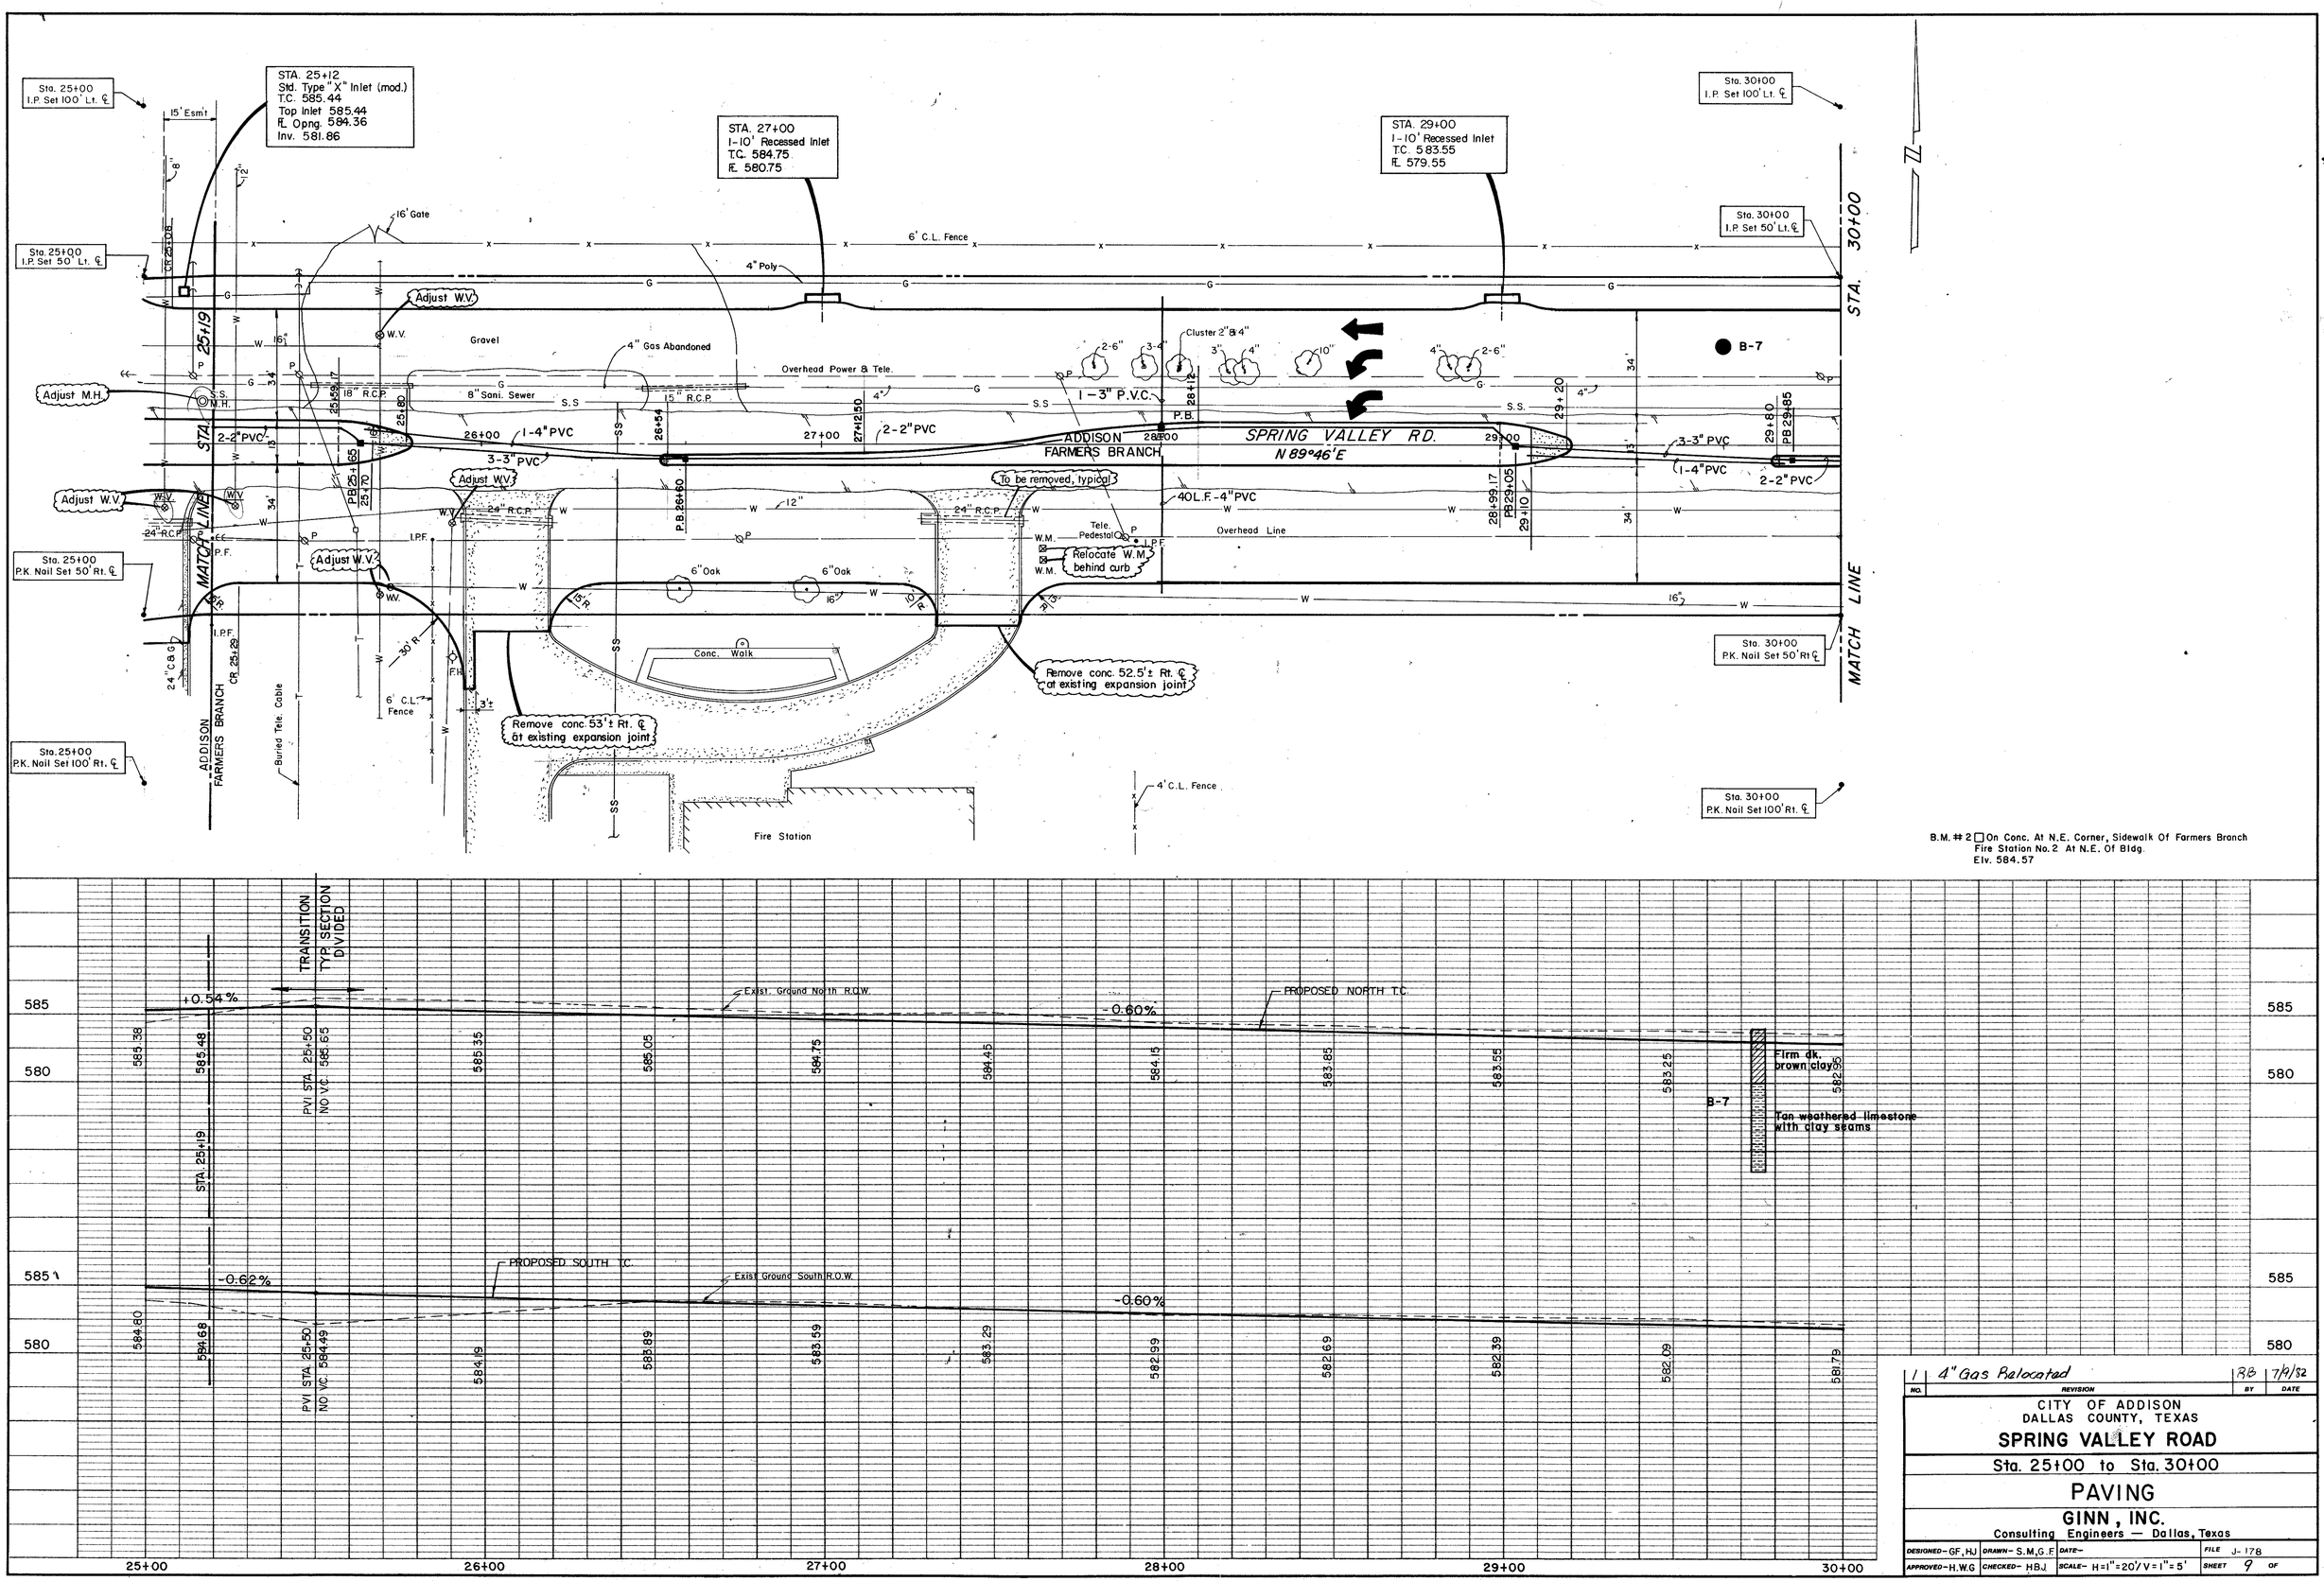

NO.	REVISION	BY	DATE
1	4" Gas Relocated	RB	7/9/82

CITY OF ADDISON
DALLAS COUNTY, TEXAS

SPRING VALLEY ROAD

Sta. 25+00 to Sta. 30+00

PAVING

GINN, INC.
Consulting Engineers — Dallas, Texas

DESIGNED- GF, HJ	DRAWN- S.M, G.F.	DATE-	FILE J-178
APPROVED- H.W.G	CHECKED- HBJ	SCALE- H=1"=20' V=1"=5'	SHEET 9 OF