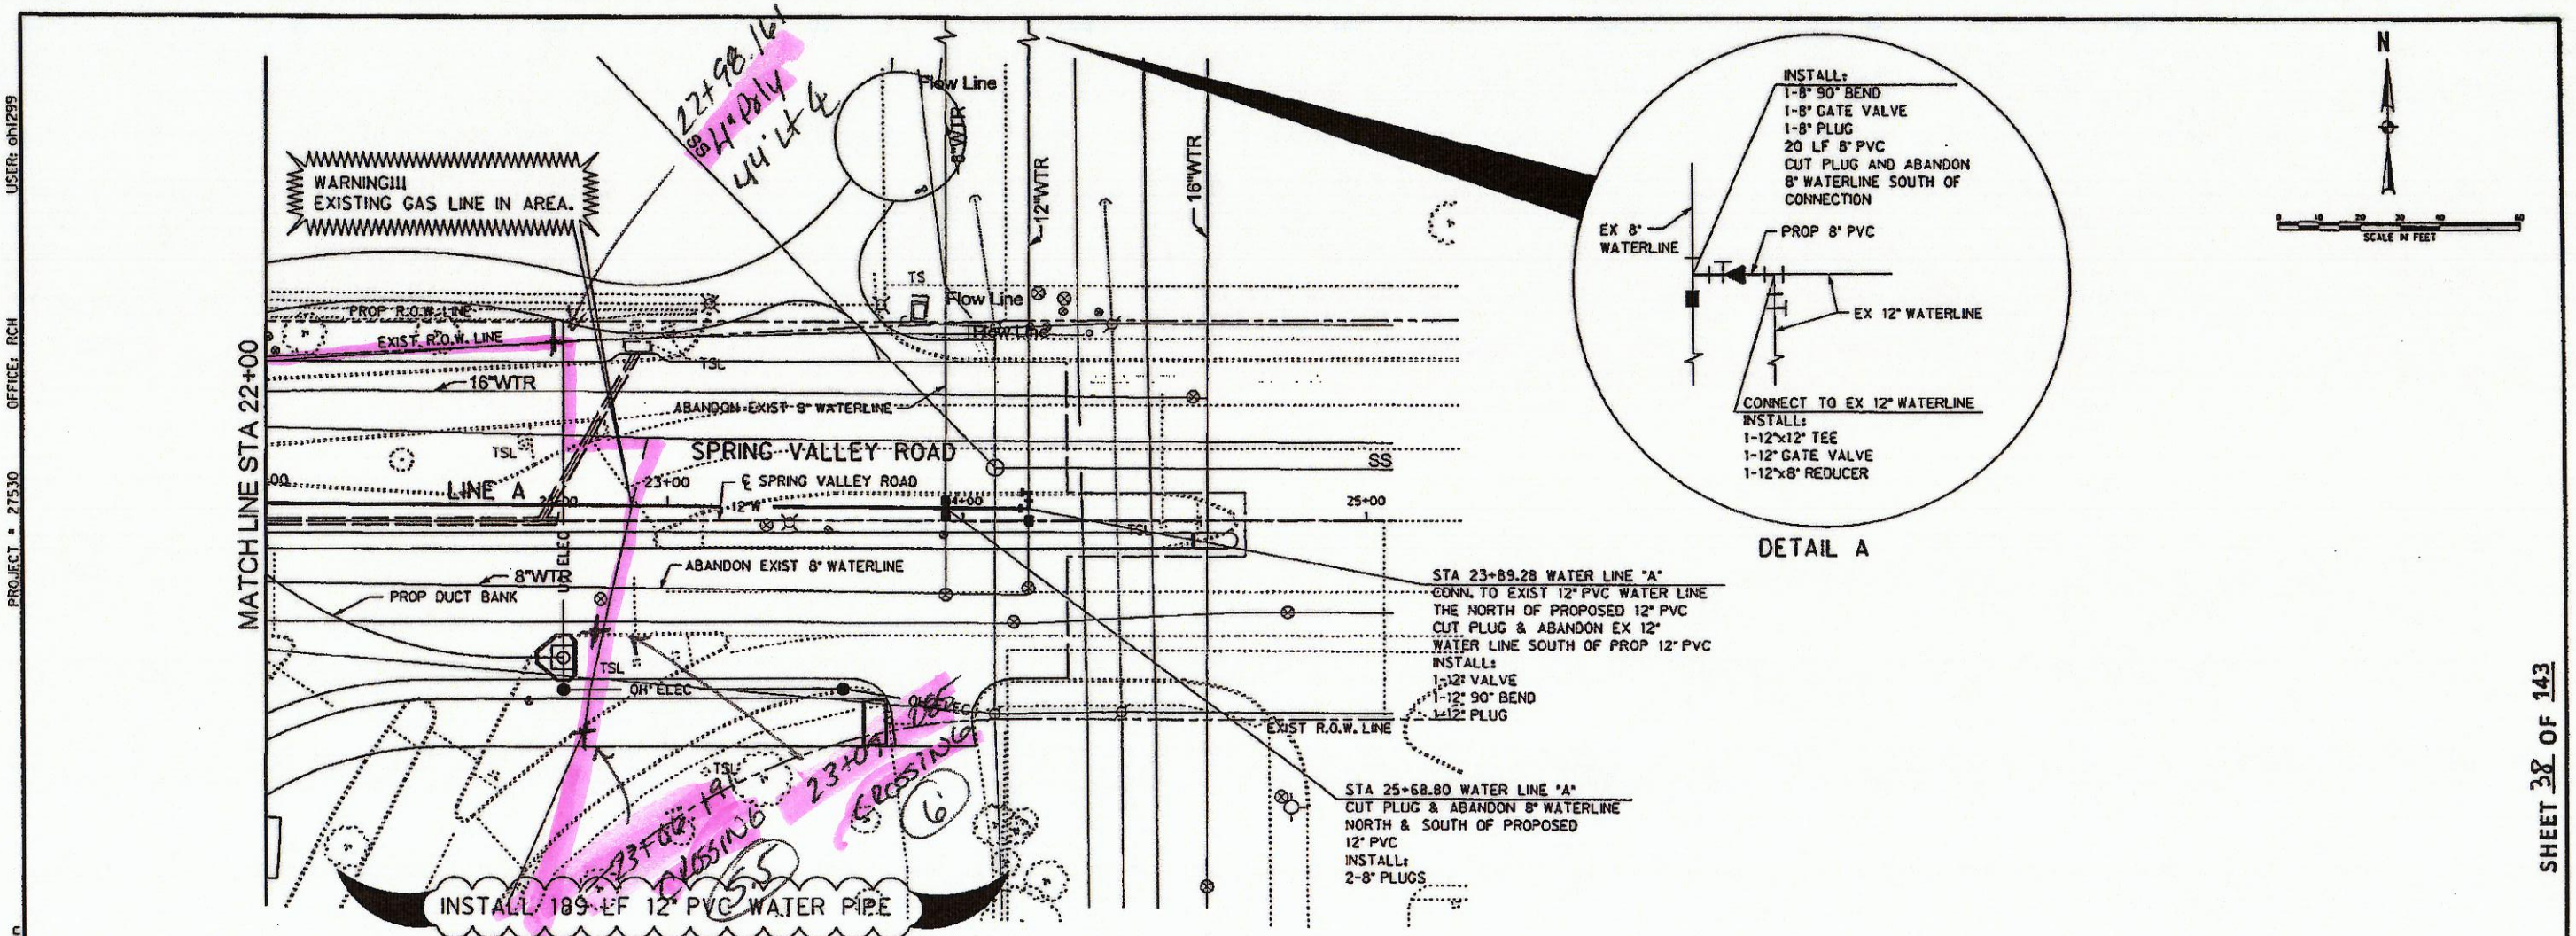

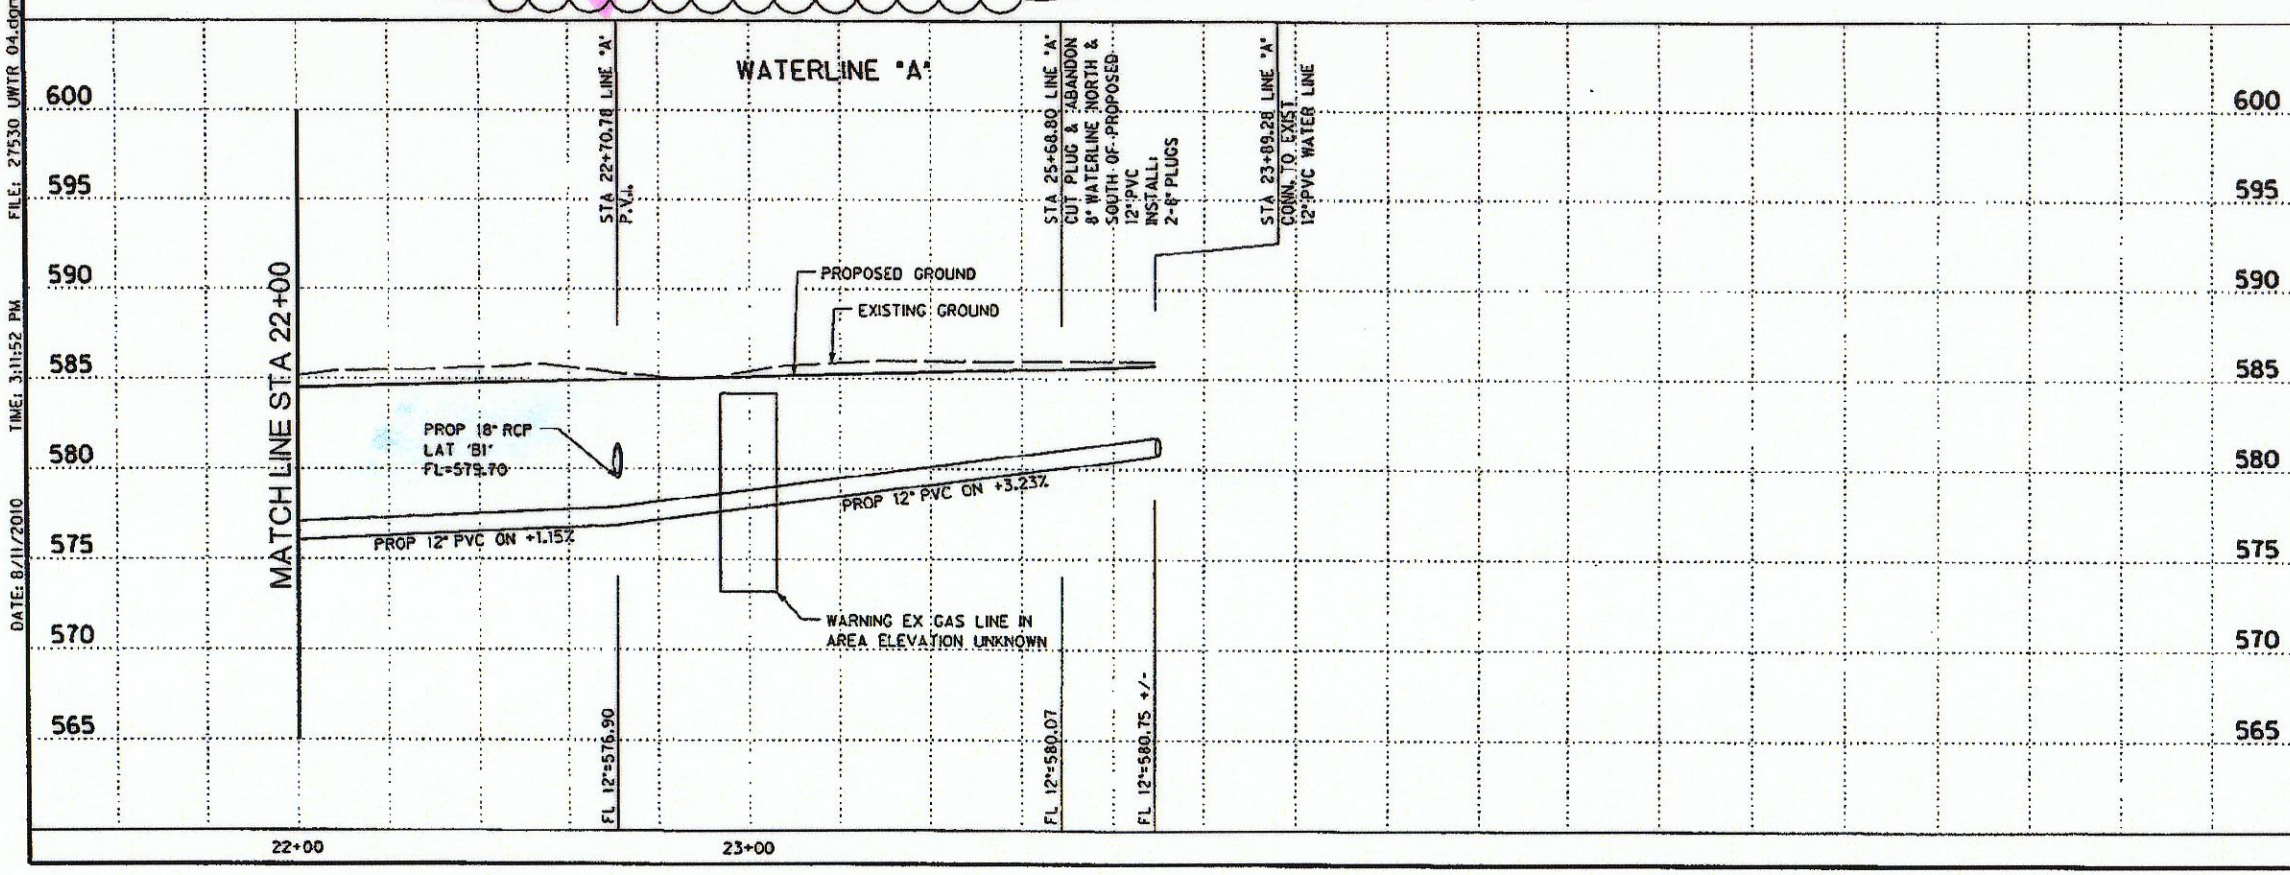

HALFF ASSOCIATES, INC.
ENGINEERS · SURVEYORS · SCIENTISTS

PRELIMINARY - FOR INTERIM REVIEW ONLY

These documents are for Interim Review and not intended for Construction, Bidding, or Permit Purposes. They were prepared by, or under the supervision of:

M.E. ROMANOWSKI — PE# 56206 — Date AUGUST 2010

NO.	REVISION	BY	DATE

TOWN OF ADDISON
DALLAS COUNTY, TEXAS

SPRING VALLEY ROAD

WATER PLAN AND PROFILE
STA 22+00 TO 23+89.28

HALFF
1201 NORTH BOWSER ROAD, RICHARDSON, TEXAS 75081-2275
TEL (214) 346-6200 FAX (214) 738-0095

PROJECT	DESIGN	DRAWN	DATE	FILE	SHEET
27530	XXX	XXX	AUGUST 2010	27530 UWTR 04	WTR-4

SHEET 38 OF 143

USER: ohl299 OFFICE: RCH PROJECT # 27530 FILE: 27530 UWTR 04.dgn TIME: 3:11:52 PM DATE: 8/11/2010