USER: ah1299
OFFICE: RCH
PROJECT # 27530
FILE: 27530 UELE 01.dgn
TIME: 3:12:40 PM
DATE: 8/11/2010

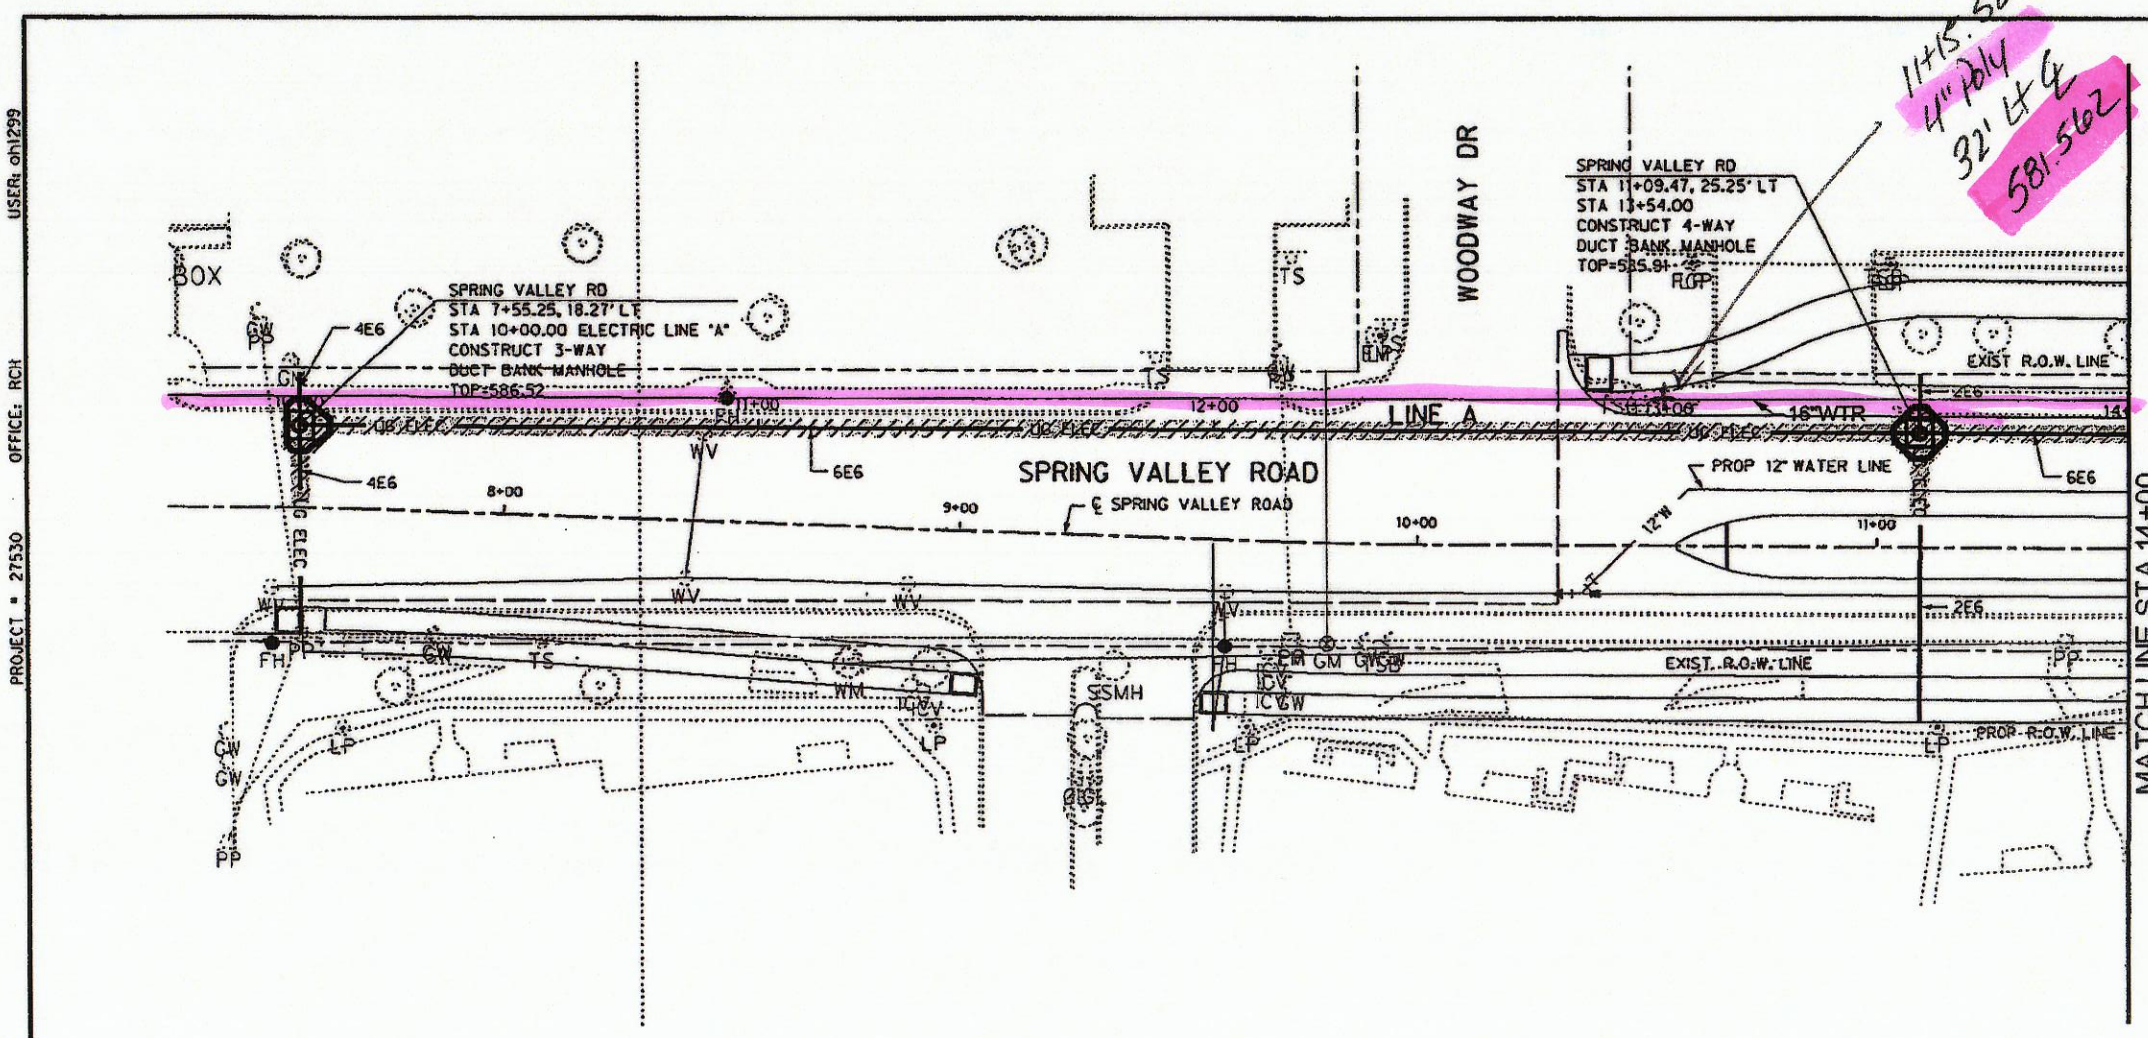

11+15.580
32' LT &
581.562

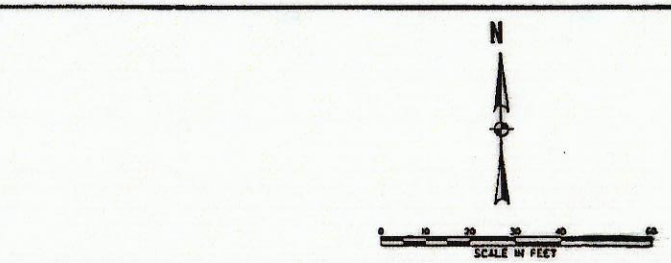

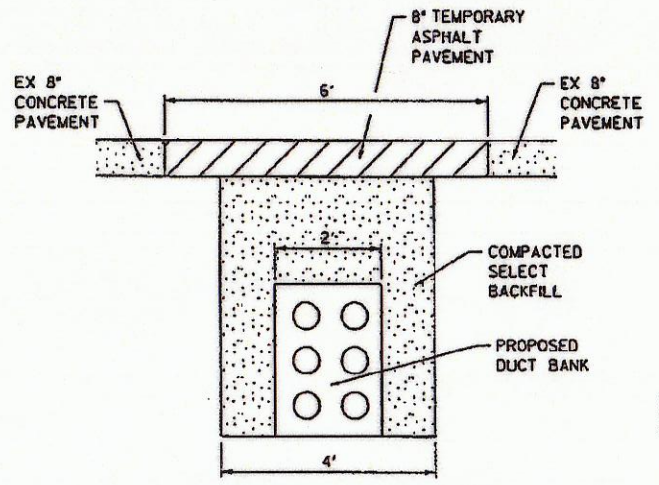

DUCT BANK TRENCH DETAIL
N.T.S.

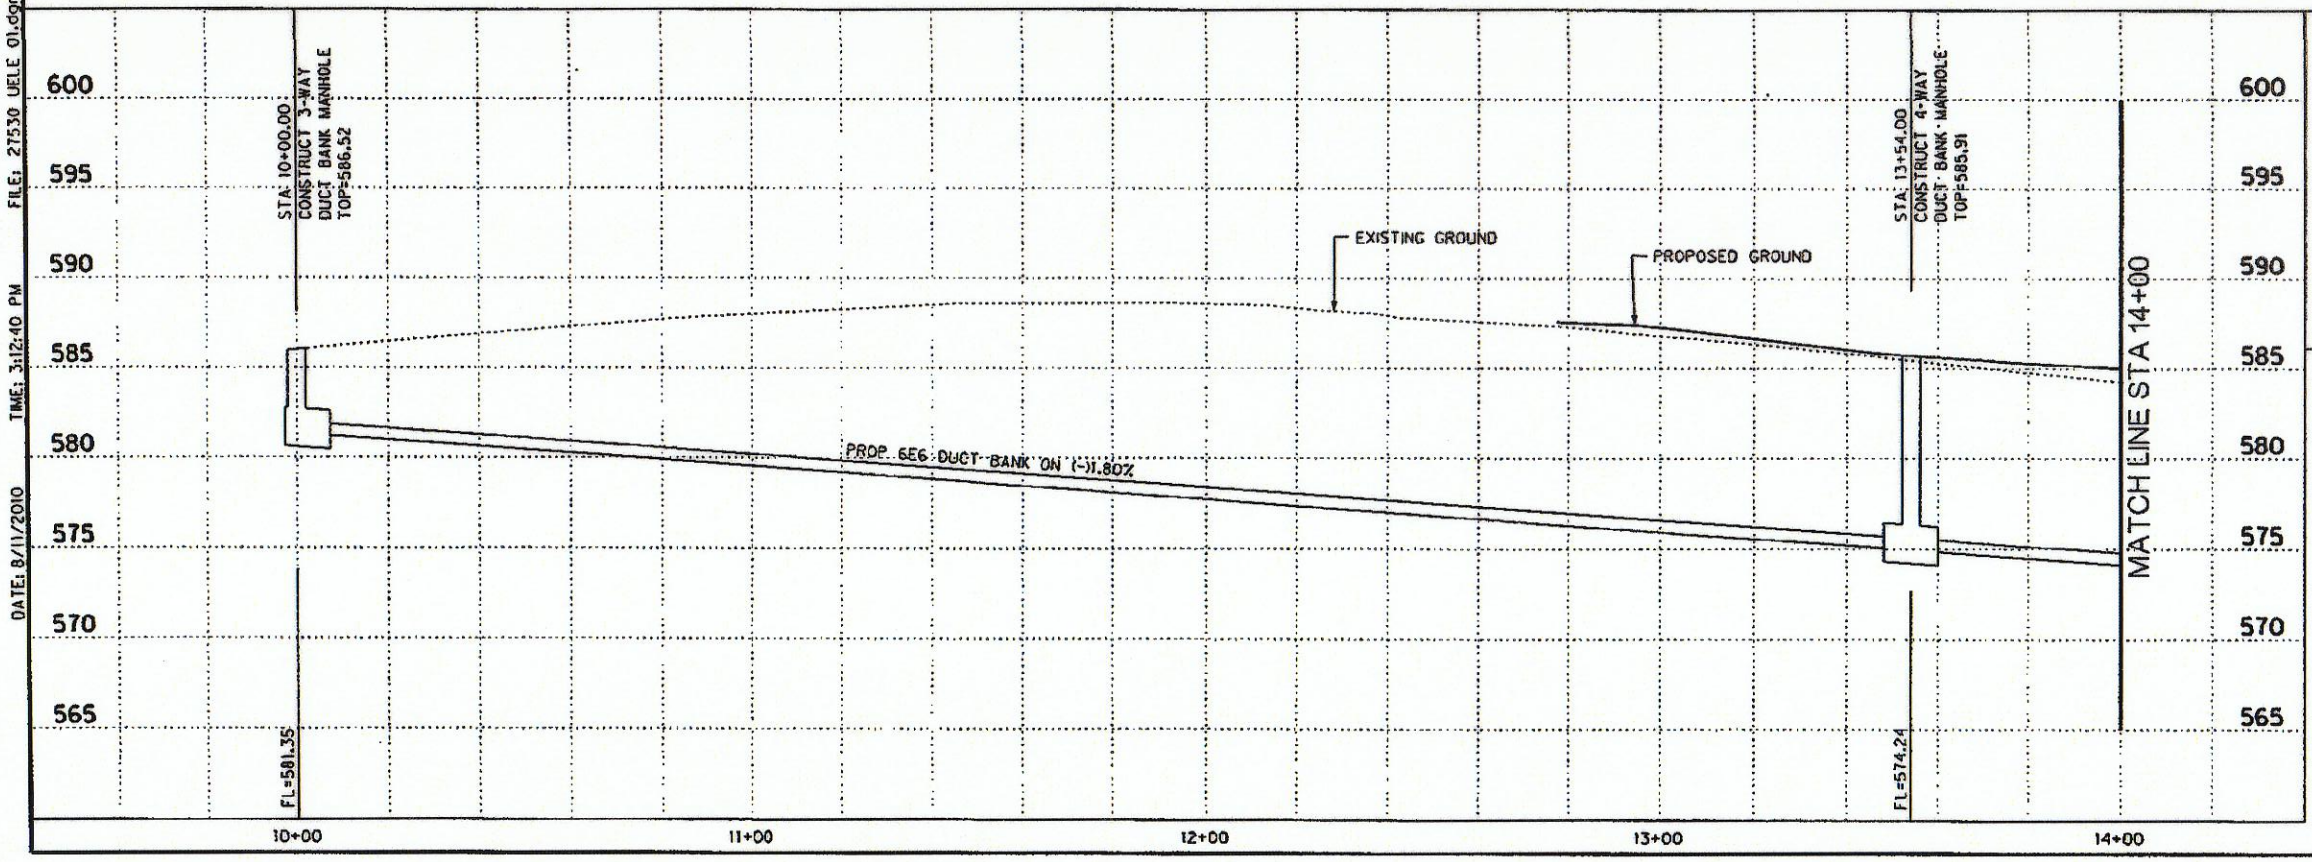

HALFF ASSOCIATES, INC.
ENGINEERS · SURVEYORS · SCIENTISTS

PRELIMINARY - FOR INTERIM REVIEW ONLY

These documents are for Interim Review and not intended for Construction, Bidding, or Permit Purposes. They were prepared by, or under the supervision of:

M.E. ROMANOWSKI — 56306 PE# — AUGUST 2010 Date

NO.	REVISION	BY	DATE

TOWN OF ADDISON
DALLAS COUNTY, TEXAS

SPRING VALLEY ROAD

DUCT BANK PLAN AND PROFILE STA 10+00 TO 14+00

HALFF
1201 NORTH BOWSER ROAD, RICHARDSON, TEXAS 75081-2275
TEL (214) 346-6200 FAX (214) 739-0095

PROJECT	DESIGN	DRAWN	DATE	FILE	SHEET
27530	xxx	xxx	AUGUST 2010	27530 UELE 01	ELE-1