


DIMENSIONS ARE TO FACE OF CURB UNLESS OTHERWISE NOTED

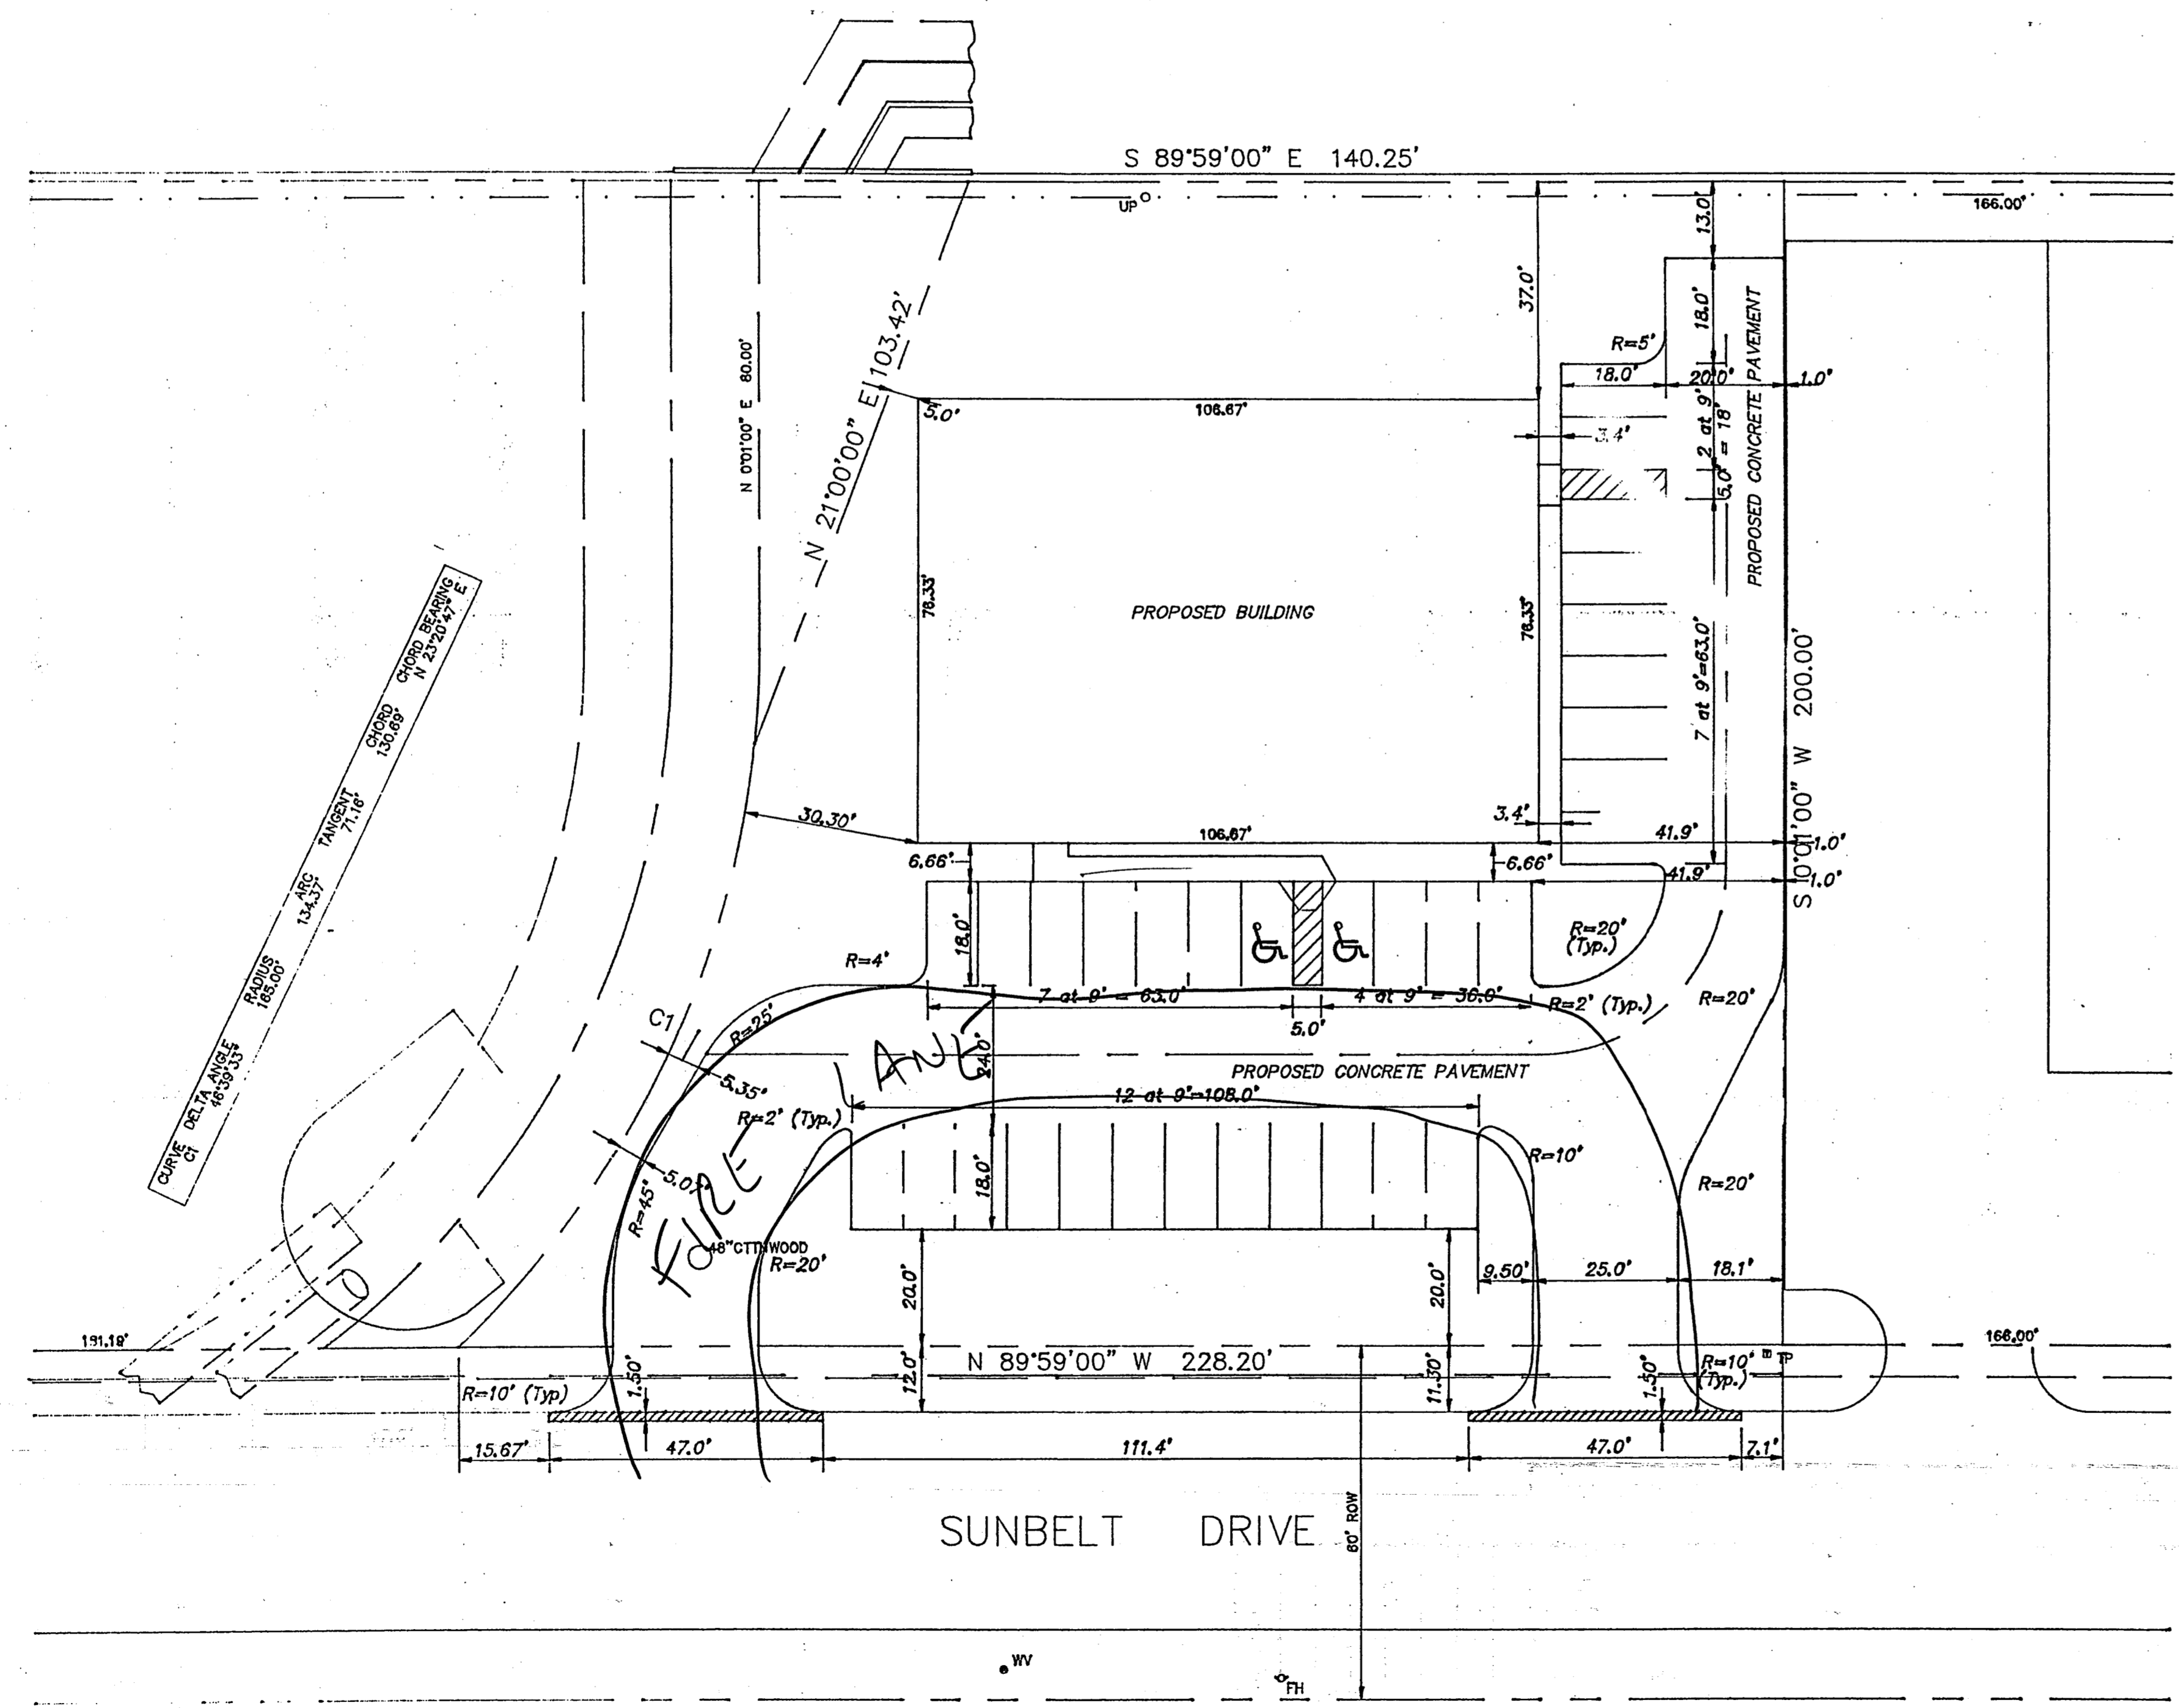

ALL DRAWINGS DEVELOPED BY B & R ARE THE SOLE PROPERTY OF B & R. REPRODUCTION OR USE OF THESE DOCUMENTS IS PROHIBITED

<b>B&amp;R</b>		405 LANCASTER HUTCHINS ROAD, HUTCHINS, TEXAS 75141 (214) 225-2397	
Customer Name - <b>H.M.S. JEWELRY, INC.</b>			
Project Location - <b>SUNBELT DR. ADDISON, TX</b>			
Date: <b>2/97</b>	Design Load: <b>UBC '91</b>	Building Size: <b>76'x106'x15'</b>	
Scale: <b>1"=20'</b>	Job No. <b>2 - J - 97</b>	DRAWING NO. <b>A2</b>	Issue No. <b>1</b>

REV.	DATE	DESCRIPTION

TELEPHONE: 214-225-2397