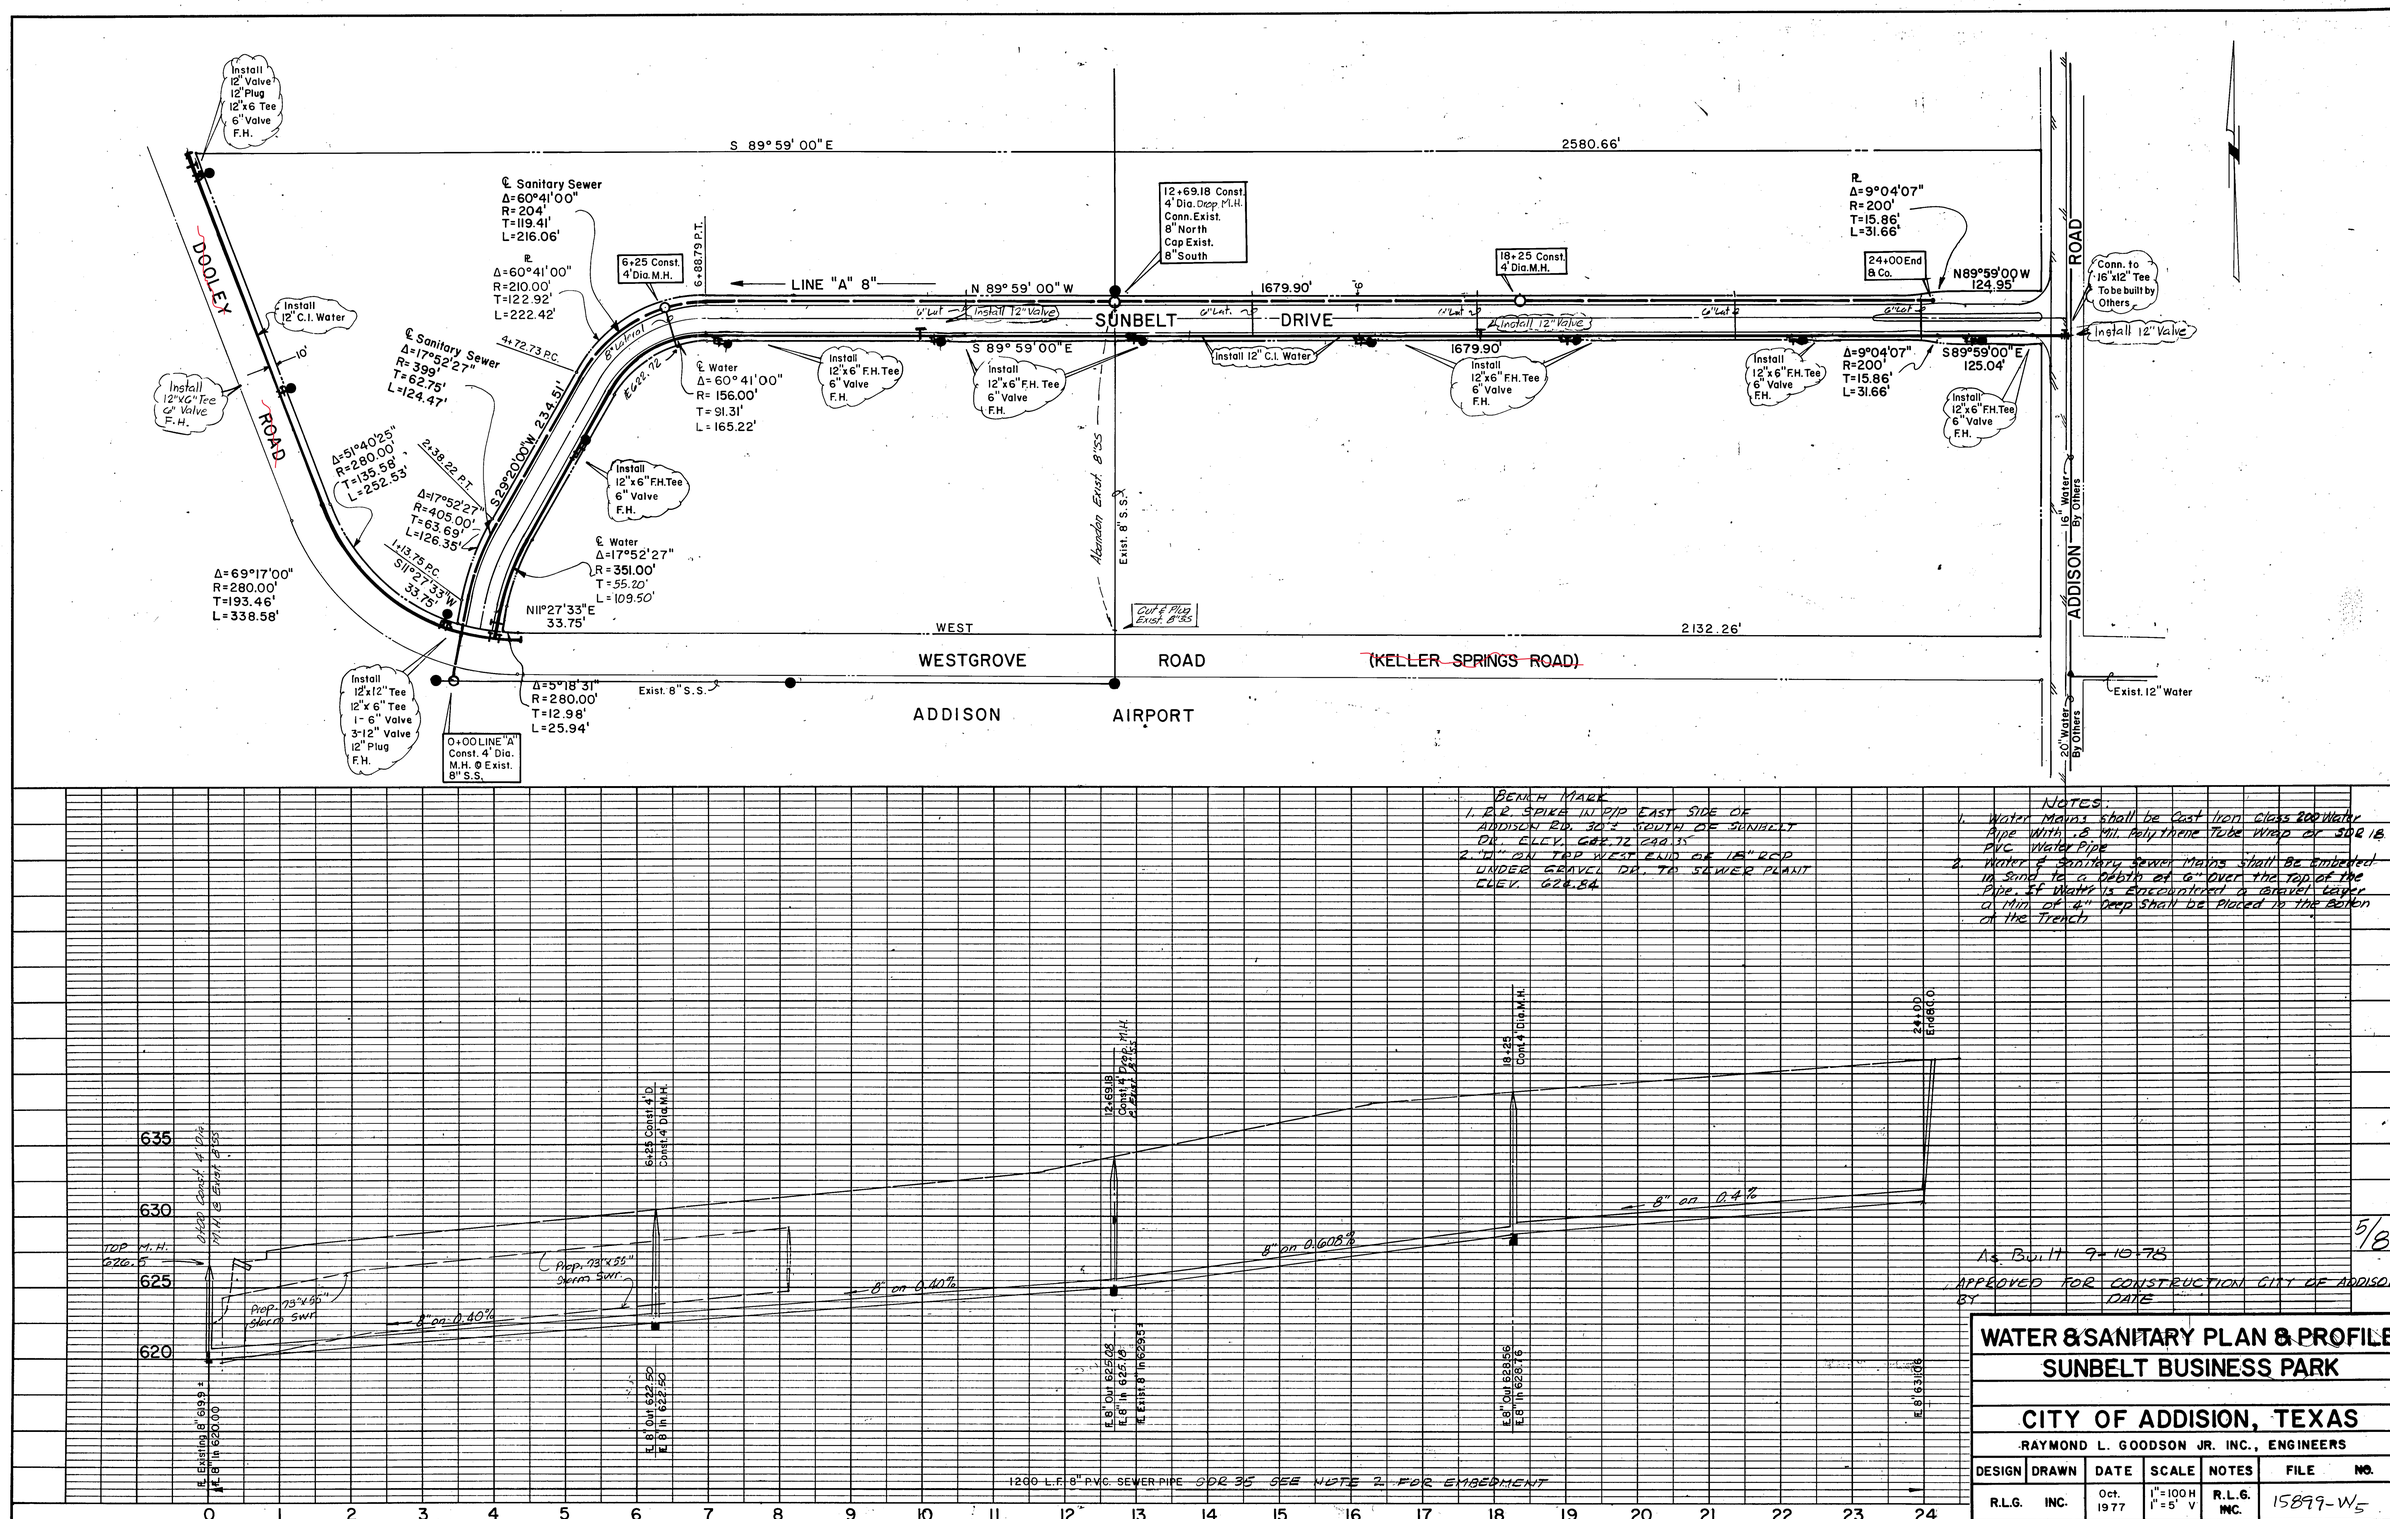

5/8

As Built 9-10-78

APPROVED FOR CONSTRUCTION CITY OF ADDISON
BY DATE

WATER & SANITARY PLAN & PROFILE
SUNBELT BUSINESS PARK

CITY OF ADDISION, TEXAS

RAYMOND L. GOODSON JR. INC., ENGINEERS

DESIGN	DRAWN	DATE	SCALE	NOTES	FILE NO.
R.L.G.	INC.	Oct. 1977	1"=100 H 1"=5' V	R.L.G. INC.	15899-W5

PLAN — NOTE BOOK No. — SURVEYED — PLOTTED — ALIGNMENT CHECKED — RT. OF WAY CHECKED — BY — DATE

PROFILE — NOTE BOOK No. — SURVEYED — PLOTTED — GRADES CHECKED — B. M.'s NOTED — STRUCTURE NOTATIONS CHECKED — BY — DATE