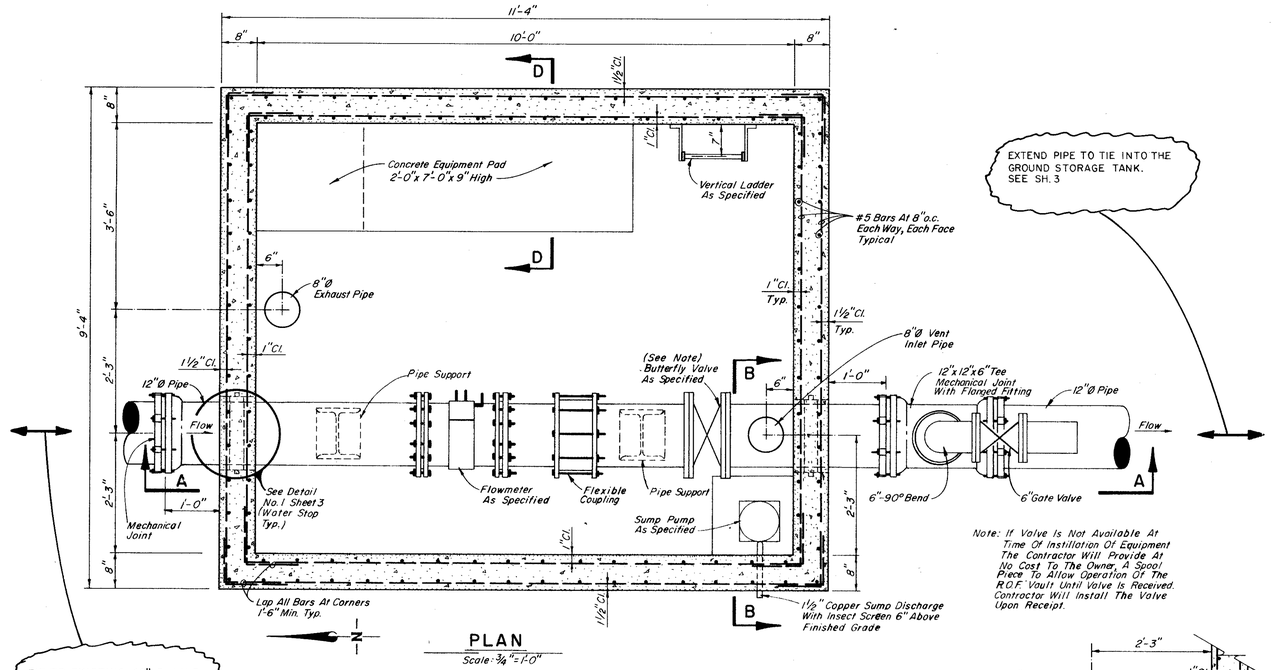

NOTES:
1. Slope Floor To Drain Into Sump 1/4" Per Foot.
2. Concrete Equipment Pad Shall Be Level.
3. Slope Roof To Drain. 1/4" Per Foot

STATE OF TEXAS
JOHN O. STACY
34391
REGISTERED
PROFESSIONAL ENGINEER

CITY OF DALLAS FILE NO. 68IQ-21

CITY OF ADDISON
DALLAS COUNTY, TEXAS

WATER IMPROVEMENTS

RATE OF FLOW CONTROLLER PLAN AND DETAILS

GINN & STACY, INC.
CONSULTING ENGINEERS — DALLAS, TEXAS

Designed By: J.O.S.	Scale: As Shown	Sheet 2 of 6
Drawn By: G.L.H.	Date: 1978	