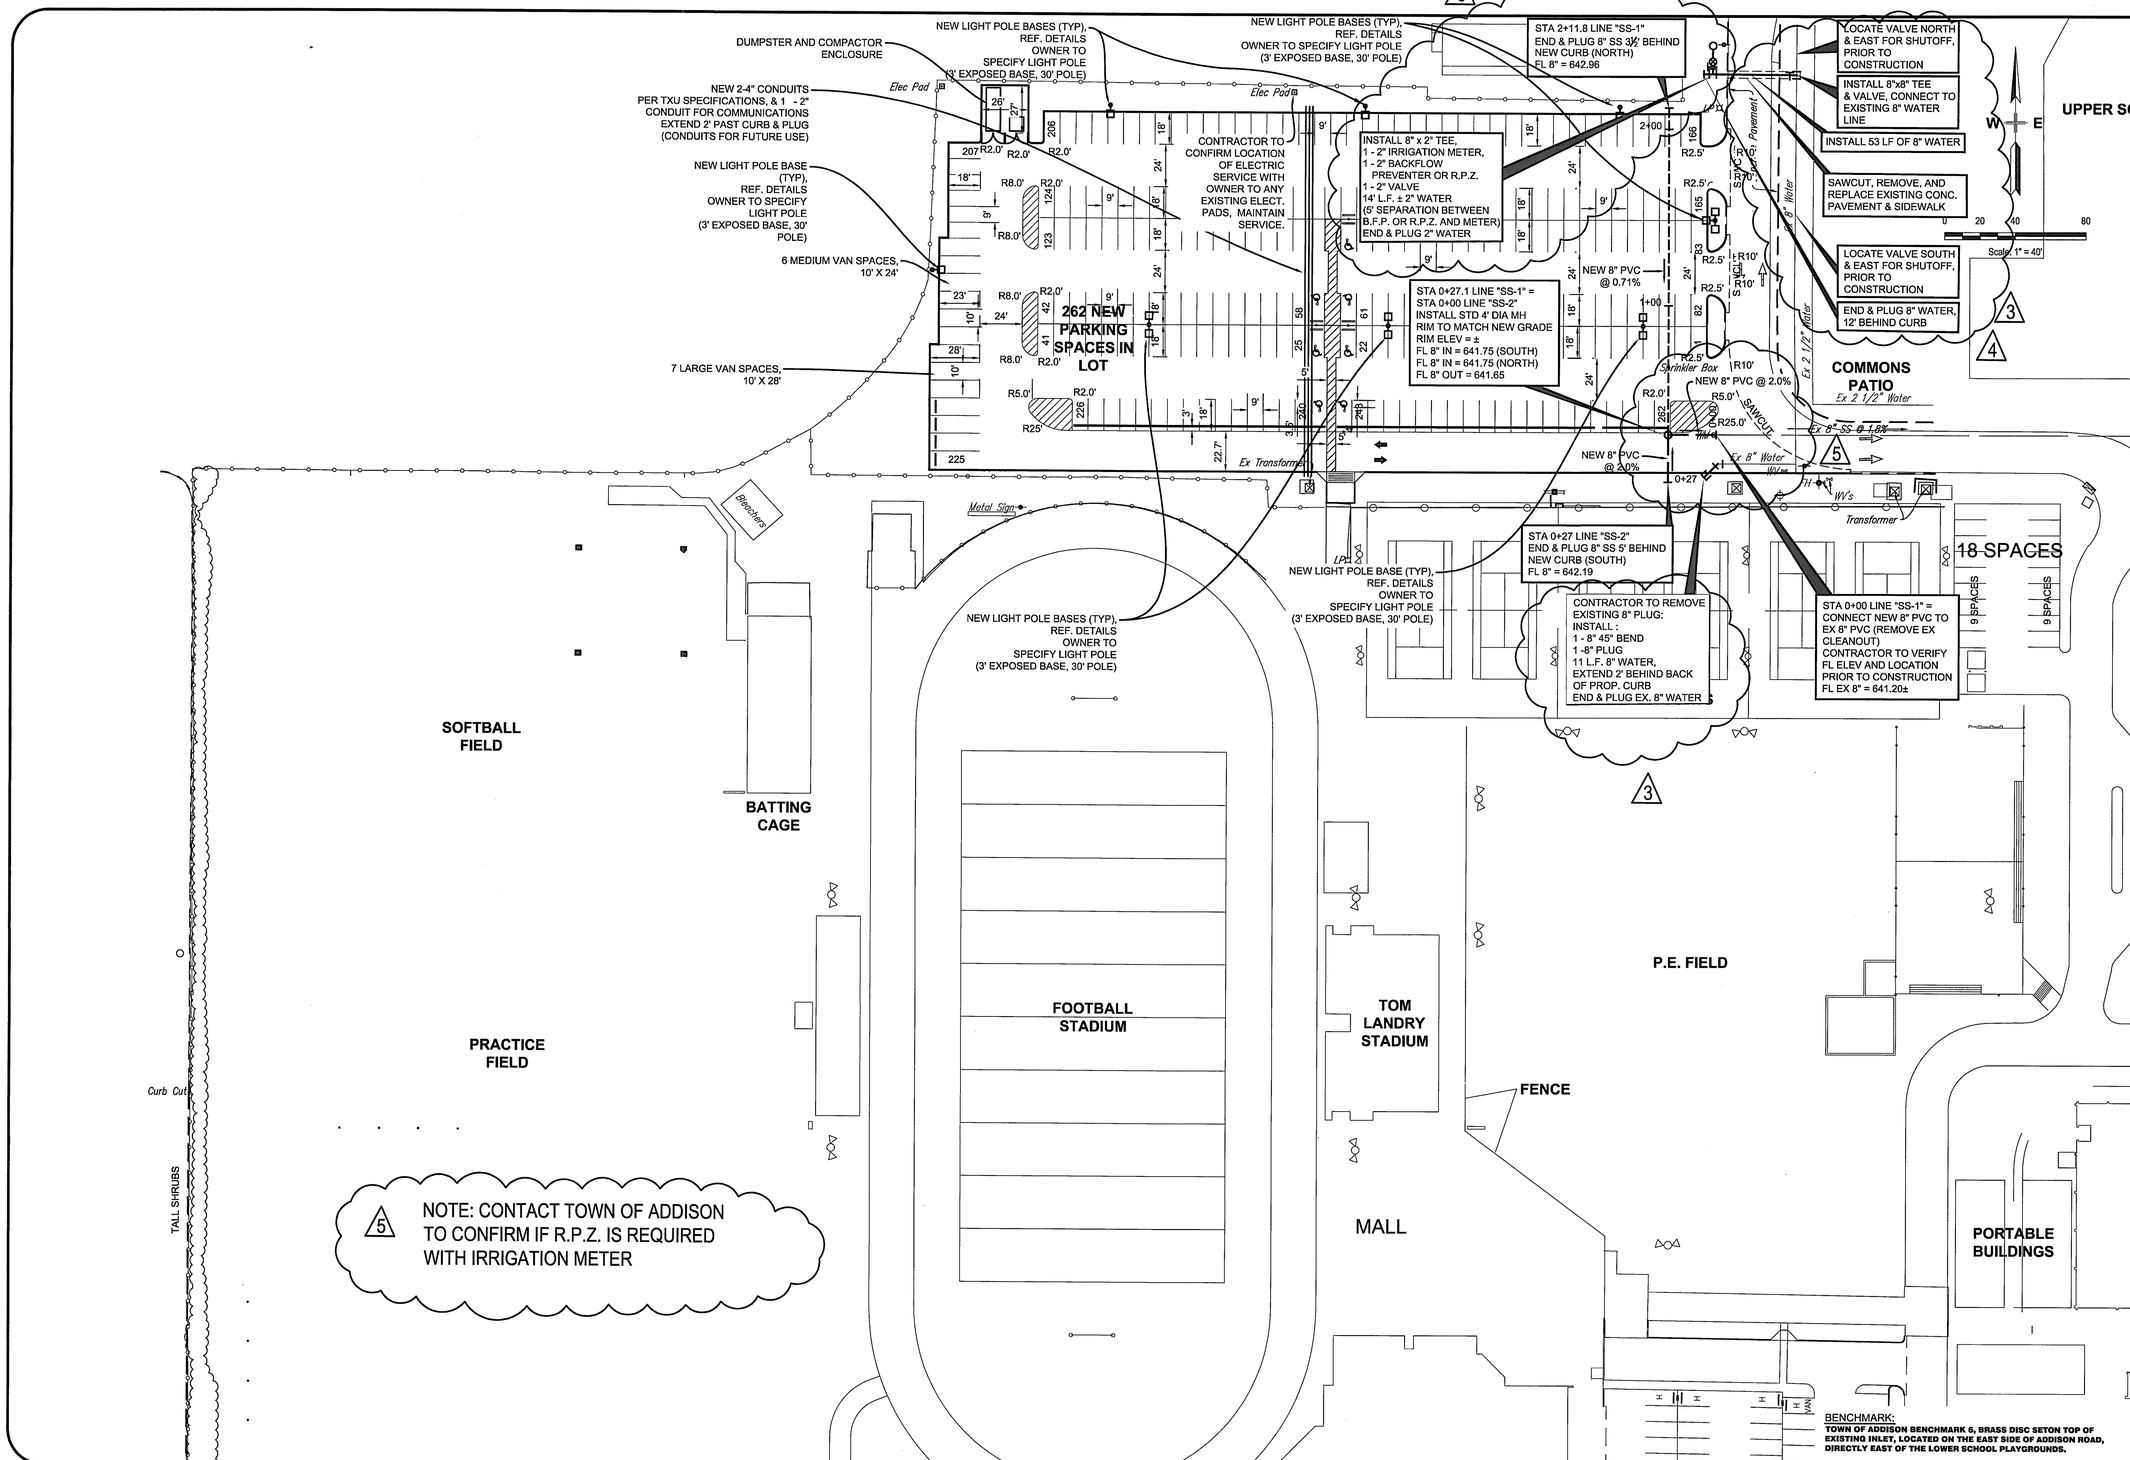

GLENN ENGINEERING
T.B.P.E. FIRM # F - 303
PHONE 972-717-5151
105 DECKER COURT-SUITE 910
FAX 972-717-2176
IRVING, TEXAS 75062

TRINITY CHRISTIAN ACADEMY

PARKING ADDITIONS

SITE & UTILITY PLAN

STATE OF TEXAS
THOMAS J. CASEY IV
86213
PROFESSIONAL ENGINEER

THE SEAL APPEARING ON THIS DOCUMENT WAS AUTHORIZED BY THOMAS J. CASEY IV, P.E. 86213, ON JULY 11, 2011

Issue Dates:

Review: Bid March 7, 2011

1 Revised Grading & HC Parking May 2, 2011
2 Re-Bid May 11, 2011
3 Town Comments, June 7, 2011
4 Town Comments #2, Removed Loop Road June 30, 2011
5 Added Irr. Meter July 11, 2011

Construction:

Scale:	AS NOTED
Drawn By:	TJC
Checked By:	CMA
Project No.:	10 - 599.150

Sheet 3 of 13