
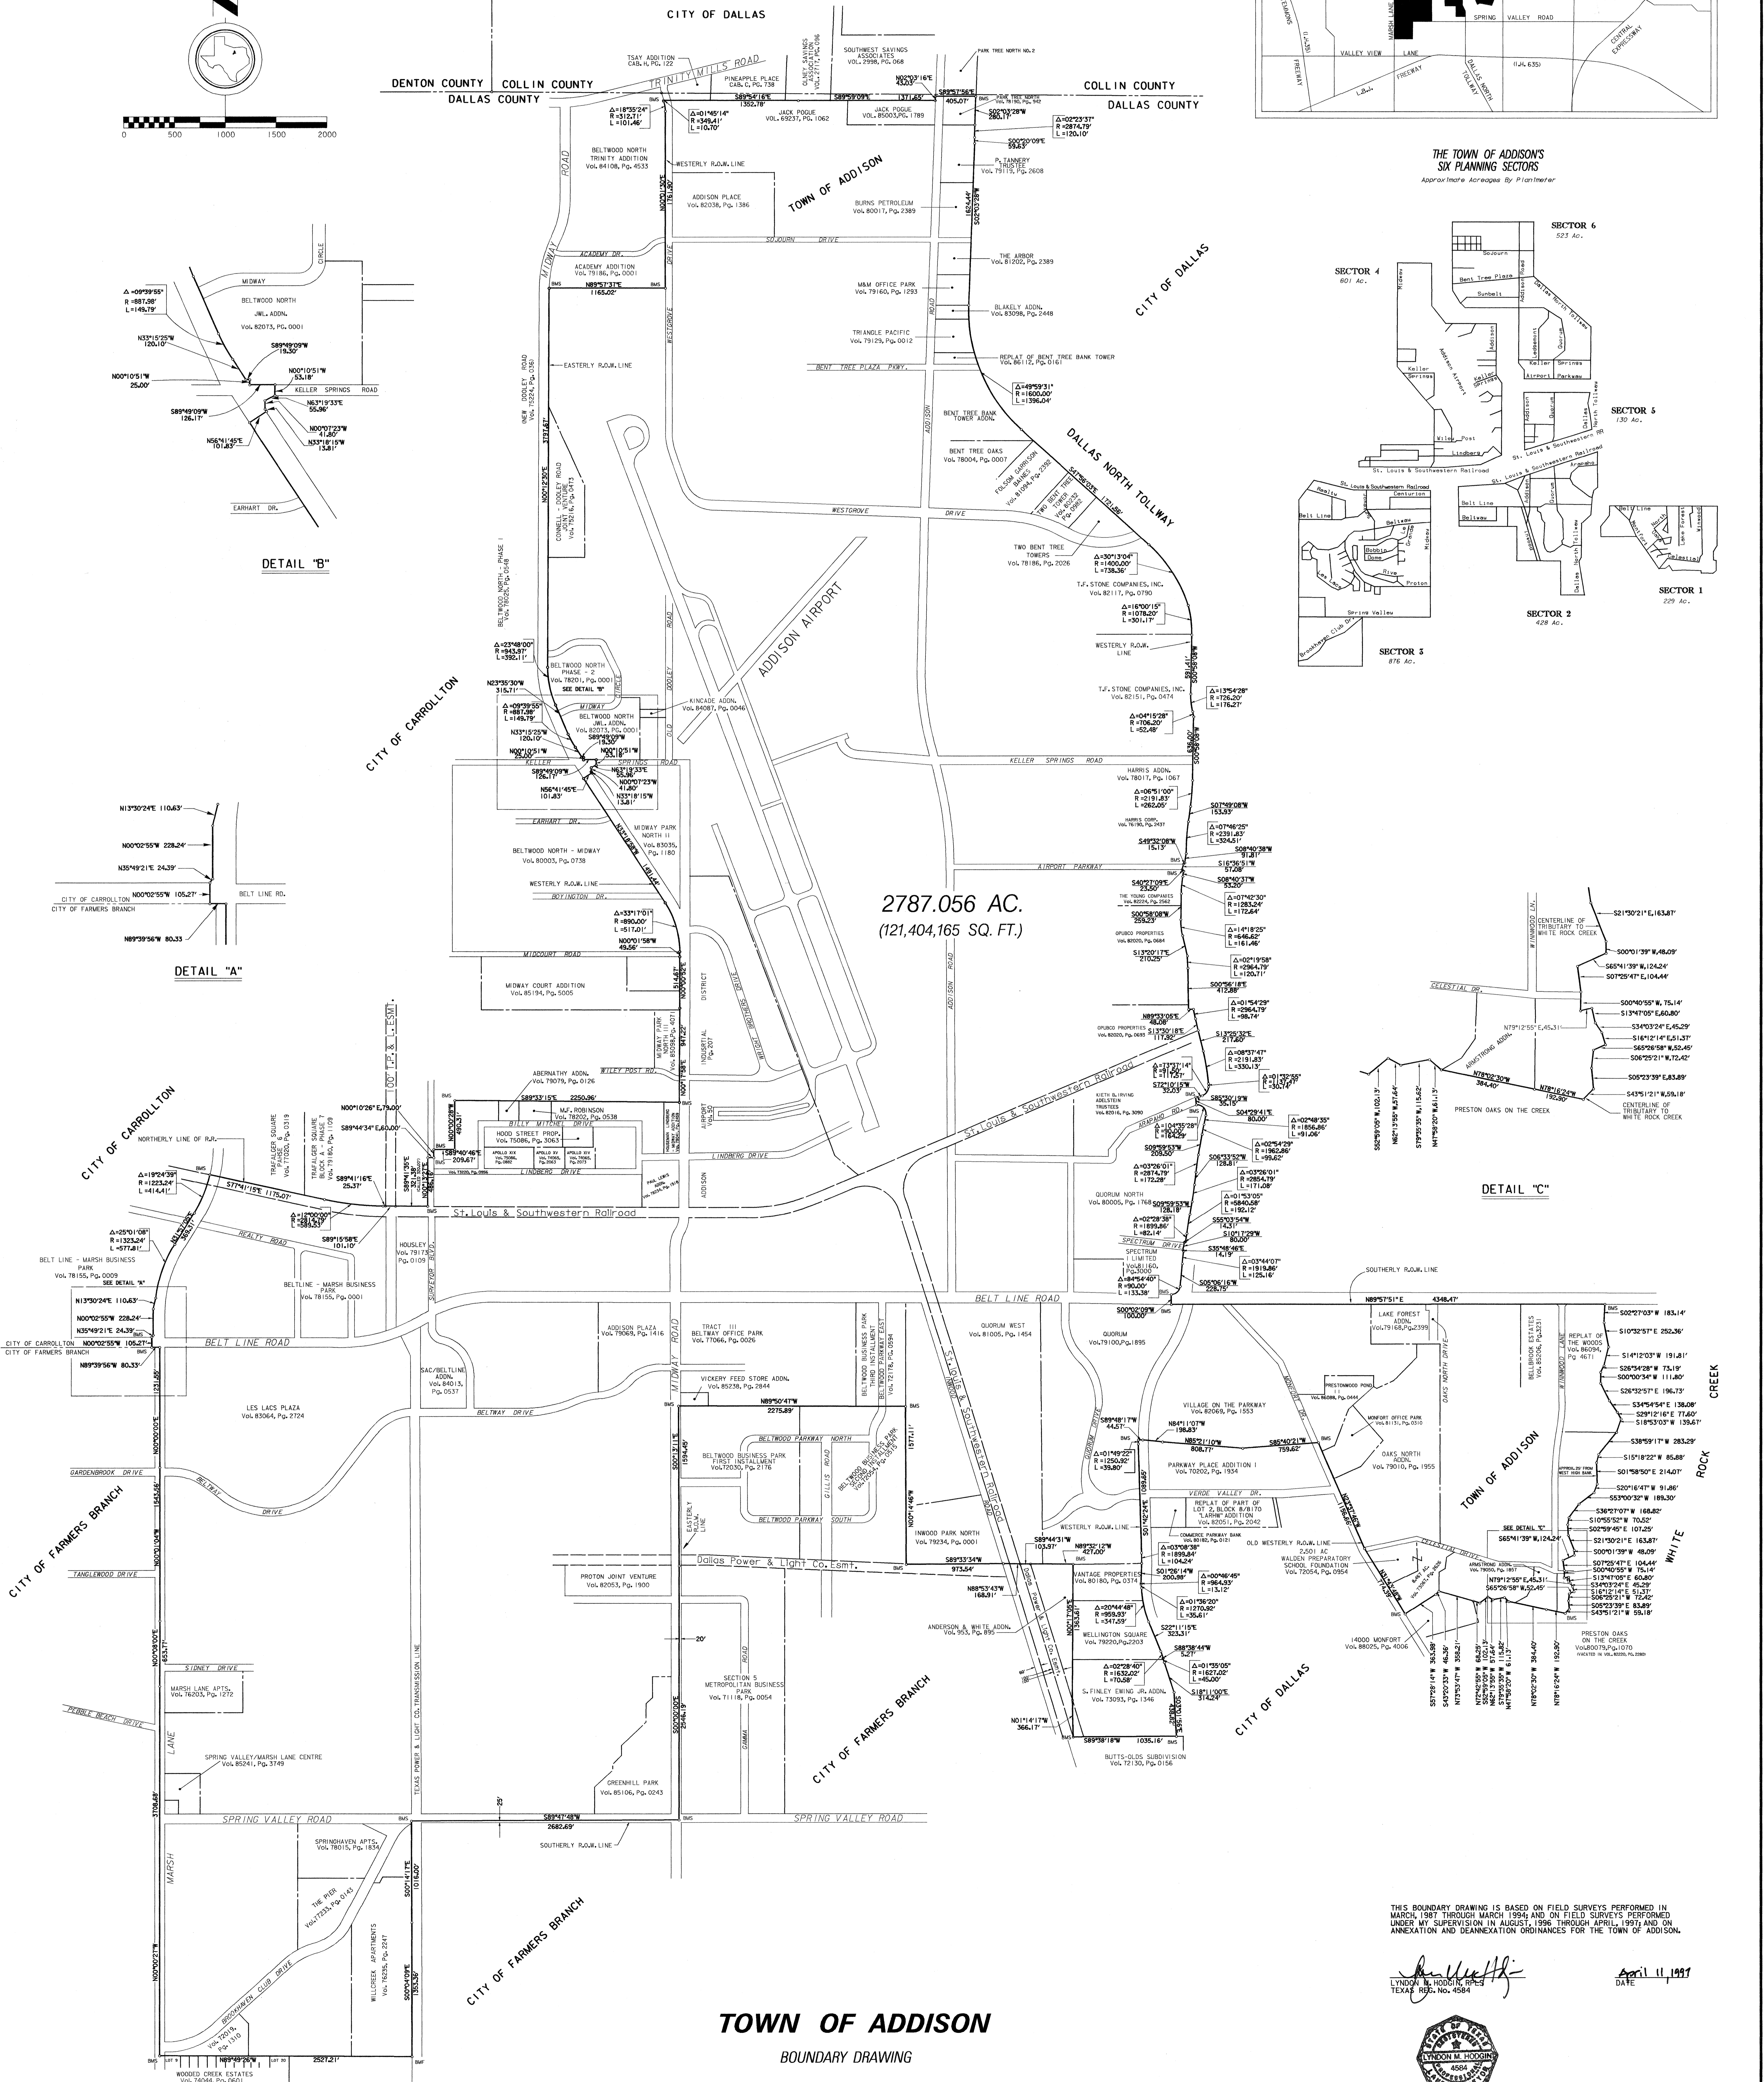


THE TOWN OF ADDISON'S SIX PLANNING SECTORS
Approximate Acreages by Planner

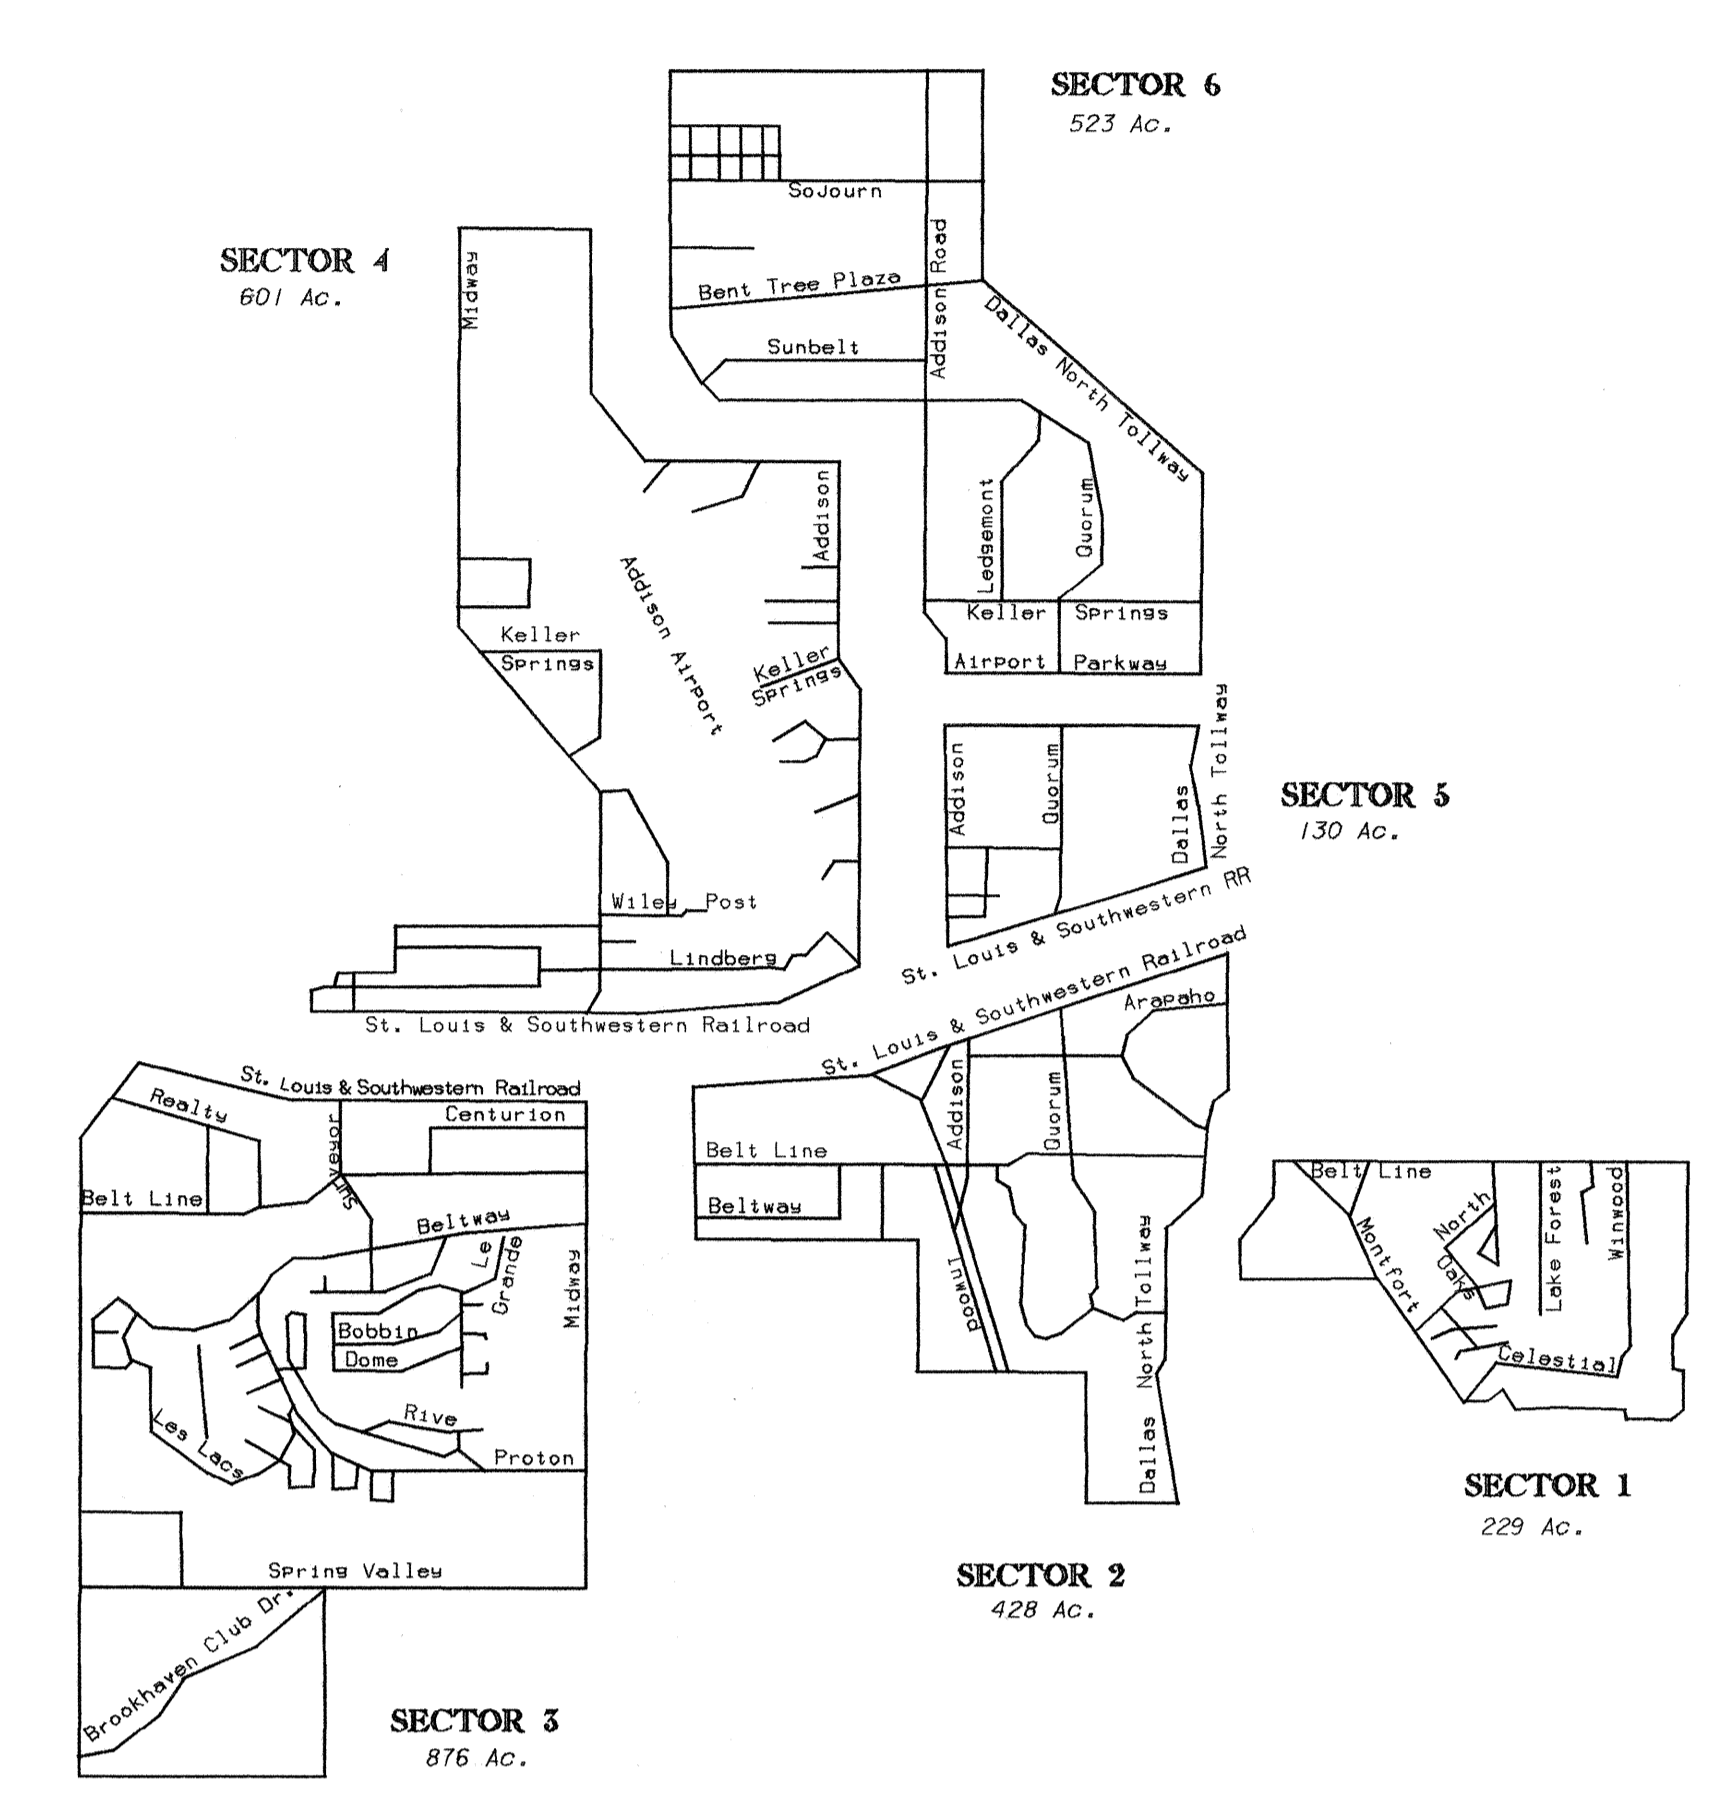

DETAIL "B"

DETAIL "A"

DETAIL "C"

TOWN OF ADDISON
BOUNDARY DRAWING

APRIL, 1997

SCALE: 1" = 500'

THIS BOUNDARY DRAWING IS BASED ON FIELD SURVEYS PERFORMED IN MARCH, 1987 THROUGH MARCH, 1994, AND ON FIELD SURVEYS PERFORMED UNDER MY SUPERVISION IN AUGUST, 1996 THROUGH APRIL, 1997 AND ON ANNEXATION AND DEANNEXATION ORDINANCES FOR THE TOWN OF ADDISON.

LYNDON M. HOODIN, P.E.
TEXAS REG. NO. 4584

DATE: April 11, 1997

