APPROVED CITY BOUNDARY MAP
5-8-1 1987 Survey

B13-4

2833 ACRES

POINT OF BEGINNING

Dallas Co./Collin Co. line as recorded May 18, 1987 in Volume 361, Page 949, of the Commissioners Court Records of Dallas County, Texas, Order No. 87901

DENTON COUNTY
COLLIN COUNTY
DALLAS COUNTY
COLLIN COUNTY
DALLAS COUNTY

CITY OF DALLAS
CITY OF CARROLLTON
CITY OF FARMERS BRANCH
TOWN OF ADDISON

TRINITY MILLS ROAD
BELTWOOD NORTH TRINITY ADDITION Vol. 84108, Pg. 4533
WEST R.O.W. LINE
ADDISON PLACE Vol. 82038, Pg. 1386
SOJOURN DRIVE
ACADEMY DR.
ACADEMY ADDITION Vol. 79186, Pg. 0001
Ex. City Limits Line ℄ Of Westgrove
WESTGROVE DRIVE
NEW DOOLEY ROAD Vol. 79224, Pg. 036
CONNELL - DOOLEY ROAD JOINT VENTURE Vol. 76216, Pg. 0473
Ex. City Limits Line ℄ Of Midway Road
CENTERLINE
BELTWOOD NORTH - PHASE I Vol. 78025, Pg. 0548
BELTWOOD NORTH PHASE II Vol. 78201, Pg. 0001
MIDWAY
BELTWOOD NORTH ADDN. Vol. 82073, Pg. 0001
KINCADE ADDN. Vol. 84087, Pg. 0046
KELLER SPRINGS RD.
KELLER SPRINGS ROAD
S89°45'43"W 41.93'
MIDWAY PARK NORTH II Vol. 83035, Pg. 1180
EARHART DR.
BELTWOOD NORTH - MIDWAY Vol. 80003, Pg. 0738
BOYINGTON DR.
MIDCOURT ROAD
MIDWAY COURT ADDITION Vol. 85194, Pg. 5005
SEE DETAIL "C"
SEE DETAIL "B"
WILEY POST RD.
ADDISON AIRPORT
ADDISON ROAD
DESIGN CENTERLINE DALLAS NORTH TOLLWAY
BENT TREE PLAZA PKWY.
BENT TREE BANK TOWER ADDN.
REPLAT OF BENT TREE BANK TOWER Vol. 86112, Pg. 0161
BENT TREE OAKS Vol. 78004, Pg. 0007
FULSOM GARRISON BAINES Vol. 81094, Pg. 2392
TWO BENT TREE TOWER Vol. 80232, Pg. 0982
TWO BENT TREE TOWERS Vol. 78186, Pg. 2026
PARK TREE NORTH Vol. 78190, Pg. 942
Z. TANNERY TRUSTEE Vol. 79119, Pg. 2808
BURNS PETROLEUM Vol. 80017, Pg. 2389
THE ARBOR Vol. 81202, Pg. 2389
MBM OFFICE PARK Vol. 79180, Pg. 1283
BLAKELY ADDN. Vol. 85098, Pg. 2448
TRIANGLE PACIFIC Vol. 79129, Pg. 0062
T.F. STONE COMPANIES, INC. Vol. 82117, Pg. 0790
WESTERLY R.O.W. LINE
T.F. STONE COMPANIES, INC. Vol. 82151, Pg. 0474
HARRIS ADDN Vol. 78017, Pg. 1067
HARRIS CORP. Vol. 76190, Pg. 2457
AIRPORT PARKWAY
THE YOUNG COMPANIES Vol. 82254, Pg. 2562
OPUBCO PROPERTIES Vol. 82020, Pg. 0684
OPUBCO PROPERTIES Vol. 82020, Pg. 0693
KIETH & IRVING ADELSTEIN TRUSTEES Vol. 82261, Pg. 3090
QUORUM NORTH Vol. 80005, Pg. 1768
ARAPAHO RD.
T.F. STONE COMPANIES, INC. Vol. 82117, Pg. 0790
SPECTRUM DR
SPECTRUM I LIMITED Vol. 81160, Pg. 3000
QUORUM WEST Vol. 81005, Pg. 1454
QUORUM Vol. 79100, Pg. 1895
QUORUM DR.
MONTFORT DR.
VILLAGE ON THE PARKWAY Vol. 82069, Pg. 1553
PRESTONWOOD POND III Vol. 86038, Pg. 0466
MONTFORT OFFICE PARK Vol. 81131, Pg. 0310
OAKS NORTH ADDN. Vol. 79010, Pg. 1955
PARKWAY PLACE ADDITION I Vol. 70202, Pg. 1934
VERDE VALLEY DR.
REPLAT OF PART OF LOT 2, BLOCK B/870 LHRHW ADDITION Vol. 82051, Pg. 2042
COMMERCE PARKWAY BANK Vol. 80182, Pg. 0121
VANTAGE PROPERTIES Vol. 80180, Pg. 0374
WELLINGTON SQUARE Vol. 79220, Pg. 2203
S. FINLEY EWING JR. ADDN. Vol. 73093, Pg. 1346
BUTTS - OLDS SUBDIVISION Vol. 72130, Pg. 0156
14400 MONTFORT Vol. 86013, Pg. 4250
DESIGN CENTERLINE DALLAS NORTH TOLLWAY
SOUTH R.O.W. BELT LINE RD.
BELT LINE ROAD
LAKE FOREST ADDN Vol. 79168, Pg. 2399
BELLBROOK ESTATES Vol. 85206, Pg. 3231
REPLAT OF THE WOODS Vol. 86094, Pg. 4671
OAKS NORTH DR.
WINNWOOD LANE
PRESTON OAKS ON THE CREEK Vol. 80079, Pg. 1071 (VACATED IN VOL. 82220, PG. 2280)
ROCK CREEK
WHITE

St. Louis & Southwestern Railroad
Texas Power & Light Co. Transmission Line
Dallas Power & Light Co. Esmt.

BELT LINE ROAD
REALTY RD.
BELTLINE - MARSH BUSINESS PARK Vol. 78155, Pg. 0009
BELTLINE - MARSH BUSINESS PARK Vol. 78155, Pg. 0001
SURVEYOR BLVD.
HOUSLEY Vol. 79173 Pg. 0109
ADDISON PLAZA Vol. 79069, Pg. 1416
SAC/BELTLINE ADDN. Vol. 84013, Pg. 0537
LES LACS PLAZA Vol. 83064, Pg. 2724
BELTWAY DRIVE
GARDENBROOK DR.
TANGLEWOOD DR.
SIDNEY DR.
PEBBLE BEACH DR.
MARSH LANE APTS. Vol. 76203, Pg. 1272
SPRING VALLEY/ MARSH LANE CENTRE Vol. 85241, Pg. 3749
SPRINGHAVEN APTS. Vol. 78015, Pg. 1834
THE PIER Vol. 79230, Pg. 0145
MILLCREEK APARTMENTS Vol. 76235, Pg. 2247
BROOKHAVEN CLUB DR.
WOODED CREEK ESTATES Vol. 74044, Pg. 0601
MARSH LANE
SPRING VALLEY ROAD
GREENHILL PARK Vol. 85106, Pg. 0243
SECTION 5 METROPOLITAN BUSINESS PARK Vol. 71118, Pg. 0054
PROTON JOINT VENTURE Vol. 82053, Pg. 1900
INWOOD PARK NORTH Vol. 79234, Pg. 0001
BELTWOOD PARKWAY NORTH
BELTWOOD PARKWAY SOUTH
BELTWOOD BUSINESS PARK FIRST INSTALLMENT Vol. 72030, Pg. 2176
BELTWOOD BUSINESS PARK SECOND INSTALLMENT Vol. 72054, Pg. 0515
VICKERY FEED STORE ADDN. Vol. 85236, Pg. 2844
BELTWOOD BUSINESS PARK NORTH ADDITION EAST Vol. 72178, Pg. 0594
GILLIS ROAD
MIDWAY ROAD
PROTON
ABERNATHY ADDN. Vol. 79079, Pg. 0126
M.F. ROBINSON Vol. 78052, Pg. 0538
HOSEMAN LINDBERG HOPKINS ADDITION Vol. 79041, Pg. 2491
HOOD STREET PROP. Vol. 78136, Pg. 3063
APOLLO XIX Vol. 79088, Pg. 0662
APOLLO XV Vol. 74065, Pg. 2053
APOLLO XIV Vol. 74065, Pg. 2073
BILLY MITCHELL DRIVE
LINDBERG DR.
LINDBERG DRIVE
PAUL LEWIS ADDN. Vol. 78234, Pg. 1518
ANDERSON & WHITE ADDN. Vol. 953, Pg. 895
TRACT III BELTWAY OFFICE PARK Vol. 77086, Pg. 0026
TRAFALGER SQUARE PHASE 6 Vol. 77026, Pg. 0319
TRAFALGER SQUARE BLOCK A - PHASE 7 Vol. 79064, Pg. 1109
ABANDONED 100' T.P. & L. ESMT.
NORTH LINE OF R.R.
CITY OF CARROLLTON
CITY OF FARMERS BRANCH

LOCATION MAP

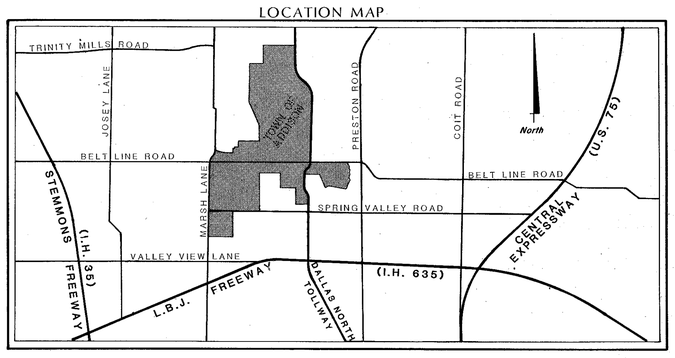

DETAIL "C"

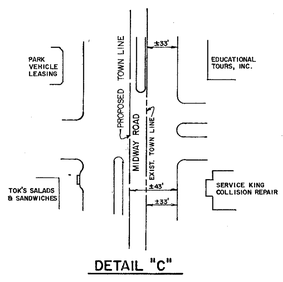

DETAIL "B"

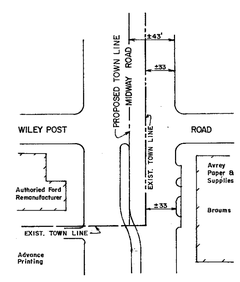

DETAIL "A"

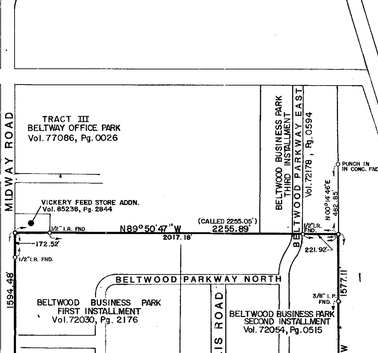

"DETAIL A"

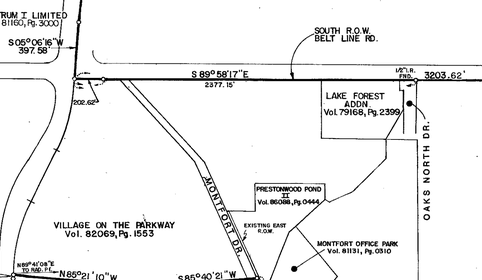

FIELD BOOK REFERENCE

NO.	DATE	REVISIONS	APP.
5			
4			
3			
2			
1			

GINN INC.

BOUNDARY SURVEY TOWN OF ADDISON

Geogram Corporation
Land Surveyors - Engineers

DRAWN BY: Doug Hall | SCALE: 1" = 500'
APPV'D. BY: RSH | DATE: JULY 1987
JOB NO.: 3343-55-001-100

SHEET NO. 1 OF 2