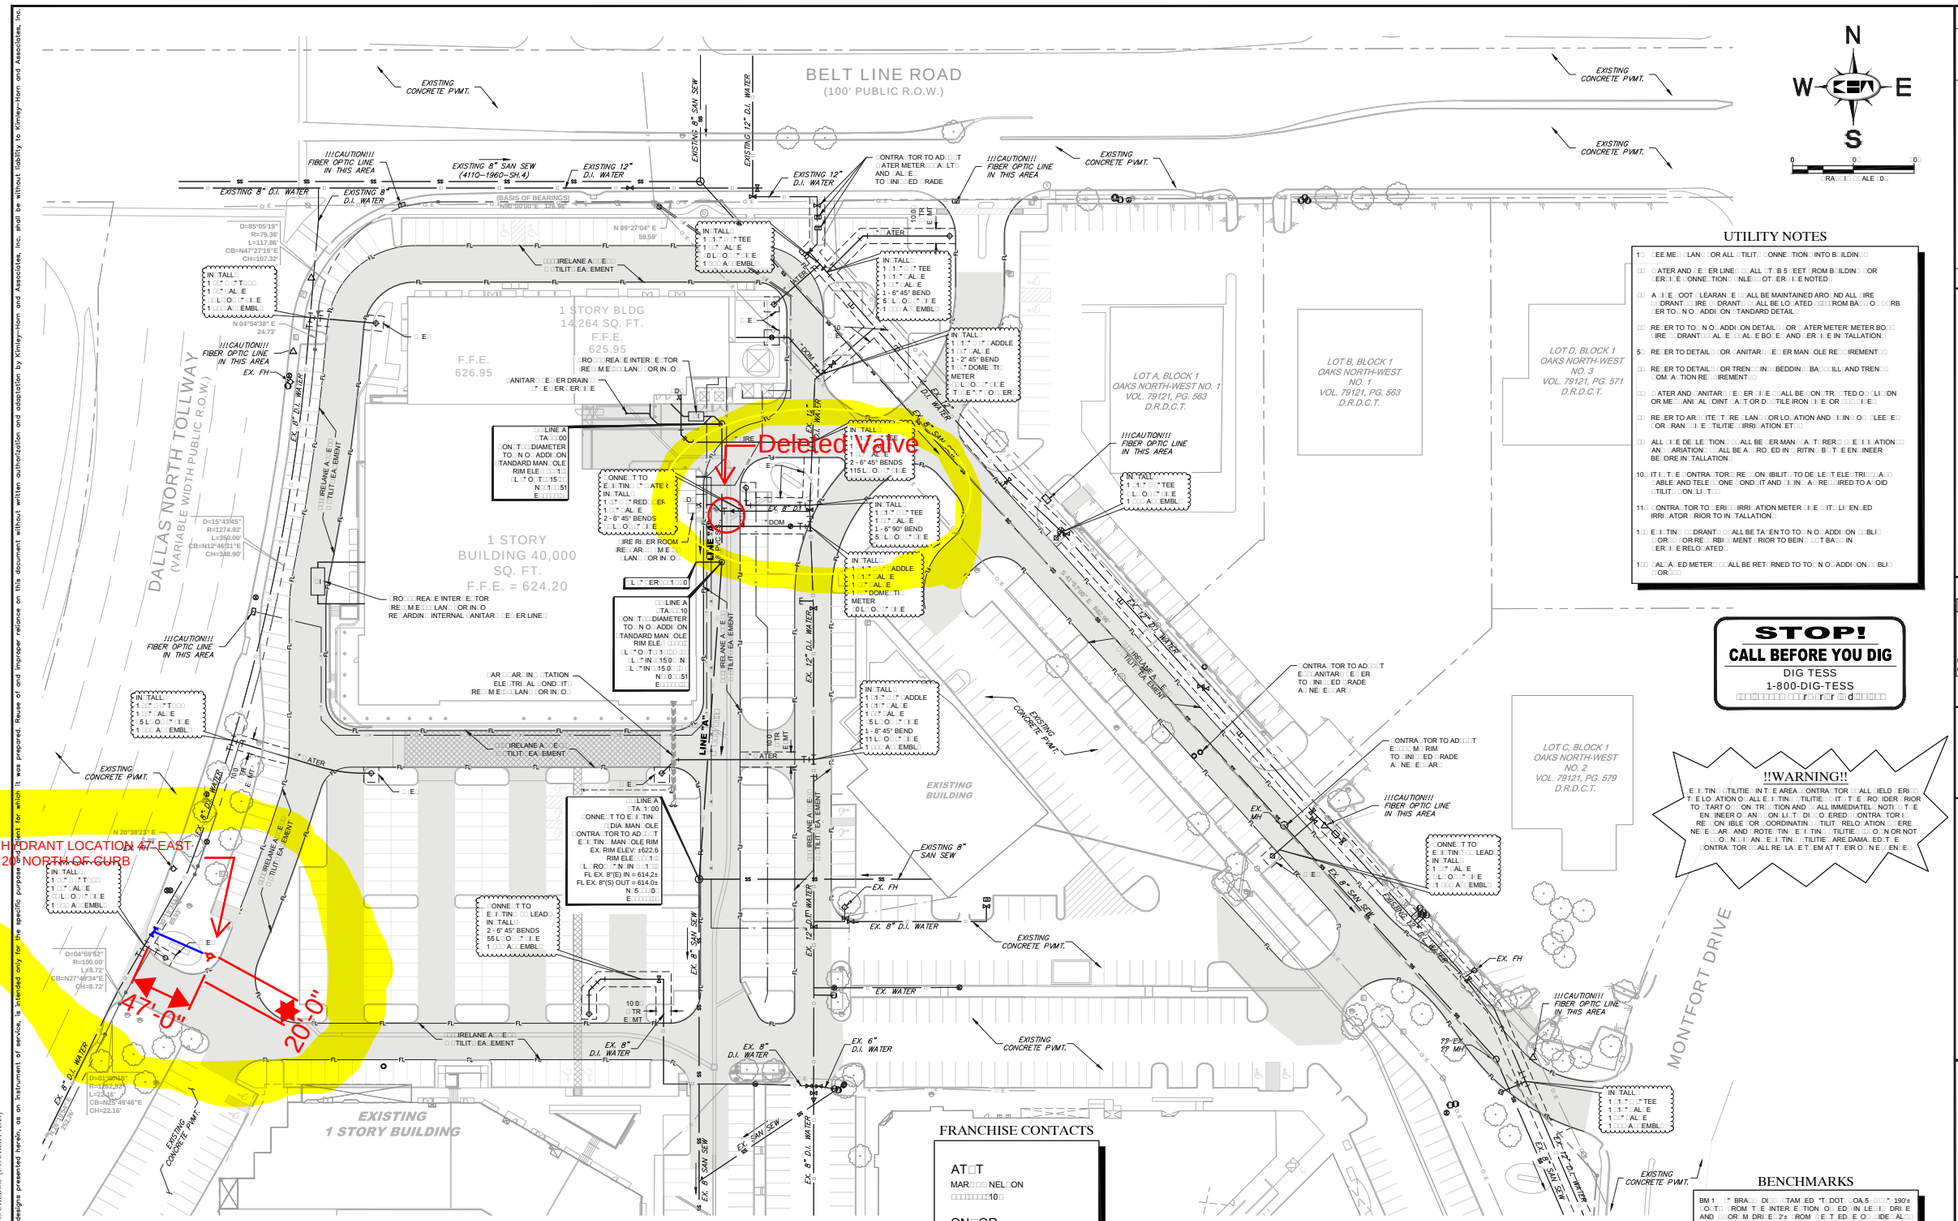

UTILITY NOTES

1. [illegible]EE ME[illegible]LAN[illegible]OR ALL [illegible]TILIT[illegible] [illegible]ONNE[illegible]TION[illegible]INTO B[illegible]ILDIN[illegible]
2. [illegible]ATER AND [illegible]E[illegible]ER LINE[illegible]ALL [illegible]T [illegible]B 5 [illegible]EET [illegible]ROM B[illegible]ILDIN[illegible]OR [illegible]ER [illegible]E[illegible]ONNE[illegible]TION[illegible]NLE[illegible]OT [illegible]ER [illegible] E NOTED.
3. A [illegible]E [illegible]OOT [illegible]LEARAN[illegible]E[illegible]ALL BE MAINTAINED ARO[illegible]ND ALL [illegible]IRE [illegible]DRANT[illegible]IRE [illegible]DRANT[illegible]ALL BE LO[illegible]ATED [illegible]ROM BA[illegible]O[illegible]RB [illegible]ER TO [illegible]N O[illegible]ADDI[illegible]ON [illegible]TANDARD DETAIL.
4. RE[illegible]ER TO TO[illegible]N O[illegible]ADDI[illegible]ON DETAIL[illegible]OR [illegible]ATER METER; METER BO[illegible] [illegible]IRE [illegible]DRANT[illegible]AL[illegible]E[illegible]AL[illegible]E BO[illegible]E; AND [illegible]ER [illegible]E IN[illegible]TALLATION.
5. RE[illegible]ER TO DETAIL[illegible]OR [illegible]ANITAR[illegible]E[illegible]ER MAN[illegible]OLE RE[illegible]IREMENT.
6. RE[illegible]ER TO DETAIL[illegible]OR TREN[illegible]IN[illegible]BEDDIN[illegible]BA[illegible]ILL AND TREN[illegible] [illegible]OM A[illegible]TION RE[illegible]IREMENT.
7. [illegible]ATER AND [illegible]ANITAR[illegible]E[illegible]ER [illegible]E [illegible]ALL BE [illegible]ON [illegible]TR[illegible]TED O[illegible]LI[illegible]ON OR ME[illegible]ANI[illegible]AL [illegible]OINT [illegible]A[illegible]T OR D[illegible]TILE IRON [illegible]E[illegible]OR [illegible]E.
8. RE[illegible]ER TO AR[illegible]ITE[illegible]T[illegible]RE[illegible]LAN[illegible]OR LO[illegible]ATION AND [illegible]IN[illegible]O[illegible] LEE[illegible]E[illegible] [illegible]OR [illegible]RAN[illegible]E[illegible]TILITIE[illegible]IRRI[illegible]ATION[illegible]ET.
9. ALL [illegible]E DE[illegible]LE[illegible]TION[illegible]ALL BE [illegible]ER MAN[illegible]A[illegible]T[illegible]RER[illegible]E[illegible]E[illegible]ATION[illegible] AN[illegible]ARIATION[illegible]ALL BE A[illegible]RO[illegible]ED IN [illegible]RTIN[illegible]B[illegible]T[illegible]E EN[illegible]INEER BE[illegible]ORE IN[illegible]TALLATION.
10. IT I[illegible]T[illegible]E [illegible]ONTRA[illegible]TOR[illegible]RE[illegible]ON[illegible]IBILIT[illegible] TO DE[illegible]LE[illegible]T ELE[illegible]TRI[illegible]A[illegible] [illegible]ABLE AND TELE[illegible]ONE[illegible]OND[illegible]IT AND [illegible]IN[illegible]A[illegible]RE[illegible]IRED TO A[illegible]OID [illegible]TILIT[illegible]ON LI[illegible]T.
11. [illegible]ONTRA[illegible]TOR TO [illegible]ER[illegible]IRRI[illegible]ATION METER [illegible]E [illegible]IT[illegible]LI[illegible]EN[illegible]ED IRRI[illegible]ATOR [illegible]RIOR TO IN[illegible]TALLATION.
12. [illegible]E[illegible]TIN[illegible] [illegible]DRANT[illegible]ALL BE TA[illegible]EN TO TO[illegible]N O[illegible]ADDI[illegible]ON [illegible]BLI[illegible] [illegible]OR [illegible]OR RE[illegible]RBI[illegible]MENT [illegible]RIOR TO BEIN[illegible]TBA[illegible]IN [illegible]ER [illegible]E RELO[illegible]ATED.
13. [illegible]AL[illegible]ED METER[illegible]ALL BE RET[illegible]RNED TO TO[illegible]N O[illegible]ADDI[illegible]ON [illegible]BLI[illegible] [illegible]OR.

STOP!
CALL BEFORE YOU DIG
DIG TESS
1-800-DIG-TESS

!!WARNING!!
E[illegible]TIN[illegible] [illegible]TILITIE[illegible]IN T[illegible]E AREA[illegible]ONTRA[illegible]TOR [illegible]ALL [illegible]IELD [illegible]ERI[illegible] T[illegible]E LO[illegible]ATION O[illegible]ALL E[illegible]TIN[illegible] [illegible]TILITIE[illegible] [illegible]IT [illegible]T[illegible]E [illegible]RO[illegible]IDER [illegible]RIOR TO [illegible]TART O[illegible]ON TR[illegible]TION AND [illegible]ALL IMMEDIATEL[illegible]NOTI[illegible]T[illegible]E EN[illegible]INEER O[illegible]AN[illegible] [illegible]ON LI[illegible]T[illegible] DI[illegible]O[illegible]ERED [illegible]ONTRA[illegible]TOR I[illegible] RE[illegible]ON IBLE [illegible]OR [illegible]OORDINATIN[illegible] [illegible]TILIT[illegible] RELO[illegible]ATION [illegible]ERE NE[illegible]E[illegible]AR[illegible] AND [illegible]ROTE[illegible]TIN[illegible] E[illegible]TIN[illegible] [illegible]TILITIE[illegible] [illegible]O[illegible]N OR NOT [illegible]O[illegible] N[illegible]T[illegible]AN[illegible] E[illegible]TIN[illegible] [illegible]TILITIE[illegible] ARE DAMA[illegible]ED T[illegible]E [illegible]ONTRA[illegible]TOR [illegible]ALL RE[illegible]LA[illegible]E T[illegible]EM AT T[illegible]ER O[illegible]NE[illegible]EN[illegible]E.

FRANCHISE CONTACTS

AT□T
MAR□□□NEL□ON
□□□□□□□10□

ON□OR
□AREN EA□TMAN
□1□□□55□050

ATMO□
□AR□ DI□□IN□ON
□□□□□0□□□□

TIME □ ARNER □ABLE
DA□E □□ENE□
□1□□□0□□0□

NOTE

□RIOR TO □ON□TR□□TION□ONTRA□TOR TO NOTI□□ EN□INEER IMMEDIATEL□□O□LD T□ERE BE AN□ DI□□RE□AN□IE□OR I□E□I□TIN□□IELD□ONDITION□ □AR□□ROM T□O□E□□O□N ON T□E□E□LAN□□

FIRE SPRINKLER NOTE

□IRE□□RIN□LER LINE□□ALL BE □□ED AND IN□TALLED B□A□TATE LI□EN□ED □IRE□□RIN□LER □ONTRA□TOR

BENCHMARKS

BM 1 [illegible]" BRA[illegible] DI[illegible] [illegible]TAM□ED "T□DOT □OA.5 [illegible]" 190'± [illegible]O□T□ [illegible]ROM T□E INTER□E□TION O□ED□IN LE□□ DRI□E AND [illegible]OR□M DRI□E 2'± [illegible]ROM [illegible]E□T ED□E O□ [illegible]IDE AL□□ 50.5'± [illegible]ROM T□E [illegible]E□T [illegible]IDE O□ MEDIAN IN [illegible]OR□M DRI□E 76'± FROM FIRE HYDRANT.

ELE[illegible]0.10

BM [illegible]" BRA[illegible] DI[illegible] [illegible]TAM□ED "T□DOT □OA.10 [illegible]" AT T□E NORT□E□T [illegible]ORNER O[illegible]A□EN□IRE [illegible]LA□E AND BELLBROO□DRI□E 21.80± [illegible]ROM □ANITAR□□E□ER MAN□OLE 11.10'± FROM STREET SIGN & 2.45± TO PC IN SIDEWALK.

ELE[illegible]5[illegible]

BM [illegible]IT□O□DALLA□□ATER DE□T□BEN□□MAR□□"□" ON □ON□RETE BA□E O□ [illegible]BB[illegible] [illegible]ALL AT T□E NORT□EA□T □ORNER O[illegible]ELE□TIAL ROAD AND MONT□ORT DRI□E.

ELE[illegible]1

No.	DATE	BY

REVISIONS

Kimley-Horn and Associates, Inc.
State of Texas Registration No. F-928
5750 GENESIS COURT, SUITE 200, FRISCO, TX 75034
PHONE: 972-335-3580 FAX: 972-335-3779
WWW.KIMLEY-HORN.COM

PRELIMINARY
FOR REVIEW ONLY
Not for construction or permit purposes.
Kimley-Horn and Associates, Inc.
Engineer ROY BRASWELL
P.E. No. 104908 Date 08/17/2012

KHA PROJECT 063190038
DATE 08/17/2012
SCALE AS SHOWN
DESIGNED BY TBB
DRAWN BY AJE
CHECKED BY TBB

VILLAGE ON THE PARKWAY
ADDISON, TEXAS

UTILITY PLAN

SHEET NUMBER
C-13

This document, together with the concepts and designs presented herein, as an instrument of service, is intended only for the specific purpose and client for which it was prepared. Reuse of and improper reliance on this document without written authorization and adaptation by Kimley-Horn and Associates, Inc. shall be without liability to Kimley-Horn and Associates, Inc.

EXHIBIT NAME: E:\KHCI\VILLAGE ON THE PARKWAY\DWG\PLAN SET\C-13-UTILITY PLAN.DWG
LAYOUT NAME: C-13 UTILITY PLAN
LAST SAVED: 8/20/2012 2:02 PM

SCALE: 1"=40'
UTILITY PLAN C-13

Good Fulton & Farrell Architects
2808 Fairmount Street
Suite 300
Dallas, Texas 75201
214.303.1500/Tel
214.303.1512/Fax
www.gff.com

© Good Fulton & Farrell 2009

VILLAGE ON THE PARKWAY
5100 BELT LINE ROAD
Addison, Texas 75254
ISSUE FOR PERMIT

No.	Date	Item
3	08.17.12	ASI #1
2	06.14.12	ADDENDUM #2

REVISIONS

Drawn
Checked
Approved

UTILITY PLAN

Project No.	11013.03
Date	05.25.12
Last Revision	06.14.12

C-13