This document, together with the concepts and designs presented herein, as an instrument of service, is intended only for the specific purpose and client for which it was prepared. Reuse of and improper reliance on this document without written authorization and adaptation by Kimley-Horn and Associates, Inc. shall be without liability to Kimley-Horn and Associates, Inc.

PLOTTED BY LUCIO, RAMIRO 6/14/2013 3:55 PM
DWG NAME K:\FRI_CIVIL\063190\8-VOP\DWG\PLAN SET\BELT LINE ROAD\C-08-BL-DETAILS.DWG [C:\8-TOWN OF ADDISON PAVING DETAILS ]
LAST SAVED 6/12/2013 12:12 PM

**RECORD DRAWINGS**
**(October 2013)**

**INFORMATION PROVIDED BY:**
**Bob Moore Construction**

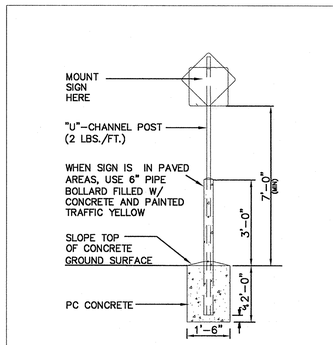


STANDARD SIGN BASE
N.T.S.

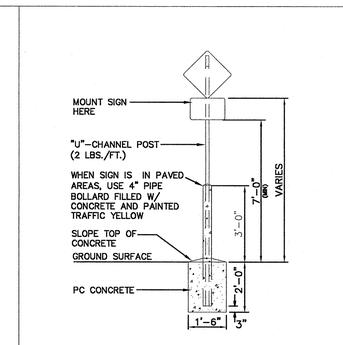


STANDARD PEDESTRIAN CROSSING SIGN BASE
N.T.S.

Kimley-Horn and Associates, Inc.
State of Texas Registration No. F-928
5750 GENESIS COURT, SUITE 200, FRISCO, TX 75034
PHONE: 972-335-3580 FAX: 972-335-3779
WWW.KIMLEY-HORN.COM

| No. | REVISIONS | DATE | BY |
|---|---|---|---|

STATE OF TEXAS
ROY BRASWELL
104908
LICENSED
PROFESSIONAL ENGINEER
6/14/13

KHA PROJECT 063190038
DATE 06/14/2013
SCALE AS SHOWN
DESIGNED BY TBB
DRAWN BY AAE
CHECKED BY TBB

CITY OF DALLAS 311T - 8155
BELT LINE ROAD
IMPROVEMENTS
VILLAGE ON THE PARKWAY
ADDISON, TEXAS

# CONSTRUCTION DETAILS II

SHEET NUMBER
C-08