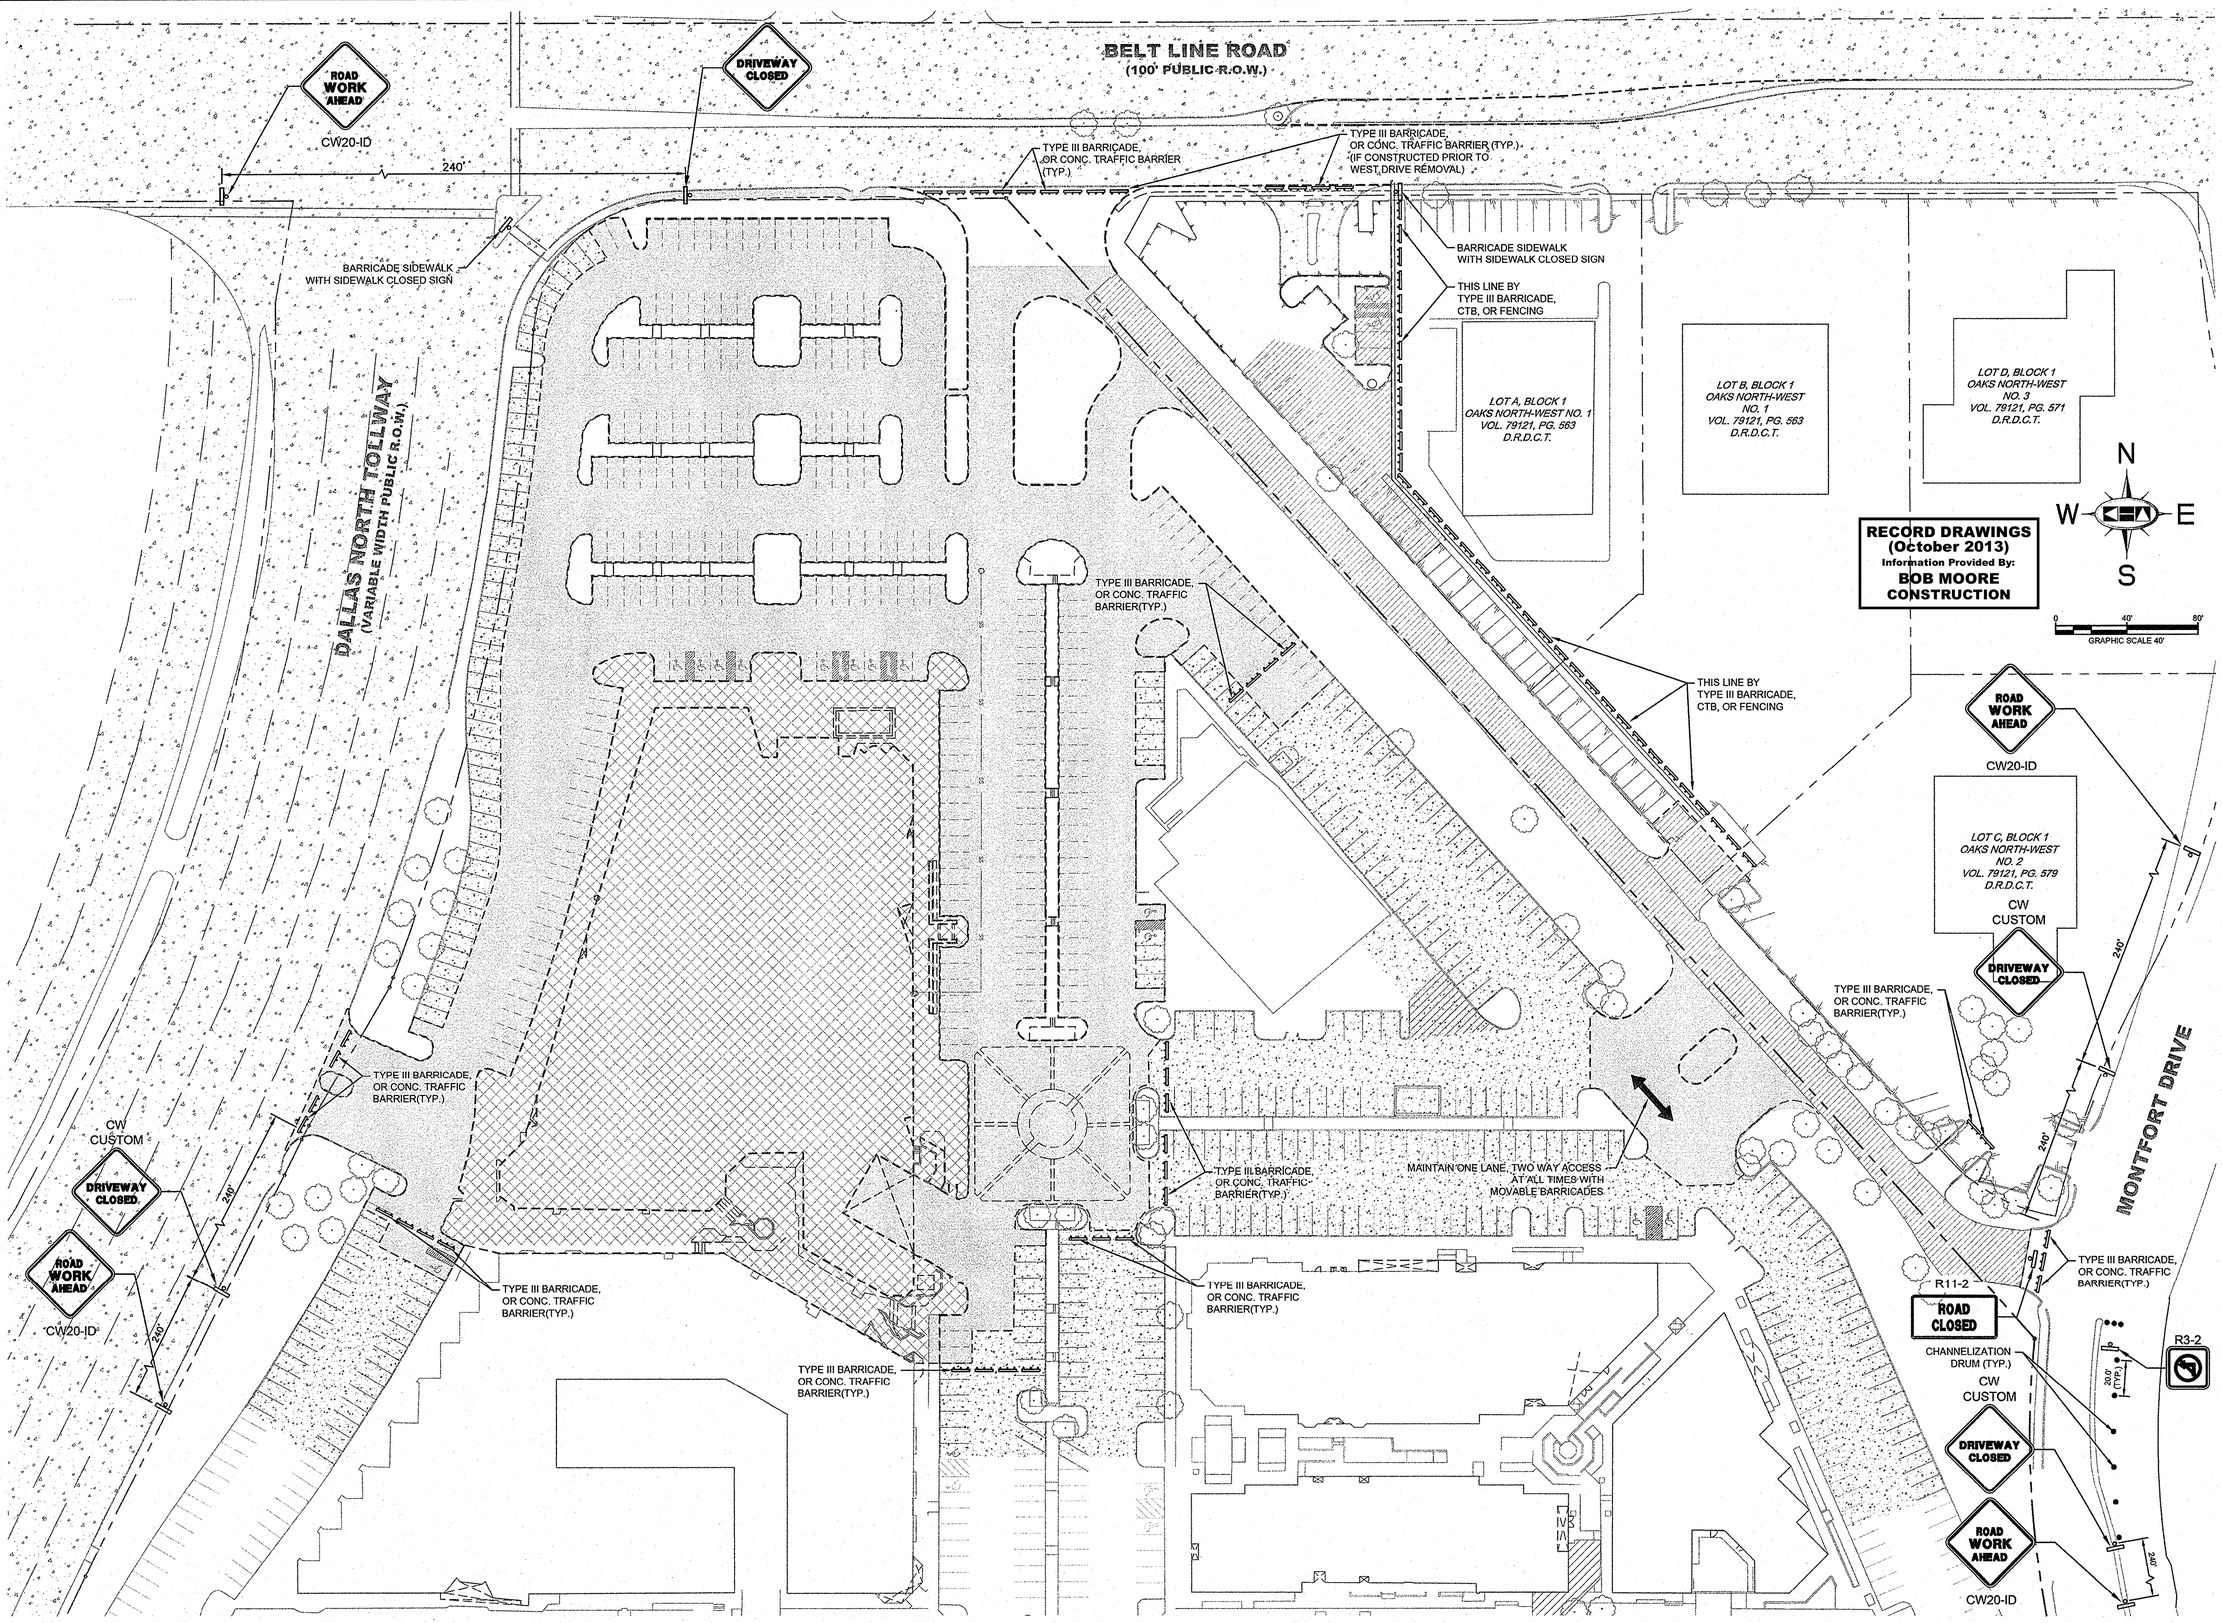

No.	REVISIONS	DATE	BY

Kimley-Horn and Associates, Inc.
State of Texas Registration No. F-928
5750 GENESIS COURT, SUITE 200, FRISCO, TX 75034
PHONE: 972-335-3580 FAX: 972-335-3779
WWW.KIMLEY-HORN.COM

STATE OF TEXAS
ROY BRASWELL
104908
LICENSED PROFESSIONAL ENGINEER
9/27/12

KHA PROJECT 063319038
DATE 9/27/2012
SCALE AS SHOWN
DESIGNED BY TBB
DRAWN BY AAE
CHECKED BY TBB

VILLAGE ON THE PARKWAY
ADDISON, TEXAS

ON-SITE TRAFFIC CONTROL PLAN

SHEET NUMBER
C-16

PLOTTED BY MAURICIO, MARLA 9/27/2012 8:58 AM
DWG NAME K:\FRI_CTV\11063319038-VOP\DWG\PLAN SET\C-16-TCP-ONSITE.DWG [C-16 TRAFFIC CONTROL PLAN ONSITE]
LAST SAVED 9/27/2012 8:31 AM
This document, together with the concepts and designs presented herein, as an instrument of service, is intended only for the specific purpose and client for which it was prepared. Reuse of and improper reliance on this document without written authorization and adaptation by Kimley-Horn and Associates, Inc. shall be without liability to Kimley-Horn and Associates, Inc.