


No.	DATE	BY

Kimley-Horn and Associates, Inc.
 State of Texas Registration No. F-928
 5750 GENESIS COURT, SUITE 200, FRISCO, TX 75034
 PHONE: 972-335-5580 FAX: 972-335-3779
 WWW.KIMLEY-HORN.COM

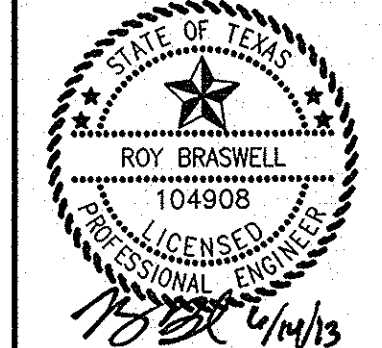

KHA PROJECT: 063319038
 DATE: 06/14/2013
 SCALE: AS SHOWN
 DESIGNED BY: TBB
 DRAWN BY: AAE
 CHECKED BY: TBB

VILLAGE ON THE PARKWAY PHASE II
 ADDISON, TEXAS

TOWN OF ADDISON SANITARY SEWER DETAILS