


GRADING NOTES
REFER OVERALL PAVING LAYOUT PLAN FOR GRADING GENERAL NOTES

STORM DRAIN NOTES
REFER OVERALL STORM DRAIN LAYOUT PLAN FOR STORM DRAIN GENERAL NOTES

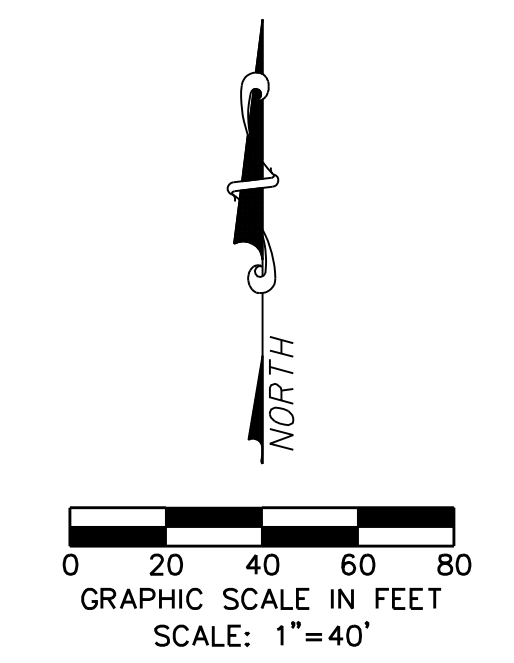

WARNING
CONTRACTOR IS TO CONTACT TEXAS ONE-CALL SYSTEM (1-800-245-4545) OR OTHER UTILITY LOCATING SERVICES AT LEAST 48 HOURS PRIOR TO CONSTRUCTION ACTIVITIES. ICON CONSULTING ENGINEERS, INC. IS NOT RESPONSIBLE FOR KNOWING ALL EXISTING UTILITIES IN THE PROJECT AREA NOR FOR DEPICTING THE EXACT LOCATIONS OF UTILITIES ON THESE DRAWINGS.

BM #1 REF. ELEVATION = 559.47
SQUARE CUT IN TOP OF CURB, SOUTH MEDIAN END NOSE, MARSH LANE 1127' NORTH OF VITRUVIAN WAY.

BM #2 REF. ELEVATION = 547.84
SQUARE CUT IN TOP OF CURB, NORTH MEDIAN END NOSE, AT INTERSECTION OF VITRUVIAN WAY AND MARSH LANE.



LAYOUT, DIMENSION, PAVING, STREET LIGHT & CONDUIT PLAN

GRADING & DRAINAGE PLAN

GRADING & PAVING NOTES
REFER OVERALL PAVING LAYOUT PLAN FOR GRADING & PAVING GENERAL NOTES

PAVEMENT JOINTING NOTES
REFER OVERALL PAVING LAYOUT PLAN FOR PAVEMENT JOINTING GENERAL NOTES

LAYOUT & DIMENSIONAL CONTROL PLAN
REFER OVERALL PAVING LAYOUT PLAN FOR LAYOUT & DIMENSIONAL CONTROL GENERAL NOTES

STREET LIGHTING AND CONDUIT NOTES
REFER TO STREET LIGHT AND CONDUIT PLANS FOR STREET LIGHT AND CONDUIT NOTES

PAVEMENT MARKINGS & SIGNAGE
REFER TO OVERALL VW & PA PAVEMENT MARKING PLANS FOR PAVEMENT MARKING & SIGNAGE NOTES

LEGEND

STANDARD DUTY PAVEMENT:
6" (4200 PSI AT 28 DAYS) CONCRETE PAVT. W/ #3 BARS @ 24" O.C.E.W. ON 6" COMPACTED SUBGRADE TO 95% AT OR ABOVE OPTIMUM MOISTURE CONTENT (ASTM D 698) WITH 6" CURB.

SIDEWALK & FLATWORK:
4" REINFORCED CONCRETE SIDEWALKS & FLATWORK (3000 PSI AT 28 DAYS) W/ #3 BARS @ 18" O.C.E.W. ON 6" COMPACTED SUBGRADE TO 95% AT OR ABOVE OPTIMUM MOISTURE CONTENT (ASTM D 698). REFERENCE LANDSCAPE PLANS.

NOTE
FIRELANE MARKING SHALL CONSIST OF 4" SOLID RED STRIPE WITH "NO PARKING - FIRE LANE" STENCILED IN WHITE PAINT AT 25' INTERVALS.

STREET LIGHT LEGEND

PVC CONDUIT (LIGHTING) ———

PVC CONDUIT (POWER) ———

TRANSFORMER ON PAD * [Symbol]

STREET LIGHT - 400W [Symbol]

STREET LIGHT - FUTURE 400W [Symbol]

STREET LIGHT - 100W [Symbol]

STREET LIGHT - FUTURE 100W [Symbol]

DUPLEX 20A GFI RECEPTACLE [Symbol]

* PROVIDE!

NO.	REVISION	BY	DATE

ADDISON TOWN OF ADDISON
DALLAS COUNTY, TEXAS

PAVING, DRAINAGE & UTILITY IMPROVEMENTS
VITRUVIAN WAY & PONTE AVENUE

PAVING, CONDUIT, GRADING & DRAINAGE
PARK ROAD

icon Consulting Engineers, Inc. 250 W. Southlake Blvd., Suite 117
Civil Engineers - Designers - Planners Southlake, TX 76092 (817) 552-6210

PROJECT	DESIGN	DRAWN	DATE	FILE	SHEET
5029-01	ICE	ICE	MAY 7 2009	PW# 2009-01	25