



NOTE:
CONTRACTOR SHALL CONFIRM THICKNESS OF FINAL PAVER SELECTION PRIOR TO POURING DROP SLABS IN THE SIDEWALKS OR STREETS

STREET PAVERS ON CONCRETE DROP SLAB
N.T.S.

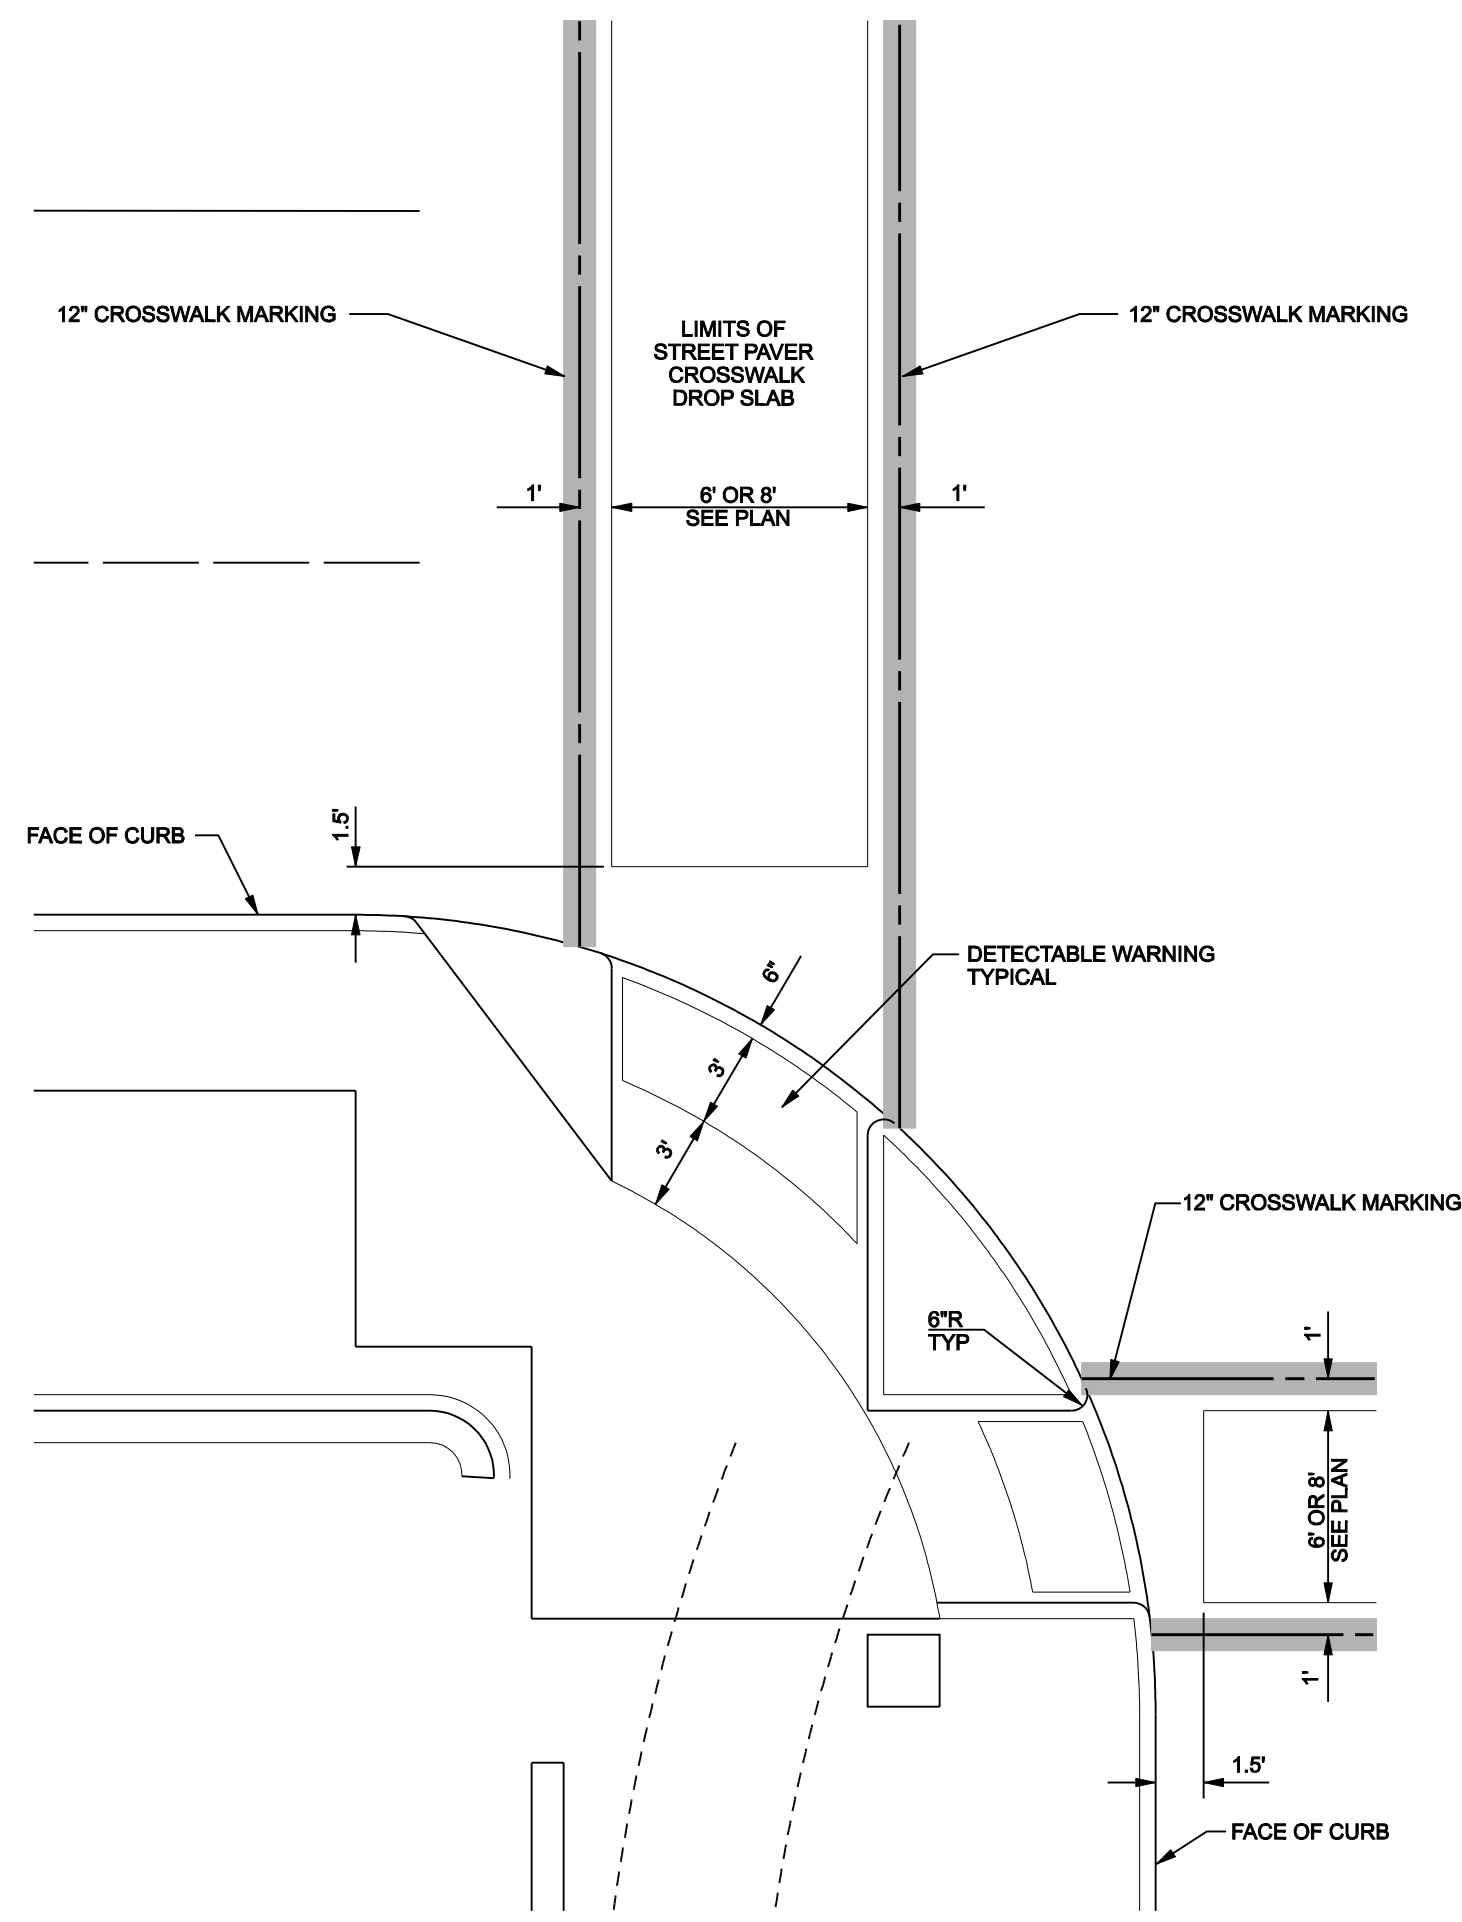


TYPICAL CROSSWALK STREET PAVER DROP SLAB
N.T.S.

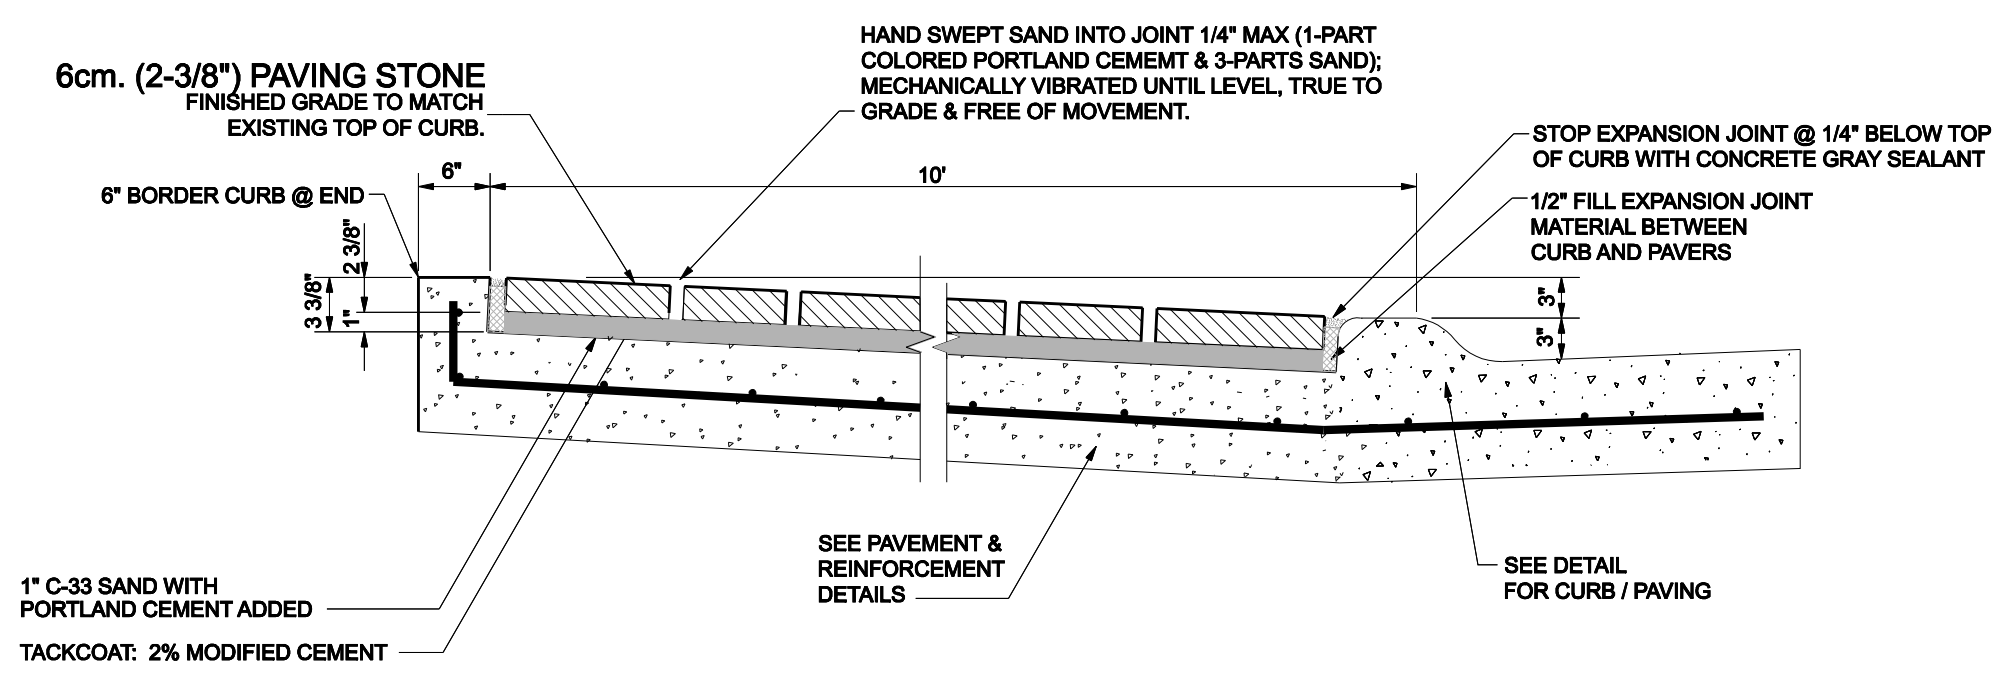


NOTE:
CONTRACTOR SHALL CONFIRM THICKNESS OF FINAL PAVER SELECTION PRIOR TO POURING DROP SLABS IN THE SIDEWALKS OR STREETS


TYPICAL CROSS SECTION
N.T.S.

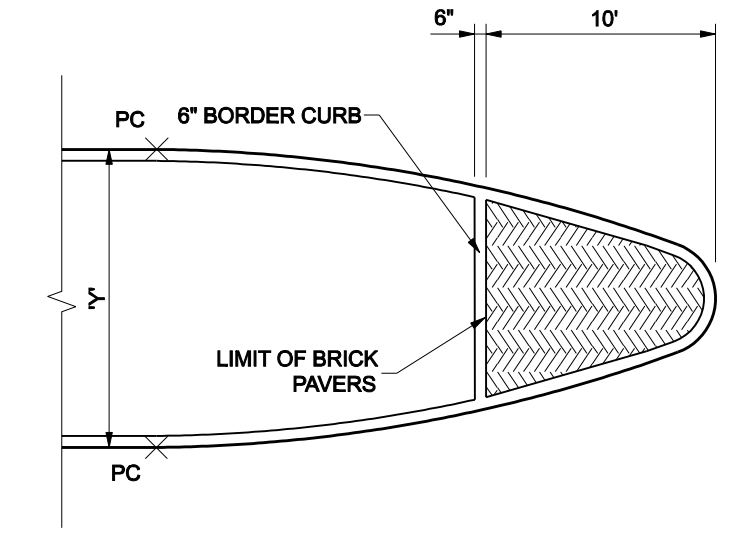

DETAIL FOR MEDIAN NOSE TREATMENT WIDER THAN 6' (Y>6')
N.T.S.

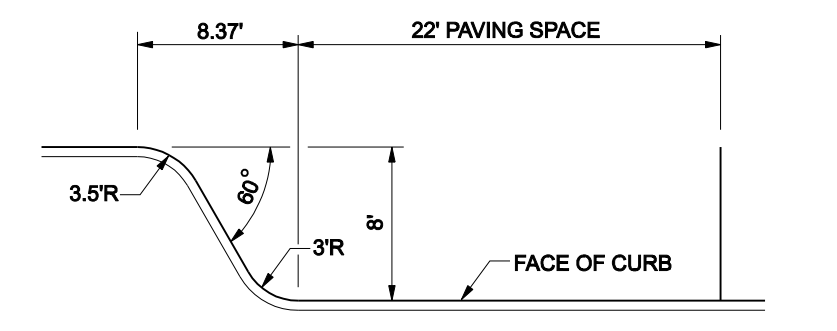

TYPICAL PARALLEL PARKING TRANSITION
NOT TO SCALE

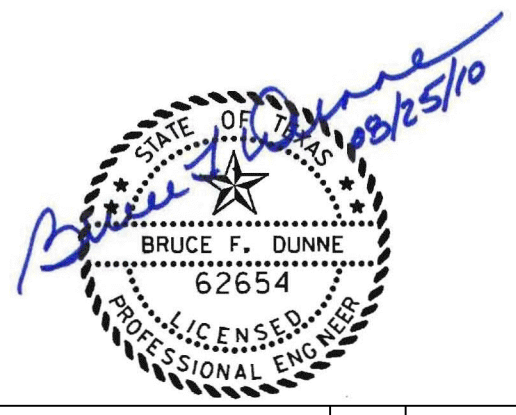

NO.	REVISION	BY	DATE

Addison! TOWN OF ADDISON
DALLAS COUNTY, TEXAS
PAVING, DRAINAGE & UTILITY IMPROVEMENTS
VITRUVIAN WAY & PONTE AVENUE

PAVING DETAILS

icon Consulting Engineers, Inc. 250 W. Southlake Blvd., Suite 117
Civil Engineers - Designers - Planners Southlake, Tx 76092 (817) 552-6210

PROJECT	DESIGN	DRAWN	DATE	FILE	SHEET
5029-01	ICE	ICE	MAY 7 2009	PW# 2009-01	29

PAVING, DRAINAGE, & UTILITY IMPROVEMENTS - VITRUVIAN WAY & PONTE AVENUE