
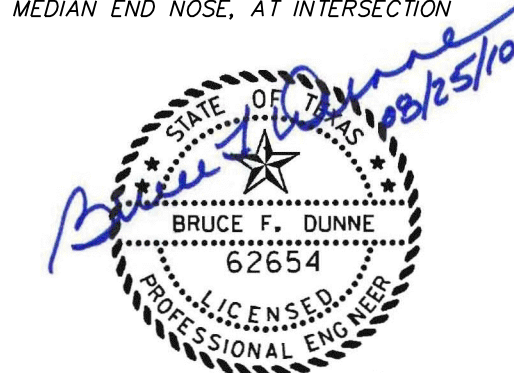


**BM #1 REF. ELEVATION = 559.47**  
 SQUARE CUT IN TOP OF CURB, SOUTH MEDIAN END NOSE, MARSH LANE 1127' NORTH OF VITRUVIAN WAY.

**BM #2 REF. ELEVATION = 547.84**  
 SQUARE CUT IN TOP OF CURB, NORTH MEDIAN END NOSE, AT INTERSECTION OF VITRUVIAN WAY AND MARSH LANE.

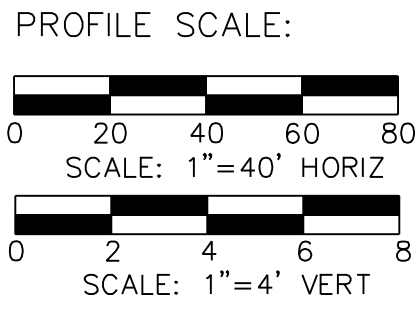

NO.		REVISION		BY		DATE	
<b>TOWN OF ADDISON</b> DALLAS COUNTY, TEXAS							
<b>PAVING, DRAINAGE &amp; UTILITY IMPROVEMENTS</b> VITRUVIAN WAY & PONTE AVENUE							
<b>STORM DRAIN PLAN &amp; PROFILE-PA</b> LINES B1 & C1							
<b>icon</b>		Consulting Engineers, Inc.		250 W. Southlake Blvd., Suite 117		Southlake, Tx 76092 (817) 552-6210	
PROJECT	DESIGN	DRAWN	DATE	FILE	SHEET		
5029-01	ICE	ICE	MAY 7 2009	PW# 2009-01	37		

PAVING, DRAINAGE, & UTILITY IMPROVEMENTS - VITRUVIAN WAY & PONTE AVENUE