




25+00.00

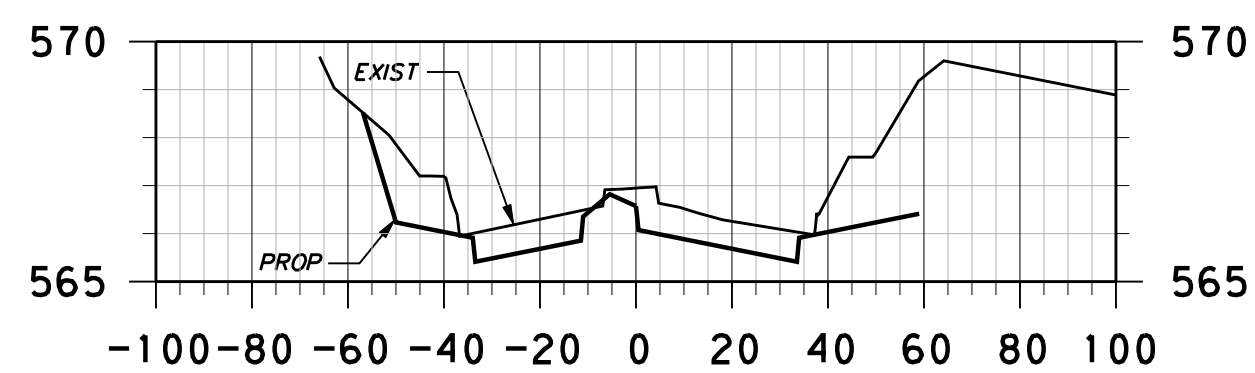


27+00.00

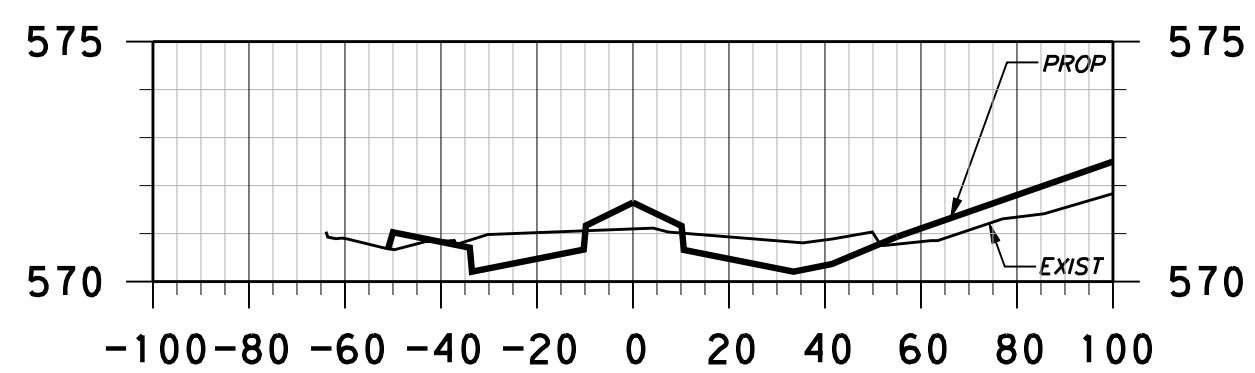


29+00.00

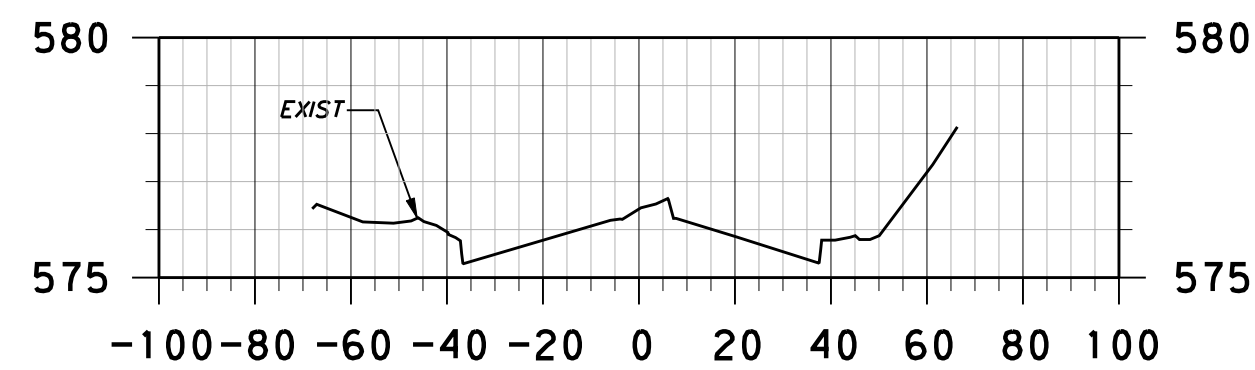


31+00.00

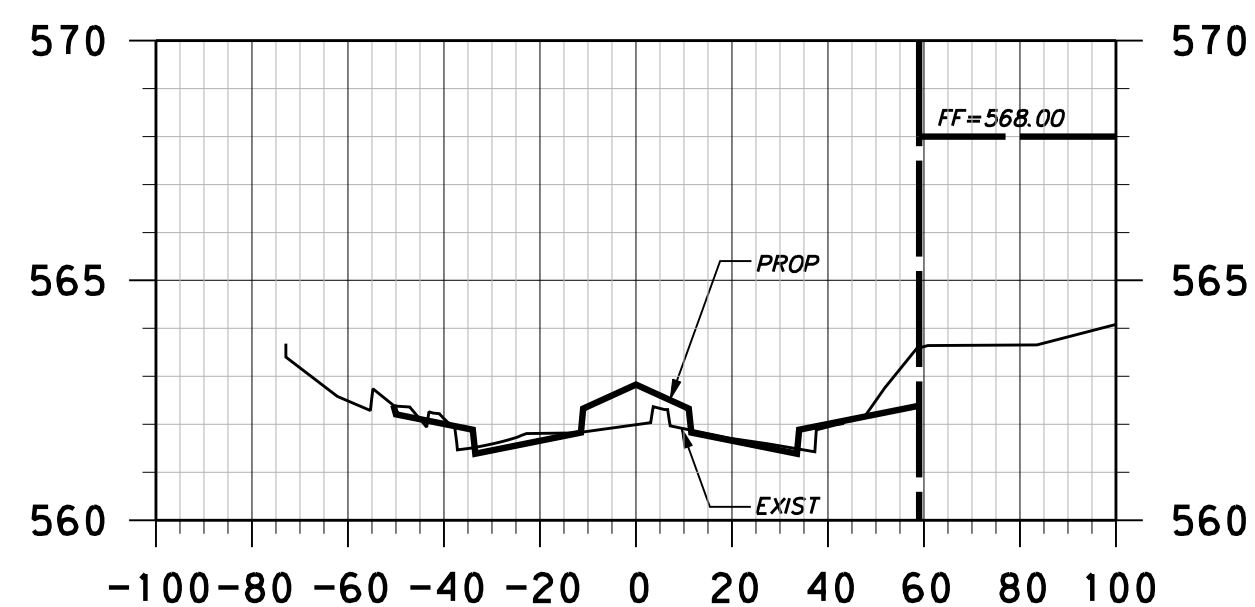


24+50.00

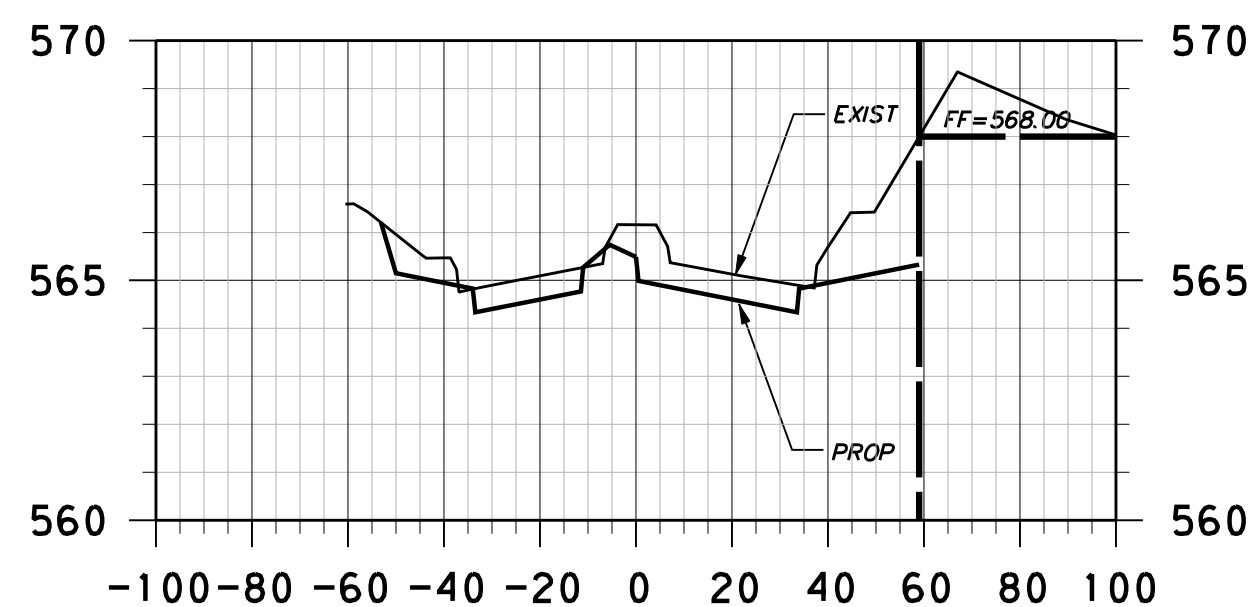


26+50.00

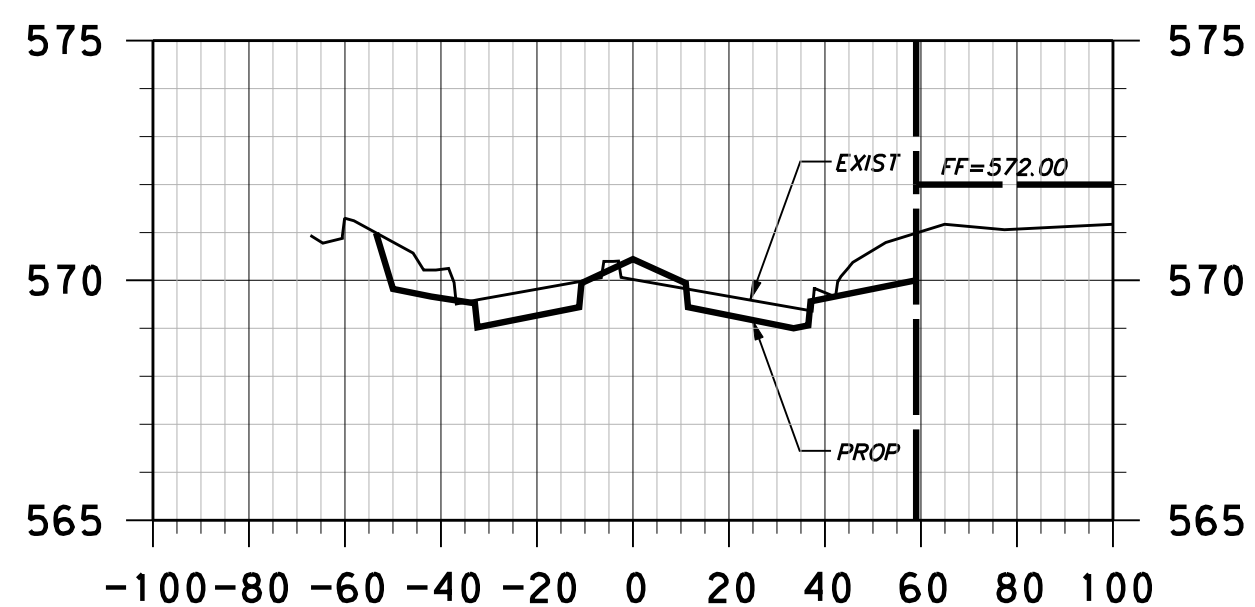


28+50.00

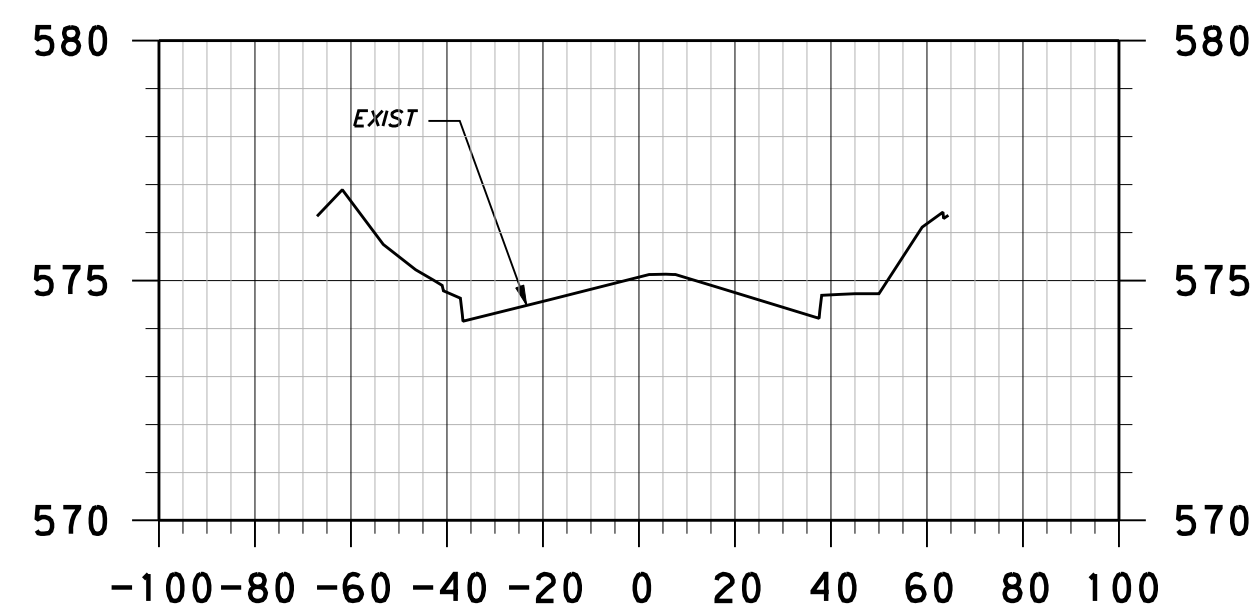


30+50.00

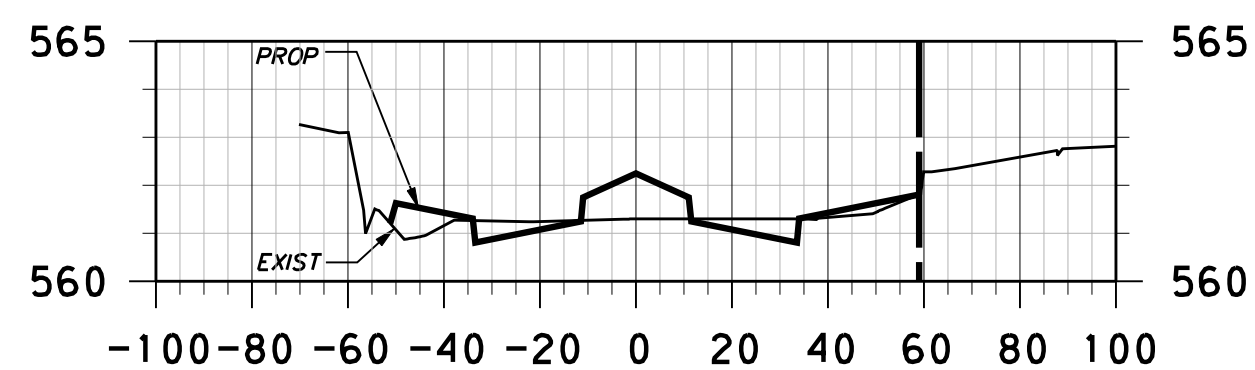


24+00.00

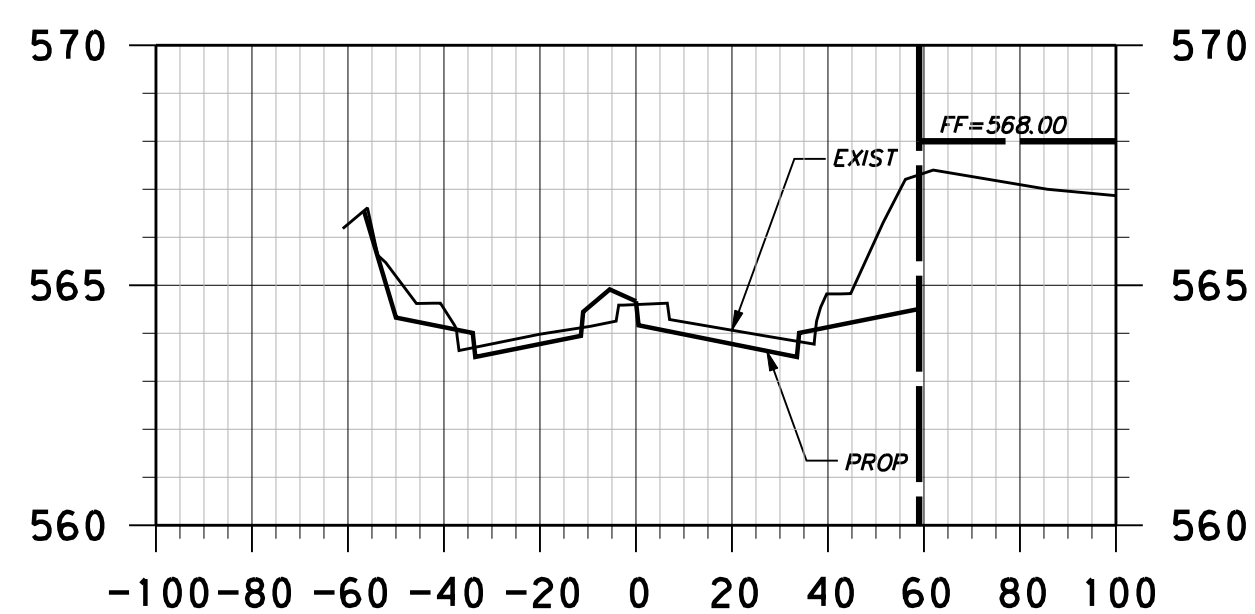


26+00.00

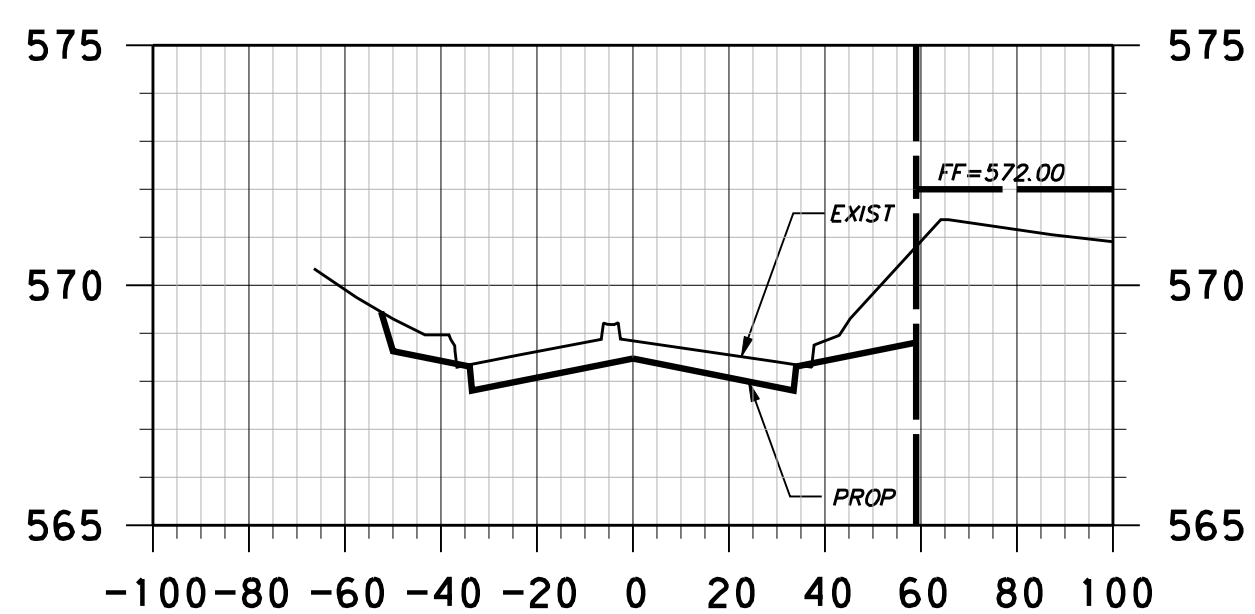


28+00.00

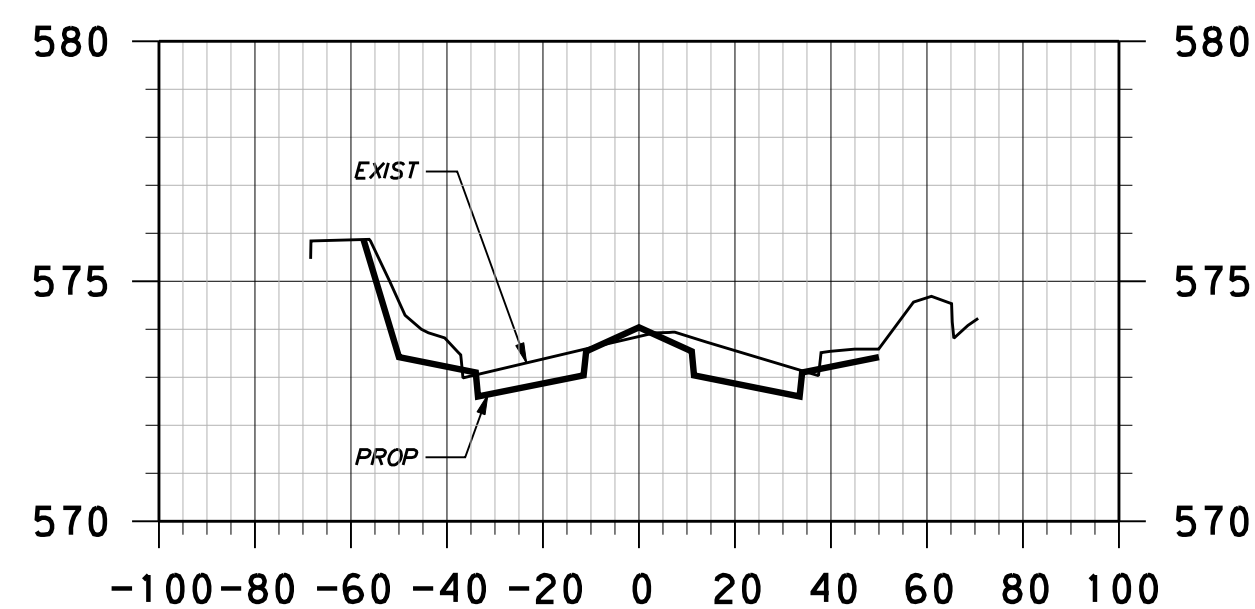


30+00.00

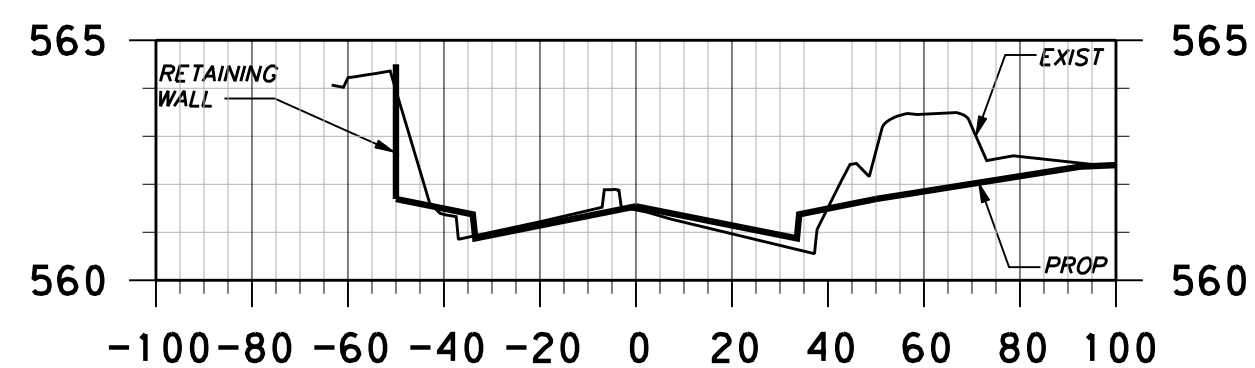


23+50.00

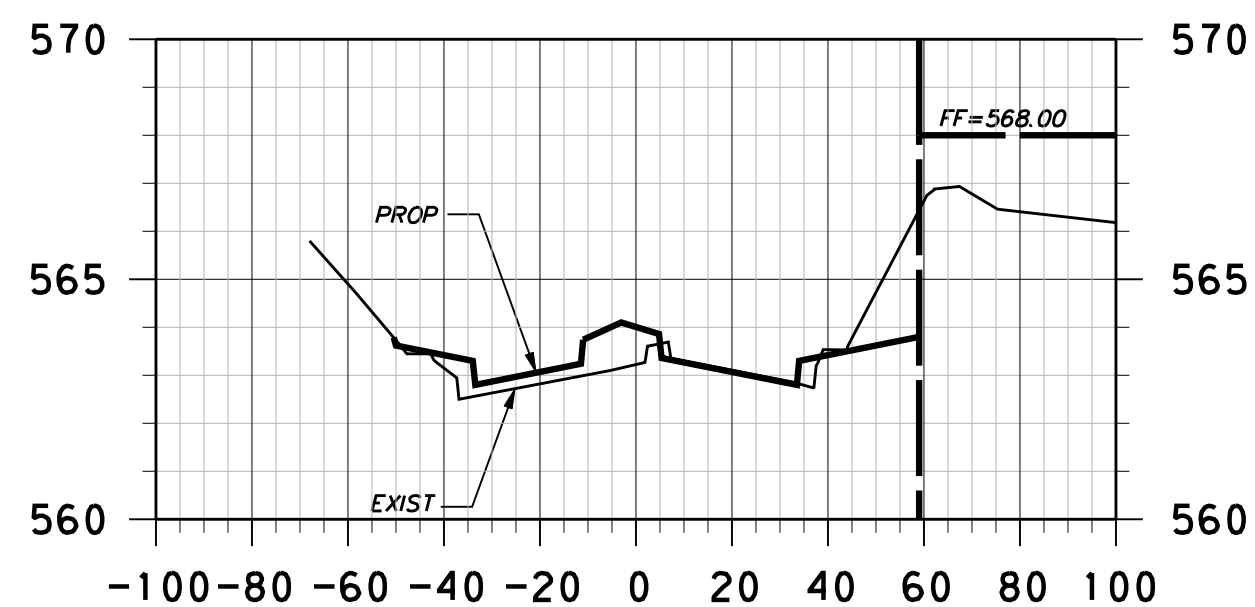

25+50.00

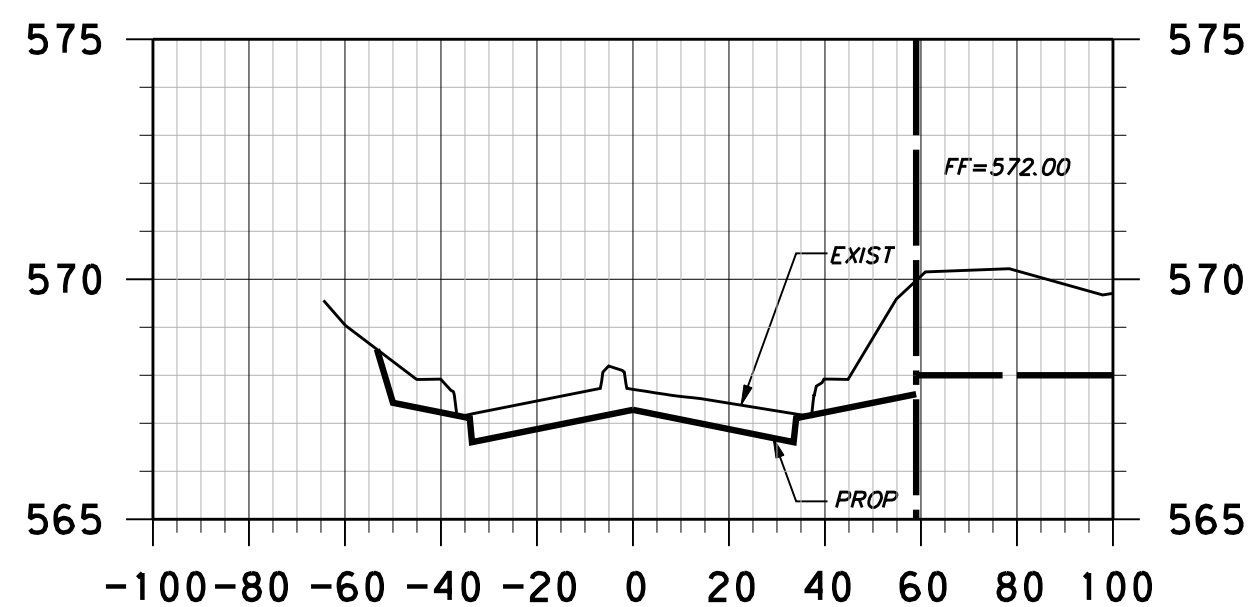


27+50.00

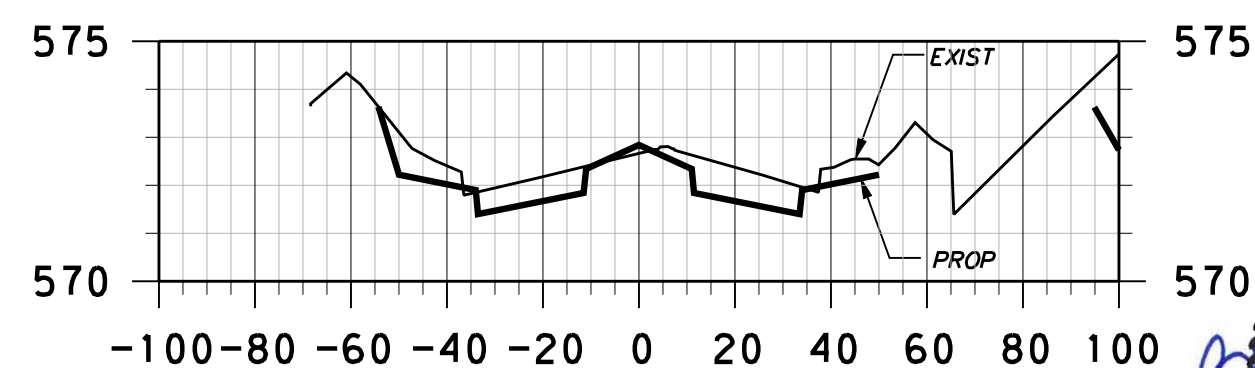

29+50.00

PROFILE SCALE:

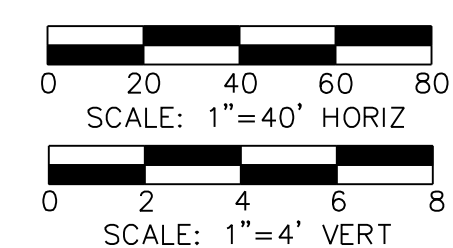

NO.	REVISION	BY	DATE

**Addison!** TOWN OF ADDISON  
DALLAS COUNTY, TEXAS  
PAVING, DRAINAGE & UTILITY IMPROVEMENTS  
VITRUVIAN WAY & PONTE AVENUE

**CROSS-SECTIONS-VW**  
STA 23+50.00 TO STA 31+00.00

<b>icon</b> Consulting Engineers, Inc. Civil Engineers - Designers - Planners	250 W. Southlake Blvd., Suite 117 Southlake, Tx 76092 (817) 552-6210				
PROJECT: 5029-01	DESIGN: ICE	DRAWN: ICE	DATE: MAY 7 2009	FILE: PW# 2009-01	SHEET: 94

PAVING, DRAINAGE, & UTILITY IMPROVEMENTS - VITRUVIAN WAY & PONTE AVENUE