

GRADING NOTES:

- No walk or ramp cross slopes shall exceed 2.0%.
- No walk longitudinal slope shall exceed 5.0%.
- No ramp longitudinal slope shall exceed 8.33%.
- Curb ramps shall be constructed at a maximum longitudinal slope of 8.33% and a maximum cross slopes of 2.0%. Length to be determined in field.


- MATERIALS LEGEND**
- ① PIP concrete paving
ref. Civil, Structural
 - ② PIP concrete band
ref. Plan for width
 - ③ 6" concrete curb
ref. Civil
 - ④ Stop bar
ref. Civil
 - ⑤ Pavestone City Stone I
2 3/8" thickness Travertine Blend color
on 4" concrete base ref. Civil
 - ⑥ Not Used
 - ⑦ Pavestone City Stone I
3 1/8" thickness Travertine Blend color
on 4" concrete base ref. Civil
 - ⑧ Pavestone City Stone I
3 1/8" thickness Bellows Brown color
on 4" concrete base ref. Civil
 - ⑨ Not used
 - ⑩ Pavestone ADA Concrete Paver
running bond pattern Bellows Brown color
on 4" concrete base ref. Civil
 - ⑪ Traffic signal
ref. Traffic Engineer
 - ⑫ Manhole cover
ref. Civil
 - ⑬ Not Used
 - ⑭ Storm drain inlet
ref. Civil
 - ⑮ 18" concrete gutter
ref. Civil

ISSUED
FOR
CONSTRUCTION

KEVIN SLOAN STUDIO

Landscape Architect: KEVIN W. SLOAN
Lic. No. 2296 Date 8/17/09

| | | | |
|---|----------|--|----------|
| NO. | REVISION | BY | DATE |
| | | | |
| <p style="margin: 0;">TOWN OF ADDISON DALLAS COUNTY, TEXAS</p> | | | |
| <p style="margin: 0;"><i>PAVING, DRAINAGE & UTILITY IMPROVEMENTS</i> VITRUVIAN WAY AND PONTE AVENUE</p> | | | |
| <p style="margin: 0;">VW Hardscape - Central Crosswalk Enlargements</p> | | | |
| <p style="margin: 0;">KEVIN SLOAN STUDIO</p> | | 4145 Travis, Suite 105 Dallas, Texas 75204 (214) 379-1061 | |
| PROJECT | DESIGN | DRAWN | DATE |
| 5029-01 | KWS | ARJ | AUG 2009 |
| FILE | SHEET | | |
| PW # 2009-01 | L2-02 | | |

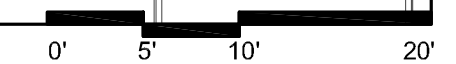

PAVING, DRAINAGE, & UTILITY IMPROVEMENTS - VITRUVIAN WAY & PONTE AVENUE