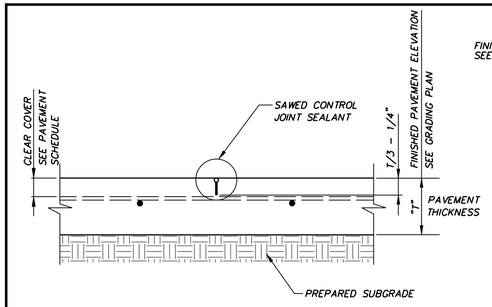

LONGITUDINAL CONTROL JOINT
NOT TO SCALE

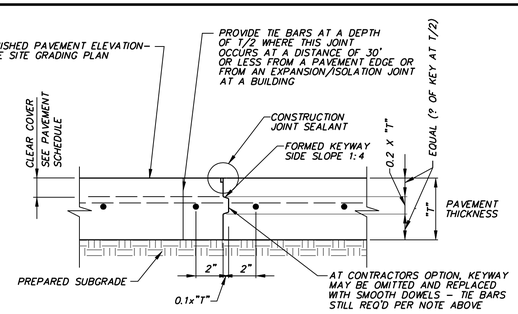

KEYED LONGITUDINAL CONSTRUCTION JOINT
NOT TO SCALE

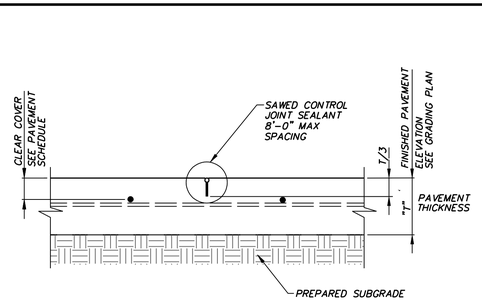

TRANSVERSE CONTROL JOINT
NOT TO SCALE

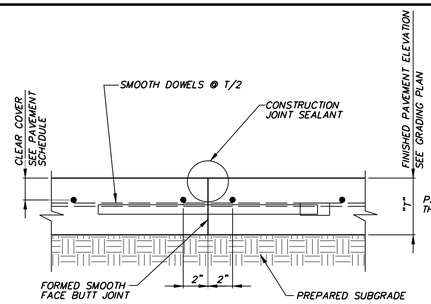

TRANSVERSE CONSTRUCTION JOINT
NOT TO SCALE

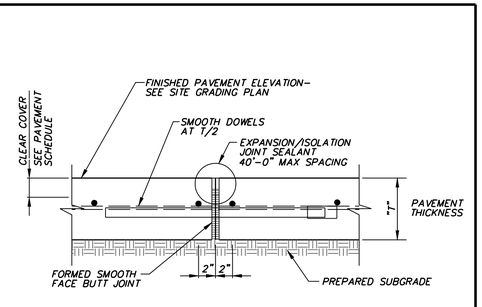

TRANSVERSE EXPANSION JOINT
NOT TO SCALE

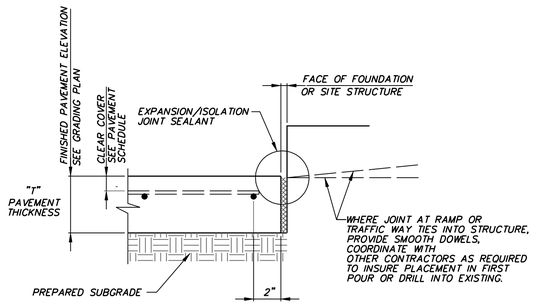

EXPANSION /ISOLATION JOINT AT STRUCTURES
NOT TO SCALE

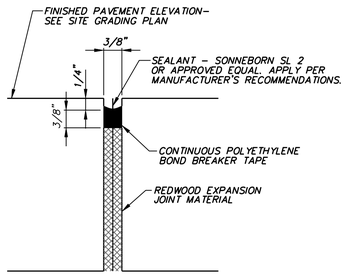

EXPANSION /ISOLATION JOINT SEALANT
NOT TO SCALE

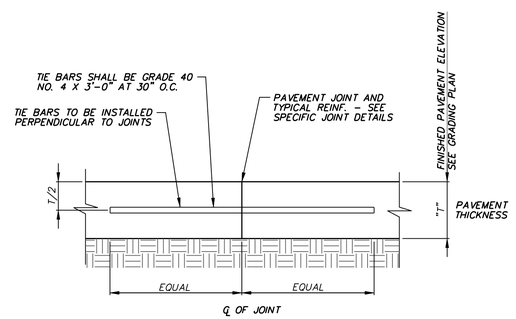

TIE BAR
NOT TO SCALE

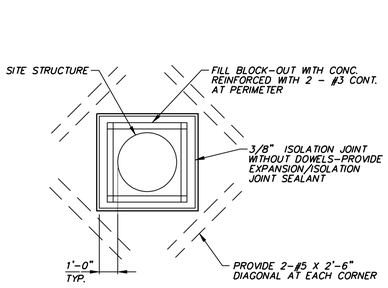

JOINT TREATMENT AT SITE STRUCTURES
NOT TO SCALE

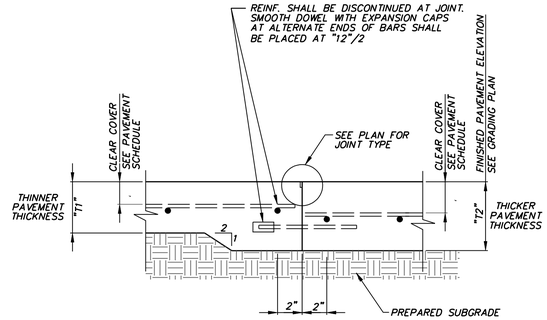

PAVEMENT DEPTH CHANGE/ ISOLATION JOINT
NOT TO SCALE

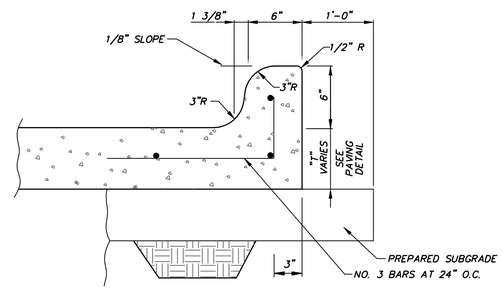

6" INTEGRAL CURB
NOT TO SCALE

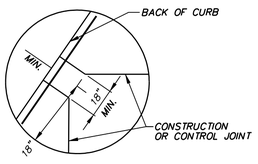

TYPICAL AT ALL ANGLED JOINT TERMINATIONS
NOT TO SCALE

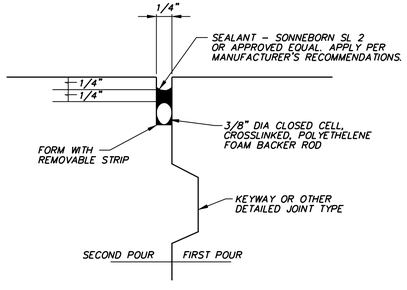

CONSTRUCTION JOINT SEALANT
NOT TO SCALE

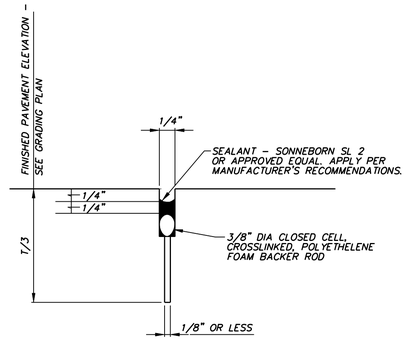

SAWED CONTROL JOINT SEALANT
NOT TO SCALE

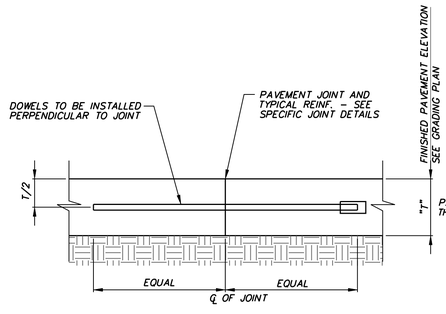

SMOOTH DOWEL
NOT TO SCALE

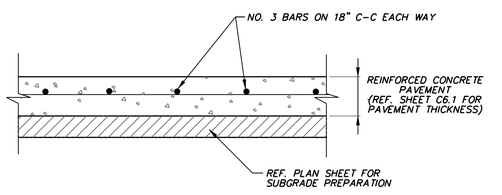

TYPICAL PAVEMENT SECTION
NOT TO SCALE

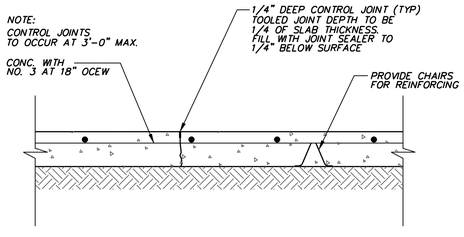

MISCELLANEOUS FLATWORK CONTROL JOINT
NOT TO SCALE

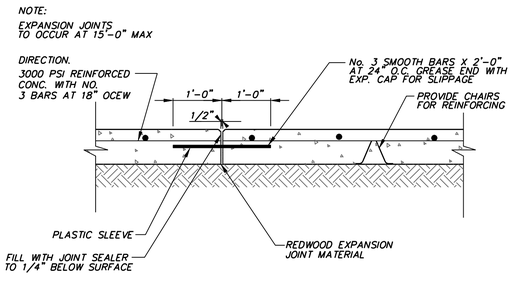

MISCELLANEOUS FLATWORK EXPANSION JOINT
NOT TO SCALE

STATE OF TEXAS
BRUCE F. DUNNE
62654
LICENSED PROFESSIONAL ENGINEER

NO.	REVISION	BY	DATE

TOWN OF ADDISON
DALLAS COUNTY, TEXAS

PARK AND STREETSCAPE IMPROVEMENTS
VITRUVIAN PARK

PAVING DETAILS

icon Consulting Engineers, Inc.
Civil Engineers - Designers - Planners
250 W. Southlake Blvd., Suite 117
Southlake, Tx 76092 (817) 552-6210

PROJECT	DESIGN	DRAWN	DATE	FILE	SHEET
5029-01	ICE	ICE	APR 26, 2010	PW# 2009-04	C603

PARK AND STREETSCAPE IMPROVEMENTS - VITRUVIAN PARK

RECORD DRAWINGS 06/18/12