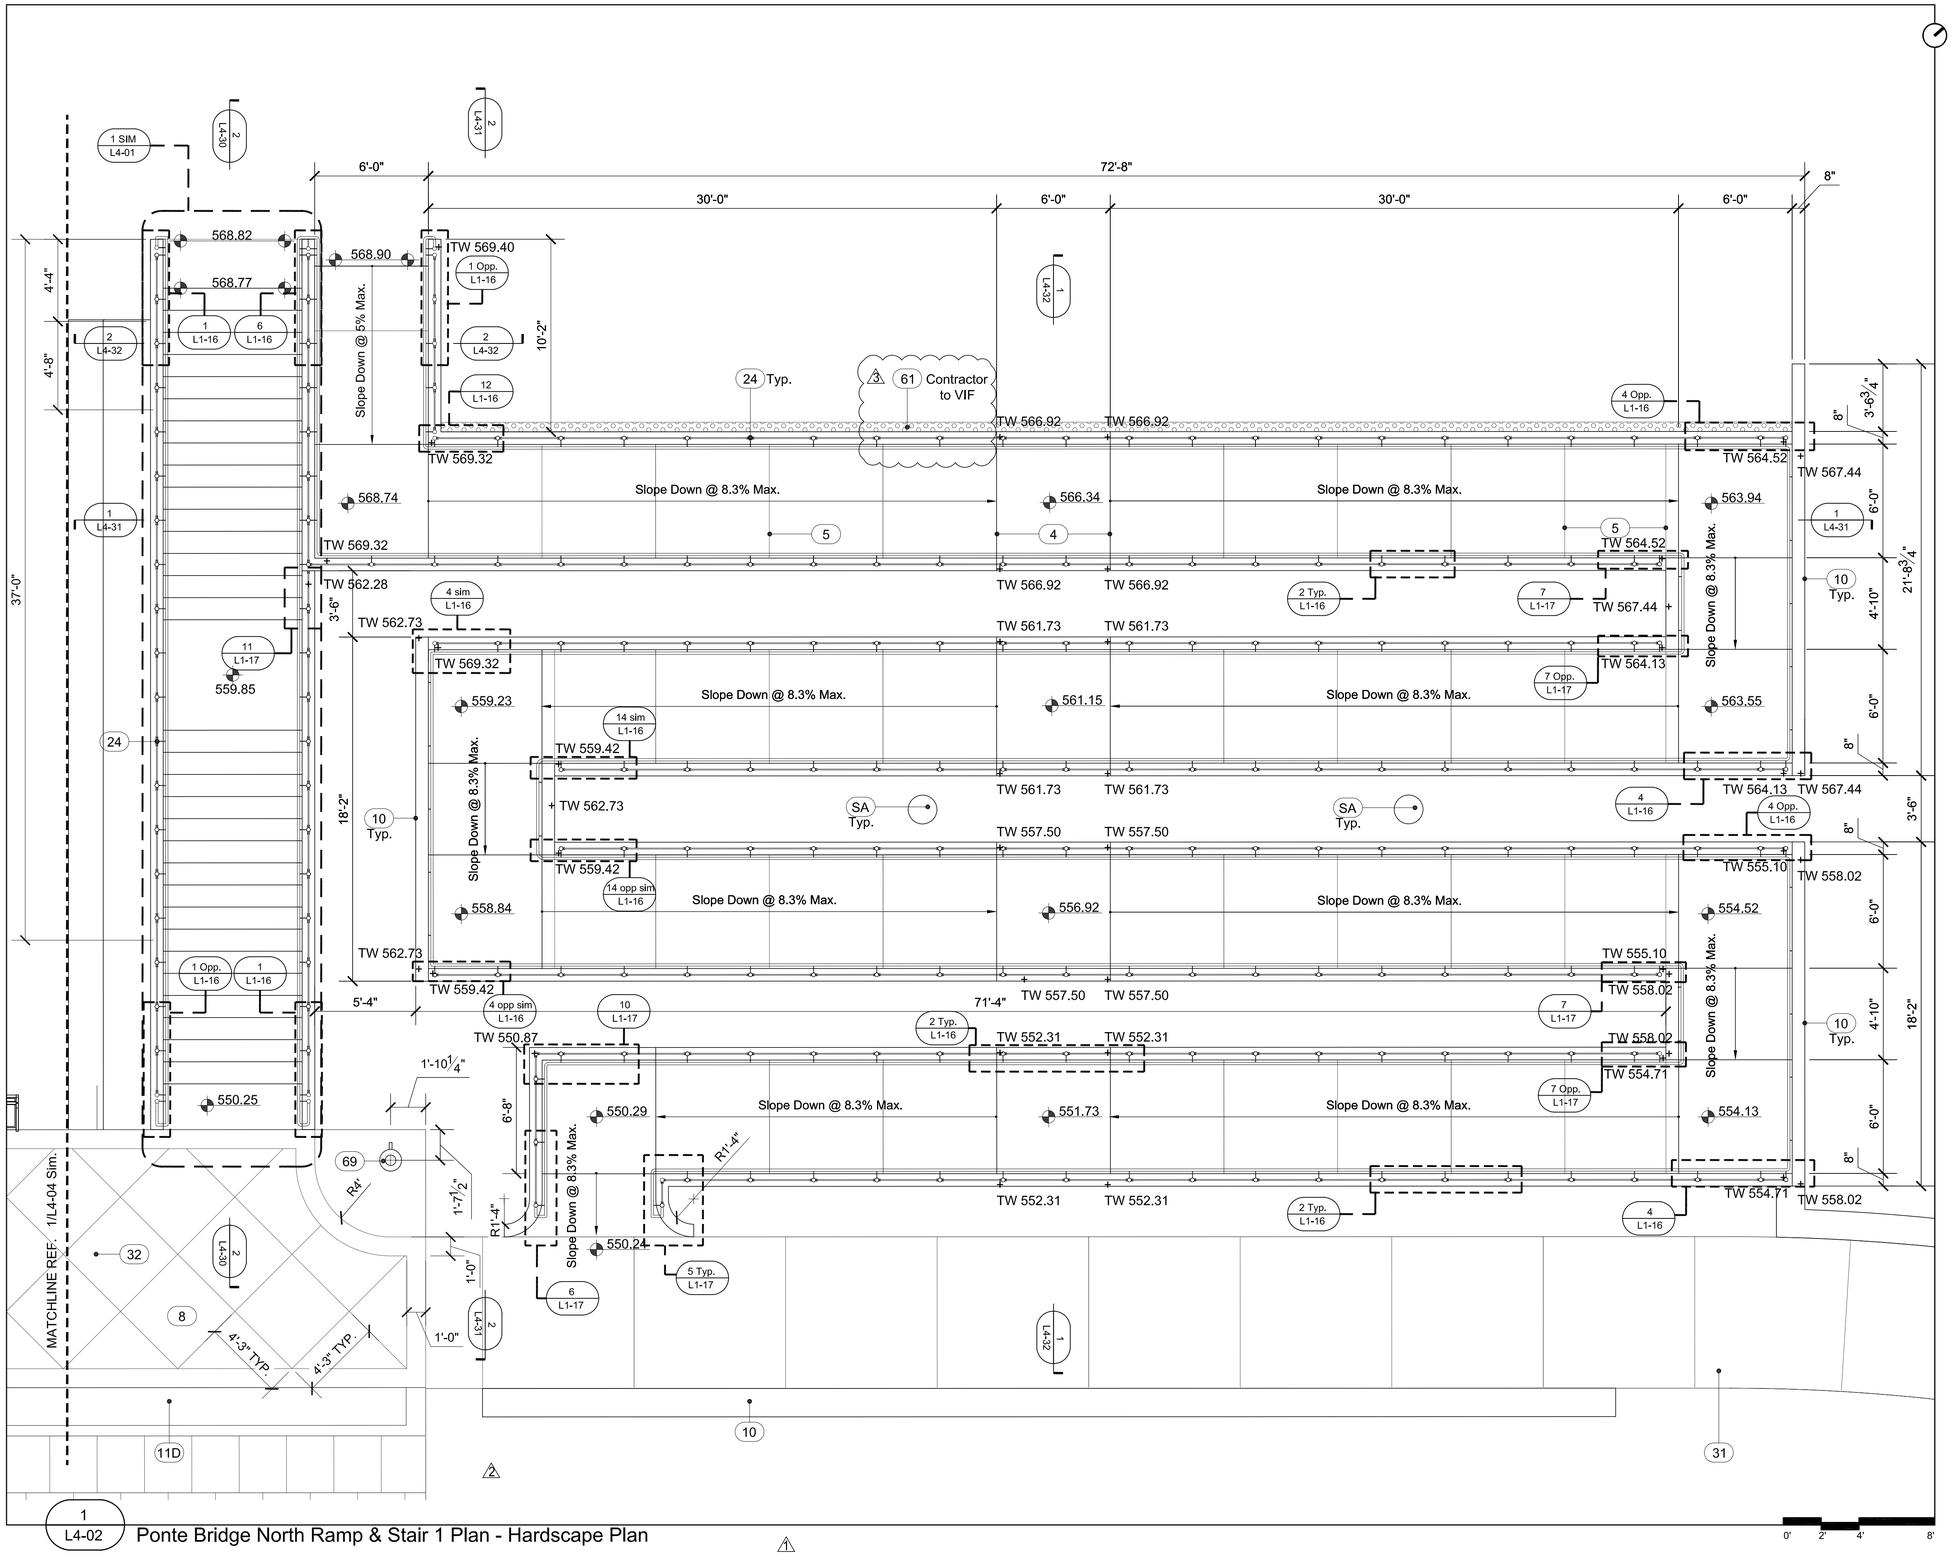

1 L4-02 Ponte Bridge North Ramp & Stair 1 Plan - Hardscape Plan

0' 2' 4' 8'

GENERAL NOTE

Refer to sheet L1-01 Design Selection Summary for specific product, finishes, and colors.

Refer to sheets L1-12 & L1-13 for furniture and park element details.

LEGEND

1. Project Limit
2. Not in Contract (N.I.C.): Information provided for design intent only.
3. Planting Area: Ref. L10-00's & L11-00's
4. Expansion Joint: Ref. Civil for detail
5. Tooled Control Joint: Ref. Civil for detail
6. Concrete Paving A
7. Concrete Paving B
8. Concrete Paving C
9. Concrete Paving D
10. Concrete Wall: ref. Structural
11A. Pavestone Concrete Paver A
11B. Pavestone Concrete Paver B
11C. Pavestone Concrete Paver C
11D. Pavestone Concrete Paver D
11E. Pavestone Concrete Paver E
12. Structural Concrete Masonry Unit Wall
13. Structural Fill: Reference Structural
14. Transformer/Switchgear: Ref. Civil
15. Drain Grate
16. Atrium Grate
17. Paver Grate
18. Metal Pergola
19. Metal Trellis
20. Trellis Above
21. Light Fixture Above
22. Metal Guard Rail
23. Metal Handrail
24. Metal Guard Rail and Handrail
25. Granite Bollard
26. Composite Decking
27. Concrete Pier: Locate in field to avoid conflict with existing tree roots - Ref. Structural
28. Structural Steel Beam: Ref. Structural
29. Structural Framing: Ref. Structural
30. Structural Steel Channel: Ref. Structural
31. Concrete walkway: Ref. Civil & Structural
32. Bridge: N.I.C. (Not In Contract)
33. Building Beyond: N.I.C. (Not In Contract)
34. Guardrail Beyond
35. Concrete Form Ties
36. Vertical Control Joints: Ref. Structural
37. Concrete Bench
38. Lake Edge Wall: Ref. Structural
39. Concrete Wall Beyond
40. Electrical: Ref. Civil
41. Concrete Curb - Reference structural
42. Access Panel - Reference structural
43. Vertical Control Joints: Ref. Structural
44. Concrete Weir: Reference Structural
45. Water
46. Hollow Metal Door and Frame
47. Existing Wooden Fence
48. Metal Gate
49. Limestone Boulder
50. Stone Veneer
60. Fully Grouted Beach Pebbles
61. Loose Beach Pebbles
62. Not Used
63. Fountain Pool: Ref. Fountain Consultant
64. Fountain Water Supply Line: Reference Fountain Consultant
65. Fountain Drain Line: Reference Fountain Consultant
66. Not used
67. Not used
68. Pedestal Drinking Fountain
69. Litter Receptacle
70. Bench
71. Pet Waste Disposal System
72. Bike Rack
73. Gravel
74. Limestone Slab

LIGHTING

- SA (1,2,3,4,5,6,7,8,9) Pole Mount - ref. Civil
- SB Pole Mount - ref. Civil
- SC Wall Recessed - ref. Civil
- SE Suspended Strand - ref. Civil
- SE-1 Suspended Strand - ref. Civil
- SE-T Direct Imbedded Trans - ref. Civil
- SK1 Surface Mount - ref. Civil
- SK2 Surface Mount - ref. Civil
- L4 Pole Mount - ref. Civil
- L5 Ceiling Mount - ref. Civil

REGISTERED LANDSCAPE ARCHITECT KEVIN W. SLOAN 2296 STATE OF TEXAS

NO.	REVISION	BY	DATE
1	PONTE GRADING REVISIONS	KSS	04/13/11
2	SAW CUT JOINT DIMENSIONS	KSS	06/08/11
3	PONTE BRIDGE NORTH RAMP REVISION - RIVER PEBBLE	KSS	10/11/11

Addison TOWN OF ADDISON
DALLAS COUNTY, TEXAS

PARK AND STREETSCAPE IMPROVEMENTS
VITRUVIAN PARK

PONTE AVENUE BRIDGE/PARK NORTH RAMP & STAIR PLAN

KEVIN SLOAN STUDIO
2400 Empire Central, Suite F
Dallas, Texas 75235 (214) 459-1784

PROJECT	DESIGN	DRAWN	DATE	FILE	SHEET
5029-01	KWS	MM	DEC. 18, 2009	PW # 2009-04	L4-02

PARK AND STREETSCAPE IMPROVEMENTS - VITRUVIAN PARK