

BAR SCHEDULE ~ ONE CAP

Bar	Type	No.	Size	Length	Weight
A	S+	28	#11	58'-1"	8,641
H	S+	8	#6	57'-8"	693
L1	B+	12	#6	5'-0"	91
L2	B+	24	#6	12'-6"	451
S1	B+	55	#5	18'-2"	1,043
V	B+	59	#5	9'-2 1/2"	567
WH1	S+	22	#6	21'-2"	700
WH2	S+	38	#6	10'-2"	581
WH3	S+	22	#6	10'-8"	353
WU	B+	26	#8	26'-2 1/2"	1,820
wV1	S+	24	#8	11'-8 3/4"	752
wV2	S+	24	#6	9'-8 3/4"	351
wZ	B+	22	#6	6'-2 1/2"	206
Total Reinforcing Steel					LB 16,250
C/C Conc (Abut)					CY 47.9
C/C Conc (Mass Placement)					CY 72.5

ESTIMATED QUANTITIES

Item	Unit	QUANTITY
Drilled Shaft (48 IN)	FT	44
Drilled Shaft (30 IN)	FT	150
C/C Conc (Abut)	CY	47.9
C/C Conc (Mass Placement)	CY	72.5
Reinf Steel	LB	16,250

① For contractor's information only.

General Notes:


Designed per AASHTO LRFD Bridge Design Specifications (2007) with interim specifications thereto.
Concrete strength $f'_c = 3,600$ psi.
The price bid per foot of Drilled Shaft shall include the reinforcing extending from the shaft into the cap.

Spiral steel shall have one extra turn at the top, bottom and at splices.

All cap and wall reinforcing shall be grade 60 steel.

Drilled shaft reinforcing may be grade 40.

Calculated drilled shaft foundation load is as follows:
146 tons per shaft (48")
104 tons per shaft (30")

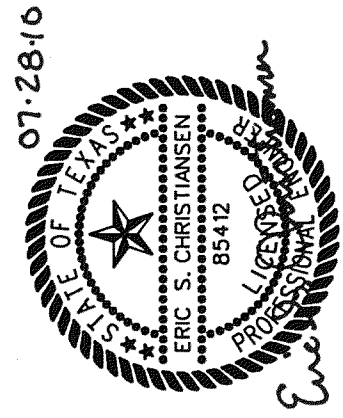


NO.	REVISION	BY	DATE
1	ESC	07/28/10	
2	ESC	05/24/10	
3	ESC	05/19/10	
4	ESC	07/28/10	

TOWN OF ADDISON
DALLAS COUNTY, TEXAS
BELLA LANE


ABUTMENT No. 1
PLAN AND ELEVATION

HALFF		1201 NORTH BOVIER ROAD, RICHARDSON, TEXAS 75081-2275		TEL (214) 346-6200		FAX (214) 798-0085	
PROJECT	DESIGN	DRAWN	DATE	FILE	SHEET		
27379	ESC	AHH	APRIL 2010	-	S2-04		

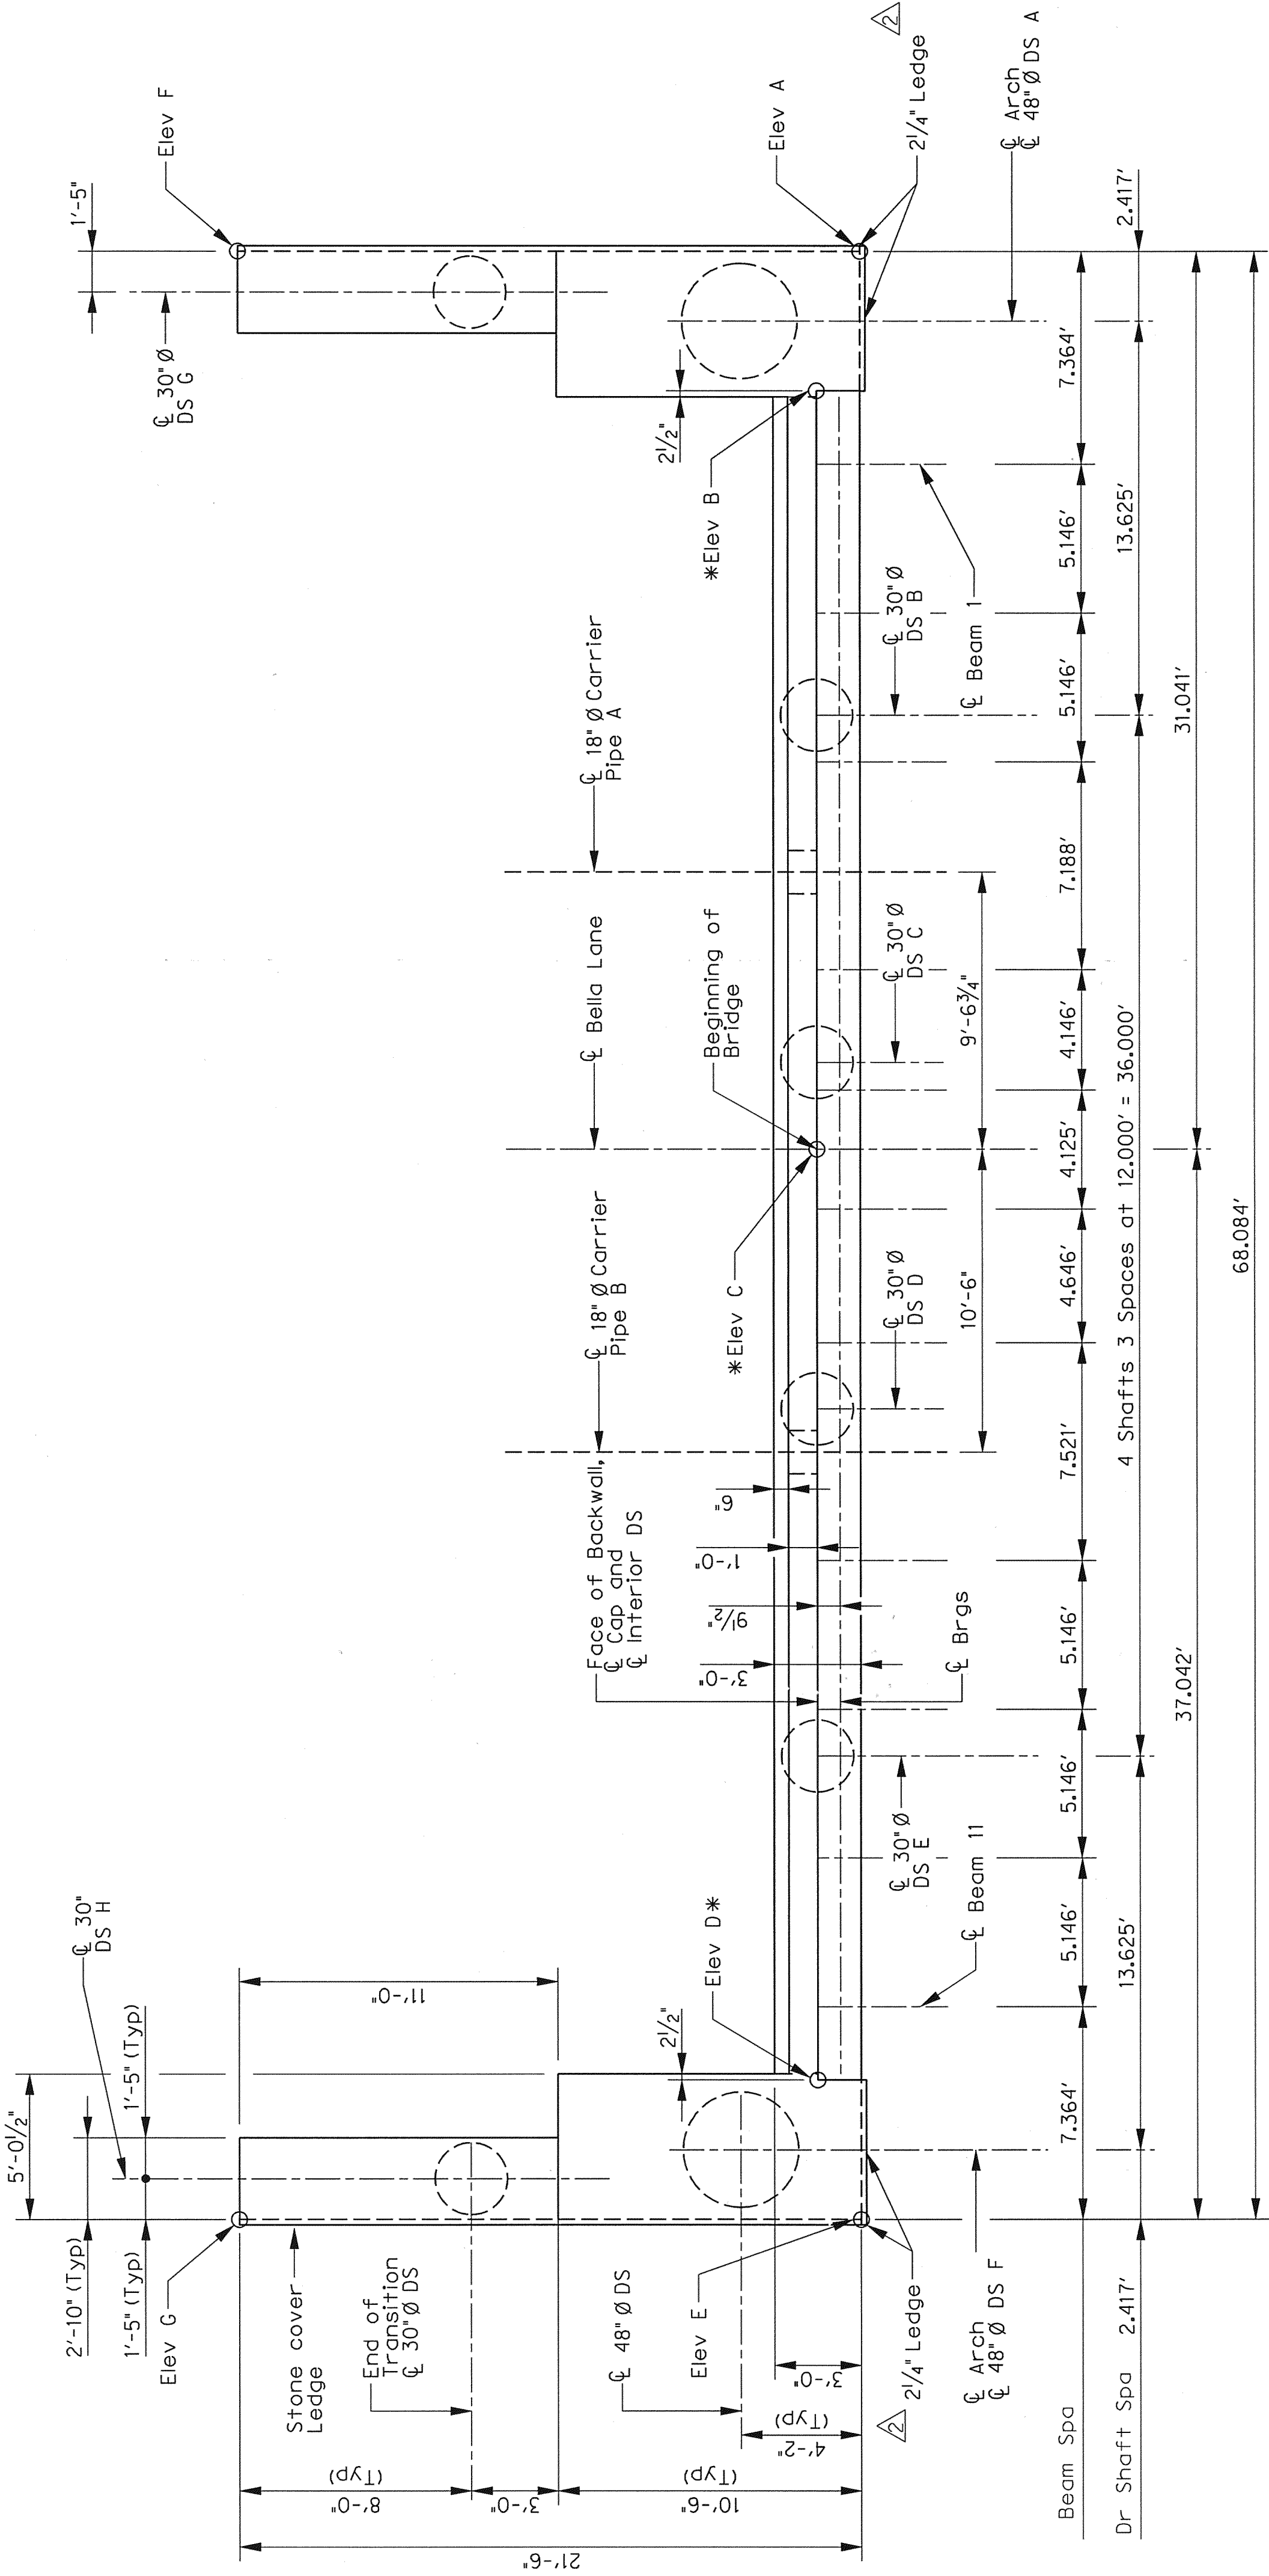

* Denotes elevation taken at top, frontface of backwall along centerline of abutment.

PLAN
SCALE: 1/4" = 1'-0"

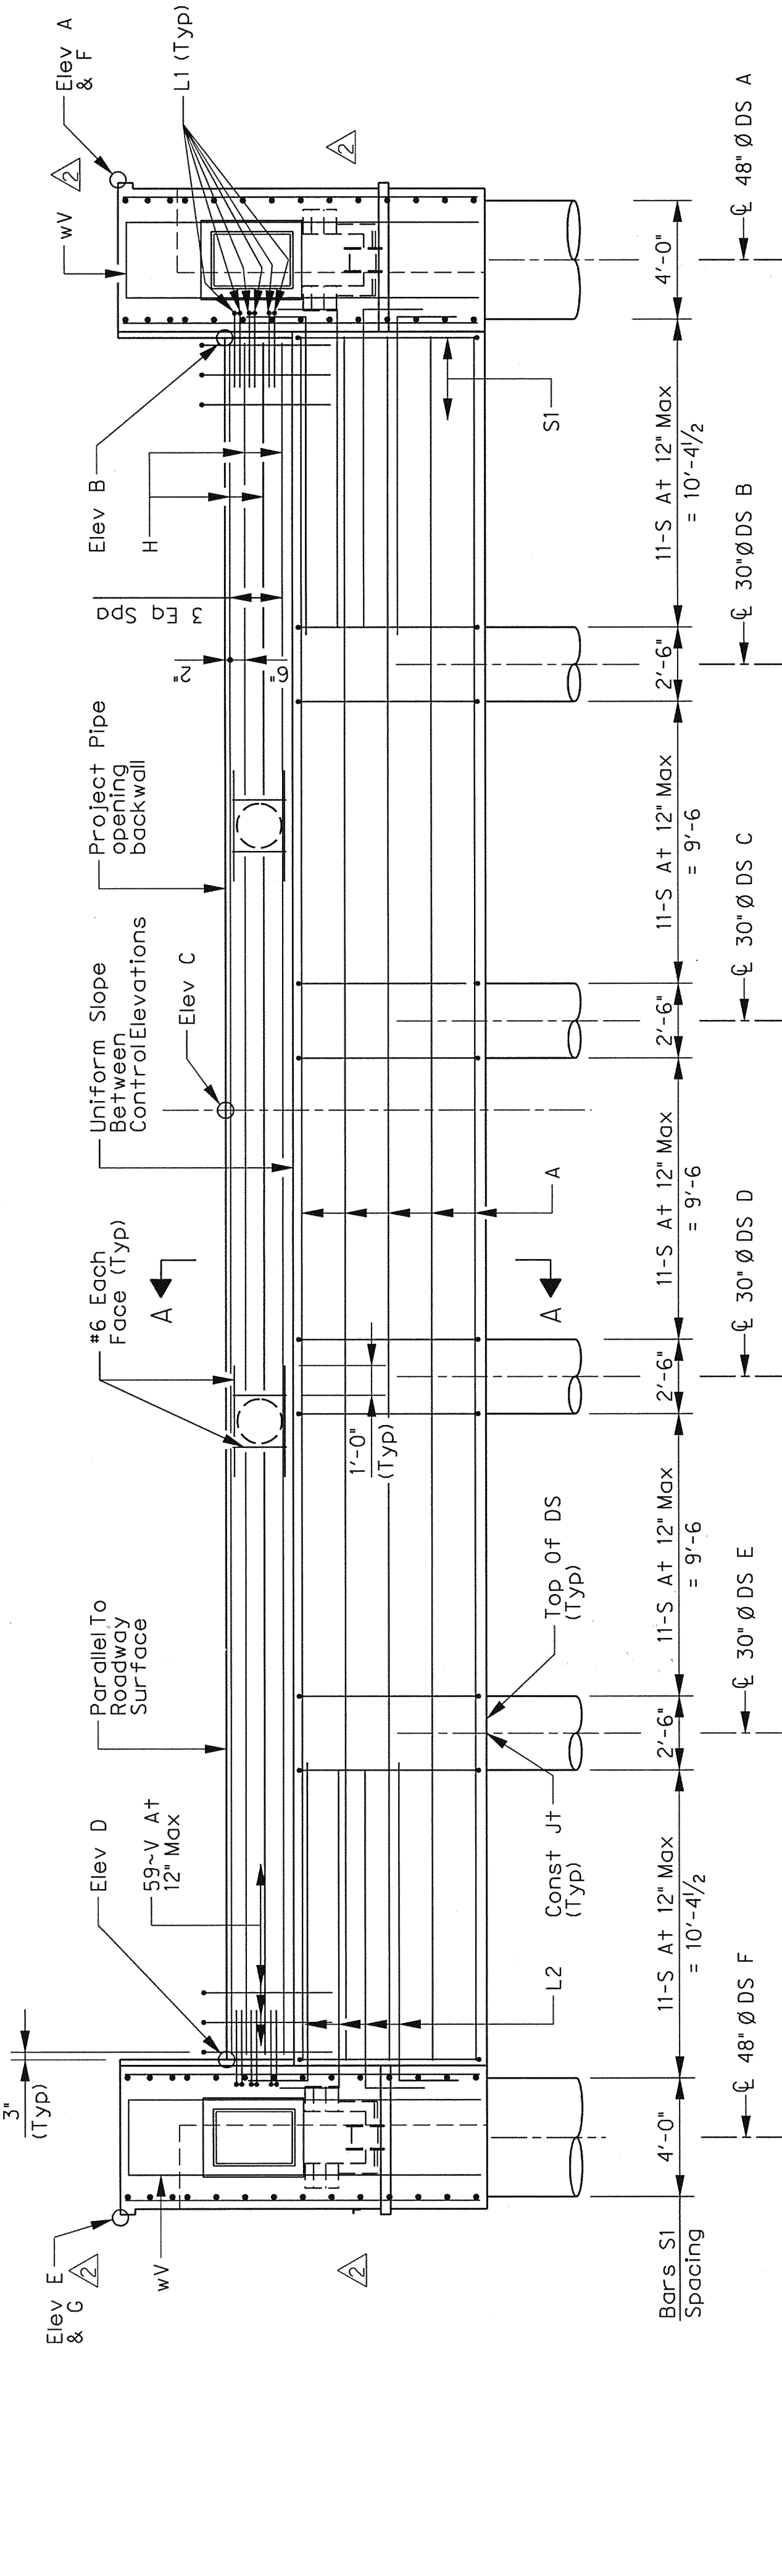

ELEVATION
SCALE: 1/4" = 1'-0"

Note: For information not shown see Section A-A/S2-07

CONTROL ELEVATIONS

Abutment	Station	Elev A	Elev B	Elev C	Elev D	Elev E	Elev F	Elev G	DS A	DS B	DS C	DS D	DS E	DS F	DS G	DS H
1	28+58.50	564.94	561.34	561.87	561.23	564.84	563.45	563.35	552.54	552.80	553.04	552.92	552.68	552.42	552.48	552.48