PROJECT # 27379 OFFICE: RCH USER: ah2140
DATE: 5/20/2010 TIME: 2:21:07 PM FILE: 27379-SC-PONTEB-ABO1-08.dgn

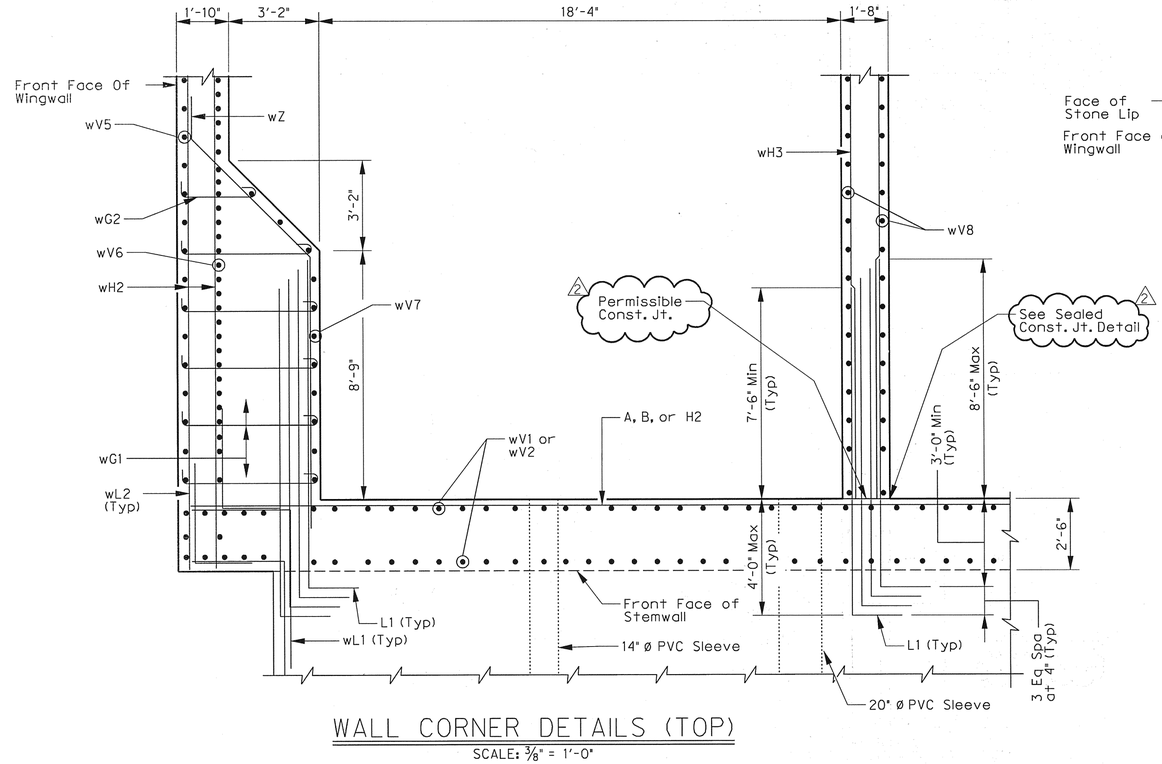

WALL CORNER DETAILS (TOP)

SCALE: 3/8" = 1'-0"

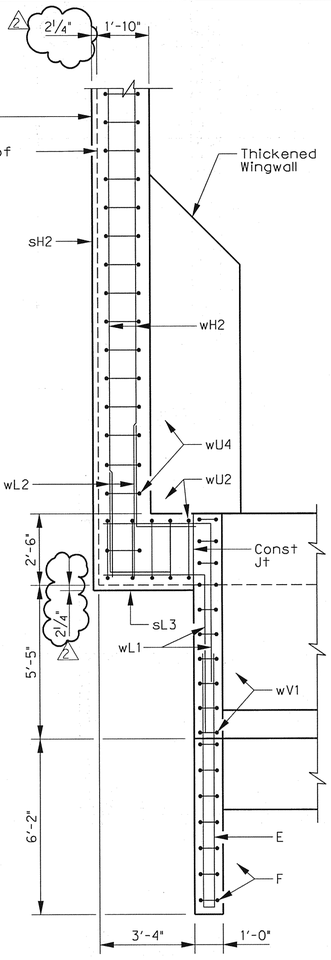

CAP END DETAIL

SCALE: 3/8" = 1'-0"

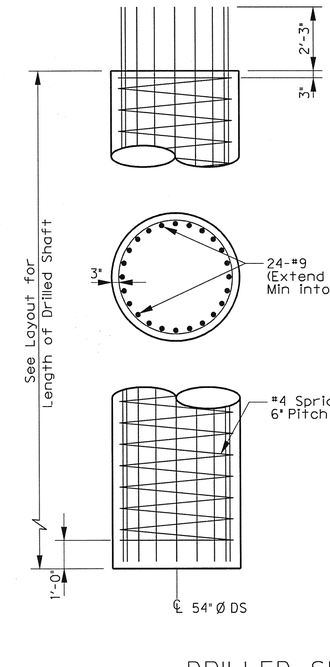

DRILLED SHAFT DETAILS

SCALE: 3/8" = 1'-0"

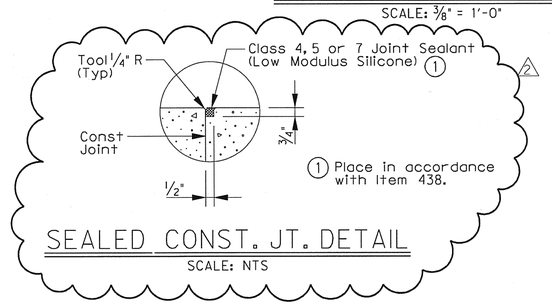

SEALED CONST. JT. DETAIL

SCALE: NTS

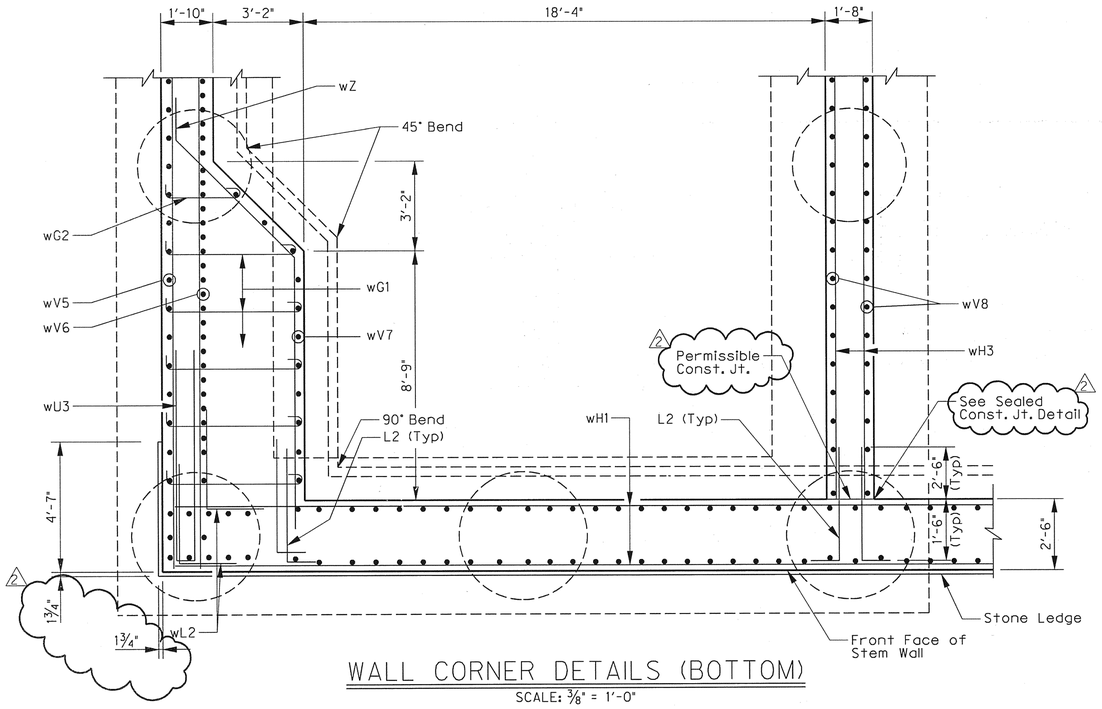

WALL CORNER DETAILS (BOTTOM)

SCALE: 3/8" = 1'-0"

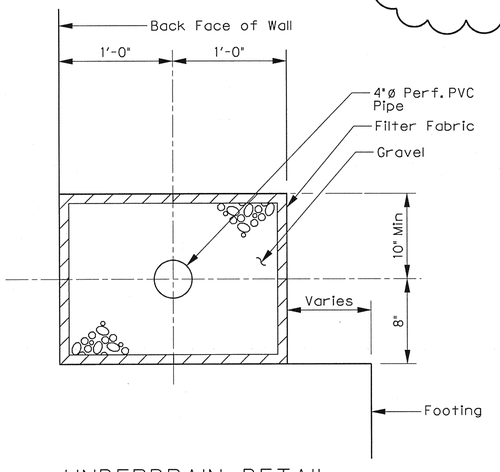

UNDERDRAIN DETAIL

SCALE: N.T.S.

05-19-10

STATE OF TEXAS
ERIC S. CHRISTIANSEN
85412
LICENSED PROFESSIONAL ENGINEER

Eric S. Christiansen

THE SEAL APPEARING ON THIS DOCUMENT WAS AUTHORIZED BY ERIC S. CHRISTIANSEN, P.E. #85412 ON 05-19-2010. ALTERATION OF A SEALED DOCUMENT WITHOUT PROPER NOTIFICATION TO THE RESPOSIBLE ENGINEER IS AN OFFENSE UNDER THE TEXAS ENGINEERING PRACTICE ACT. THE RECORD COPY OF THIS DRAWING IS ON FILE AT THE OFFICES OF HALFF ASSOCIATES, 1201 NORTH BOWSER ROAD, RICHARDSON, TEXAS, 75081. TBPE FIRM #F-312.

NO.	REVISION	BY	DATE
2	Addendum #2	ESC	05/19/10

TOWN OF ADDISON
DALLAS COUNTY, TEXAS

VITRUVIAN PARK BRIDGES
PONTE AVENUE

ABUTMENT DETAILS - WALL CORNER & DR. SHAFTS

HALFF
1201 NORTH BOWSER ROAD, RICHARDSON, TEXAS 75081-2275
TEL (214) 346-6200 FAX (214) 739-0095

PROJECT	DESIGN	DRAWN	DATE	FILE	SHEET
27379	ESC	AHH	APRIL 2010	-	S1-12