


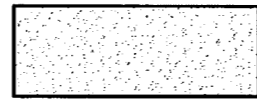


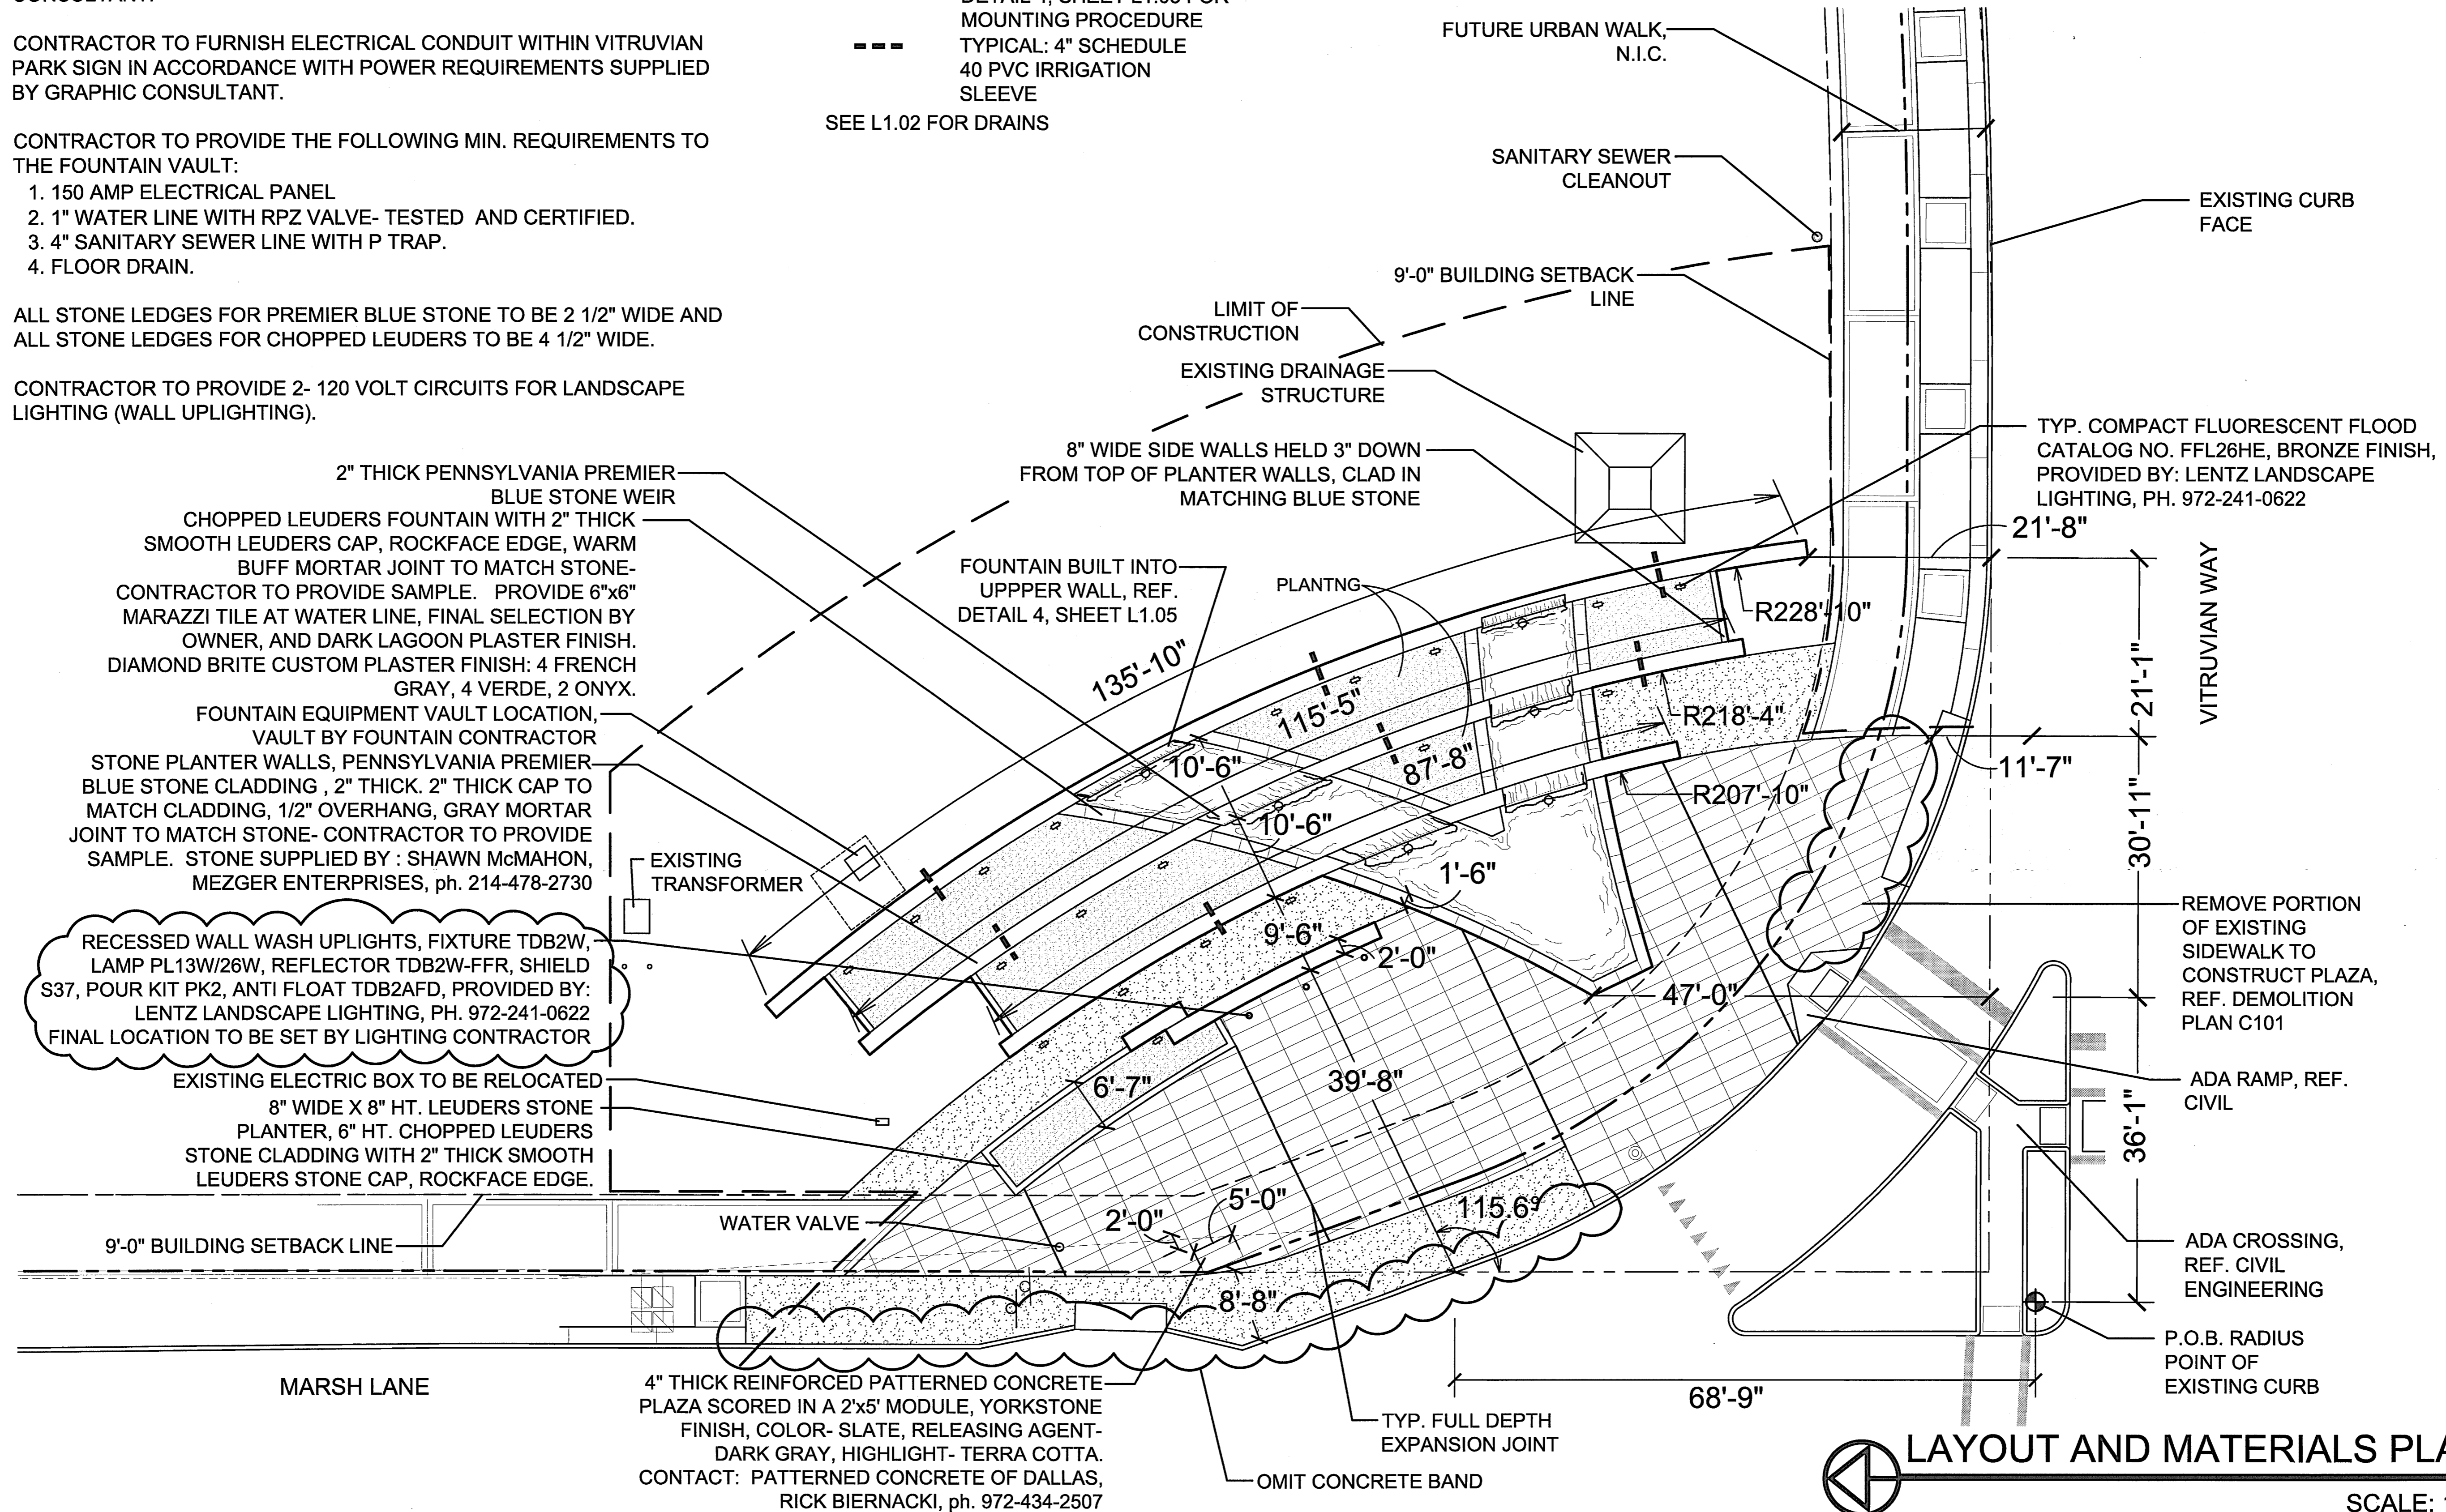


CONTRACTOR NOTES

- CONTRACTOR TO PROVIDE 4'-0" x 4'-0" FIELD MOCKUP OF LEUDERS STONE WALL, PENNSYLVANIA PREMIER BLUE STONE WALL, AND PATTERNED CONCRETE FOR OWNER REVIEW.
- NO PIERS TO BE DRILLED UNTIL PLAZA, WALLS, AND SIGN HAVE ALL BEEN LAID OUT IN THE FIELD AND APPROVED BY OWNER.
- CONTRACTOR TO OBTAIN ALL SIGN AND FOUNTAIN PERMITS
- CONTRACTOR TO FURNISH ELECTRICAL CONDUIT WITHIN 16' HT. SIGN IN ACCORDANCE WITH POWER REQUIREMENTS SUPPLIED BY GRAPHIC CONSULTANT.
- CONTRACTOR TO FURNISH ELECTRICAL CONDUIT WITHIN VITRUVIAN PARK SIGN IN ACCORDANCE WITH POWER REQUIREMENTS SUPPLIED BY GRAPHIC CONSULTANT.
- CONTRACTOR TO PROVIDE THE FOLLOWING MIN. REQUIREMENTS TO THE FOUNTAIN VAULT:
 - 150 AMP ELECTRICAL PANEL
 - 1" WATER LINE WITH RPZ VALVE- TESTED AND CERTIFIED.
 - 4" SANITARY SEWER LINE WITH P TRAP.
 - FLOOR DRAIN.
- ALL STONE LEDGES FOR PREMIER BLUE STONE TO BE 2 1/2" WIDE AND ALL STONE LEDGES FOR CHOPPED LEUDERS TO BE 4 1/2" WIDE.
- CONTRACTOR TO PROVIDE 2- 120 VOLT CIRCUITS FOR LANDSCAPE LIGHTING (WALL UPLIGHTING).

LEGEND

-  DENOTES ABOVE GROUND PLANTER
 -  DENOTES AT GRADE PLANTING BED
 -  COMPACT FLUORESCENT FLOOD WALL WASH UPLIGHT
 -  GROUND RECESSED WALL WASH UPLIGHT
 -  RECESSED FOUNTAIN UPLIGHTS BY POOL CONTRACTOR, REF. DETAIL 4, SHEET L1.05 FOR MOUNTING PROCEDURE
 -  TYPICAL: 4" SCHEDULE 40 PVC IRRIGATION SLEEVE
- SEE L1.02 FOR DRAINS




LAYOUT AND MATERIALS PLAN
SCALE: 1"=10'-0"

LINDA TYCHER & ASSOCIATES, INC.
11411 N. CENTRAL EXPRESSWAY, SUITE V
DALLAS, TEXAS 75243
(214)760-1210
LINDA TYCHER & ASSOCIATES

UDR
5430 LBJ FREEWAY, SUITE 1250
DALLAS, TX 75240
972.763.3510 PH/ 972.866.0163 F

VITRUVIAN PARK CORNER SIGNAGE
ADDISON, TEXAS

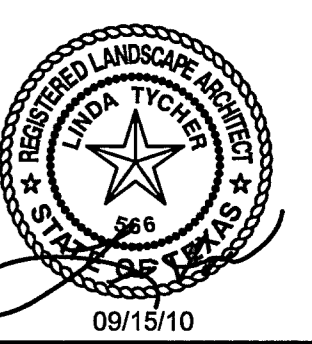

REVISIONS
1. REVISED FOUNTAIN LAYOUT 8/13/10
2. ISSUE FOR CONSTRUCTION 8/15/10

ISSUE ISSUE FOR CONSTRUCTION
DATE 7-1-10
JOB NUMBER
DRAWN BY TS
CHECKED BY LT
SHEET TITLE
LAYOUT AND MATERIALS PLAN
SHEET NUMBER

L1.01