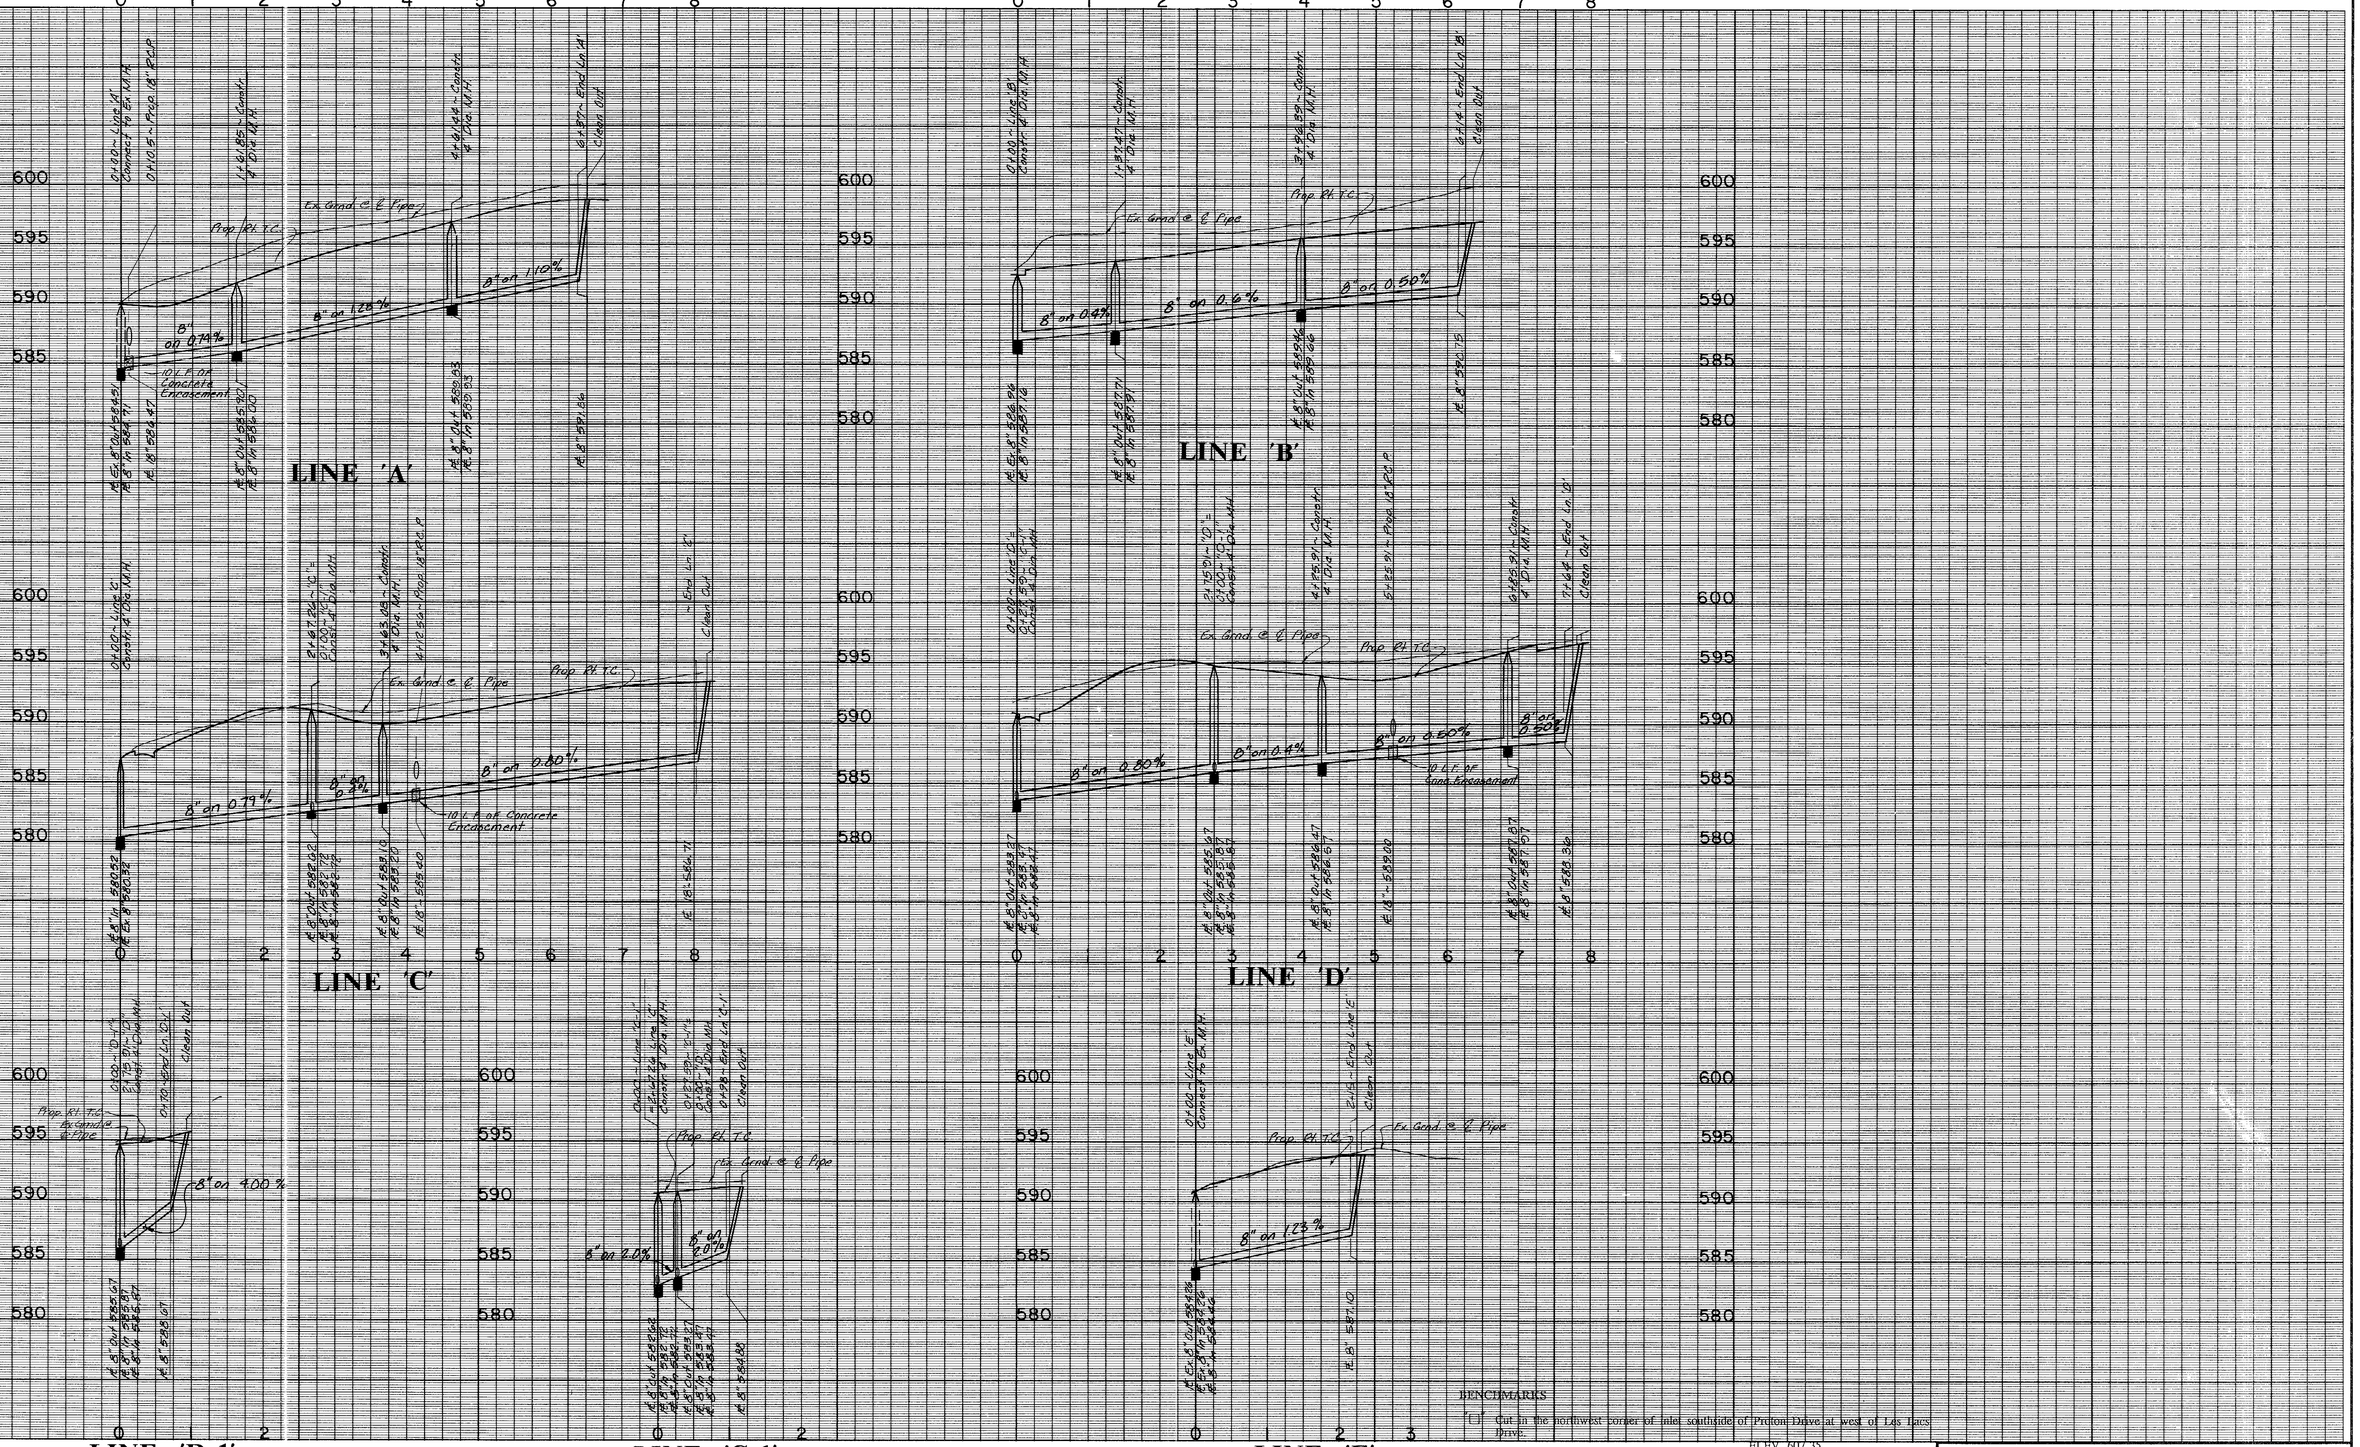

BENCHMARKS

"□" Cut in the northwest corner of inlet southside of Preton Drive at west of Les Lacs Drive.
ELEV. 607.35

"□" Cut on the north top of curb of Les Lacs Drive at Southeast Addition Corner.
ELEV. 593.38

Center of second inlet west of the East Addition Line and on the north side of Les Lacs.
ELEV. 586.17

"□" In center of the third inlet west of the East Addition Line on the north side of Les Lacs Drive.
ELEV. 587.61

"□" In center of the first inlet south of Beltway Drive and on the east side of Les Lacs Drive.
ELEV. 589.88

AS BUILTS

I CERTIFY THIS PROJECT WAS CONSTRUCTED IN GENERAL CONFORMANCE WITH THESE CONSTRUCTION PLANS AND WILL FUNCTION AS DESIGNED.

STATE OF TEXAS · BRIAN MARCUS · 52413 · REGISTERED PROFESSIONAL ENGINEER

STATE OF TEXAS · TIMOTHY JOHN WELCH · 68847 · REGISTERED PROFESSIONAL ENGINEER

SANITARY SEWER PROFILE
WATERFORD PARK II

THE NELSON CORPORATION
LAND PLANNING • ENGINEERING • SURVEYING
5999 SUMMERSIDE DRIVE • SUITE 202 • DALLAS, TEXAS 75252 • (214) 380-2605

DESIGN	DRAWN	DATE	SCALE	NOTES	FILE	NO.
N.E.C.	N.E.C.	NOV. 1991	1" = 6' V		90025-6	WS-2

TELEPHONE POLES 1481374