Revisions	Date	Description	Drawn By	Checked By

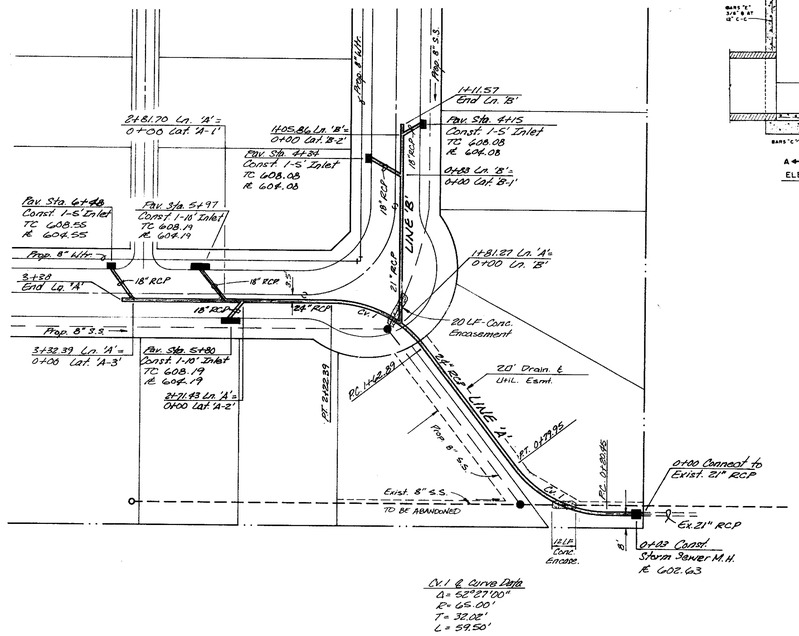

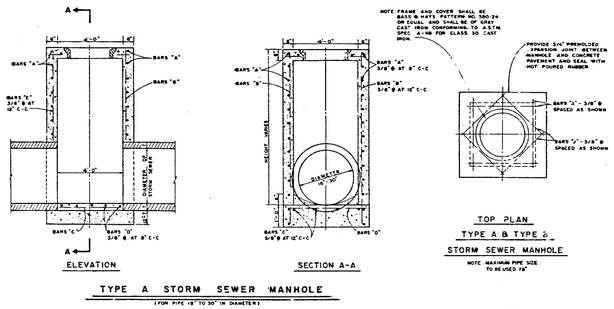

TYPE A STORM SEWER MANHOLE
(FOR PIPE 18" TO 30" IN DIAMETER)

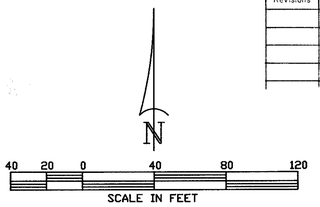

DRAINAGE GENERAL NOTES

1. All reinforced concrete pipe shall be Class III unless otherwise noted.
2. The location of all utilities are taken from existing public records. The exact location must be determined by the Contractor. It is the duty of the contractor to ascertain whether any other facilities (additional), other than those on the plans may be present.
3. Embedment is subsidiary to RCP.
4. All backfill shall be compacted to 95% Standard Proctor Density in a maximum of six 8" loose lifts. Moisture shall be from 0 to +3% of optimum.
5. No precast inlets are allowed.
6. All work and materials shall be in accordance with the Town of Addison Standards and Specifications and to contract specifications and documents.
7. All curved storm sewers having a radius of less than 200 feet shall be constructed with factory beveled joints. No joints will be allowed to have a tongue exposed by more than one-half.

BENCH MARKS:

Box cut in the northwest corner of the concrete foot of Tower No. 12N-2W-T294 at the intersection of the transmission lines with Midway Road.

ELEV. 607.46

Box cut in the concrete curb, located at the northeast corner of site.

ELEV. 615.92

Box cut in the northwest corner of the concrete foot of Tower No. 12N-3W-T290 at the angle point of the transmission line.

ELEV. 613.16

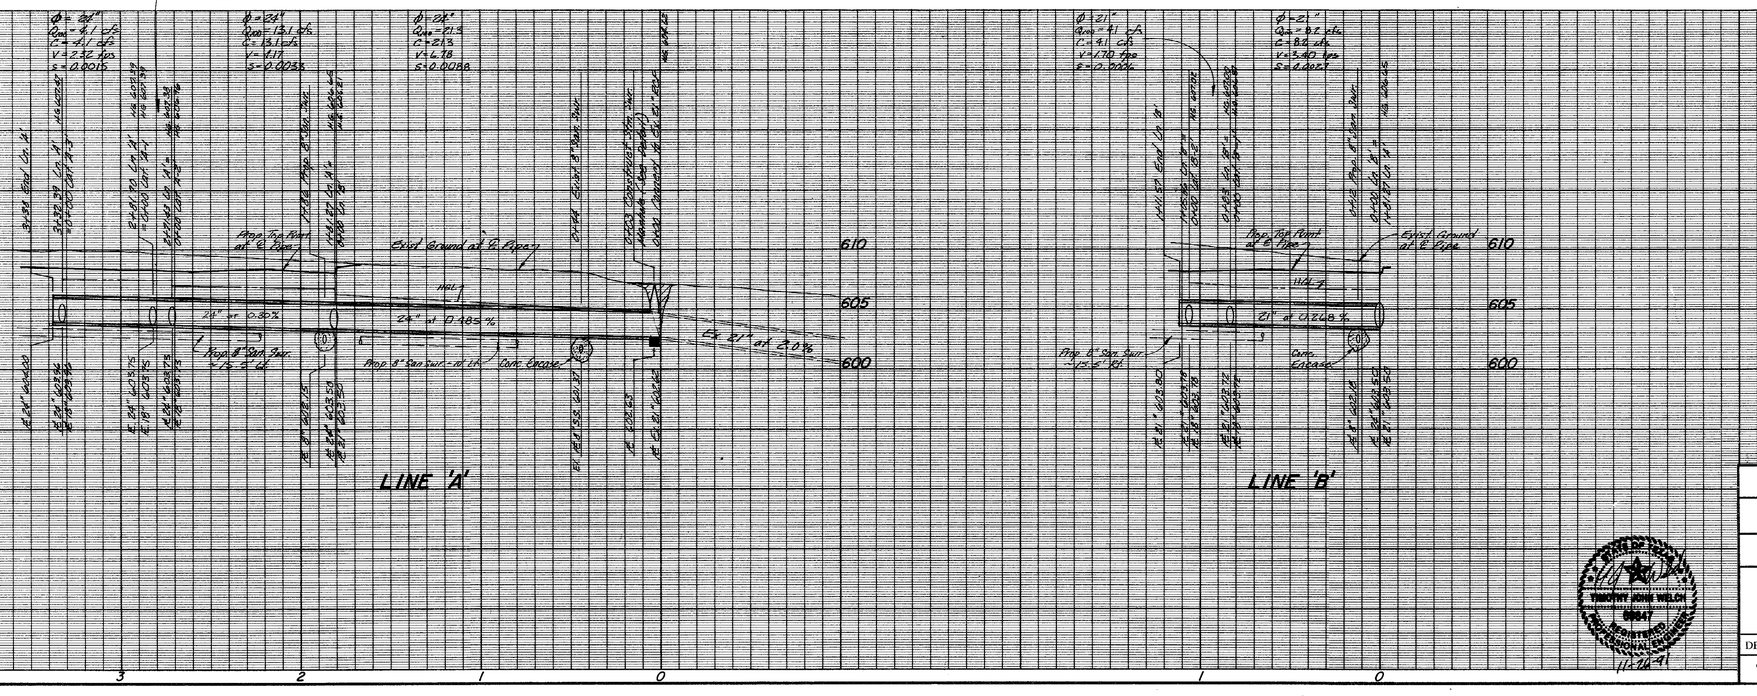

AS BUILT

DRAINAGE PLAN & PROFILE
WESTFIELD COURT
TOWN OF ADDISON, TEXAS

THE NELSON CORPORATION
LAND PLANNING • ENGINEERING • SURVEYING
5999 SUMMERSIDE DRIVE • SUITE 202 • DALLAS, TEXAS 75252 • (214) 380-2605

DESIGN	DRAWN	DATE	SCALE	FILE	SHEET NO.
TNC	TNC	JUNE, 1991	1"=40'H 1"=6'V	90025-3	DR-1

ARCHIVE SUPPLIES N3220