



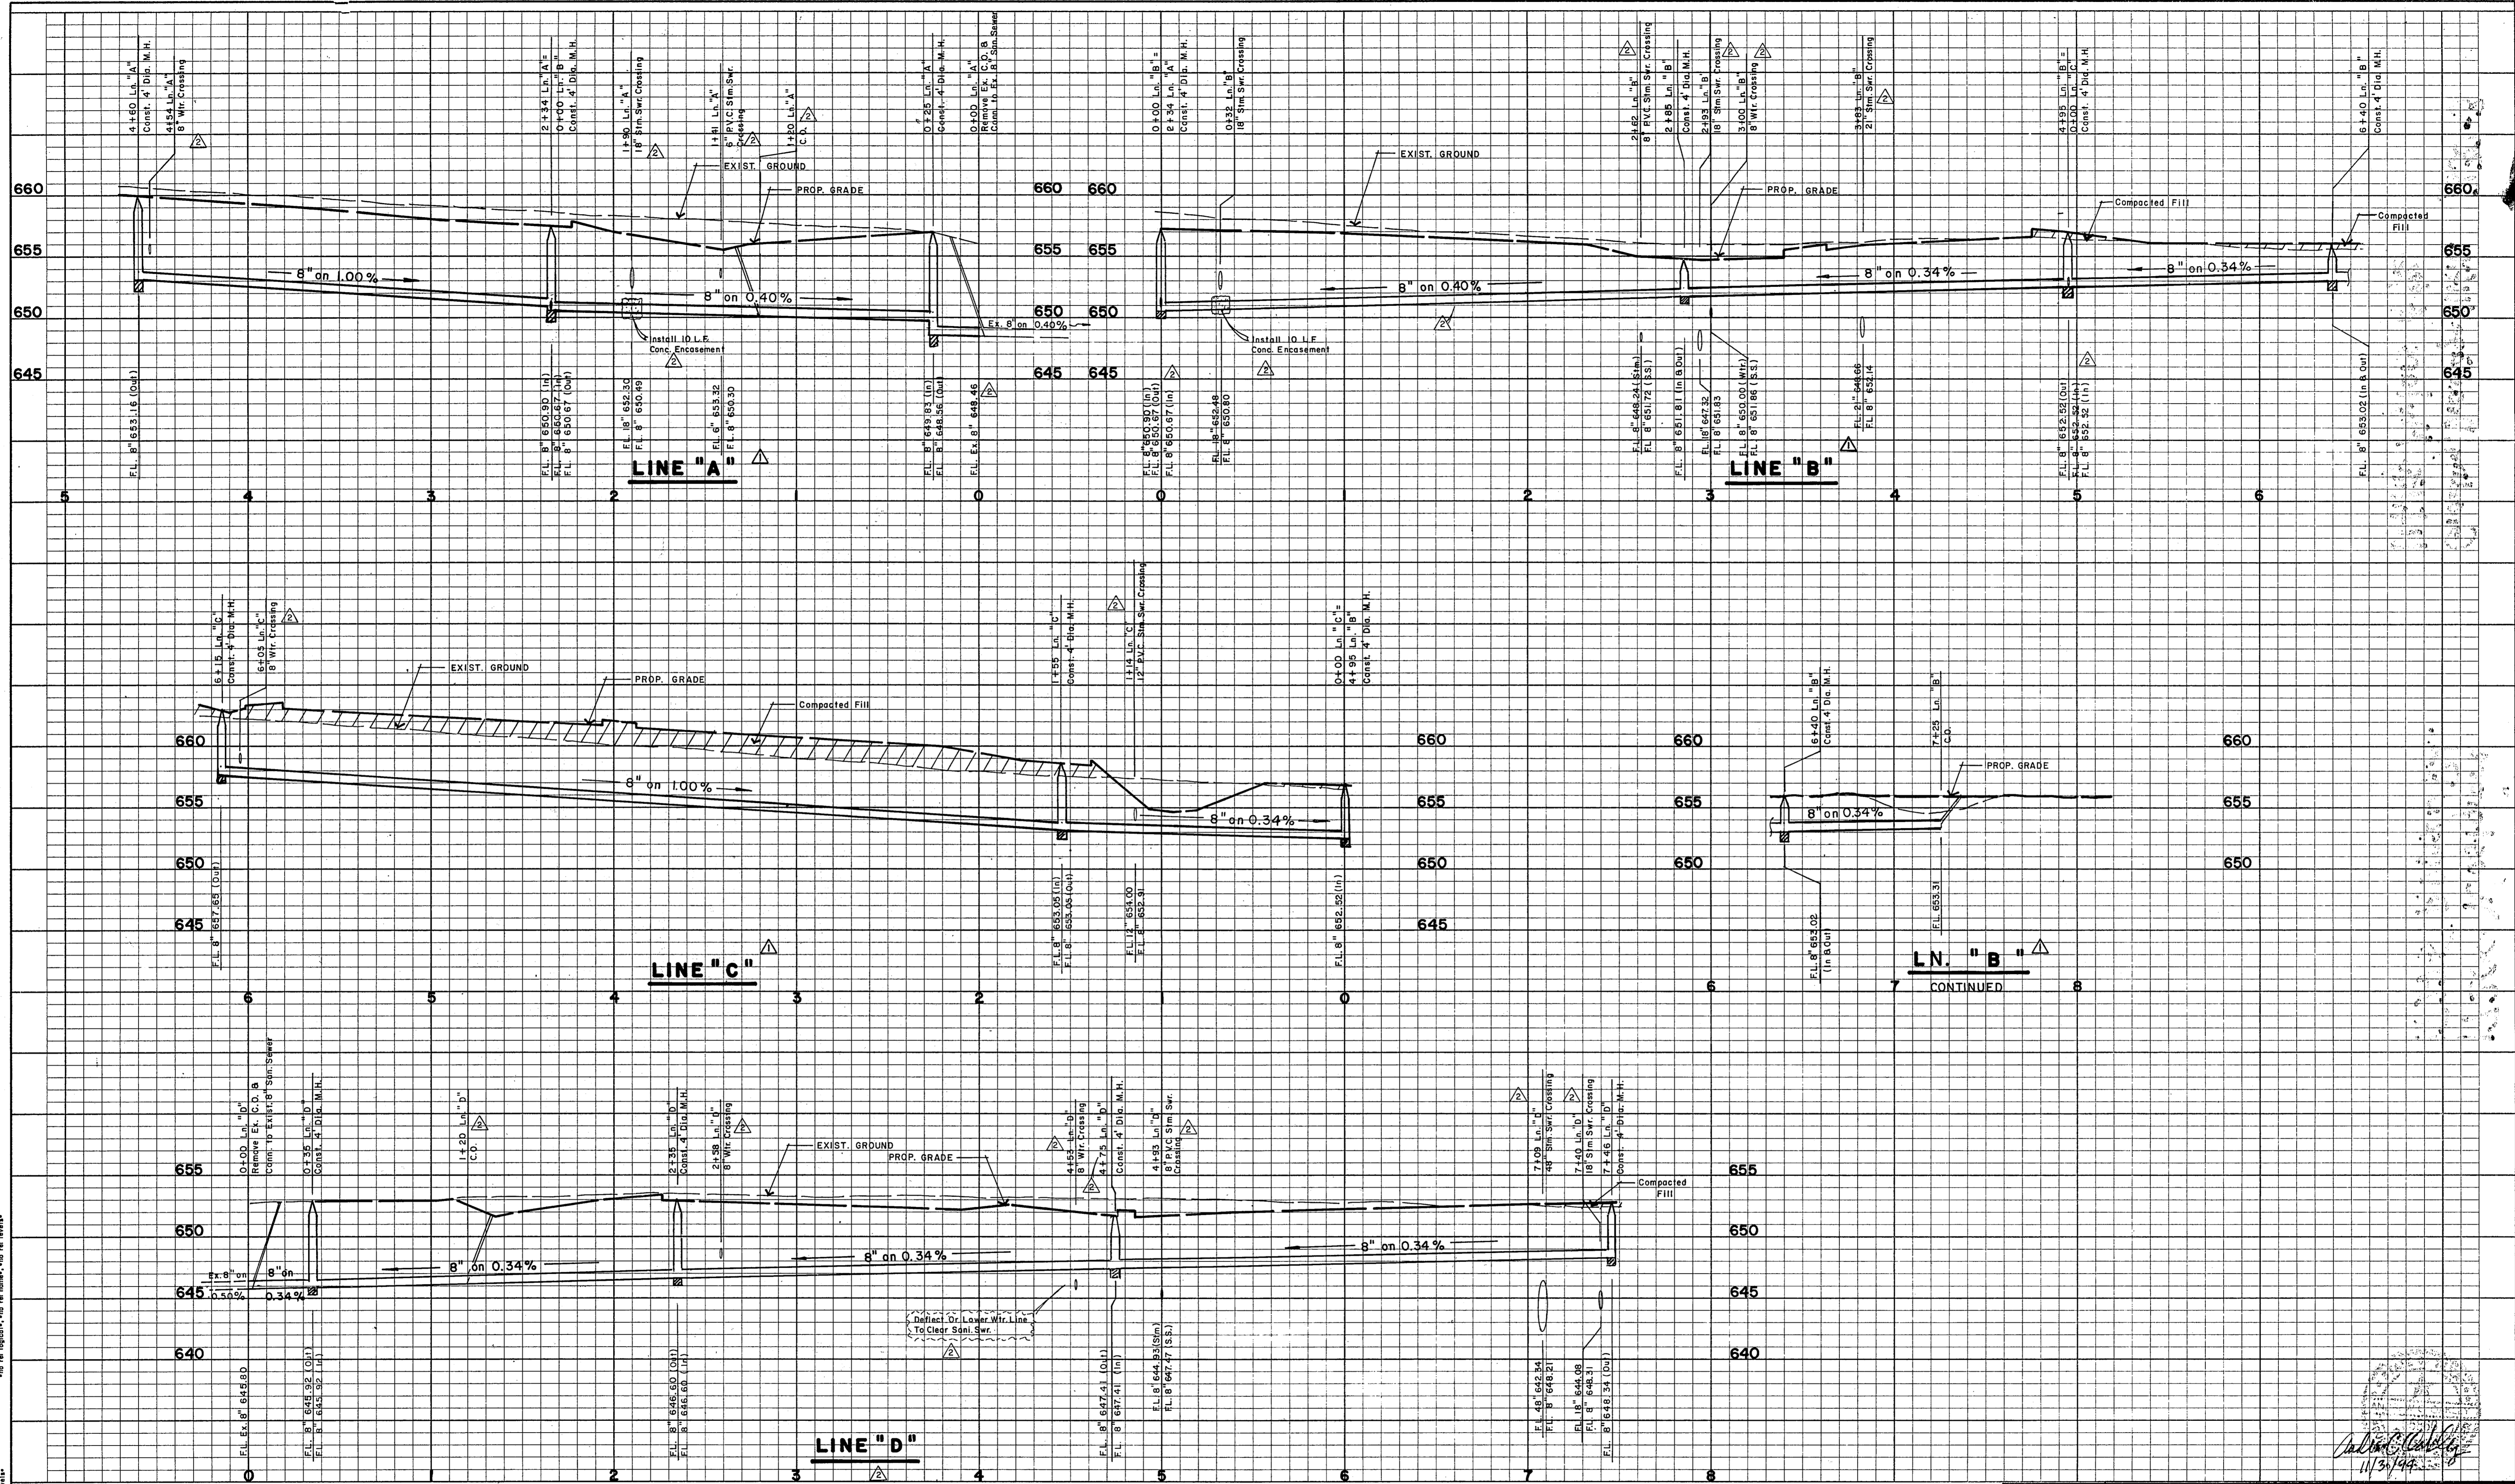

DATE	DESCRIPTION	REF. NO.
2/28/95	REV. LINE "D", ADD UTILITY CROSSINGS & MISC.	△
2/24/95	REVISED SAN. SEWER	△
12/28/94	CITY SUBMITTAL	
	REVISIONS & ISSUE DATES	

BENCH MARK:
 Top Disk South End Of Curb Inlet On The West Side
 Of Addison Road 735' +/- North Of Sojourn Drive.
 ELEVATION = 640.12
 *Cut North End Of Recessed Inlet On The West Side
 Of Westgrove 665' +/- North Of Sojourn Drive.
 ELEVATION = 661.37

SANITARY SEWER PROFILES

THE DOMINION

TOWN OF ADDISON DALLAS COUNTY, TEXAS

CAMDEN PROPERTY TRUST 3200 SOUTHWEST FREEWAY 1500 PHOENIX TOWER HOUSTON, TEXAS 77027	Sheet No. C 15 of 18 Project No. 01-1751-03
---	--

HUIT - ZOLLARS
 3131 MCKINNEY AVENUE STE. 600
 DALLAS, TEXAS 75244-3311
 DALLAS/FORT WORTH/PHOENIX/HOUSTON