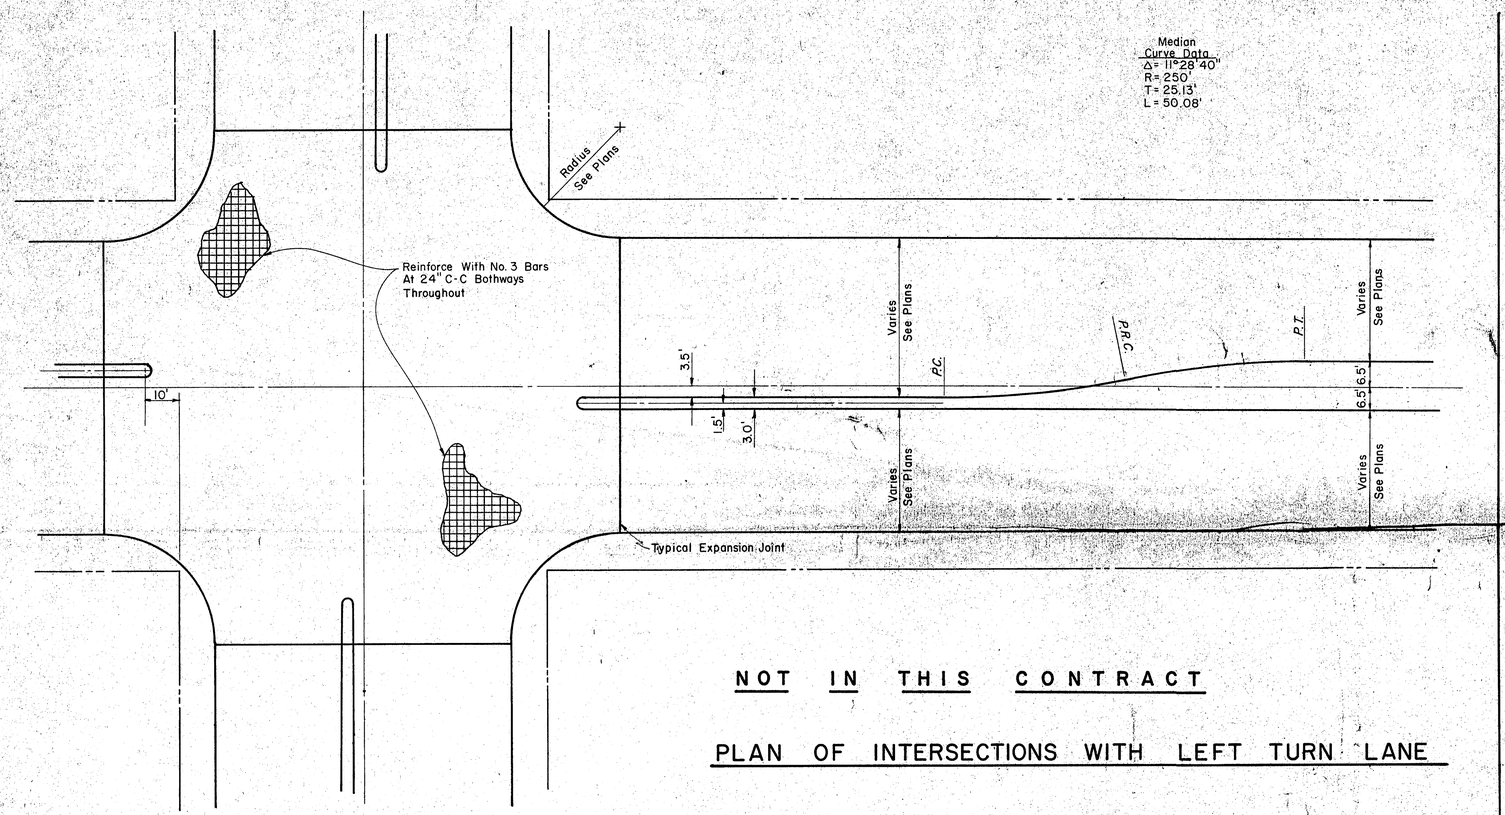

NOT IN THIS CONTRACT

PLAN OF INTERSECTIONS WITH LEFT TURN LANE

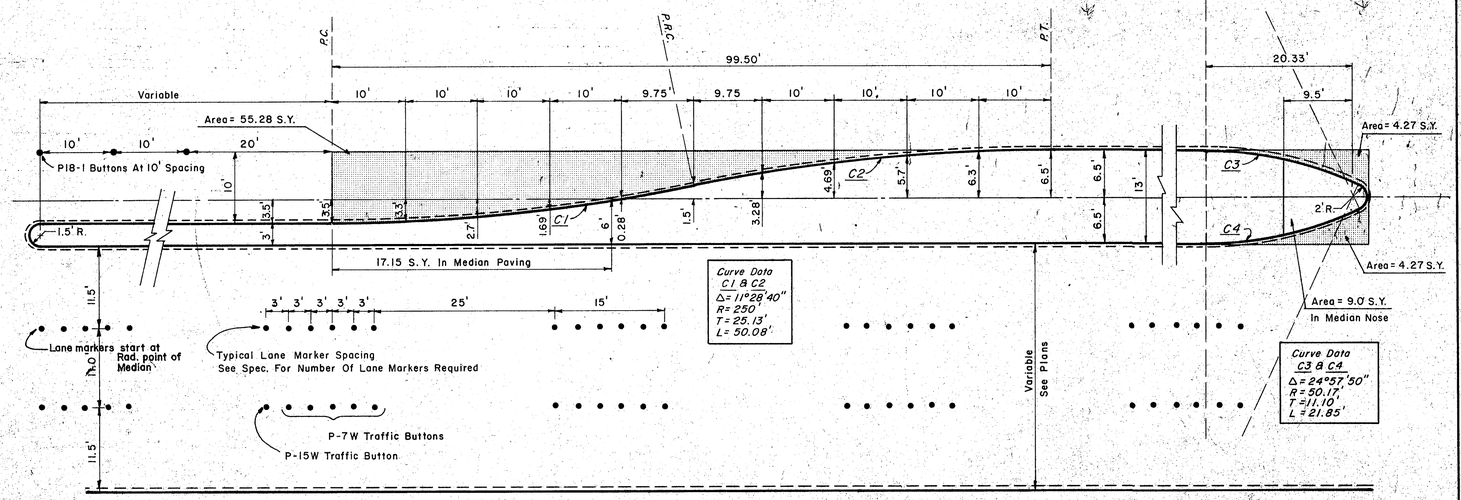

NOT IN THIS CONTRACT

LEFT TURN LANE & LANE MARKER DETAIL

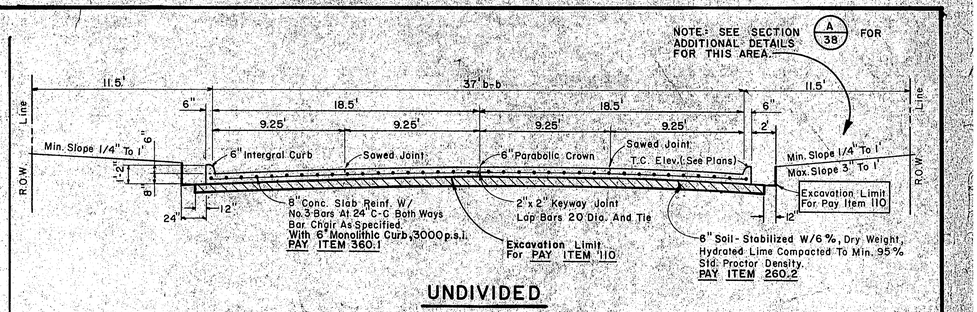

UNDIVIDED

"NOT IN THIS CONTRACT"

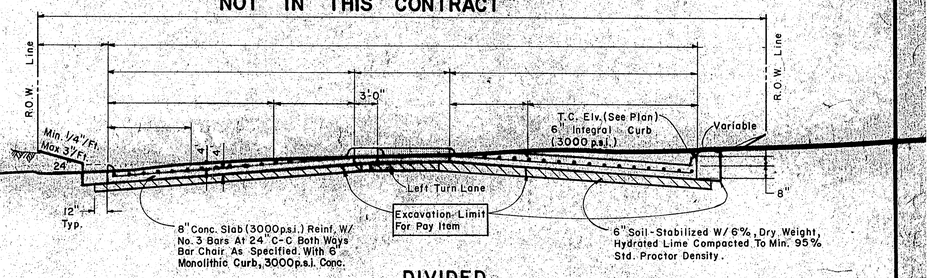

DIVIDED

TYPICAL PAVING SECTION DETAILS

NOTE: For Changes to Typical Sections See Sht. 38.

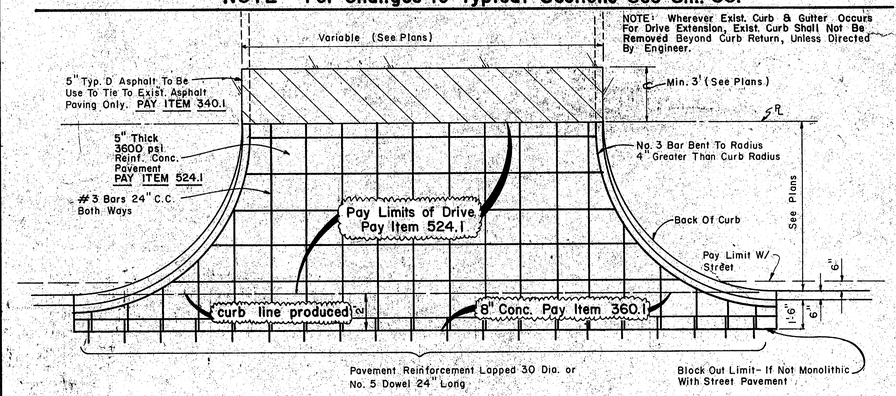

DRIVEWAY PAVING DETAIL

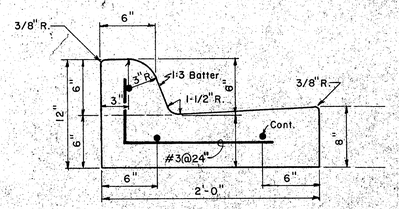

SEPARATE CURB & GUTTER

REINFORCEMENT SHALL BE No. 5 BARS

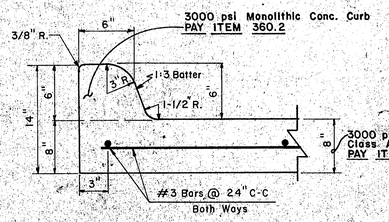

6" INTEGRAL CURB & GUTTER DETAIL

Record Set 5/9/85

CITY OF ADDISON
DALLAS COUNTY, TEXAS

WESTGROVE/VOSS ROAD IMPROVEMENTS

STANDARD PAVING DETAILS A

GINN, INC.
Consulting Engineers, Dallas, Texas

DESIGNED- H.K.	DRAWN- S.M.M.	DATE- SEPT., 1982	JOB No. J-192
APPROVED- H.G.	CHECKED- G.F.	SCALE- NONE	SHEET 18 OF