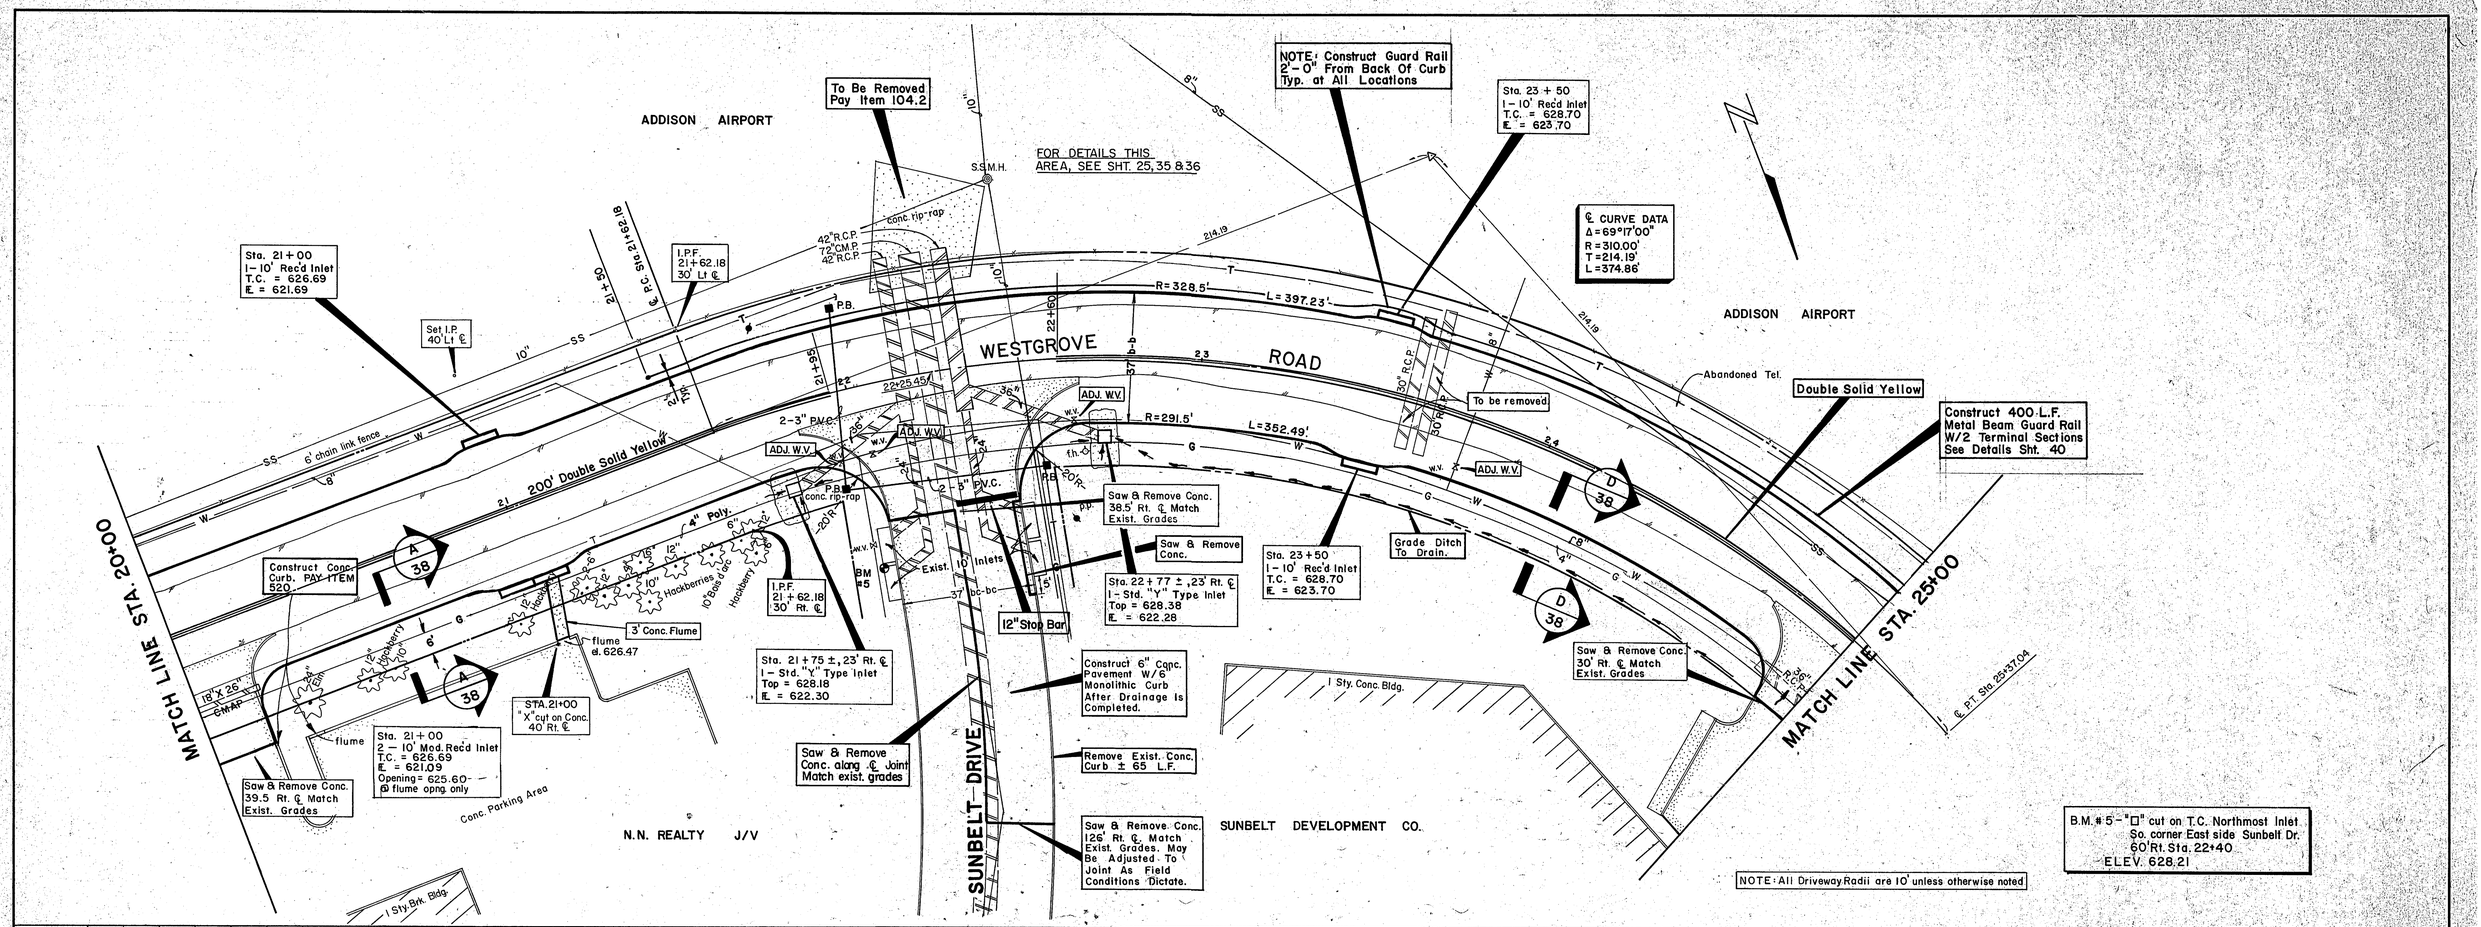

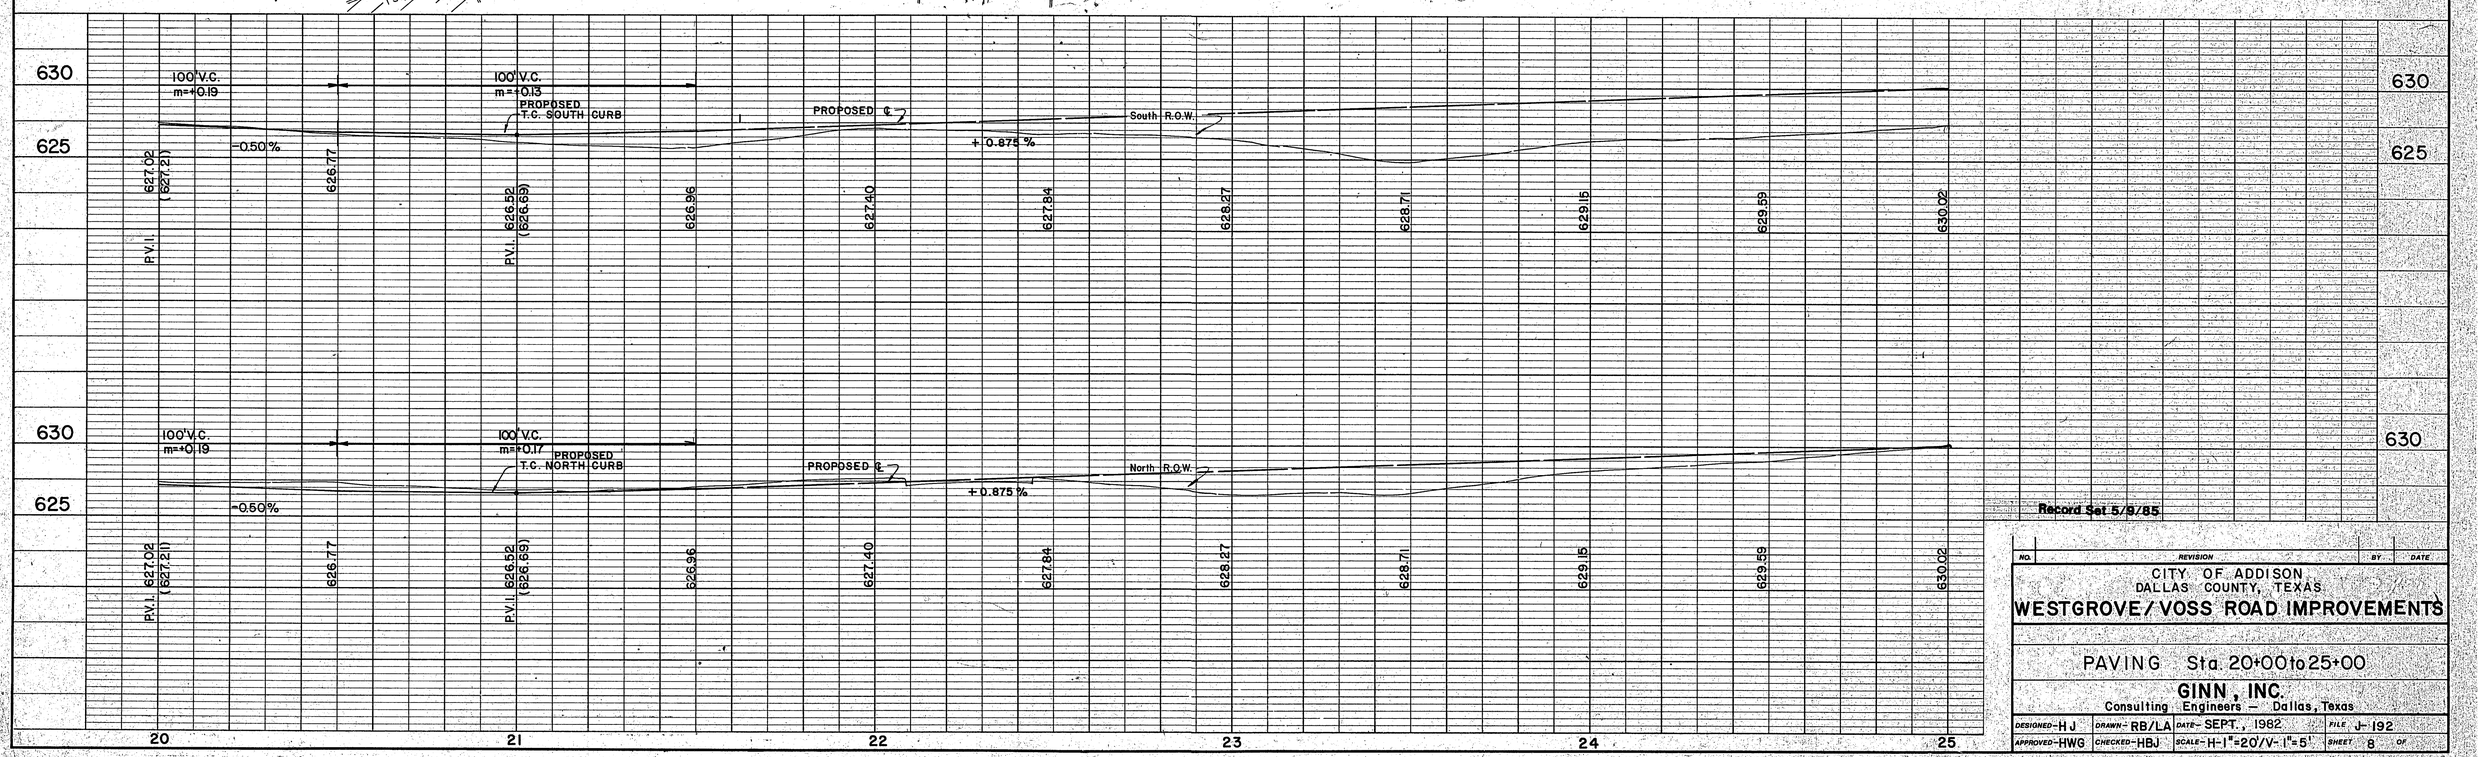

Record Set 5/9/85

NO.	REVISION	BY	DATE

CITY OF ADDISON
DALLAS COUNTY, TEXAS

WESTGROVE / VOSS ROAD IMPROVEMENTS

PAVING Sta. 20+00 to 25+00

GINN, INC.
Consulting Engineers — Dallas, Texas

DESIGNED-HJ	DRAWN-RB/LA	DATE-SEPT., 1982	FILE J-192	
APPROVED-HWG	CHECKED-HBJ	SCALE-H-1"=20'/V-1"=5'	SHEET 8	OF