




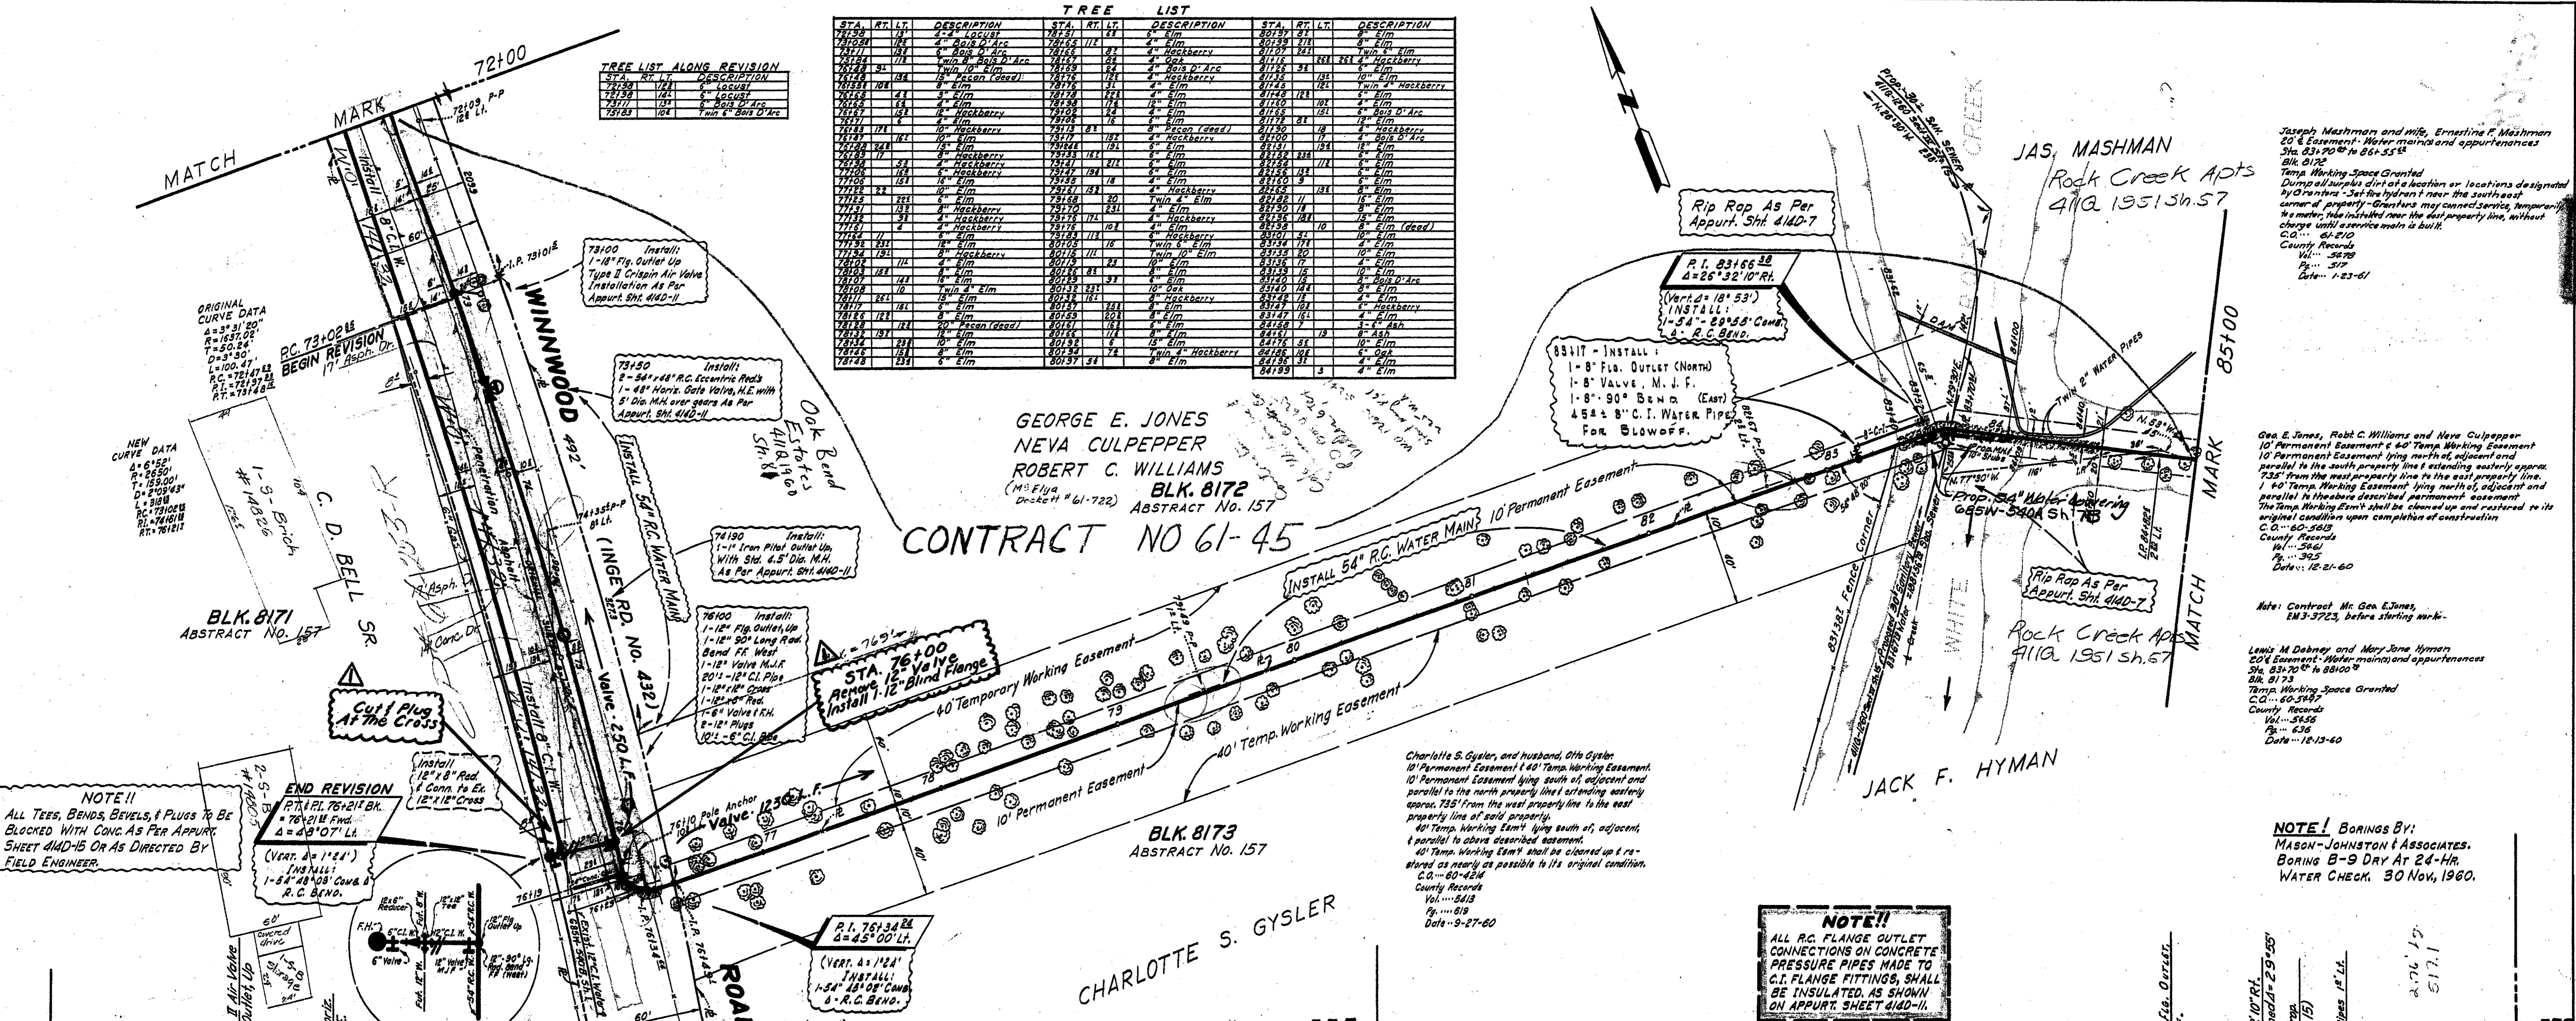


**NOTE!!**  
ALL TEES, BENDS, BEVELS, & PLUGS TO BE BLOCKED WITH CONC AS PER APPURT. SHEET 414-15 OR AS DIRECTED BY FIELD ENGINEER.

**END REVISION**  
P.I. 76134 24  
A=45°00' Lt.  
INSTALL:  

**STA. 76100**  

**NOTE!!**  
ALL R.C. FLANGE OUTLET CONNECTIONS ON CONCRETE PRESSURE PIPES MADE TO C.I. FLANGE FITTINGS, SHALL BE INSULATED AS SHOWN ON APPURT. SHEET 414-11.

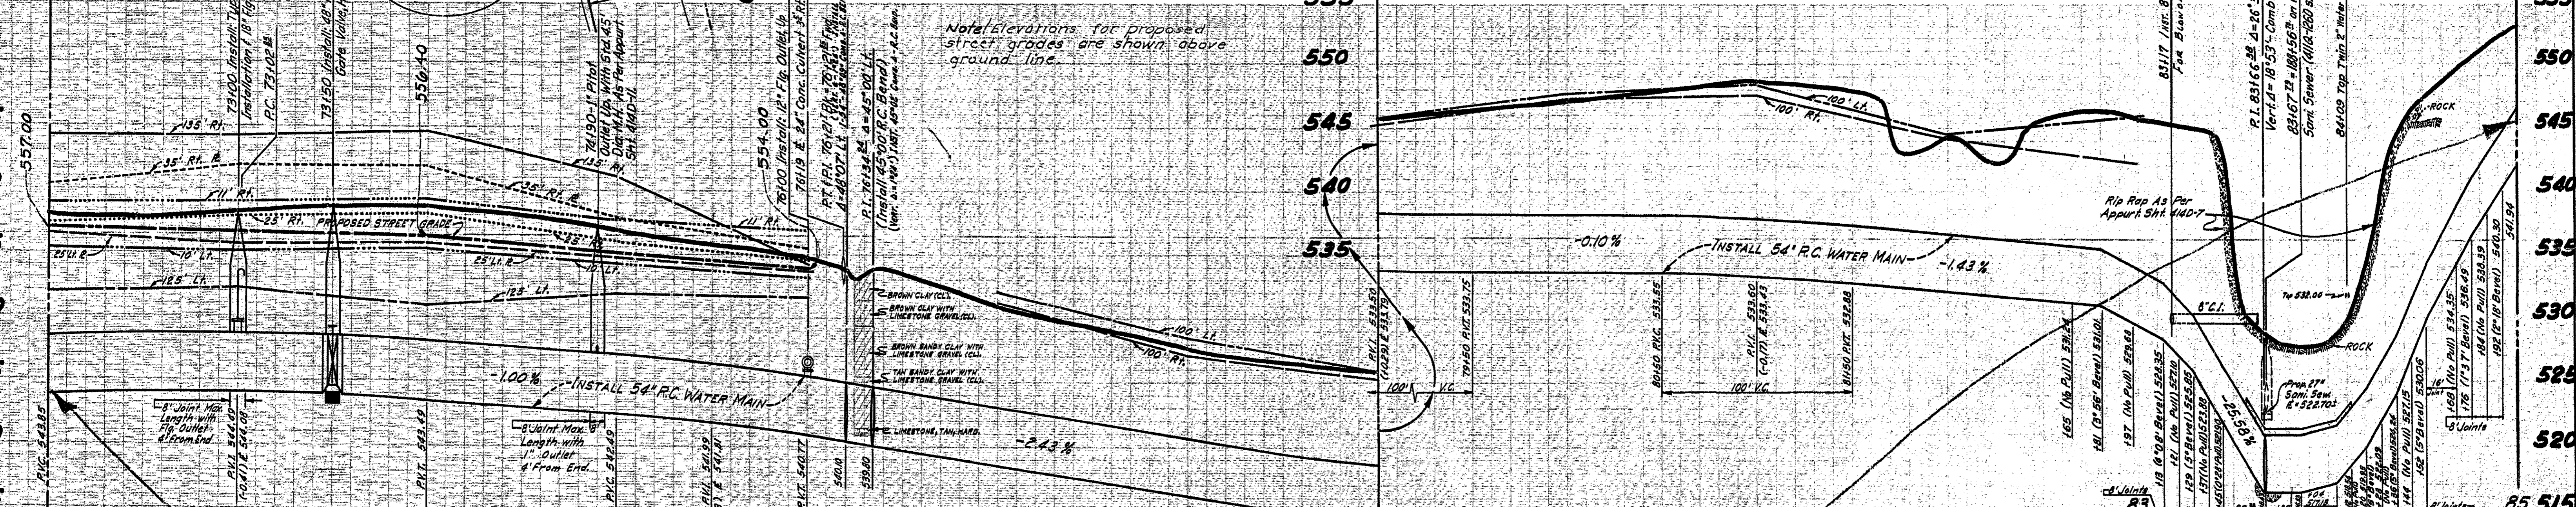

**CONTRACT NO 61-45**

129985 LINEAR FT. OF 54" DIA DOUBLE-WRAP PRESTRESSED CONCRETE CYLINDER PIPE - CLASS 150 DR  
129985 LINEAR FT. OF 54" DIA PRESTRESSED REINFORCED CONCRETE EMBEDDED CYLINDER PIPE - CLASS 150  
CLASS 3 EMBEDMENT

B.M. Sh. W.B.M. On N Side of Conc Bridge Over WHITE ROCK CREEK AT BELT LINE RD. Elevation = 558.10  
T.B.M. R.R. Spike In 28' Hackberry 42' Rt. of Sta. 76157, N Side of WINWOOD ST 1800' S. of BELT LINE RD. Elevation = 553.60

**54" WATER MAIN**  
IN BELT LINE RD. & WINWOOD RD.  
FROM INWOOD RD. TO DULLES RD.  
DALLAS CITY WATERWORKS  
CITY OF DALLAS, TEXAS

DESIGN	DRAWN	DATE	SCALE	NOTES	FILE	NO.
JACK D. GAMBELL	PAUL FARRIN	10-60	1"=100'	PROJ. 685W-540A	685W-540A	1