



CITY OF ADDISON CONT. #84-45

TREE LIST	
Sta.	Description
152779	10' Bois D'Arc
152812	10' Bois D'Arc
152813	10' Cluster Hackberry
152814	5' Hackberry
152815	5' Hackberry
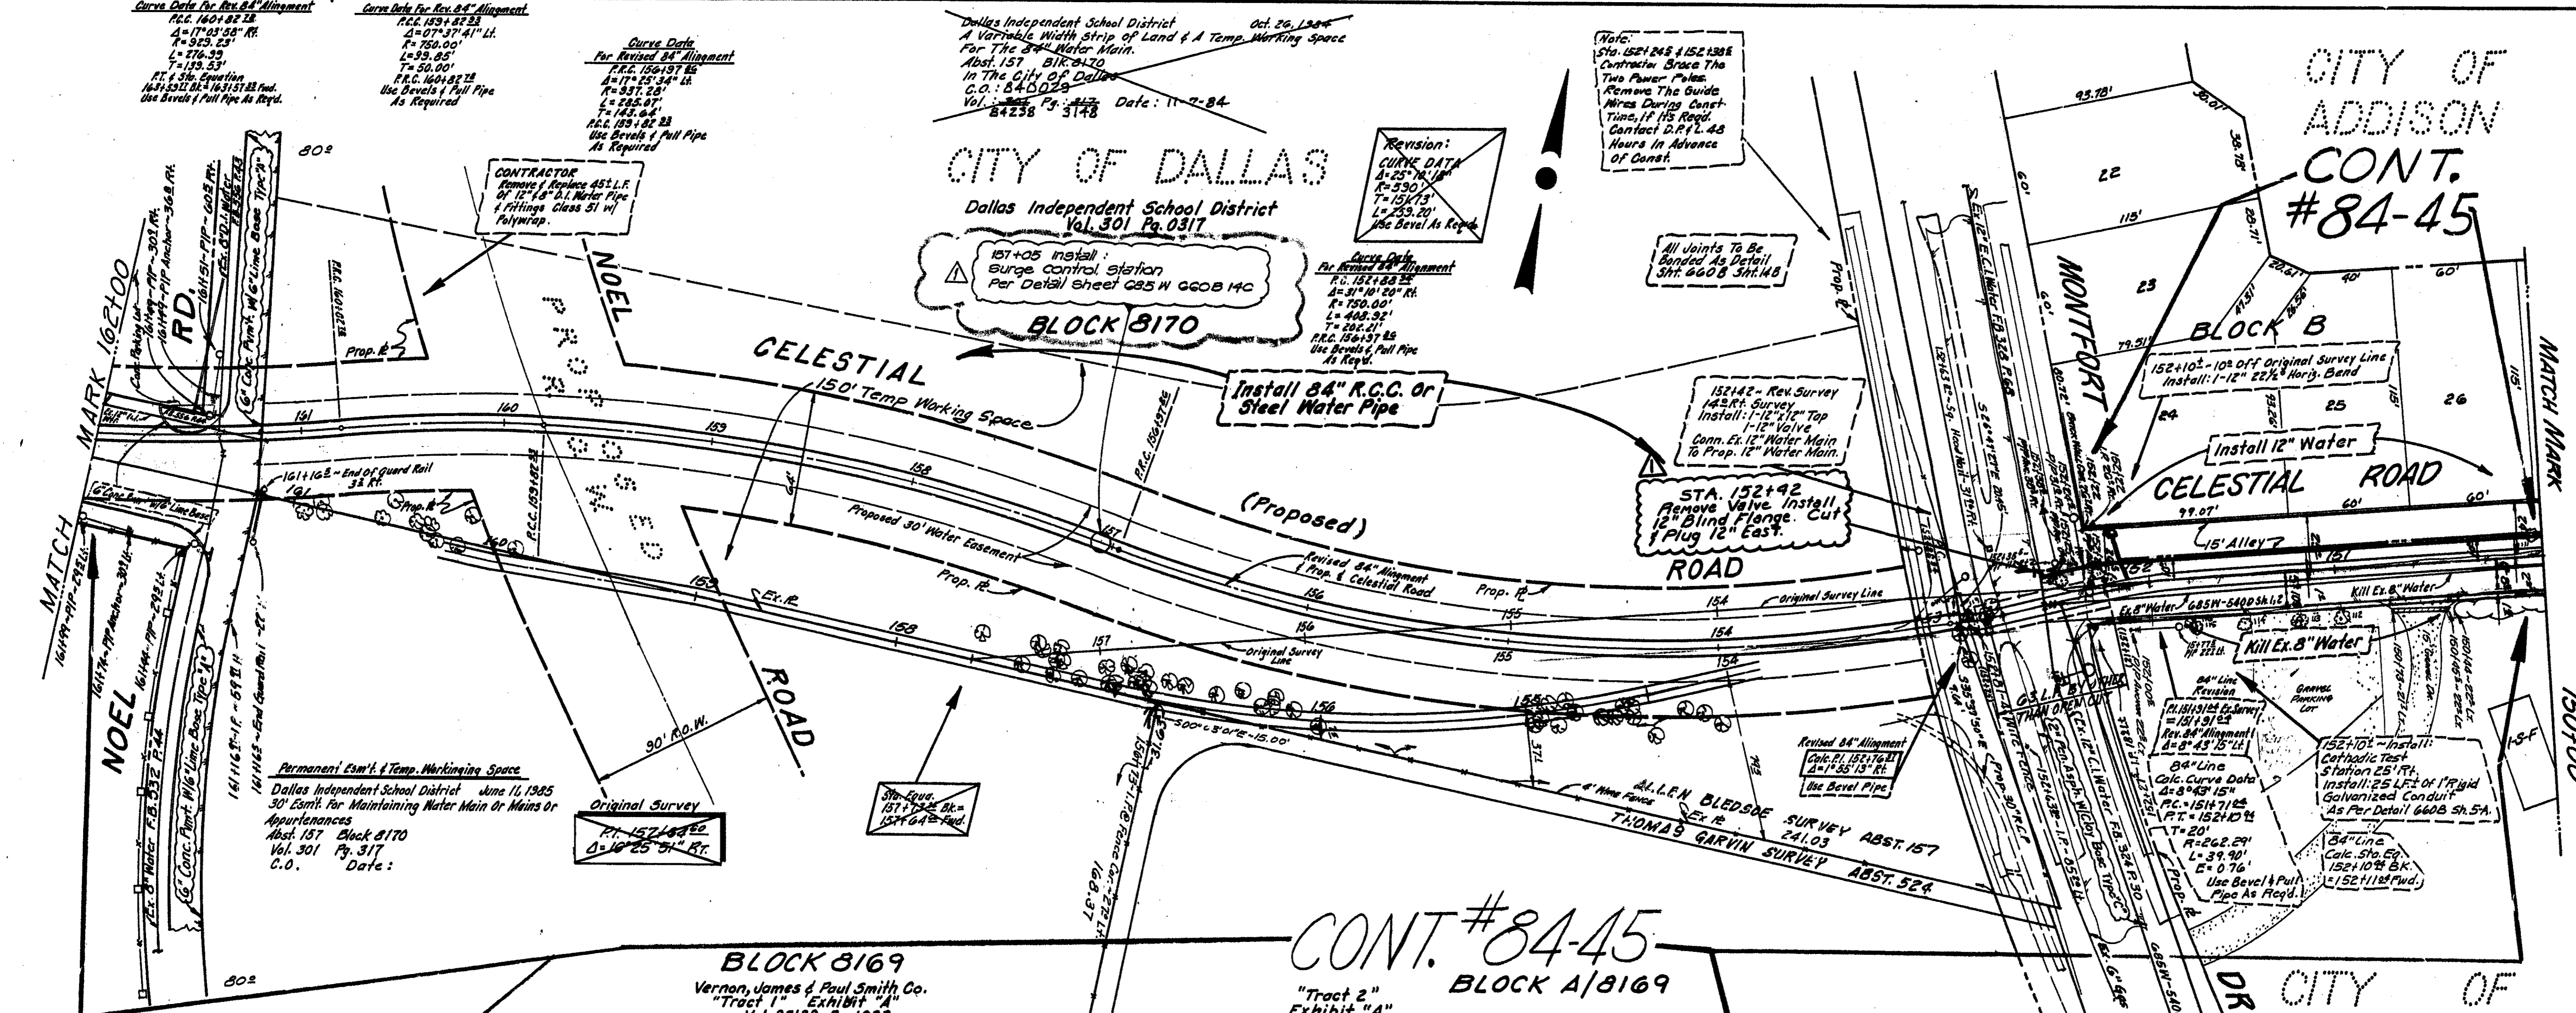

NOTE:
For Prop. Paving & Storm Sewer in MONTFORT DRIVE, see Public Works Plans, 310-318 Sh. 1-12 4210-3874 Sh. 1-11

CONT. #84-45 BLOCK A/8169 "Tract 2" Exhibit "A"

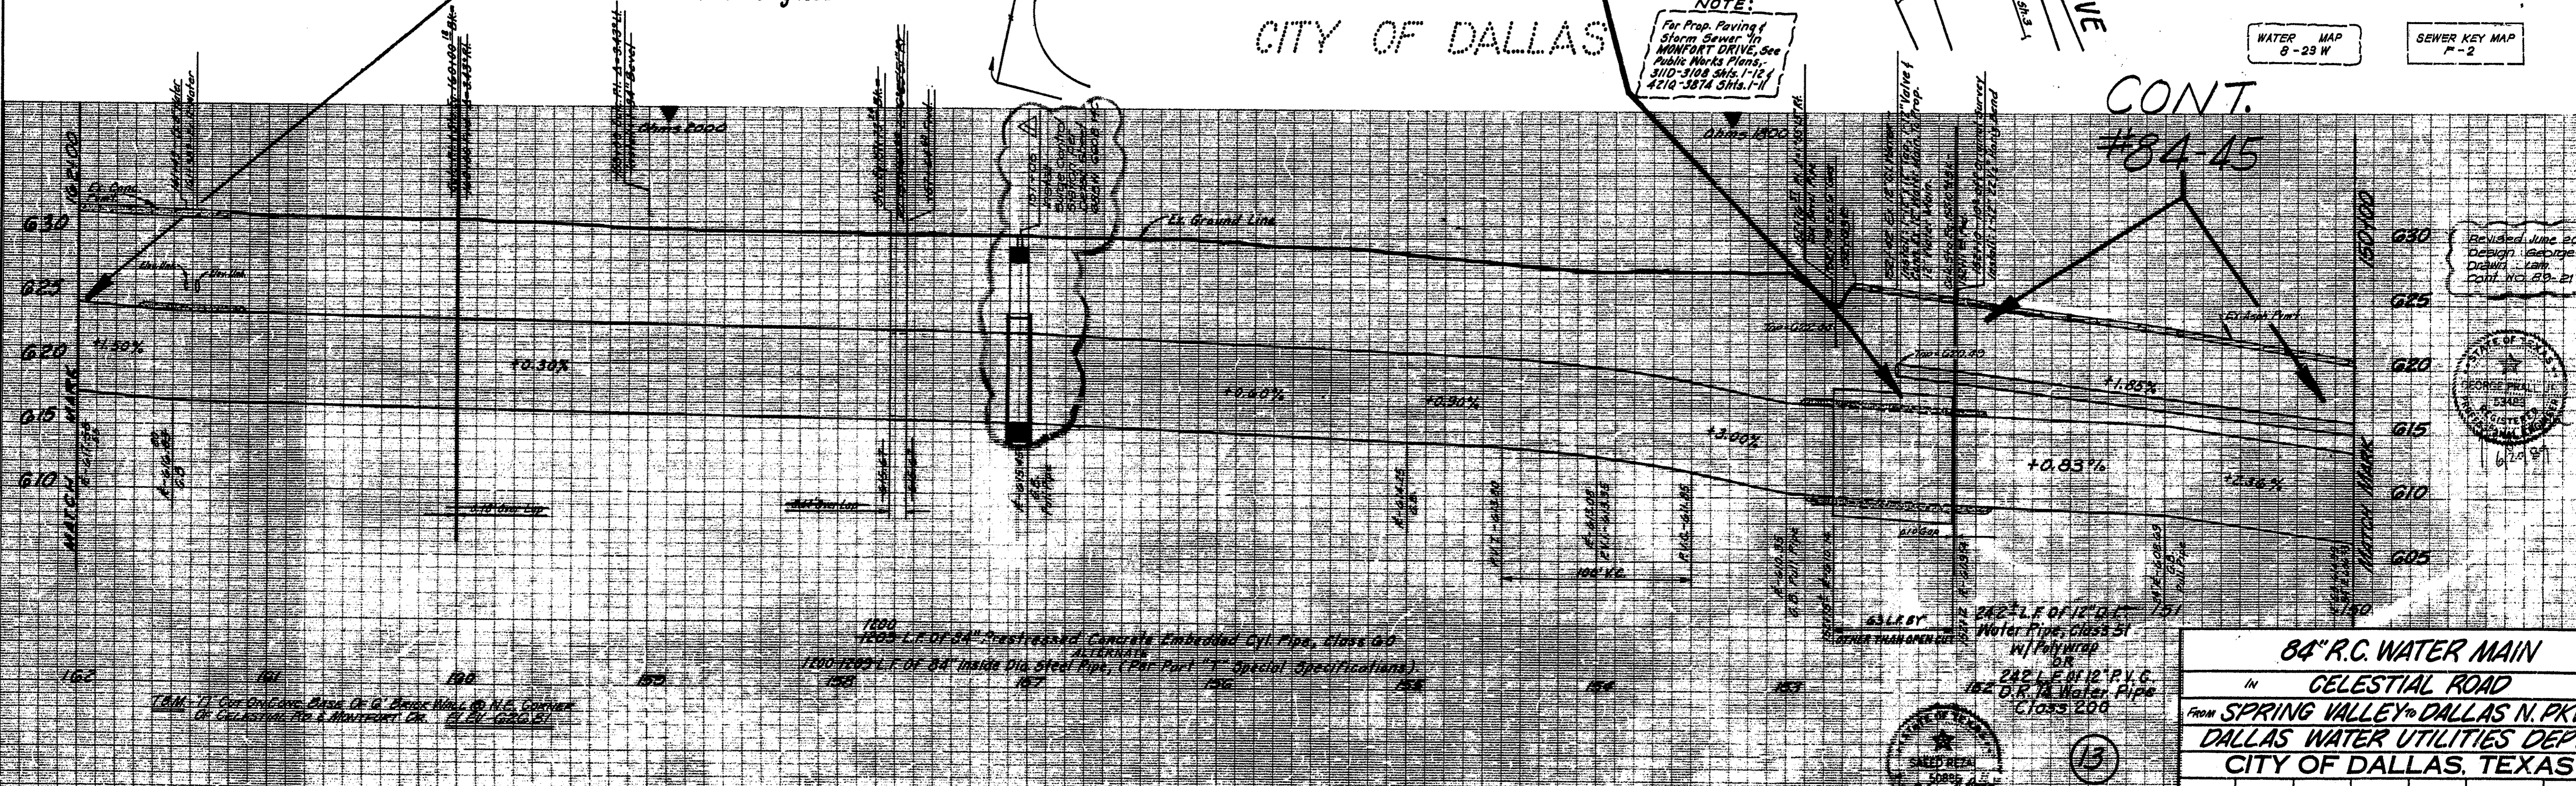

Revised June 20, 1988
Design: George Pratt
Drawn: LAM
Plant: No. 89-217



84" R.C. WATER MAIN
IN CELESTIAL ROAD
FROM SPRING VALLEY TO DALLAS N. PKWY.
DALLAS WATER UTILITIES DEPT.
CITY OF DALLAS, TEXAS

DESIGN	DRAWN	DATE	SCALE	NOTES	FILE	NO.
S. PEREZ	S. PEREZ	Jan. 84	1/4" = 1'-0"		GG5W	GG08

