
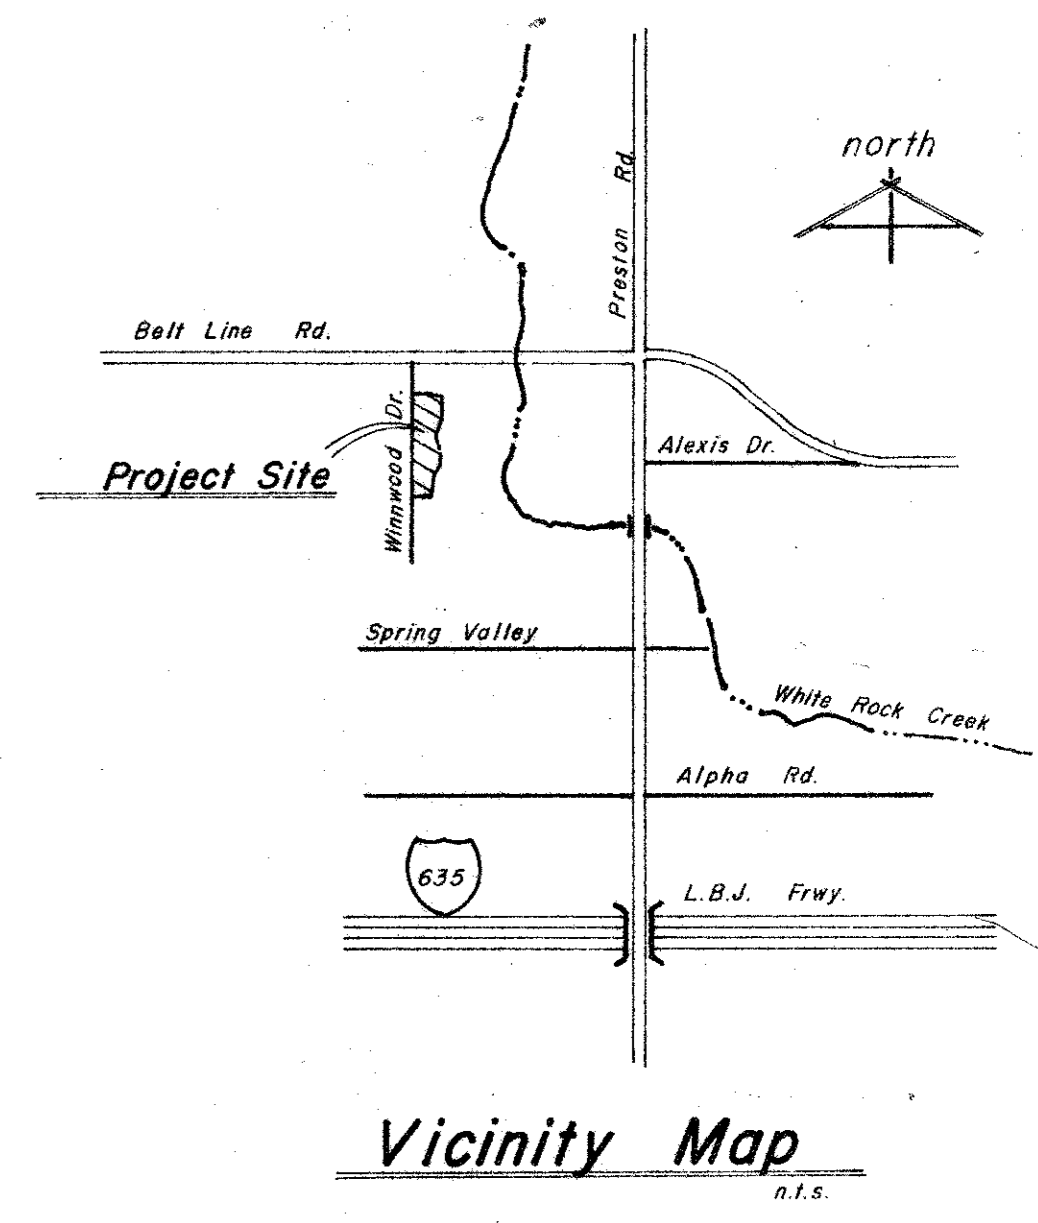


Scale: 1" = 100'

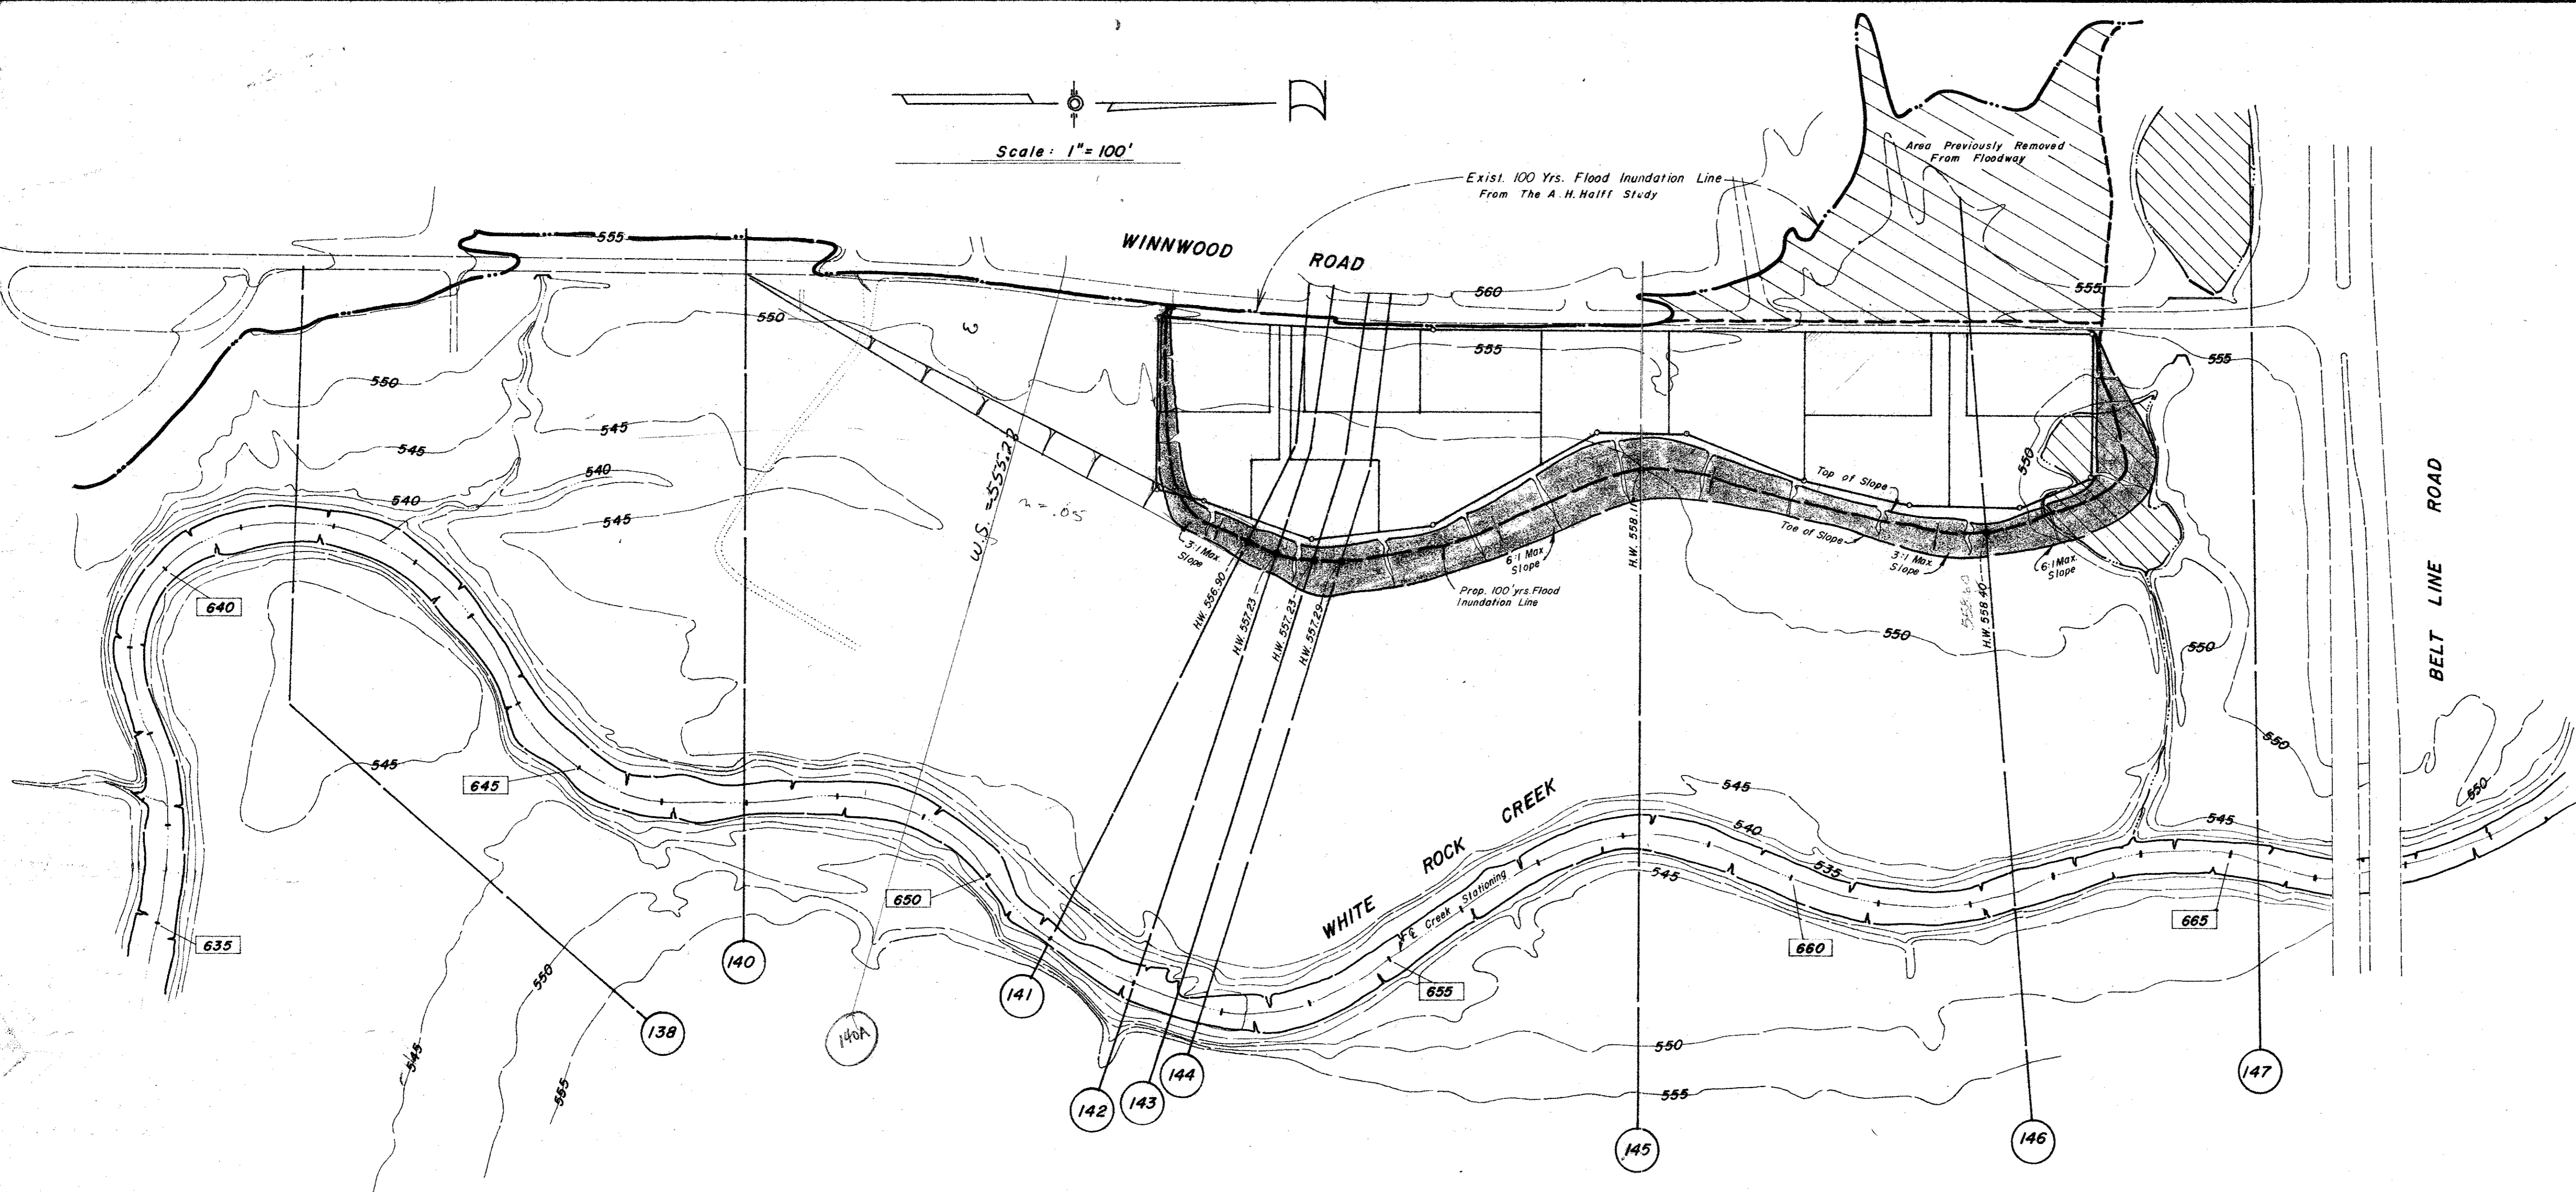

FILL PERMIT REQUEST
OAK BEND ESTATES

FOR
WILLARD BAKER and LAVERE BROOKS
 TWO TURTLE CREEK VILLAGE
 DALLAS , TEXAS 75219

BY
HUITT-ZOLLARS, Consulting Engineers
 8730 KING GEORGE, SUITE 121
 DALLAS , TEXAS 75235