


CAUTION!
 Underground Gas Main In This Area.
 Contact Lone Star Gas Company 2
 Working Days Prior To Construction.
 Call MR. Leon Weatherford At
 276-1171

Contractor Shall Notify Dallas
 Water Utilities Construction
 Inspection At 670-8700 At
 Least 48 Hours Prior To
 The Start Of Construction.

B.M. - "B" Cut on edge of concrete
 porch of Church at 5555 Celestial.
 ELEV. 577.95 (m.s.l.)

B.M. - "D" Cut on headwall, E. Side
 of Winnwood, 180' S. of Bell Line &
 ELEV. 553.79 (m.s.l.)

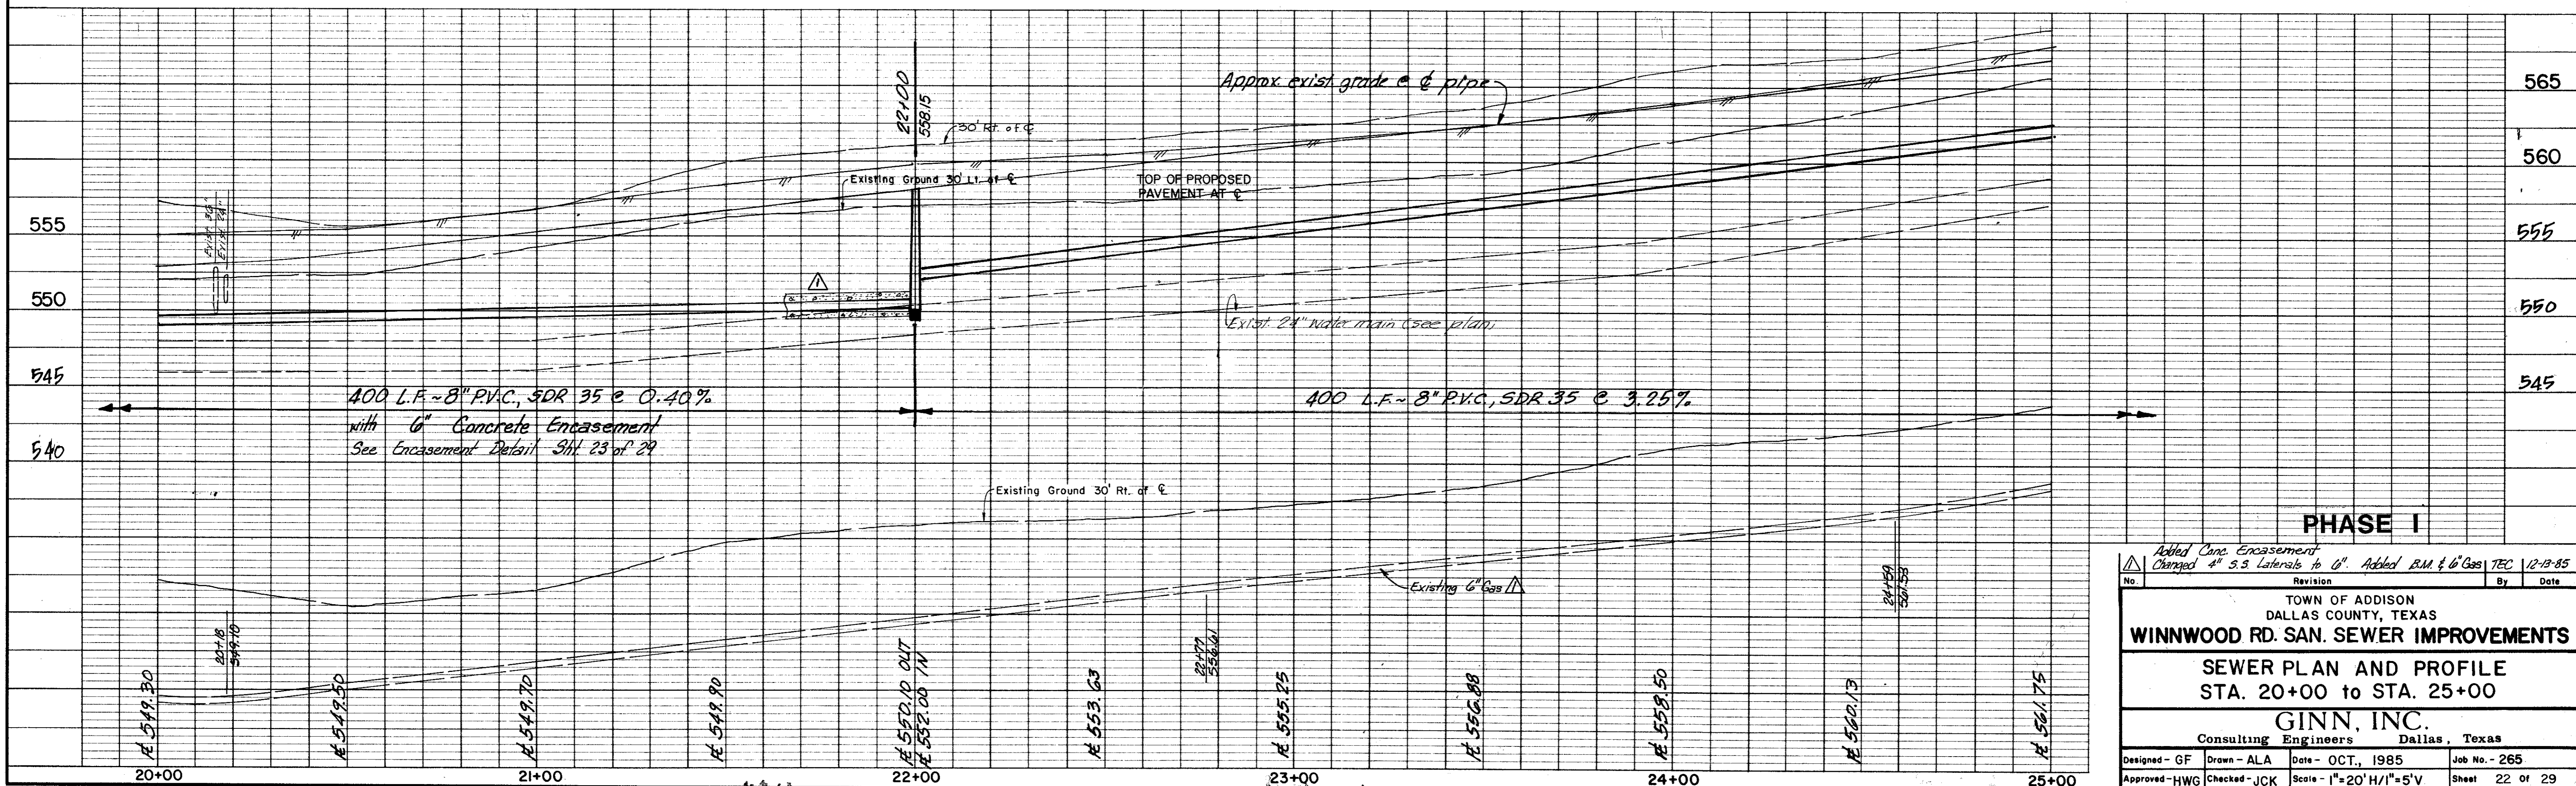

PHASE I

Added Conc. Encasement			
Changed 4\"/>			
No.	Revision	By	Date
TOWN OF ADDISON DALLAS COUNTY, TEXAS			
WINNWOOD RD. SAN. SEWER IMPROVEMENTS			
SEWER PLAN AND PROFILE STA. 20+00 to STA. 25+00			
GINN, INC. Consulting Engineers Dallas, Texas			
Designed - GF	Drawn - ALA	Date - OCT., 1985	Job No. - 265
Approved - HWG	Checked - JCK	Scale - 1"=20' H/1"=5' V	Sheet 22 Of 29