


4 CONG. CURB DETAIL
1 1/2" = 1'-0"

3 TURN-DOWN CURB DETAIL
1 1/2" = 1'-0"

2 EXP. JT. AT CONG. WALK
1 1/2" = 1'-0"

1 CONG. WALK AT PANELS
1 1/2" = 1'-0"

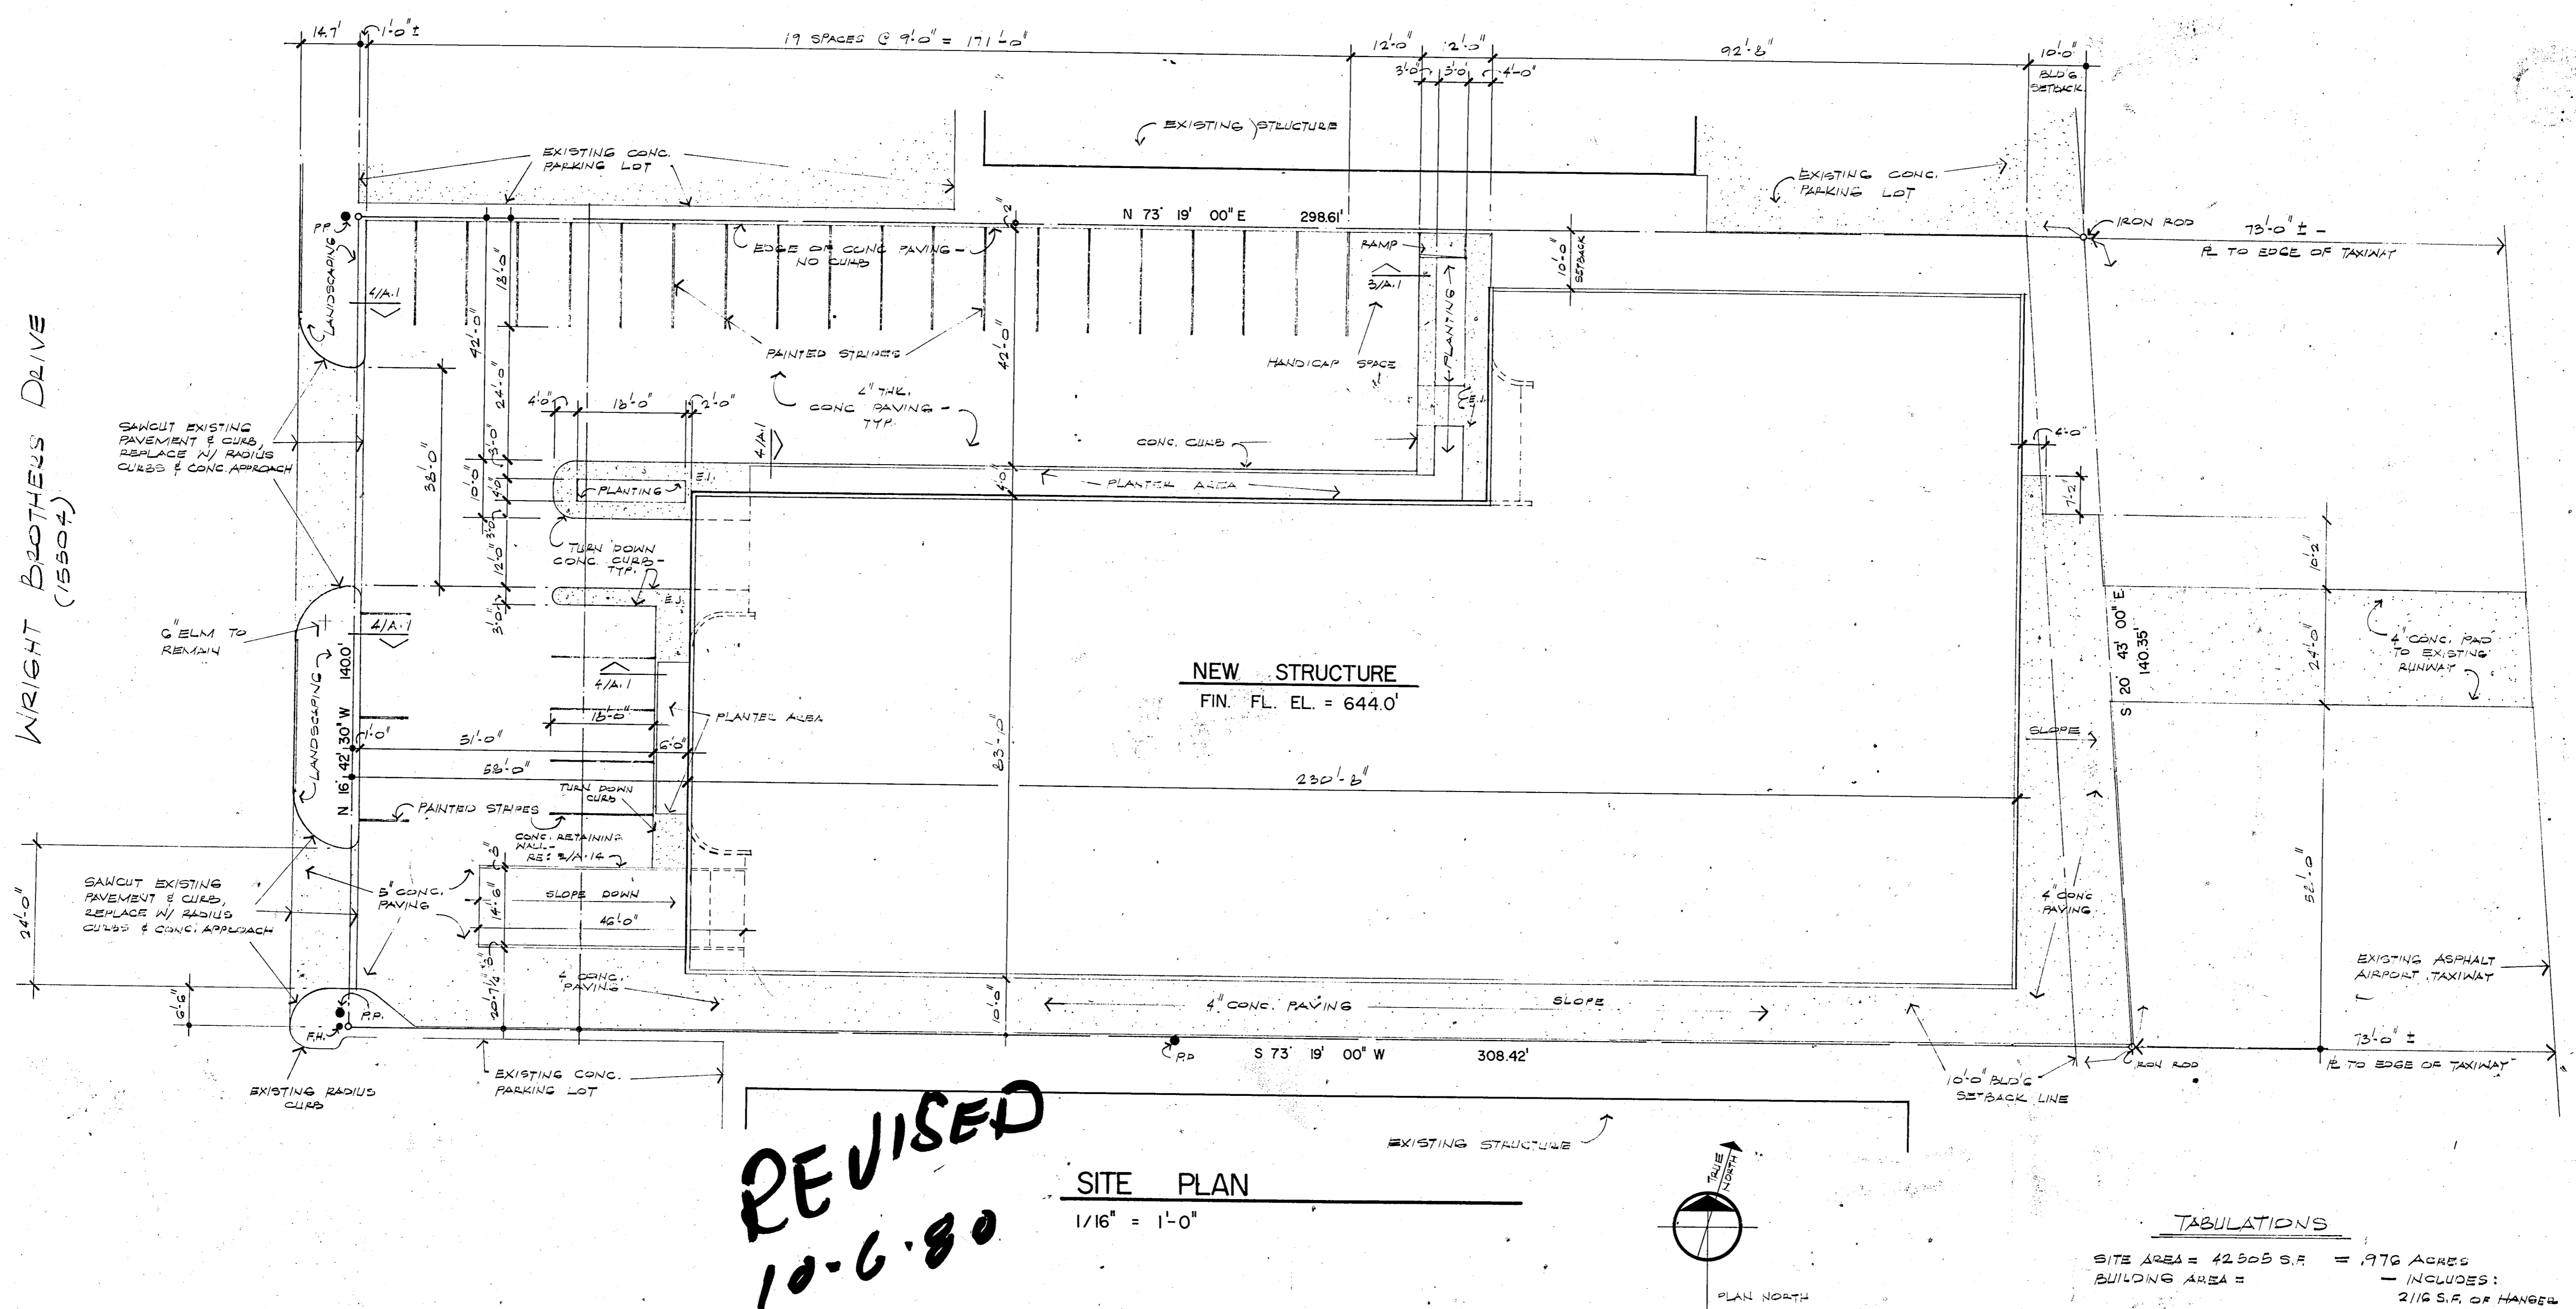

REVISED
10-6-80

SITE PLAN
1/16" = 1'-0"

TABULATIONS
SITE AREA = 42,505 S.F. = .976 ACRES
BUILDING AREA =
2 1/2 S.F. OF HANGAR
1980 S.F. OF OFFICES
PARKING INDICATED = 23 SPACES (INCLUDES 1 HANDICAP)

Revisions		
Date	No.	Description

THE HANESS TWICHELL PARTNERSHIP
ARCHITECTS
701 COMMERCE ST., #305 • DALLAS, TX. 75202 748-6461

OFFICE & WAREHOUSE FACILITY
FOR
HOWARD S. TWICHELL CO.
ADDISON TEXAS

SITE PLAN
934-8075
MIKE TWICHELL

DATE	SHEET
8-13-80	A-1
JOB	79049