


LOCATION MAP
NORTH
NOT TO SCALE

UTILITY KEY

- PROPOSED STORM LINE
- PROPOSED WATER LINE
- PROPOSED SANITARY SEWER LINE
- EXISTING FIRE HYDRANT
- PROPOSED FIRE HYDRANT
- EXISTING MANHOLE
- PROPOSED MANHOLE

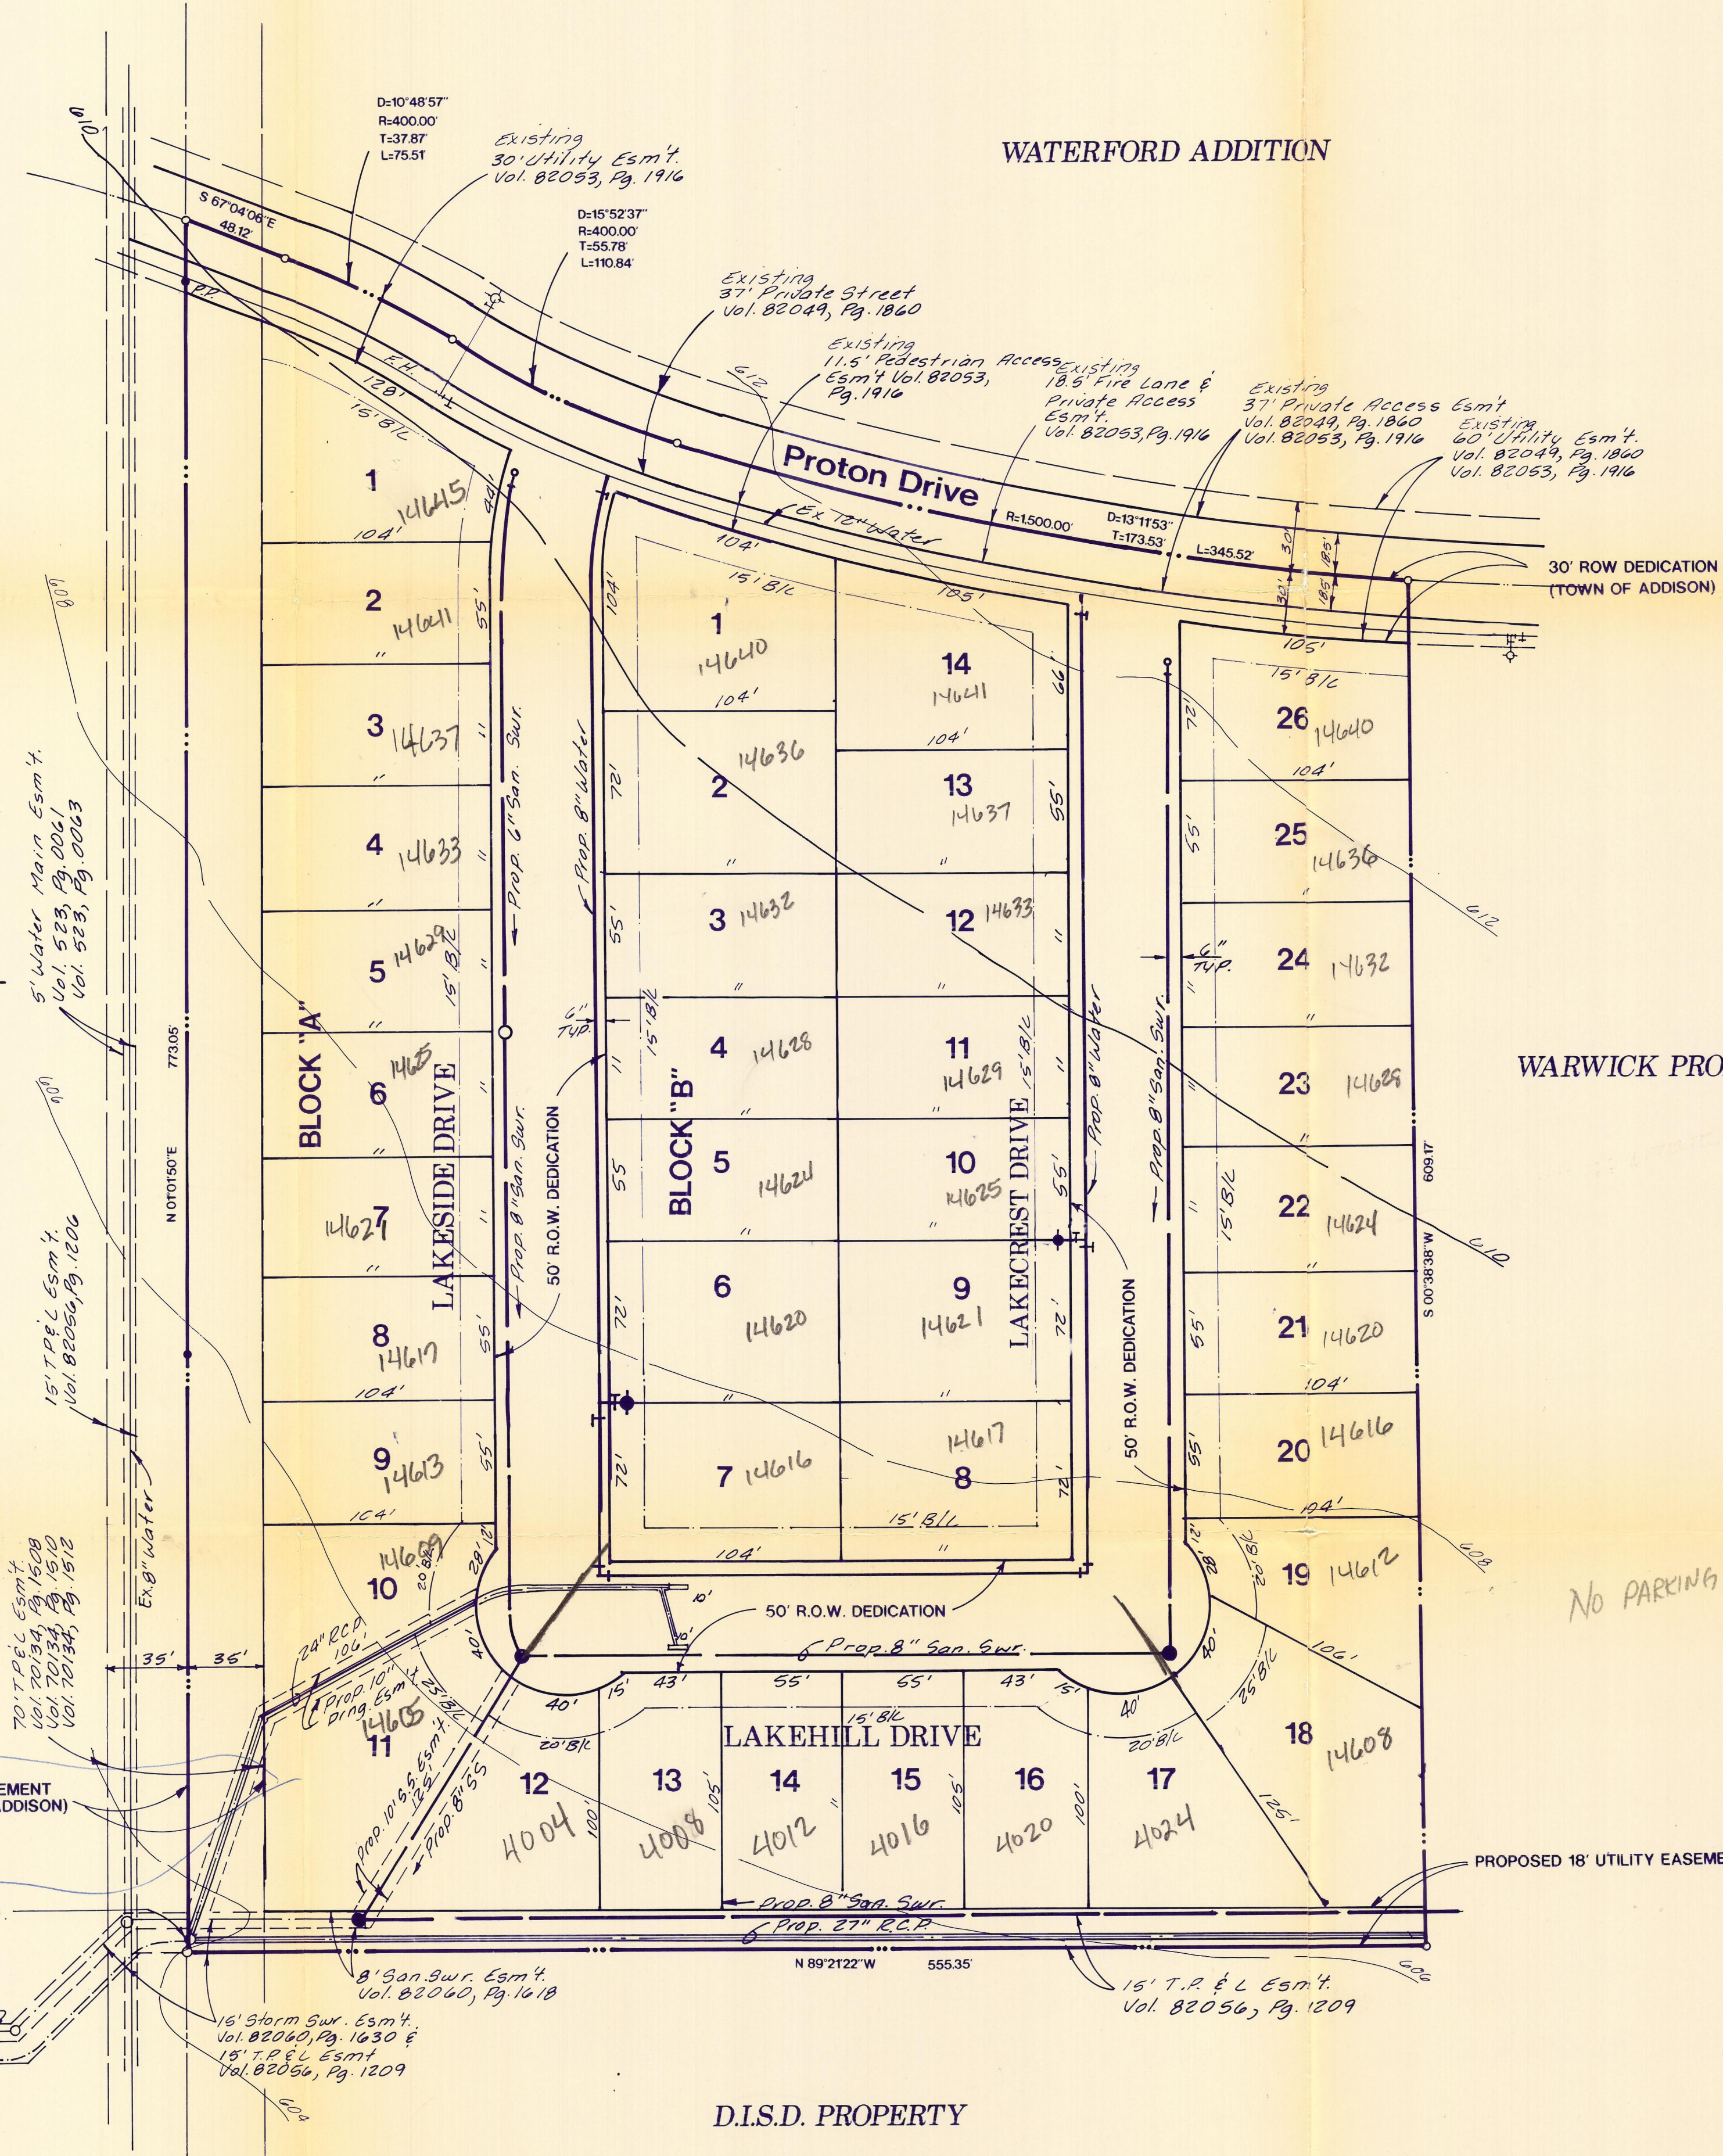

WATERFORD ADDITION

DATA SUMMARY

GROSS LAND AREA: _____ 8.4844 ACRES
 TOTAL NUMBER OF LOTS: _____ 40
 REQUIRED NUMBER OF LOTS GREATER THAN OR EQUAL TO 7500 SQ. FT.: _____ 10
 NUMBER OF LOTS GREATER THAN OR EQUAL TO 7500 SQ. FT.: _____ 10
 LOTS WITH AT LEAST 7,500 SQ. FT.:
 BLOCK "A" _____ LOTS 1,11,18,26
 BLOCK "B" _____ LOTS 1,2,6,7,8,9

40 LOTS
 PRELIMINARY PLAT
 OF
LES LACS I
 AN ADDITION TO THE
TOWN OF ADDISON, DALLAS COUNTY, TEXAS
 OUT OF THE
 THOMAS L. CHENOWITH SURVEY, ABSTRACT NO. 273

"MXR"
 MIXED USE RESIDENTIAL DISTRICT
 8.4844 ACRES



NO PARKING OFF OF PROTON ALLOWED

