


VICINITY MAP

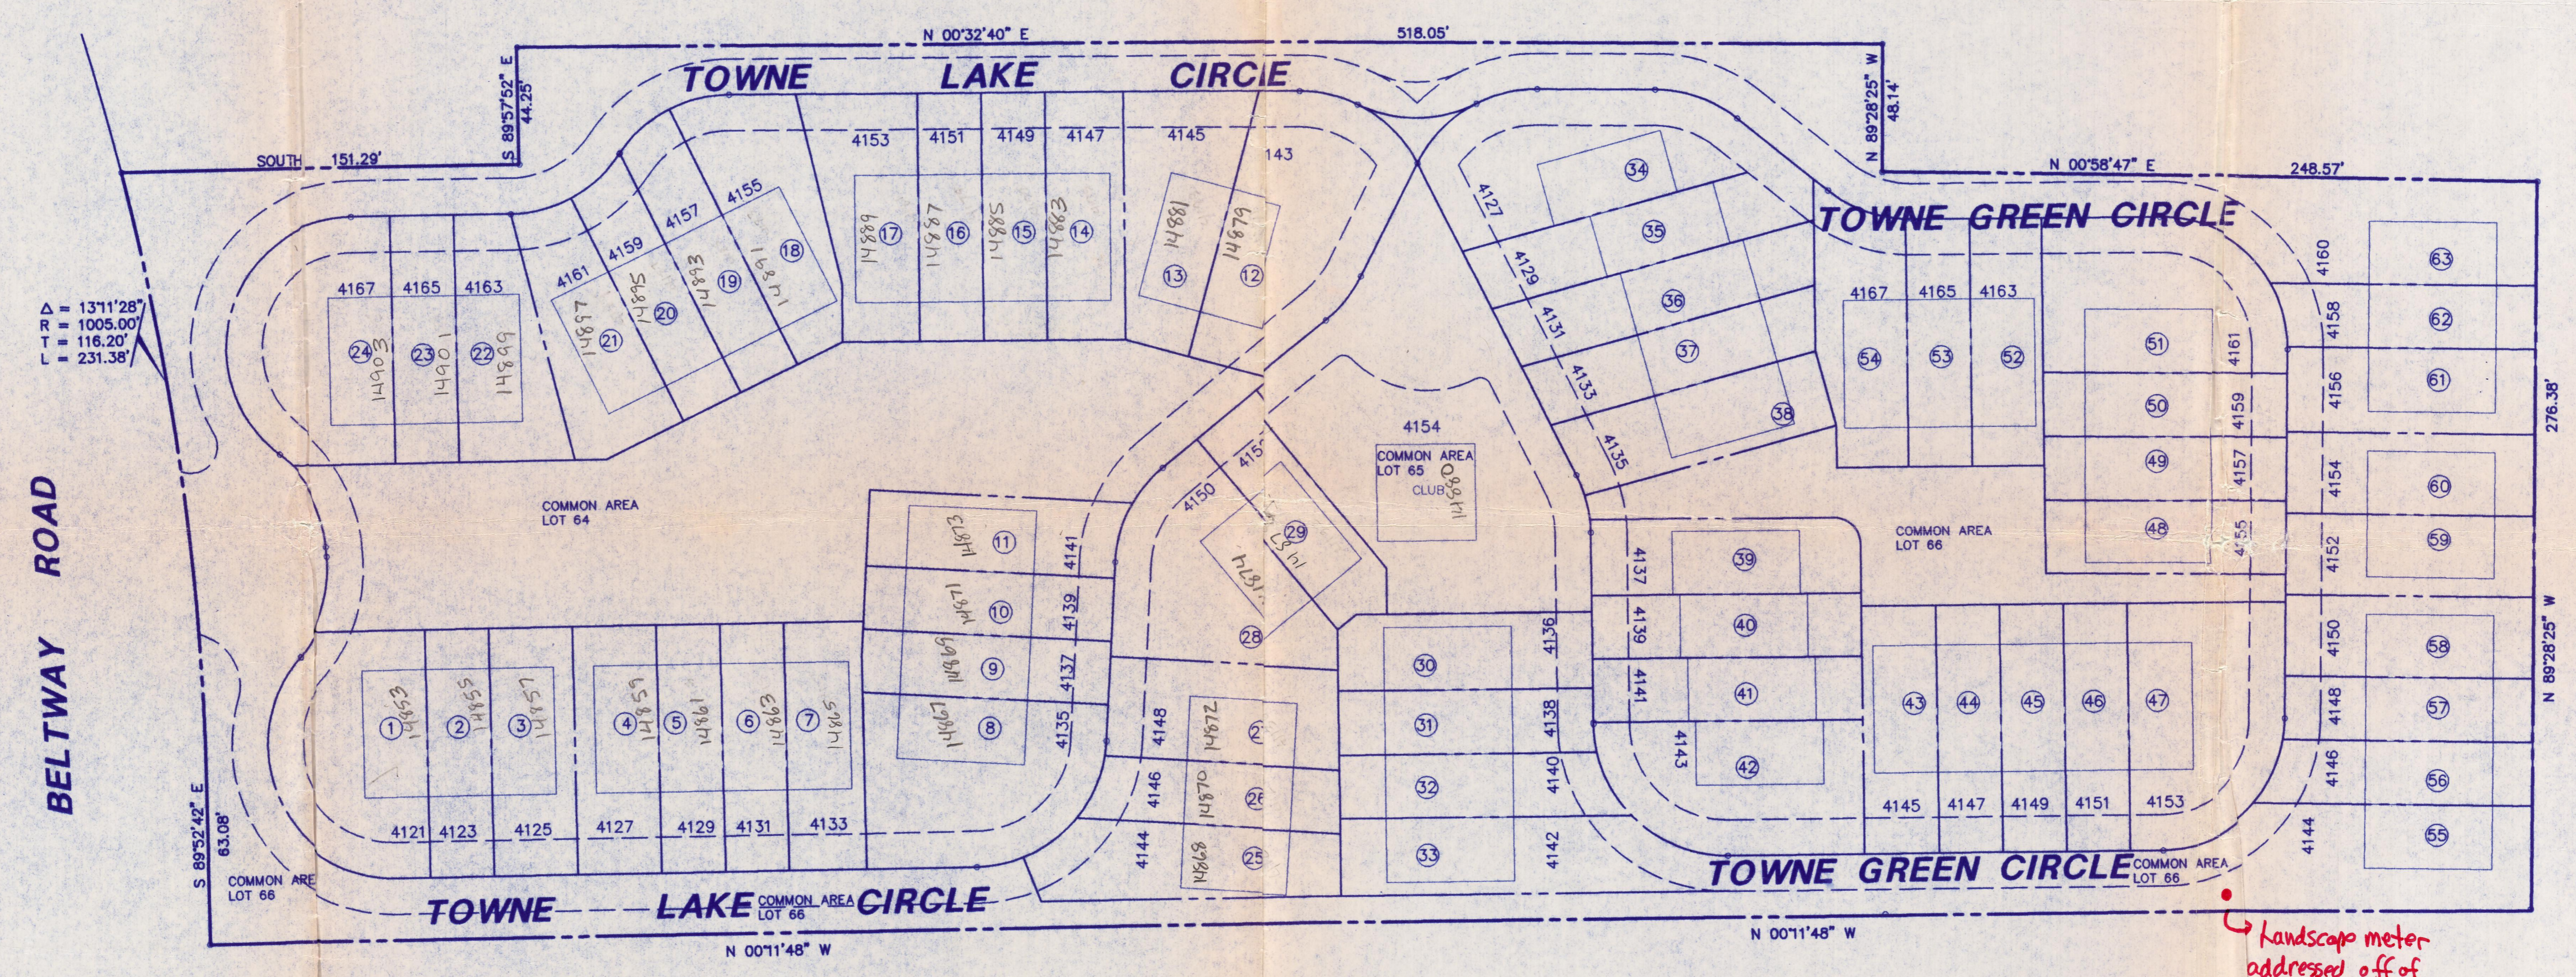

Δ = 1371'28"
R = 1005.00'
T = 116.20'
L = 231.38'

Handscap meter
addressed off of
Beltway - 4140

TOWNELAKE

EXHIBIT SHOWING
LOT ADDRESSES
OF
TOWNES OF ADDISON
LOCATED IN TOWN OF ADDISON, TEXAS
AND BEING OUT OF THE
THOMAS L. CHENOWETH SURVEY, ABSTRACT NO. 273,
DALLAS COUNTY, TEXAS

PACHECO KOCH		9401 LEI Freeway, Suite 300	
Consulting Engineers, Inc.		Dallas, Texas 75243	
Civil Engineering • Land Surveying		(214) 235-3031	
DRAWN BY	CHECKED BY	SCALE	DATE
JSN	JAK	1"=40'	AUGUST 1997
JOB NUMBER		1664-96.112	