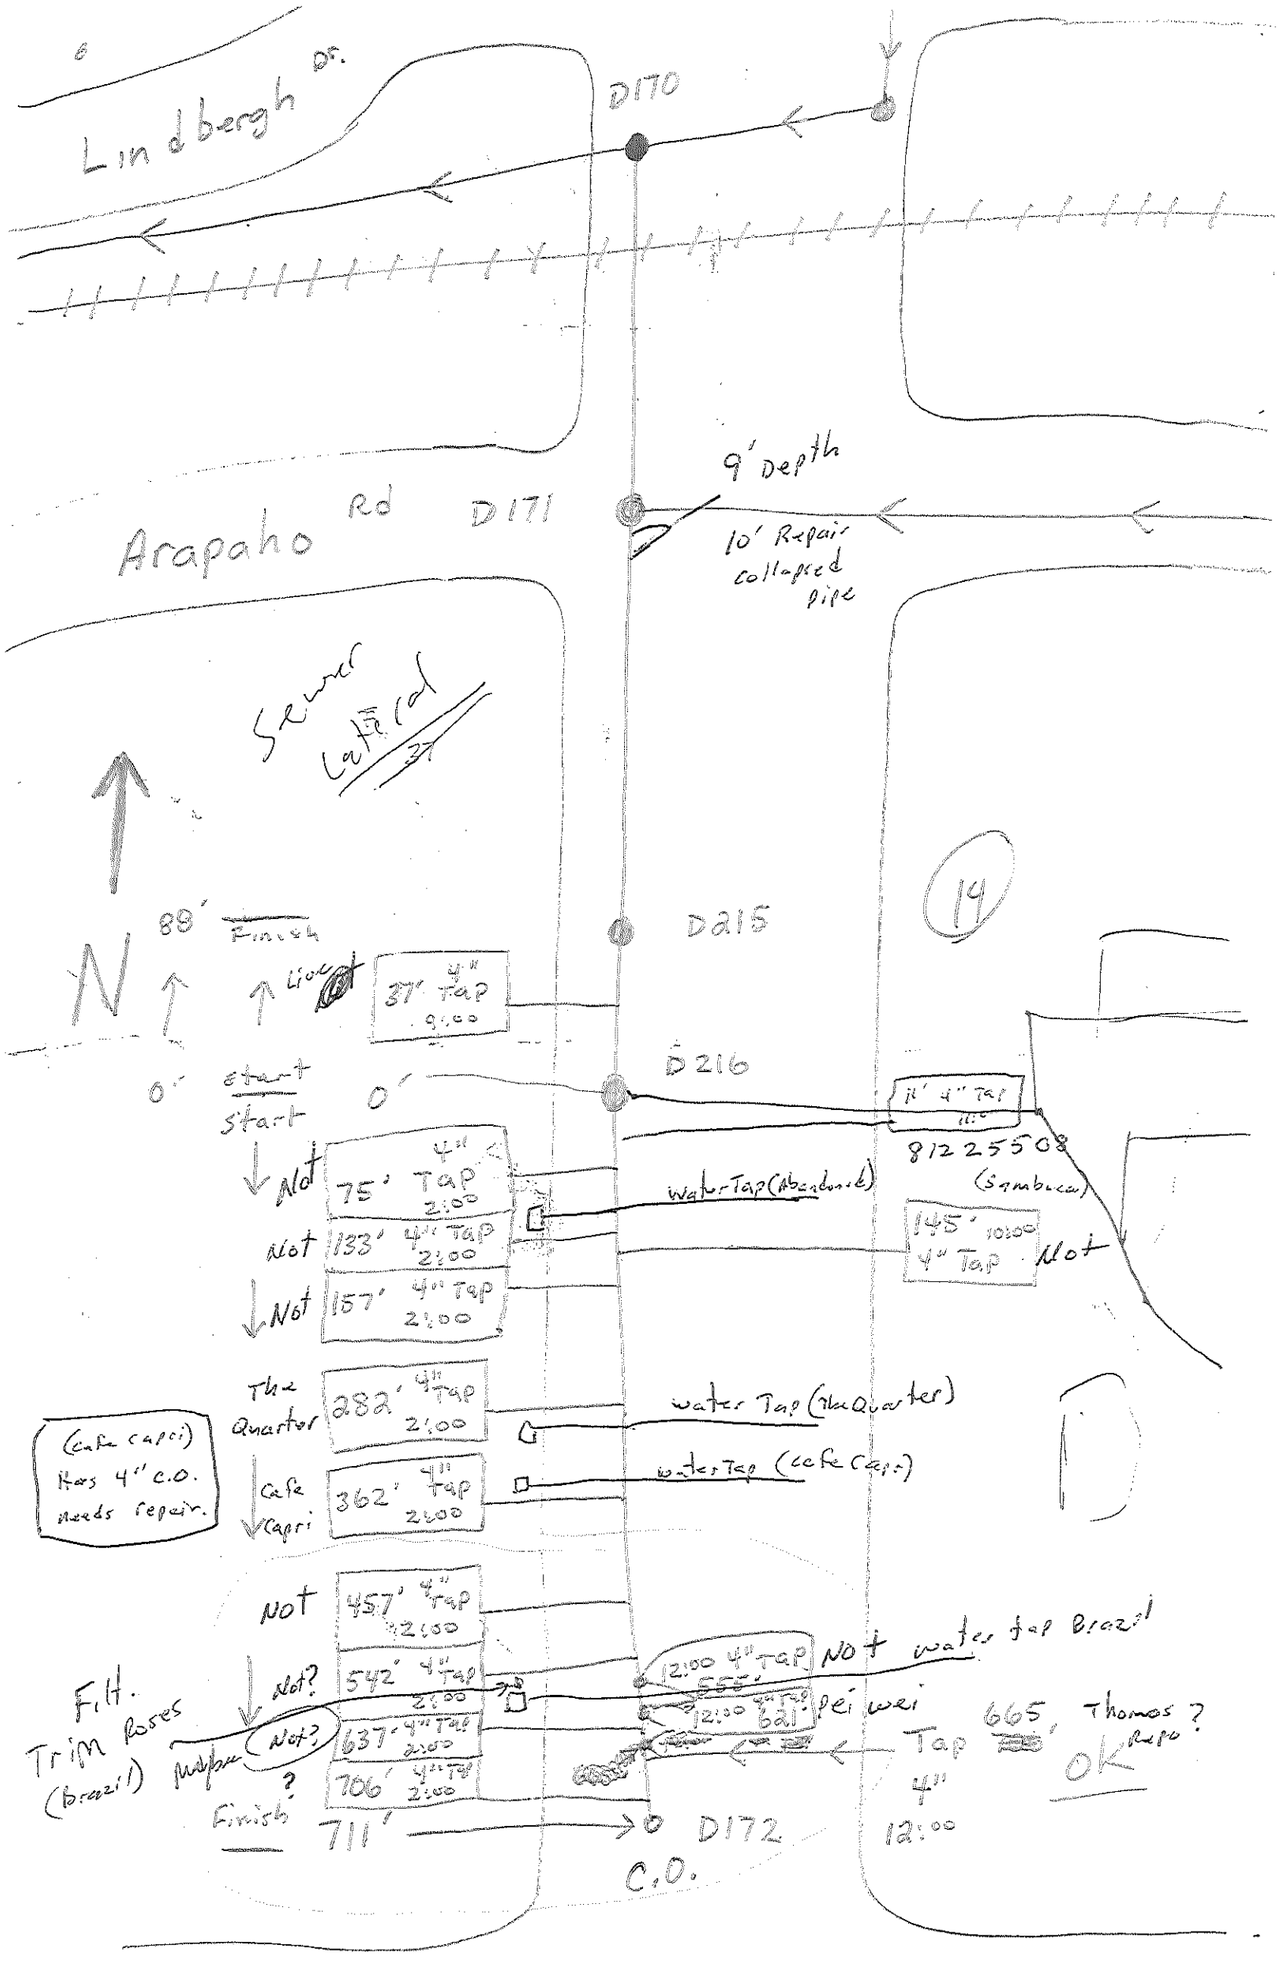

Lindbergh Dr.
D170
9' Depth
Arapaho Rd
D171
10' Repair collapsed pipe
Sewer Lateral
37
N
88' Finish
Live
37' 4" Tap 9:00
D215
14
0' start
start
0'
D216
11' 4" Tap
81225508
(Sambuca)
Not
75' 4" Tap 2:00
water Tap (Abandoned)
Not
133' 4" Tap 2:00
145' 10:00 4" Tap
Not
Not
157' 4" Tap 2:00
The Quarter
282' 4" Tap 2:00
water Tap (The Quarter)
(cafe capri) Has 4" C.O. needs repair.
Cafe Capri
362' 4" Tap 2:00
water Tap (cafe Capri)
Not
457' 4" Tap 2:00
Not?
542' 4" Tap 2:00
12:00 4" Tap 555'
Not water tap Brazil
12:00 4" Tap 621'
pei wei
Filt. Trim Roses (brazil)
Not?
637' 4" Tap 2:00
Tap 665' Thomas ?
4" 12:00
OK
Repo
706' 4" Tap 2:00
Finish
711'
D172
C.O.
BeltLine Rd.