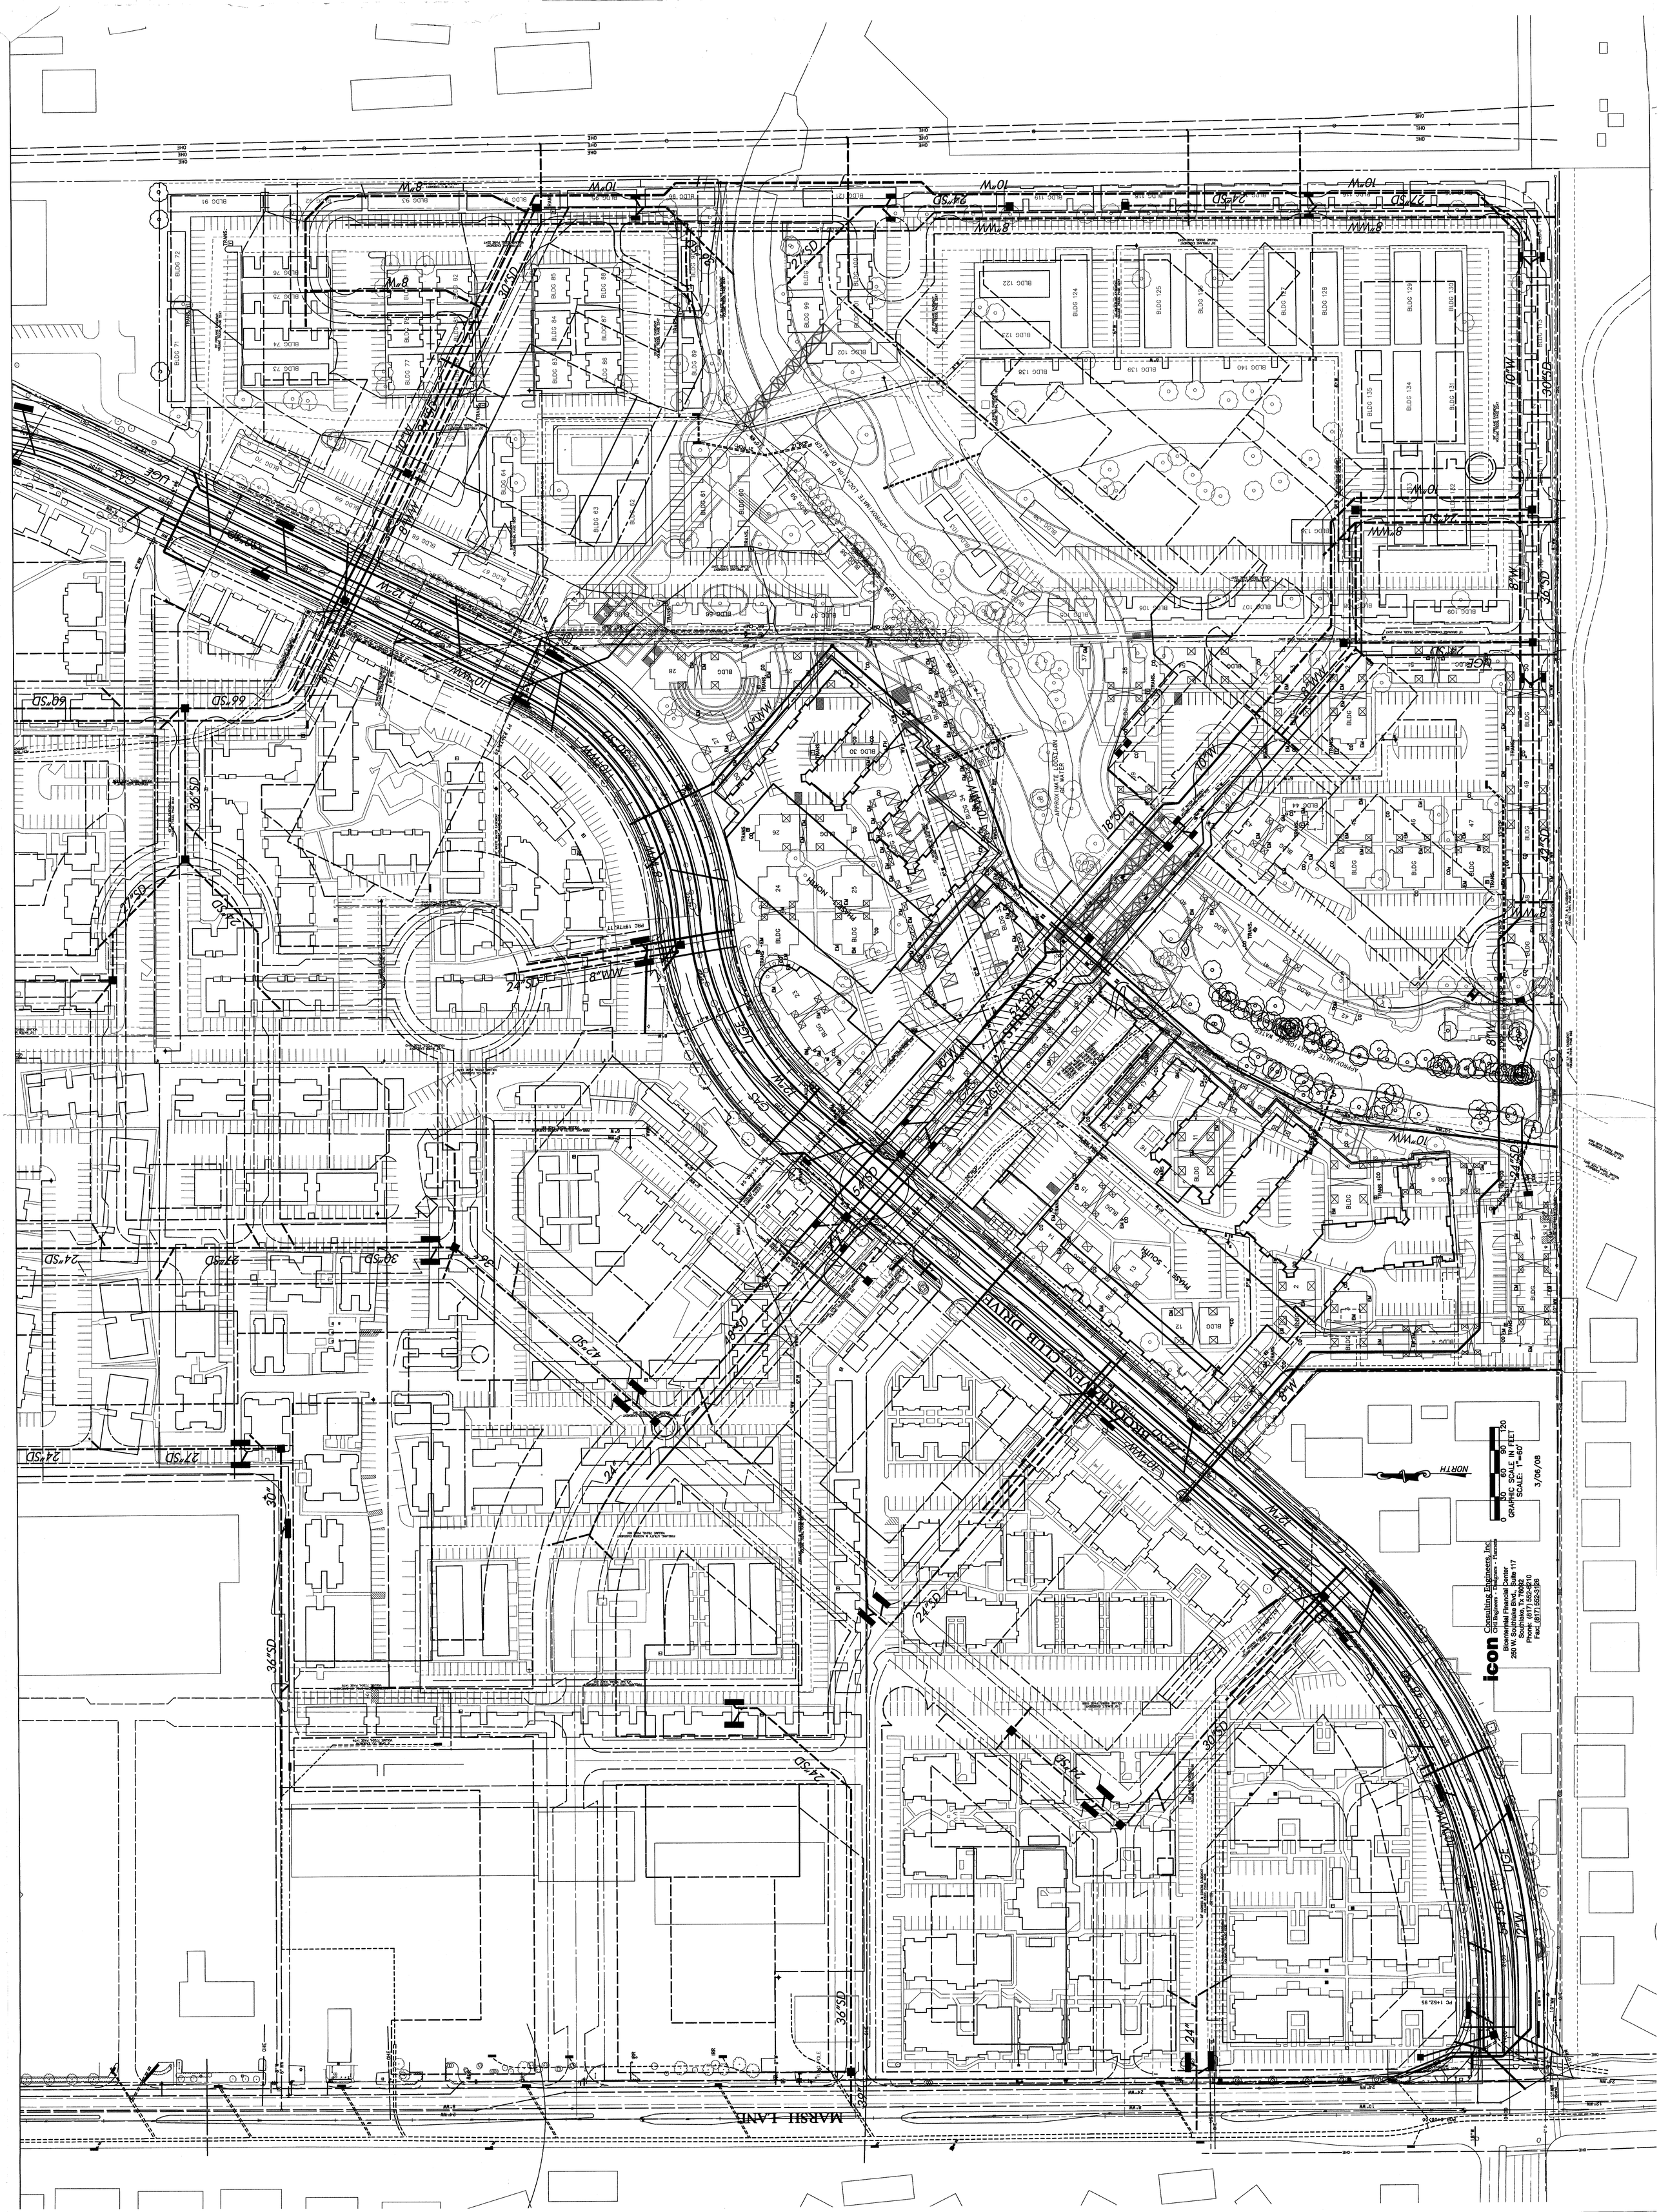
MARSH LANE
BROOKVIEW COUNTRY CLUB DRIVE
STREET B
STREET A
NORTH
GRAPHIC SCALE IN FEET
SCALE: 1"=60'
3/06/08
icon Consulting Engineers, Inc.
Civil Engineers · Designers · Planners
Riverchase Financial Center
250 W. Southlake Blvd., Suite 117
Southlake, Tx 76092
Phone: (817) 552-6210
Fax: (817) 552-3126