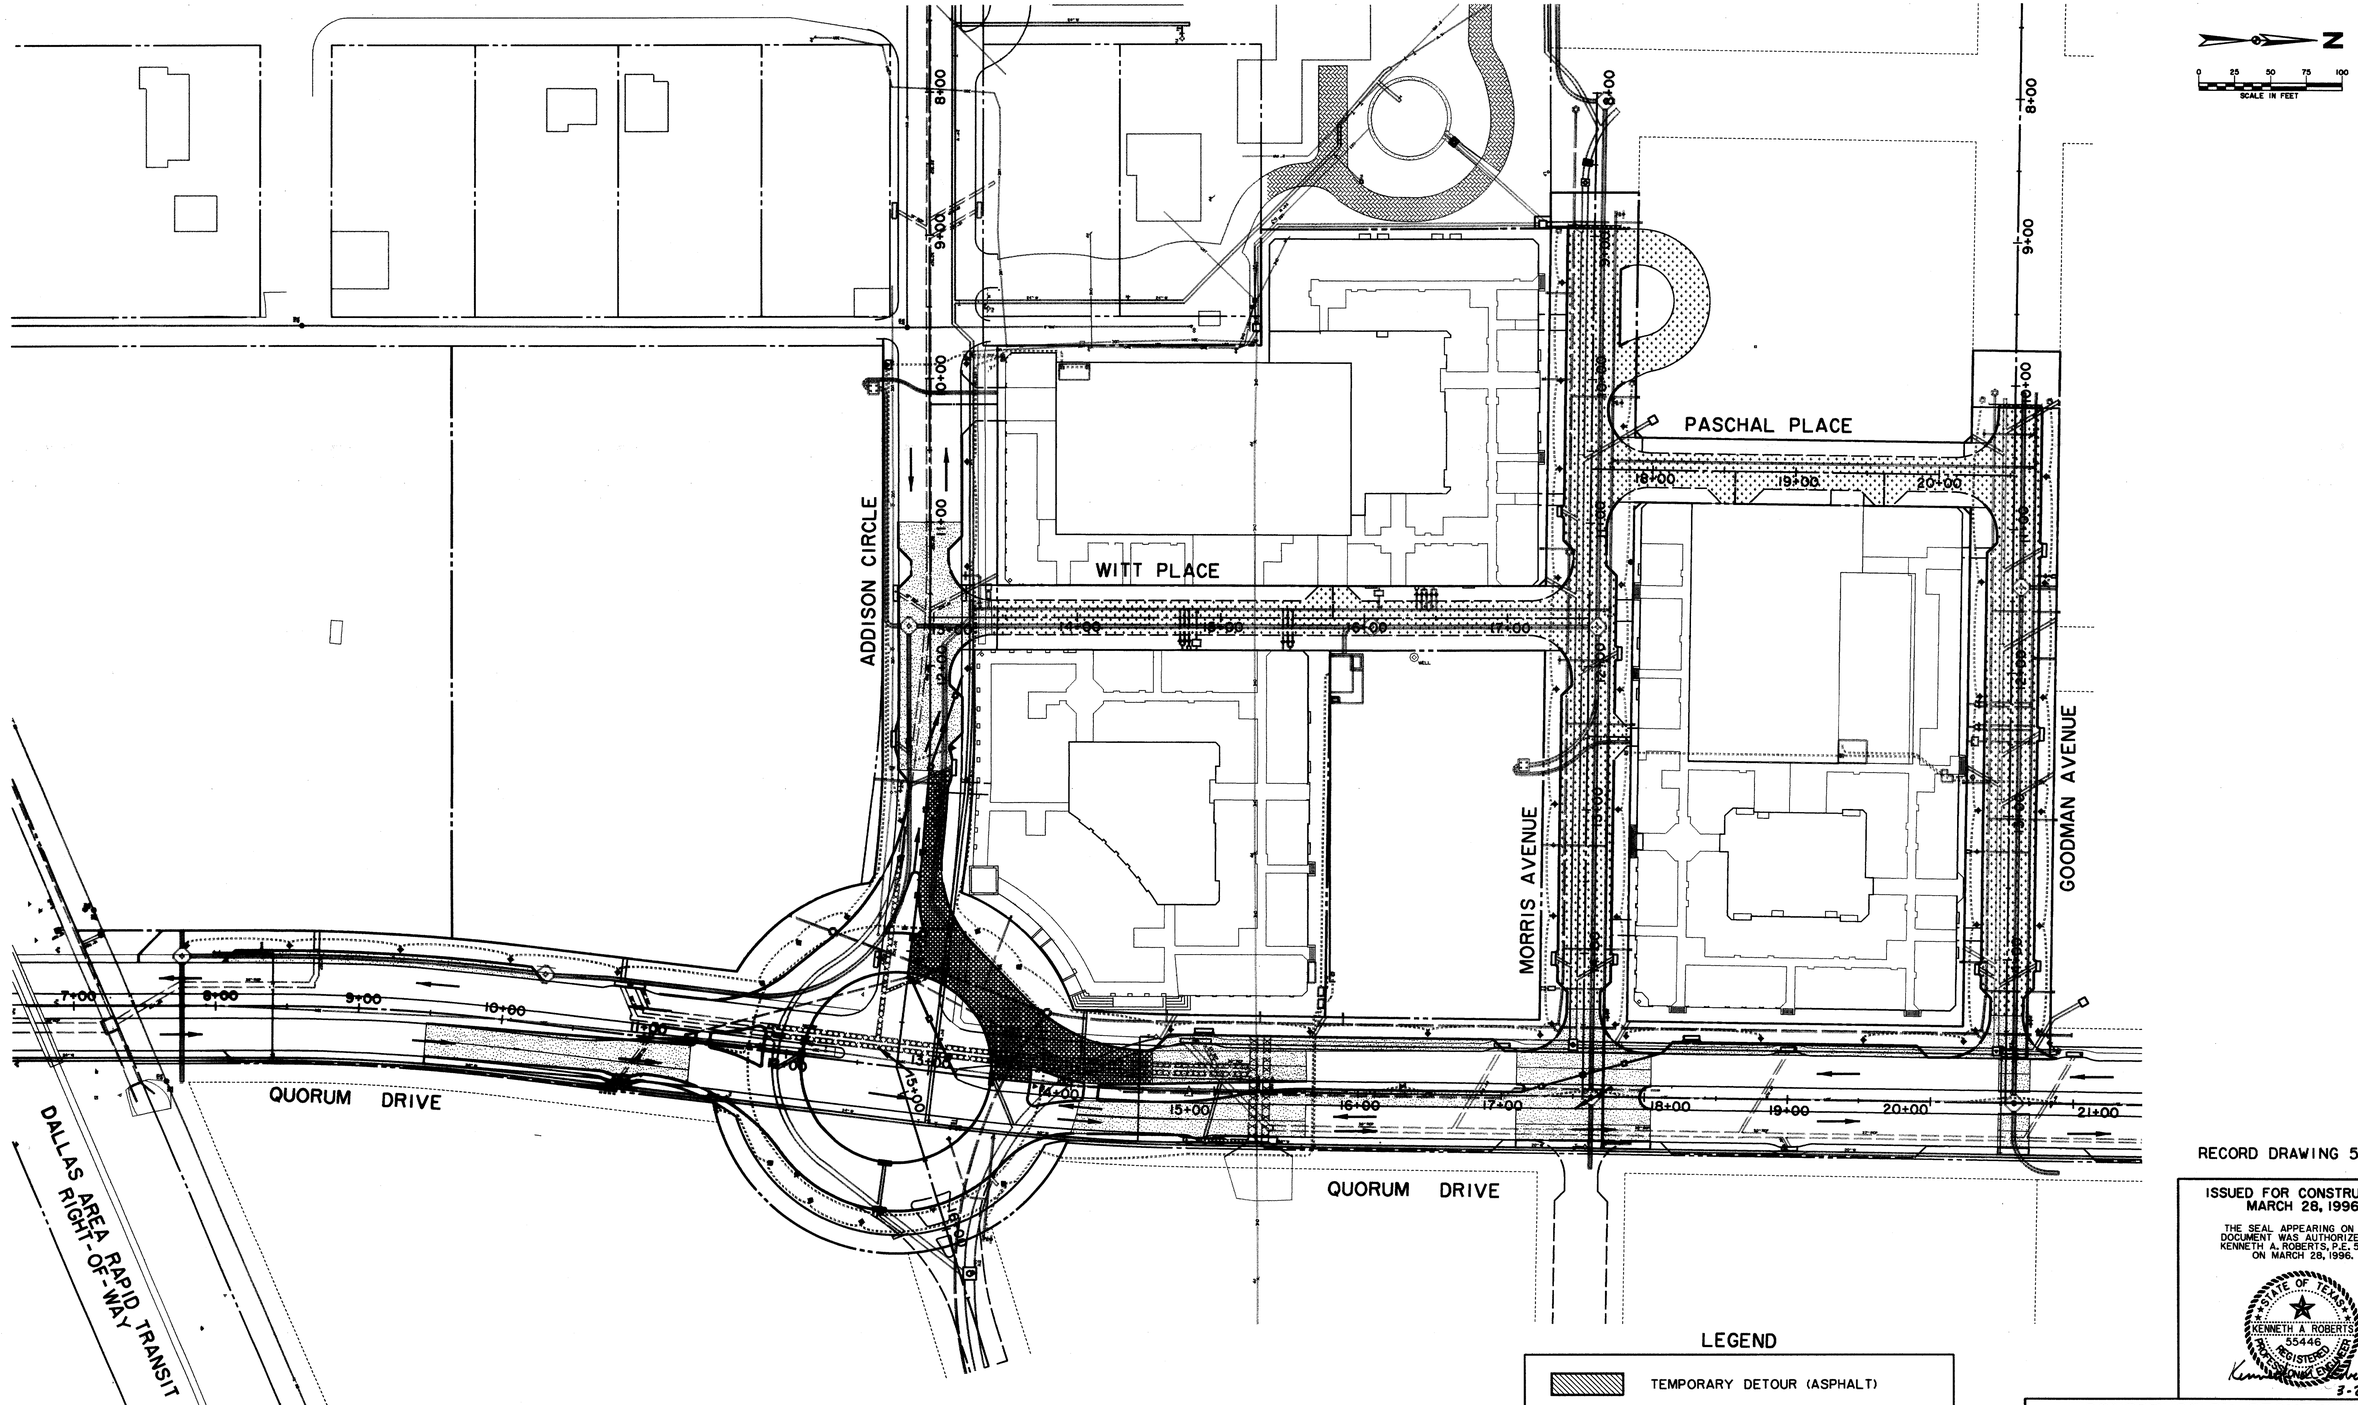

DRAINAGE & UTILITY CONSTRUCTION BETWEEN QUORUM DRIVE AND THE DALLAS NORTH TOLLWAY CAN COMMENCE UPON NOTICE TO PROCEED.

LEGEND

- TEMPORARY DETOUR (ASPHALT)
- UNDER CONSTRUCTION
- COMPLETED CONSTRUCTION
- TRAFFIC FLOW DURING CONSTRUCTION
- CONSTRUCT AT ANY TIME AFTER COMPLETION OF UTILITIES
- CHANNELIZING DEVICE

RECORD DRAWING 5/1/98

ISSUED FOR CONSTRUCTION
MARCH 28, 1996

THE SEAL APPEARING ON THIS DOCUMENT WAS AUTHORIZED BY KENNETH A. ROBERTS, P.E. 55446 ON MARCH 28, 1996.

STATE OF TEXAS · KENNETH A ROBERTS · 55446 · REGISTERED PROFESSIONAL ENGINEER

3-28-96

CONSTRUCTION SEQUENCING STAGE D

ADDISON CIRCLE

PHASE I PUBLIC INFRASTRUCTURE

TOWN OF ADDISON, TEXAS

Huitt-Zollars, Inc./Engineering/Architecture
Dallas, Fort Worth, Houston, El Paso, Phoenix, Tustin, Ontario, San Clemente

DESIGN	DRAWN	APPR.	SCALE	DATE	PROJECT NO.	NO.
HZI	HZI	KAR	1"=50'	JAN 96	1822-04	12/137

H:\PROJ\182204\DGN\AUCIPV23.DGN