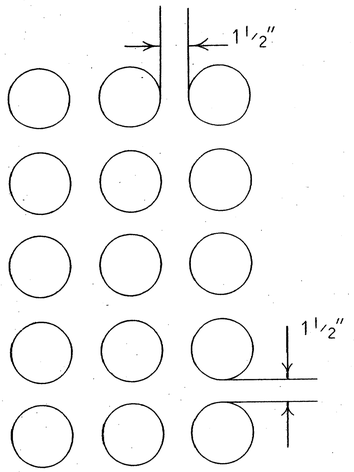

**15 - 5" OR 6"
TERMINATOR INSTALLATION
IN MANHOLES**

SEE JOB SKETCH FOR
NUMBER OF TERMINATORS
TO BE INSTALLED

DETAIL #⑧

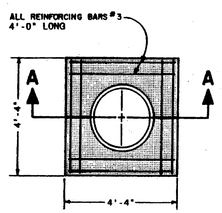

PLAN

NOTE: SEE DETAIL #⑭ FOR CONCRETE SPECIFICATION

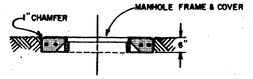

SECTION A-A

**— CONCRETE SLAB FOR MANHOLE —
CASTING**

DETAIL #⑪

DETAIL # 24

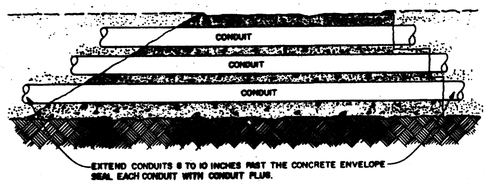

**— SLOPED AND STAIR STEPPED —
COLD JOINTS**

DETAIL # 28

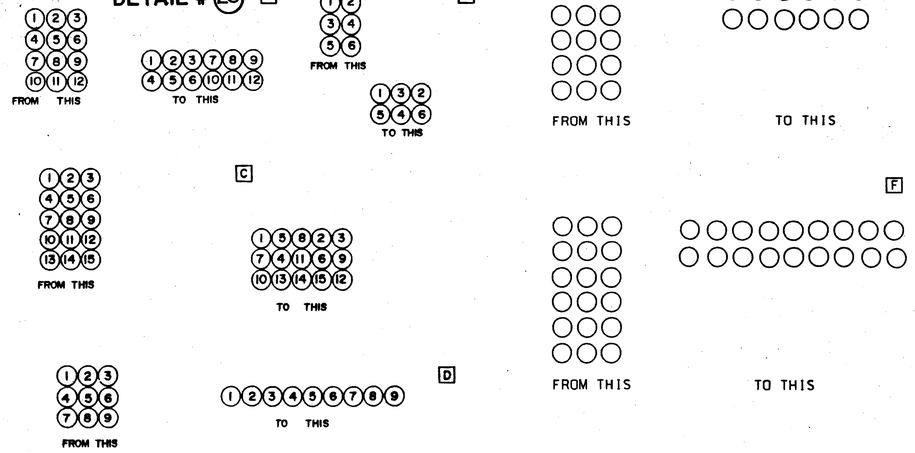

CONDUIT TRANSITION DETAILS

RECORD DRAWING 5/1/98

CD

TU ELECTRIC

DRAWN	CH.	APP.	APP.

UNIT ID

DWG TYPE

REVISION DESCRIPTION

ESTIMATE

W.A.

NO.	DATE

LIST OF DRAWINGS

SCALE (H-NO SCALE) (V-NO SCALE)

APP. PRN	APP. JES	ENG. JRC	CH. JRC	DWN. MED	DATE 05-12-92

NETWORK UNDERGROUND
APPURTENANCE SHEETS
MISCELLANEOUS DETAILS

E-NUA-1
SHEET NO. 6