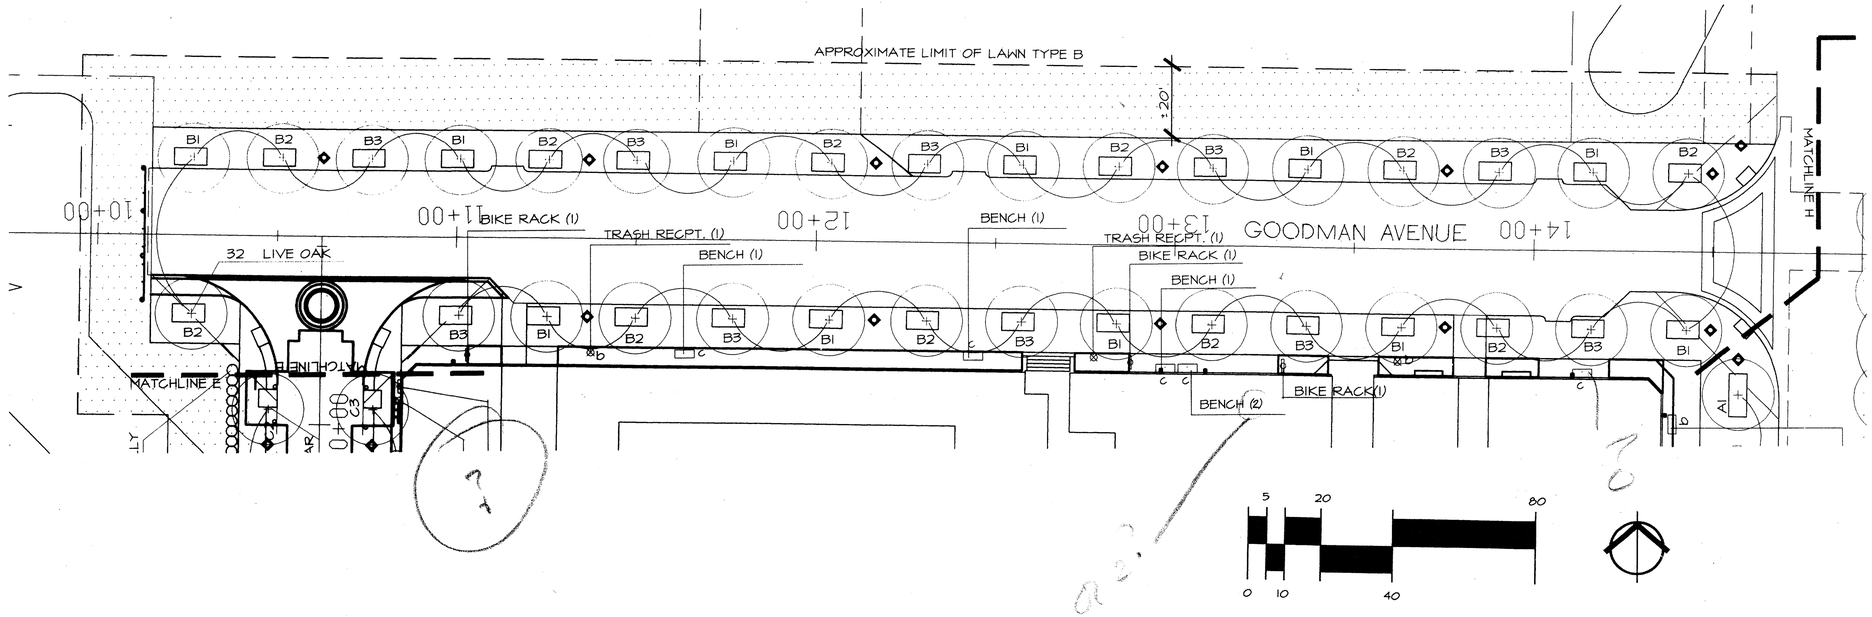

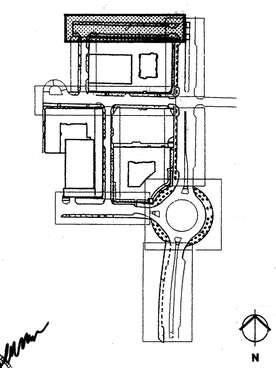

STATE OF TEXAS
PETER NEWMAN
39
REGISTERED
LANDSCAPE ARCHITECT

Newman, Jackson, Bieberstein, Inc.
Landscape Architecture — Urban and Development Planning
12710 Colt Road, Suite 210 Dallas, Texas (214) 233-2033 Fax (214) 233-2022

Planting & Furniture Plan

ADDISON CIRCLE

PHASE 1

TOWN OF ADDISON, TEXAS

Huitt-Zollars, Inc./Engineering/Architecture
Dallas, Fort Worth, Houston, El Paso, Phoenix, Tustin, Ontario, San Clemente

DESIGN	DRAWN	APPR.	SCALE	DATE	PROJECT NO.	NO.
PS	TS	GN	1" = 20'-0"	12-4-95	0030-95	125/137

RECORD DRAWING 5/1/98

Revisions:
1 1-22-96 Addendum #2

Issued for Construction
March 28, 1996