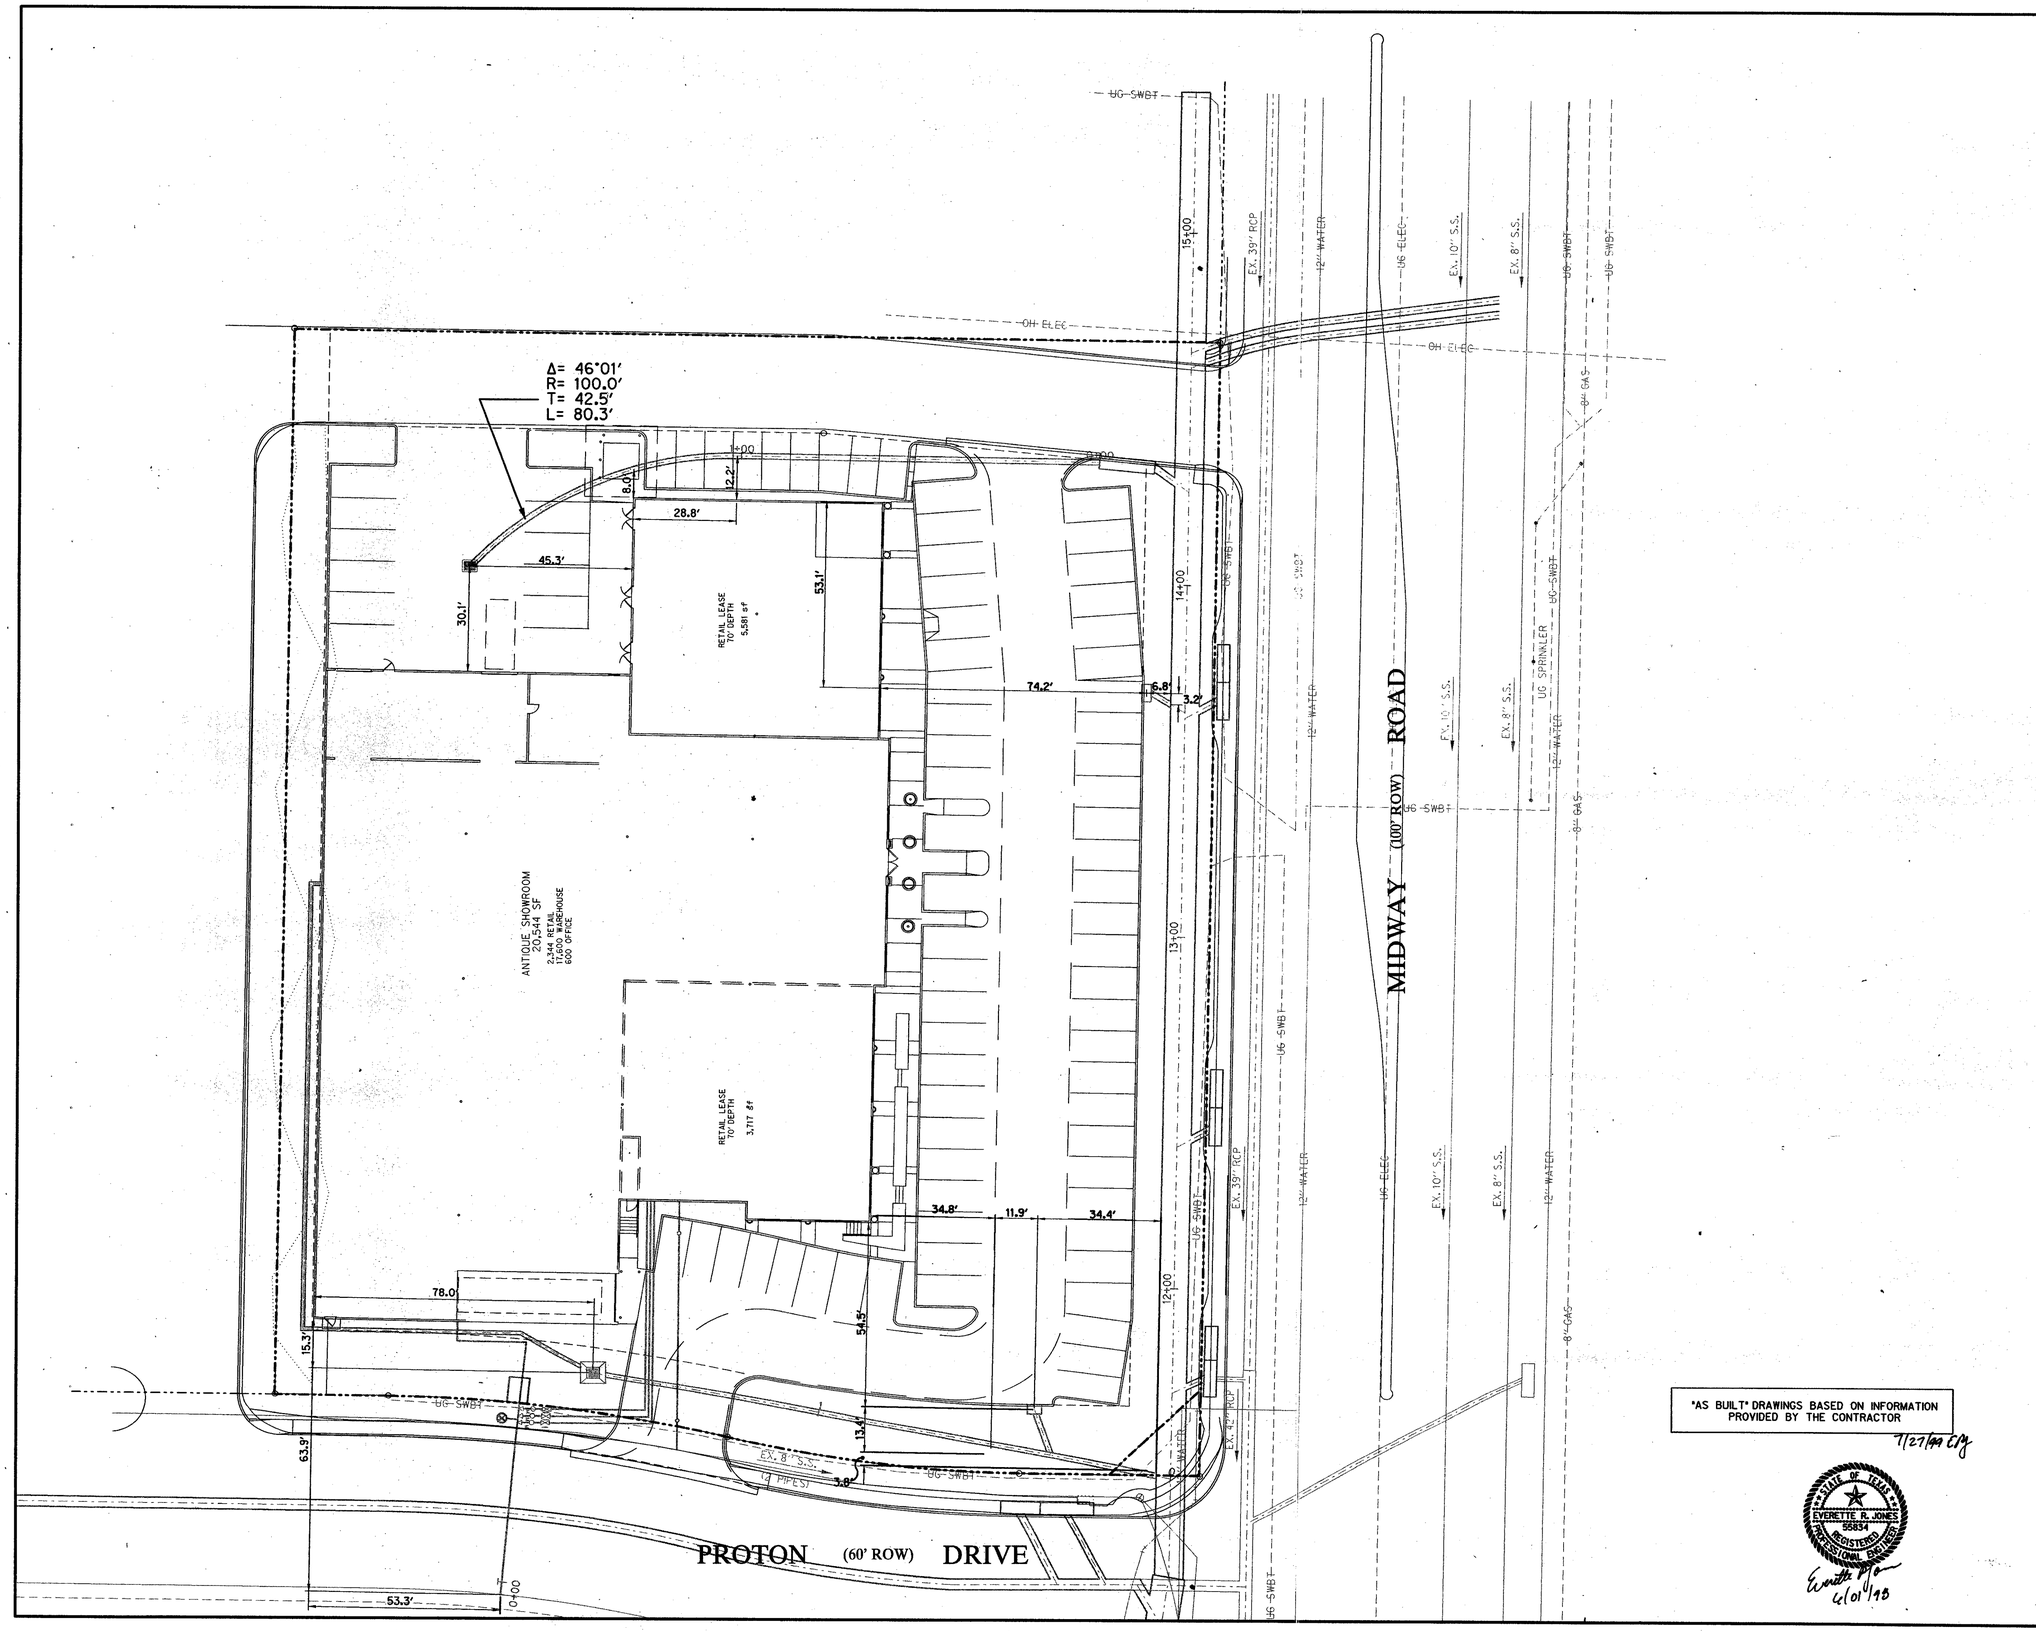

BENCH MARKS:

"□" CUT AT WEST CORNER OF CONCRETE HEADWALL OF BOX CULVERT, SOUTH SIDE OF PROTON DRIVE AND ±350' EAST OF MIDWAY ROAD AND PROTON DRIVE INTERSECTION. ELEV.=598.37

SET "□" CUT SET ON CURB INLET NORTH SIDE OF PROTON DR. ± 50' WEST OF WEST R.O.W. OF MIDWAY RD. ELEV=598.92

"AS BUILT" DRAWINGS BASED ON INFORMATION PROVIDED BY THE CONTRACTOR

7/27/99 CJG

STATE OF TEXAS
EVERETTE R. JONES
55834
REGISTERED
PROFESSIONAL ENGINEER

Everette Jones
4/01/98

UTILITY DIMENSION CONTROL PLAN

ENGLISHMAN'S ANTIQUES

PRITCHARD ASSOCIATES

ADDISON, TEXAS

Halff Associates

ENGINEERS • ARCHITECTS • SCIENTISTS • PLANNERS • SURVEYORS

DESIGN	DRAWN	DATE	SCALE	NOTES	FILE	NO.
R.M.	CADD	JULY 1998	1"= 20'	7499C01 16749		DC-1