SANITARY SEWER

MANHOLE OR CLEANOUT NUMBER | Northing (ft) | Easting (ft) 7034102.16 2477007.50 10 7034037.03 2477012.16 12 7033743.41 2477011.16 14 7033716.04 2477011.16 16 18 7033532.52 2477011.16 7033377.50 2477011.16 20 7033373.53 2476961.66 22 7033372.50 2476748.15 24 7033649.53 2476748.16 26 7033699.53 2476748.16 28 7033743.41 2476748.16 30 7033743.41 2476907.66 32 7033649.53 2476907.66 34 7033679.03 2476907.67 36 7033609.53 2476907.66 38 7033768.53 2476748.16 40 7033863.03 2476748.16 42 7033768.53 2476907.66 43 7033816.78 2476907.66 44 7033889.03 2476907.66 46 7033889.03 2476947.66 48 7033889.03 2476877.66 49 50 7033816.78 2476851.66 7034037.03 2476961.66 52 7034037.03 2476874.66 54 7033710.04 2477288.16 56 7033710.04 2477370.68 58 7033710.04 2477488.68 60 7033710.04 2477556.49 62 7033693.00 2477602.04 64 7033690.54 2477488.68 66 7033372.58 2477488.68 68 7033372.83 2477311.43 70 72 7033372.51 2477536.02 7033532.54 2477288.16 74 7033532.54 2477238.66 76 7033532.54 2477188.66 78 7033536.54 2477163.66 7033372.50 2477188.66 80 7033372.50 2477230.66 82 7033690.54 2477370.68 84 7033541.55 2477370.68 86

7033541.55 2477323.66

7033532.52 2477030.66

7033532.52 2477080.66 7033526.54 2477102.66

7033374.50 2477080.66

7033374.50 2477038.1

7033525.54 2477129.16

7033346.62 2477129.16

88

90

93

94

96

97

99

STORM SEV	WER		STORM SEV					
	R MANHOLES		STORM SEWER MANHOLES					
ND INLETS			AND INLETS					
NUMBER	Northing (ft)	Easting (ft)	NUMBER	Northing (ft)	Easting (ft)			
Ex. 1	7033589.72	2477713.22	200	7033366.50	2477182.08			
Ex. 2	7033601.12	2477658.49	202	7033366.47	2477232.09			
Ex. 3	7033566.24	2477661.28	204	7033369.92	2477279.58			
Ex. 5	7034067.49	2477594.11	205	7033489.75	2477279.66			
			206	7033538.48	2477279.69			
100	7033366.77	2476756.08	207	7033668.22	2477279.78			
102	7033366.71	2476851.57	208	7033717.98	2477279.81			
104	7033367.09	2476958.08	210	7033717.92	2477364.33			
106	7033370.09	2477002.58	212	7033717.84	2477482.33			
107	7033466.92	2477002.65	214	7033717.80	2477548.17			
108	7033538.63	2477002.69	216	7033734.76	2477579.18			
110	7033723.65	2477002.81	218	7033984.93	2477579.34			
111	7033839.86	2477002.89	219	7034045.83	2477579.38			
112	7033895.14	2477002.92	220	7034079.32	2477579.40			
114	7033972.71	2477002.92	222	7034079.40	2477392.54			
116	7034031.14	2477003.01	224	7033366.37	2477375.08			
118	7034079.65	2477003.04	226	7033366.42	2477330.09			
120	7034105.33	2476996.06	228	7033447.41	2477419.37			
122	7033417.60	2477086.11	230	7033479.06	2477306.78			
124	7033366.56	2477084.08	232	7033538.54	2477182.19			
126	7033366.80	2477033.08	234	7033538.50	2477235.19			
128	7033462.96	2476950.79	236	7033635.74	2477067.98			
130	7033469.60	2477086.15	238	7033675.18	2477194.18			
134	7033538.58	2477086.19	240	7033547.45	2477332.20			
136	7033538.61	2477033.19	242	7033547.43	2477364.22			
138	7033597.70	2477134.23	244	7033646.42	2477364.28			
142	7033723.64	2477020.81	246	7033687.42				
144	7033431.83	2476710.27	248	7033366.34	2477428.60			
146	7033433.81	2476741.61	250	7033366.30				
148	7033643.81	2476741.76	252	7033505.19				
150	7033696.81	2476741.79	254	7033666.34				
152	7033723.82	2476741.81	256	7033366.29				
153	7033723.78		258	7033663.75				
154	7033727.44		298	7034016.35				
156	7033685.71	2476901.29	300	7033970.68				
158	7033643.71	2476901.26	302	7033970.65				
160	7033612.21	2476901.24	304	7033836.88				
162	7033823.81	2476741.88	306	7033836.85				
164	7033779.82		308	7033595.77	2477016.73			
166	7033822.71	2476901.38	310	7033462.94				
168	7033895.21	2476901.43	312	7033462.91	2477016.64			
170	7033895.17	2476958.42	314	7033738.13				
172	7033893.17		316	7033738.13				
174	7034031.20		318	7033712.13				
1/7	/ / / / / / / / / / / / / / / / / / / /	2-7/0/3/0.31		7033733.27	2476802.83			
			320	7033713.27				
			322					
			324	7033721.35				
			350	7033481.76				
			352	7033485.74				
			354	7033664.23	2477251.77			

SANITARY SEWER LEADS

Block /	4							Block	В
	base	Elevation	Length		Elevation	Pavement			
Lot#	elevation	at trunk line	of Lead	Slope	at lot line	Elevation	Cover	Lot#	e
1	606.35	606.52	6	10.00%	607.12	614.20	7.08	1	
2	606.33	606.50	6	10.00%	607.10	614.20	7.10	2	\top
3	606.17	606.34	6	10.00%	606.94	614.20	7.26	3	
4	606.15	606.32	6	10.00%	606.92	614.20	7.28	4	
5	606.10	606.27	18	10.00%	608.07	614.20	6.13	5	
6	606.12	606.29	18	10.00%	608.09	614.20	6.11	6	
7	606.31	606.48	18	10.00%	608.28	614.20	5.92	7	\top
8	606.33	606.50	18	10.00%	608.30	614.20	5.90	8	
9	607.36	607.53	18	10.00%	609.33	616.80	7.47	9	T
10	607.33	607.50	18	10.00%	609.30	616.80	7.50	10	\top
11	607.16	607.33	18	10.00%	609.13	616.80	7.67	11	\top
12	607.18	607.35	18	10.00%	609.15	616.80	7.65	12	\top
13	606.82	606.99	6	10.00%	607.59	616.80	9.21	13	\top
14	606.79	606.96	6	10.00%	607.56	616.80	9.24	14	\top
15	608.63	608.80	6	10.00%	609.40	616.80	7.40	15	\top
16	606.50	606.67	6	10.00%	607.27	616.80	9.53	16	\top
17	606.36	606.53	6	10.00%	607.13	616.80	9.67	17	\top
18	606.36	606.53	18	10.00%	608.33	616.80	8.47	18	\top
19	608.88	609.05	6	10.00%	609.65	616.80	7.15	19	\top
20	608.88	609.05	4	10.00%	609.45	616.80	7.35	20	\top
21	606.77	606.94	19	10.00%	608.84	616.80	7.96	21	+
22	606.79	606.96	18	10.00%	608.76	616.80	8.04	22	\top
23	606.36	606.53	6	10.00%	607.13	615.00	7.87	23	\top
24	606.33	606.50	6	10.00%	607.10	615.00	7.90	24	\top
25	606.19	606.36	6	10.00%	606.96	615.00	8.04	25	+
26	606.17	606.34	6	10.00%	606.94	615.00	8.06	26	+
27	605.99	606.16	6	10.00%	606.76	615.00	8.24	27	+
28	606.05	606.22	18	10.00%	608.02	615.00	6.98	28	+
29	606.07	606.24	18	10.00%	608.04	615.00	6.96	29	+
30	606.18	606.35	18	10.00%	608.15	615.00	6.85	30	+
31	606.22	606.39	18	10.00%	608.19	615.00	6.81	31	+
	1	1							$\overline{}$

18 10.00%

18 10.00%

606.50

606.53

615.00 6.70

615.00 6.67

608.30

608.33

SANITARY SEWER LEADS

32 606.33

7033664.21 2477293.77

7034041.79 2477560.38

7034041.78 2477586.38

7033660.01 2477552.13

7033659.98 2477594.13

356 358

360

362

33 606.36

Block (0						
	base	Elevation	Length		Elevation	Pavement	
Lot#	elevation	at trunk line	of Lead	Slope	at lot line	Elevation	Cove
1	606.36	606.53	18	10.00%	608.33	616.50	8.17
2	606.63	606.80	16	10.00%	608.40	616.50	8.10
3	606.63	606.80	18	10.00%	608.60	616.50	7.90
4	606.66	606.83	27	10.00%	609.53	616.50	6.97
5	614.75	614.92	14	10.00%	616.32	622.72	6.40
6	614.75	614.92	16	10.00%	616.52	622.72	6.20
7	614.47	614.64	18	10.00%	616.44	622.70	6.26
8	614.45	614.62	18	10.00%	616.42	622.56	6.14
9	614.77	614.94	6	10.00%	615.54	622.95	7.41
10	614.80	614.97	6	10.00%	615.57	622.95	7.38
11	614.96	615.13	6	10.00%	615.73	623.39	7.66
12	614.98	615.15	6	10.00%	615.75	623.39	7.64
13	615.17	615.34	6	10.00%	615.94	623.87	7.93
14	615.19	615.36	6	10.00%	615.96	623.87	7.91
15	615.62	615.79	18	10.00%	617.59	624.40	6.81
16	615.47	615.64	18	10.00%	617.44	624.40	6.96
17	615.44	615.61	18	10.00%	617.41	624.40	6.99
18	613.33	613.50	21	10.00%	615.60	624.40	8.80
19	611.20	611.37	21	10.00%	613.47	624.00	10.53
20	611.24	611.41	21	10.00%	613.51	622.09	8.58
21	613.12	613.29	21	10.00%	615.39	622.06	6.67
22	613.12	613.29	9	10.00%	614.19	622.06	7.87
23	611.24	611.41	9	10.00%	612.31	622.09	9.78
24	611.20	611.37	9	10.00%	612.27	622.09	9.82
25	613.33	613.50	9	10.00%	614.40	622.06	7.66
26	607.43	607.60	18	10.00%	609.40	616.50	7.10
27	607.46	607.63	20	10.00%	609.63	616.50	6.87
28	607.59	607.76	20	10.00%	609.76	616.50	6.74
29	607.18	607.35	6	10.00%	607.95	616.50	8.55
30	607.16	607.33	6	10.00%	607.93	616.50	8.57
31	606.97	607.14	6	10.00%	607.74	616.50	8.76
32	606.95	607.12	6	10.00%	607.72	616.50	8.78
33	606.79	606.96		10.00%	607.56	616.50	8.94
34	606.77	606.94		10.00%	607.54	616.50	8.96

SANITARY SEWER LEADS

1										_	
		base	Elevation	Lenath		Elevation	Pavement			base	 Elevatior
1	Lot#		1		Slope			Cover	Lot#		at trunk lir
2	1										612.7
3	2		-						2		612.8
4 605.21 605.38 18 10.00% 607.2 614.20 7.00 4 612.52 612.00 605.37 605.54 18 10.00% 607.2 614.20 6.99 5 613.03 613.03 


























		<u> </u>	1	1				-			

SANITARY SEWER LEADS


Block D

nt				base	Elevation	Length		Elevation	Pavement	
n	Cover		Lot#	elevation	at trunk line	of Lead	Slope	at lot line	Elevation	Cover
.20	7.80		1	612.61	612.78	18	10.00%	614.58	621.80	7.22
.20	7.64		2	612.63	612.80	18	10.00%	614.60	621.80	7.20
.20	6.10		3	612.80	612.97	18	10.00%	614.77	621.97	7.20
.20	7.02		4	612.82	612.99	18	10.00%	614.79	621.97	7.18
.20	6.99		5	613.03	613.20	18	10.00%	615.00	622.15	7.15
.20	6.86		6	612.65	612.82	6	10.00%	613.42	621.80	8.38
.20	6.84		7	612.77	612.94	6	10.00%	613.54	621.97	8.43
.20	6.70		8	612.99	613.16	6	10.00%	613.76	622.15	8.39
.80	9.28		9	613.27	613.44	6	10.00%	614.04	622.40	8.36
.80	9.13		10	613.27	613.44	6	10.00%	614.04	622.40	8.36
.80	9.11		11	613.43	613.60	6	10.00%	614.20	622.40	8.20
.80	9.02		12	613.44	613.61	6	10.00%	614.21	622.40	8.19
.80	8.99		13	611.56	611.73	18	10.00%	613.53	622.51	8.98
.80	8.83		14	611.92	612.09	18	10.00%	613.89	623.19	9.30
.50	6.52		15	611.98	612.15	18	10.00%	613.95	623.19	9.24
.50	6.69		16	612.36	612.53	18	10.00%	614.33	623.80	9.47
.50	6.81		17	612.41	612.58	18	10.00%	614.38	623.80	9.42
.50	6.91		18	612.74	612.91	18	10.00%	614.71	624.28	9.57
.50	7.05	l	19	612.95	613.12	18	10.00%	614.92	624.57	9.65
.50	7.07	l	20	613.24	613.41	18	10.00%	615.21	624.96	9.75
.50	7.15	l	21 22	613.59	613.76	18 18	10.00%	615.56	625.49	9.93
.50	7.17	l	23	613.64 614.03	613.81 614.20	18	10.00%	615.61 616.00	625.49 626.10	9.88
.50	7.35	l	24	614.08	614.25	18	10.00%	616.05	626.10	10.10
.50	7.37	l	25	614.49	614.66	18	10.00%	616.46	626.74	10.03
.50	8.77	ł	26	615.17	615.34	6	10.00%	615.94	626.20	10.26
.50	8.75	\cdot	27	615.48	615.65	6	10.00%	616.25	625.12	8.87
.50 .50	8.56 8.54	ł	28	615.50	615.67	6	10.00%	616.27	625.12	8.85
.50	8.26	\mathbf{I}	29	615.68	615.85	19	10.00%	617.75	624.81	7.06
.50	8.24	ł	30	615.53	615.70	19	10.00%	617.60	625.04	7.44
.50	8.11	ł	31	615.50	615.67	19	10.00%	617.57	625.04	7.47
.50	8.02	ł	32	615.33	615.50	19	10.00%	617.40	625.70	8.30
.50	8.00	ł	33	615.31	615.48	19	10.00%	617.38	625.70	8.32
.00	9.22	ł	34	615.10	615.27	19	10.00%	617.17	626.45	9.28
.91	9.15	ł	35	615.08	615.25	19	10.00%	617.15	626.45	9.30
.83	9.25	l	36	619.00	619.17	19	10.00%	621.07	627.13	6.06
.75	9.26	l	37	619.04	619.21	19	10.00%	621.11	627.13	6.02
.67	9.20	l	38	619.21	619.38	19	10.00%	621.28	627.60	6.32
.57	9.27	1	39	614.39	614.56	6	10.00%	615.16	626.52	11.36
.39	9.12	1	40	614.33	614.50	6	10.00%	615.10	626.52	11.42
.46	7.15	1	41	614.03	614.20	6	10.00%	614.80	626.02	11.22
.54	7.21	1	42	613.97	614.14	6	10.00%	614.74	626.02	11.28
.61	7.16	1	43	613.68	613.85	6	10.00%	614.45	625.55	11.10
.70	7.10	1	44	613.64	613.81	6	10.00%	614.41	625.55	11.14
.00	7.38	1	45	613.35	613.52	6	10.00%	614.12	625.09	10.97
.00	7.12	1	46	613.30	613.47	6	10.00%	614.07	625.09	11.02
.00	7.12		47	612.95	613.12	6	10.00%	613.72	624.57	10.85
.00	7.26	1	48	612.74	612.91	6	10.00%	613.51	624.25	10.74
.26	7.52		49	612.68	612.85	6	10.00%	613.45	624.25	10.80
.79	7.96		50	612.41	612.58	6	10.00%	613.18	623.78	10.60
.67	8.26		51	612.36	612.53	6	10.00%	613.13	623.78	10.65
.62	8.23		52	612.07	612.24		10.00%	612.84	623.32	10.48
.57	8.30		53	612.02	612.19	6	10.00%	612.79	623.32	10.53
.52	8.27		54	611.56	611.73	6	10.00%	612.33	622.65	10.32
.47	8.34									
.42	8.31									
.08	9.88					Γ		CALL NOTIFICA		
							\bigcirc \wedge \downarrow		VOLLDIO	

ONE-CALL NOTIFICATION SYSTEM
CALL BEFORE YOU DIG

1-800-545-6005
OR OTHER UTILITY LOCATING SERVICES AT
LEAST 48 HOURS PRIOR TO
CONSTRUCTION ACTIVITIES.



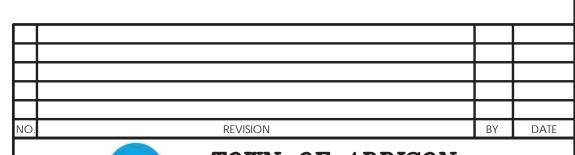

TOWN OF ADDISON
DALLAS COUNTY, TEXAS

IMPROVEMENT PLANS ADDISON GROVE

PRIVATE UTILITY COORDINATES

SAWYER ENGINEERING, LLC
TBPE: F-9171

ENGINEERING, LLC
(832) 553-5948

PROJECT	DESIGN	DRAWN	DATE	FILE	SHEET
	CDP	JDS	MAY 2017		54