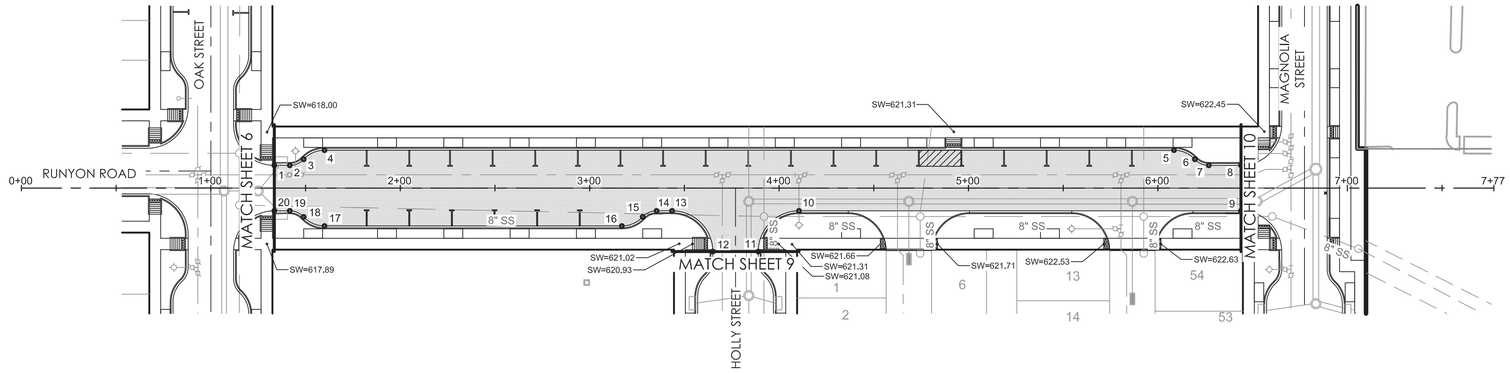

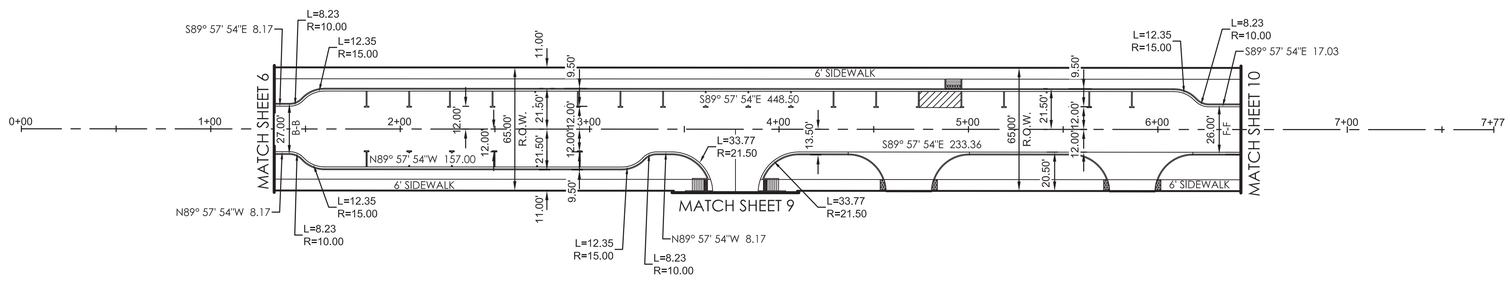

RUNYON ROAD (EAST)

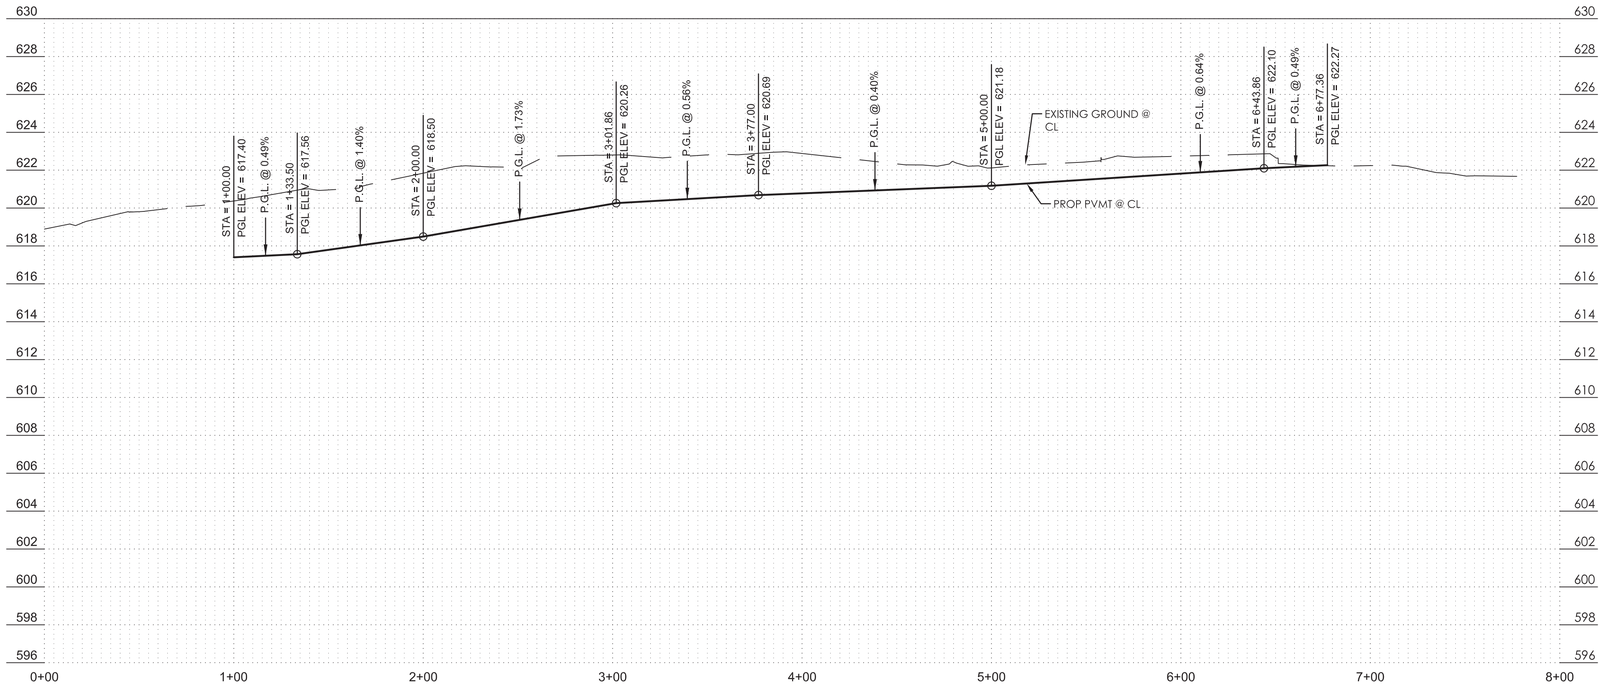

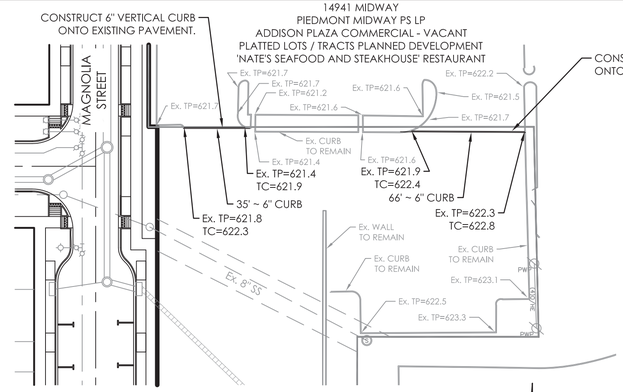

CURB REPLACEMENT DETAIL

Point	Station	Offset	Side	TP Elevation
1	1+33.50	12.0	Lt.	617.28
2	1+41.67	12.0	Lt.	617.42
3	1+69.01	15.2	Lt.	617.46
4	1+60.00	20.0	Lt.	621.40
5	6+08.50	20.0	Lt.	621.58
6	6+19.50	15.2	Lt.	621.71
7	6+26.83	12.0	Lt.	621.82
8	6+43.86	12.0	Lt.	621.82
9	6+43.86	12.0	Lt.	617.39
10	4+10.50	12.0	Rt.	620.53
11	3+89.00	33.5	Rt.	620.25
12	3+65.00	33.5	Rt.	620.25
13	3+43.50	12.0	Rt.	620.21
14	3+35.33	12.0	Rt.	620.17
15	3+28.00	15.2	Rt.	620.05
16	3+17.00	20.0	Rt.	619.87
17	1+60.00	20.0	Rt.	617.46
18	1+69.01	15.2	Rt.	617.42
19	1+41.67	12.0	Rt.	617.39
20	1+33.50	12.0	Rt.	617.28

0' 40' 80'
0' 4' 8'
HORIZ. SCALE: 1"=40'
VERT. SCALE: 1"=4'

PAVING LEGEND

- SANITARY SEWER AND MANHOLE
- SANITARY SEWER AND CLEANOUT
- EXISTING SANITARY SEWER AND MANHOLE
- PROPOSED FIRE HYDRANT ASSEMBLY
- PROPOSED WATERLINE WITH GATE VALVE AND BOX WITH 10' W.L.E.
- EXISTING WATERLINE WITH GATE VALVE AND BOX
- PROPOSED STORM SEWER WITH MANHOLE AND INLETS
- PROPOSED PRIVATE STORM SEWER
- EXISTING STORM SEWER AND MANHOLE
- EXISTING INLET
- PROPOSED TREE WELL
- 2'x6' TRUNCATED DOME PANEL
- LIMITS OF PARABOLIC PAVEMENT CROWN
- AREA OF NON-STANDARD PARABOLIC PAVEMENT CROWN

STATE OF TEXAS
CARMEN D. PEARSON
95885
LICENSED PROFESSIONAL ENGINEER
2018/04/04

SAWYER ENGINEERING, LLC
TBPE FIRM NUMBER F-9171

ONE-CALL NOTIFICATION SYSTEM
CALL BEFORE YOU DIG
1-800-545-6005
OR OTHER UTILITY LOCATING SERVICES AT LEAST 48 HOURS PRIOR TO CONSTRUCTION ACTIVITIES.

NO.	REVISION	BY	DATE

TOWN OF ADDISON
DALLAS COUNTY, TEXAS

IMPROVEMENT PLANS
ADDISON GROVE

PAVING PLAN & PROFILE - RUNYON ROAD (EAST)

SAWYER ENGINEERING, LLC
TBPE: F-9171
1520 OLIVER STREET
HOUSTON, TEXAS 77007
(832) 553-5948

PROJECT	DESIGN	DRAWN	DATE	FILE	SHEET
	CDP	JDS	MAY 2017		8