


Council Aug. 25th approved Plan } 611- Tract I - PD Condo } Dondi
 } 612- Tract IX - PD Midrise Condo }
 Council 9-24th prelin plan } 629- Tract VIII - PD - mid-rise } Drexel
 approved } 630- Tract II - PD - mid-rise } preliminary

1.78 Preliminary Plat
 Final Plat

SYNOPSIS

PROTON PLAZA ADDITION	22,788 Acres
BLOCK A	6,031 Acres
BLOCK B	15,630 Acres
STREET DEDICATION	1,178 Acres
LES LACS VILLAGE	
BLOCK A	34,256 Acres
BLOCK B	40,359 Acres
TRACT II	12,000 Acres
REMAINDER	28,350 Acres
BLOCK C	
TRACT I	81,594 Acres
TRACT II	11,000 Acres
TRACT III	8,000 Acres
TRACT IV	8,484 Acres
TRACT V	11,000 Acres
TRACT VI	9,528 Acres
TRACT VII	15,000 Acres
TRACT VIII	10,999 Acres
TRACT IX	8,000 Acres

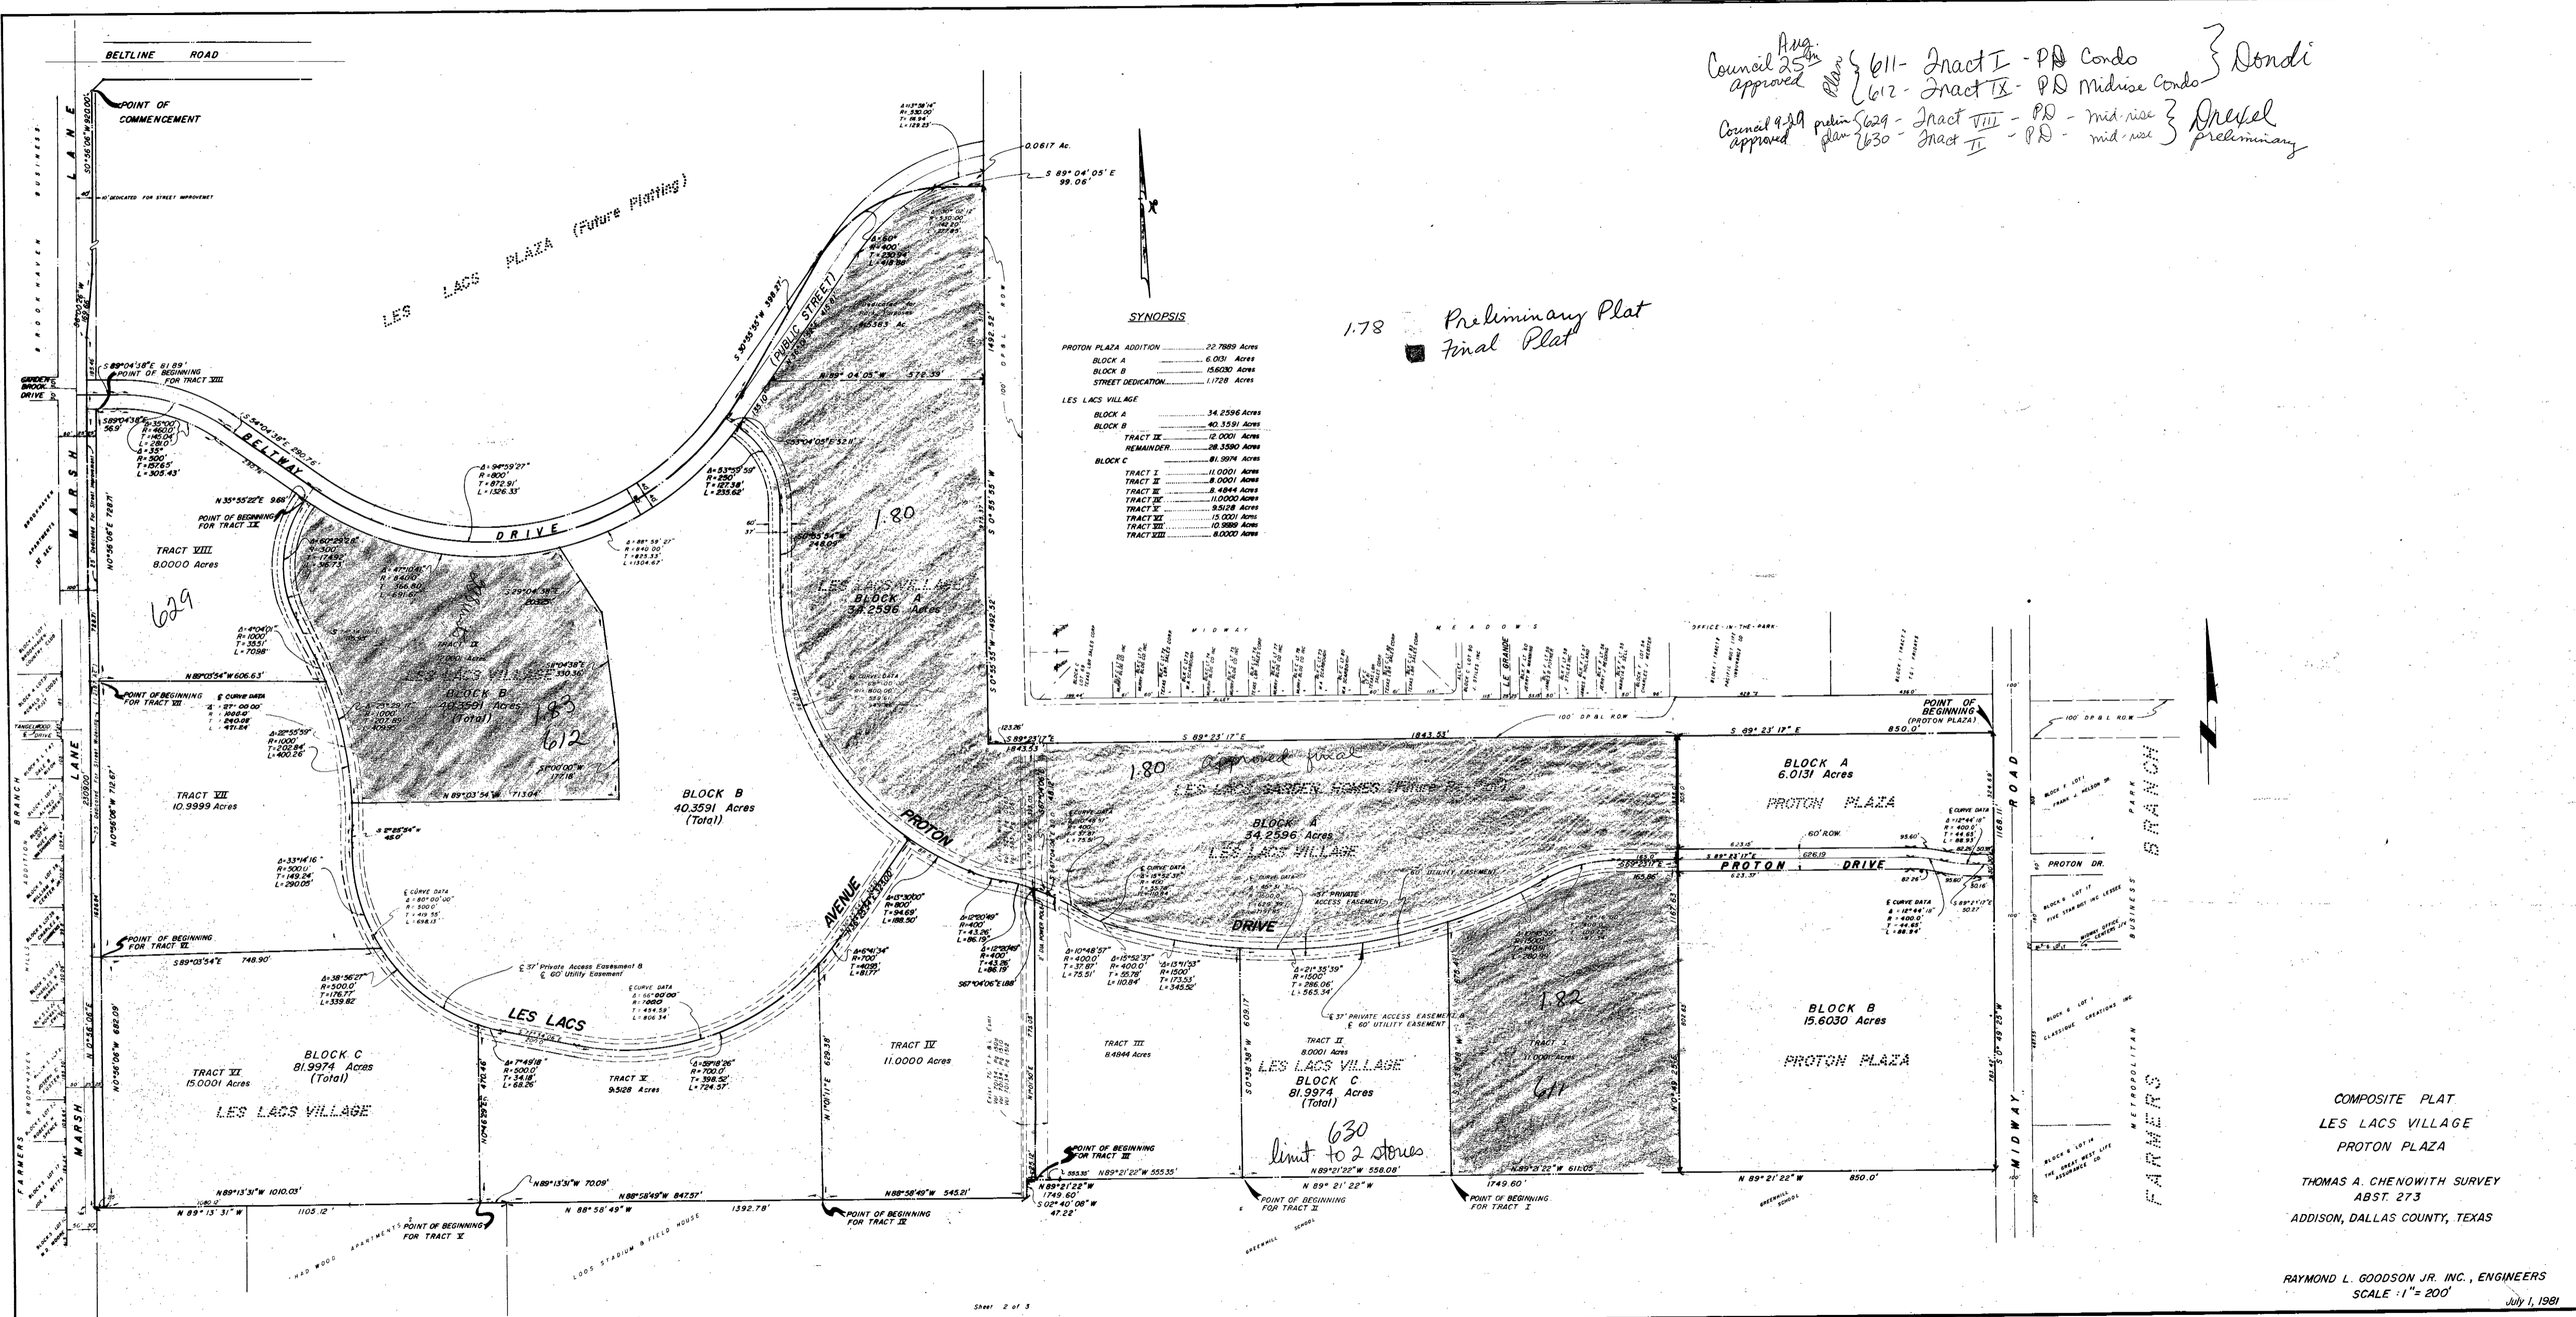

COMPOSITE PLAT
 LES LACS VILLAGE
 PROTON PLAZA
 THOMAS A. CHENOWITH SURVEY
 ABST. 273
 ADDISON, DALLAS COUNTY, TEXAS

RAYMOND L. GOODSON JR., ENGINEERS
 SCALE: 1" = 200'
 July 1, 1981