

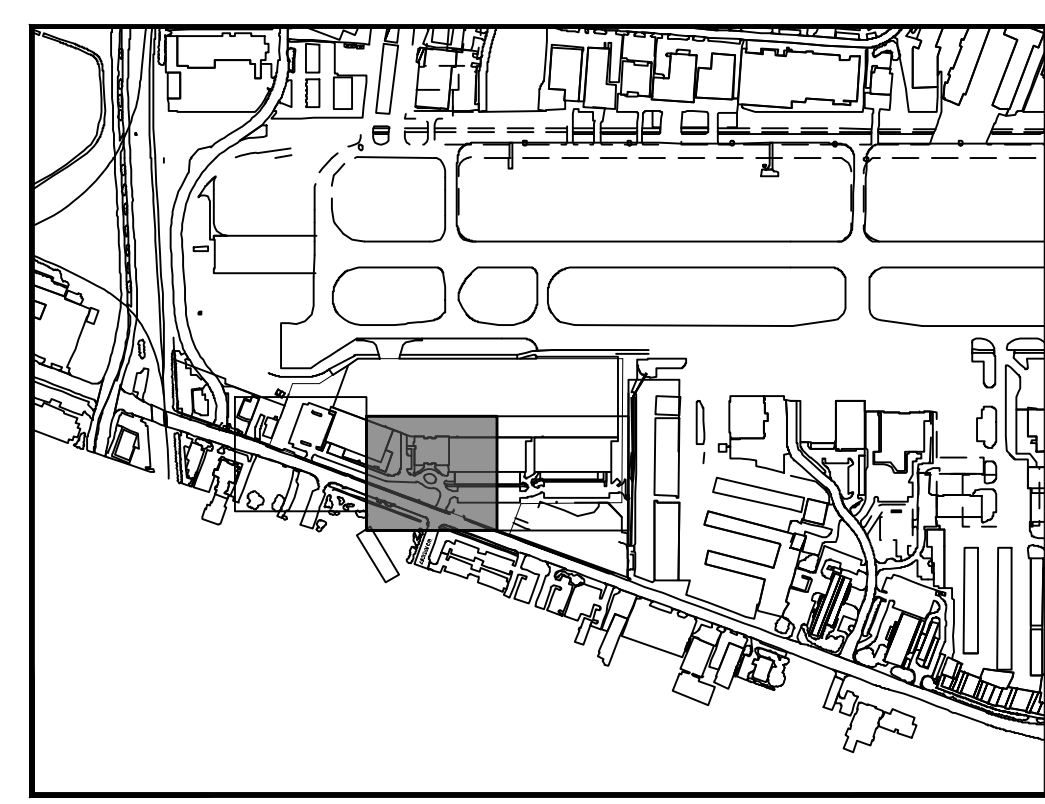


Plotted By: Acevedo, Elsie - Sheet: Set-Kha - Layout: C05.02 - April 29, 2020 - 10:00:57am - K:\WDL-Aviation\067792503 - Addison - Galaxy_FBO\ACAD\Drawings\C05.02 GEOMETRY LANDSIDE PLAN.dwg
 This document, together with the concepts and designs presented herein, is an instrument of service, as an instrument of service, is intended only for the specific purpose and client for which it was prepared. Reuse or improper reliance on this document without written authorization and approval by Kimley-Horn and Associates, Inc. shall be without liability to Kimley-Horn and Associates, Inc.

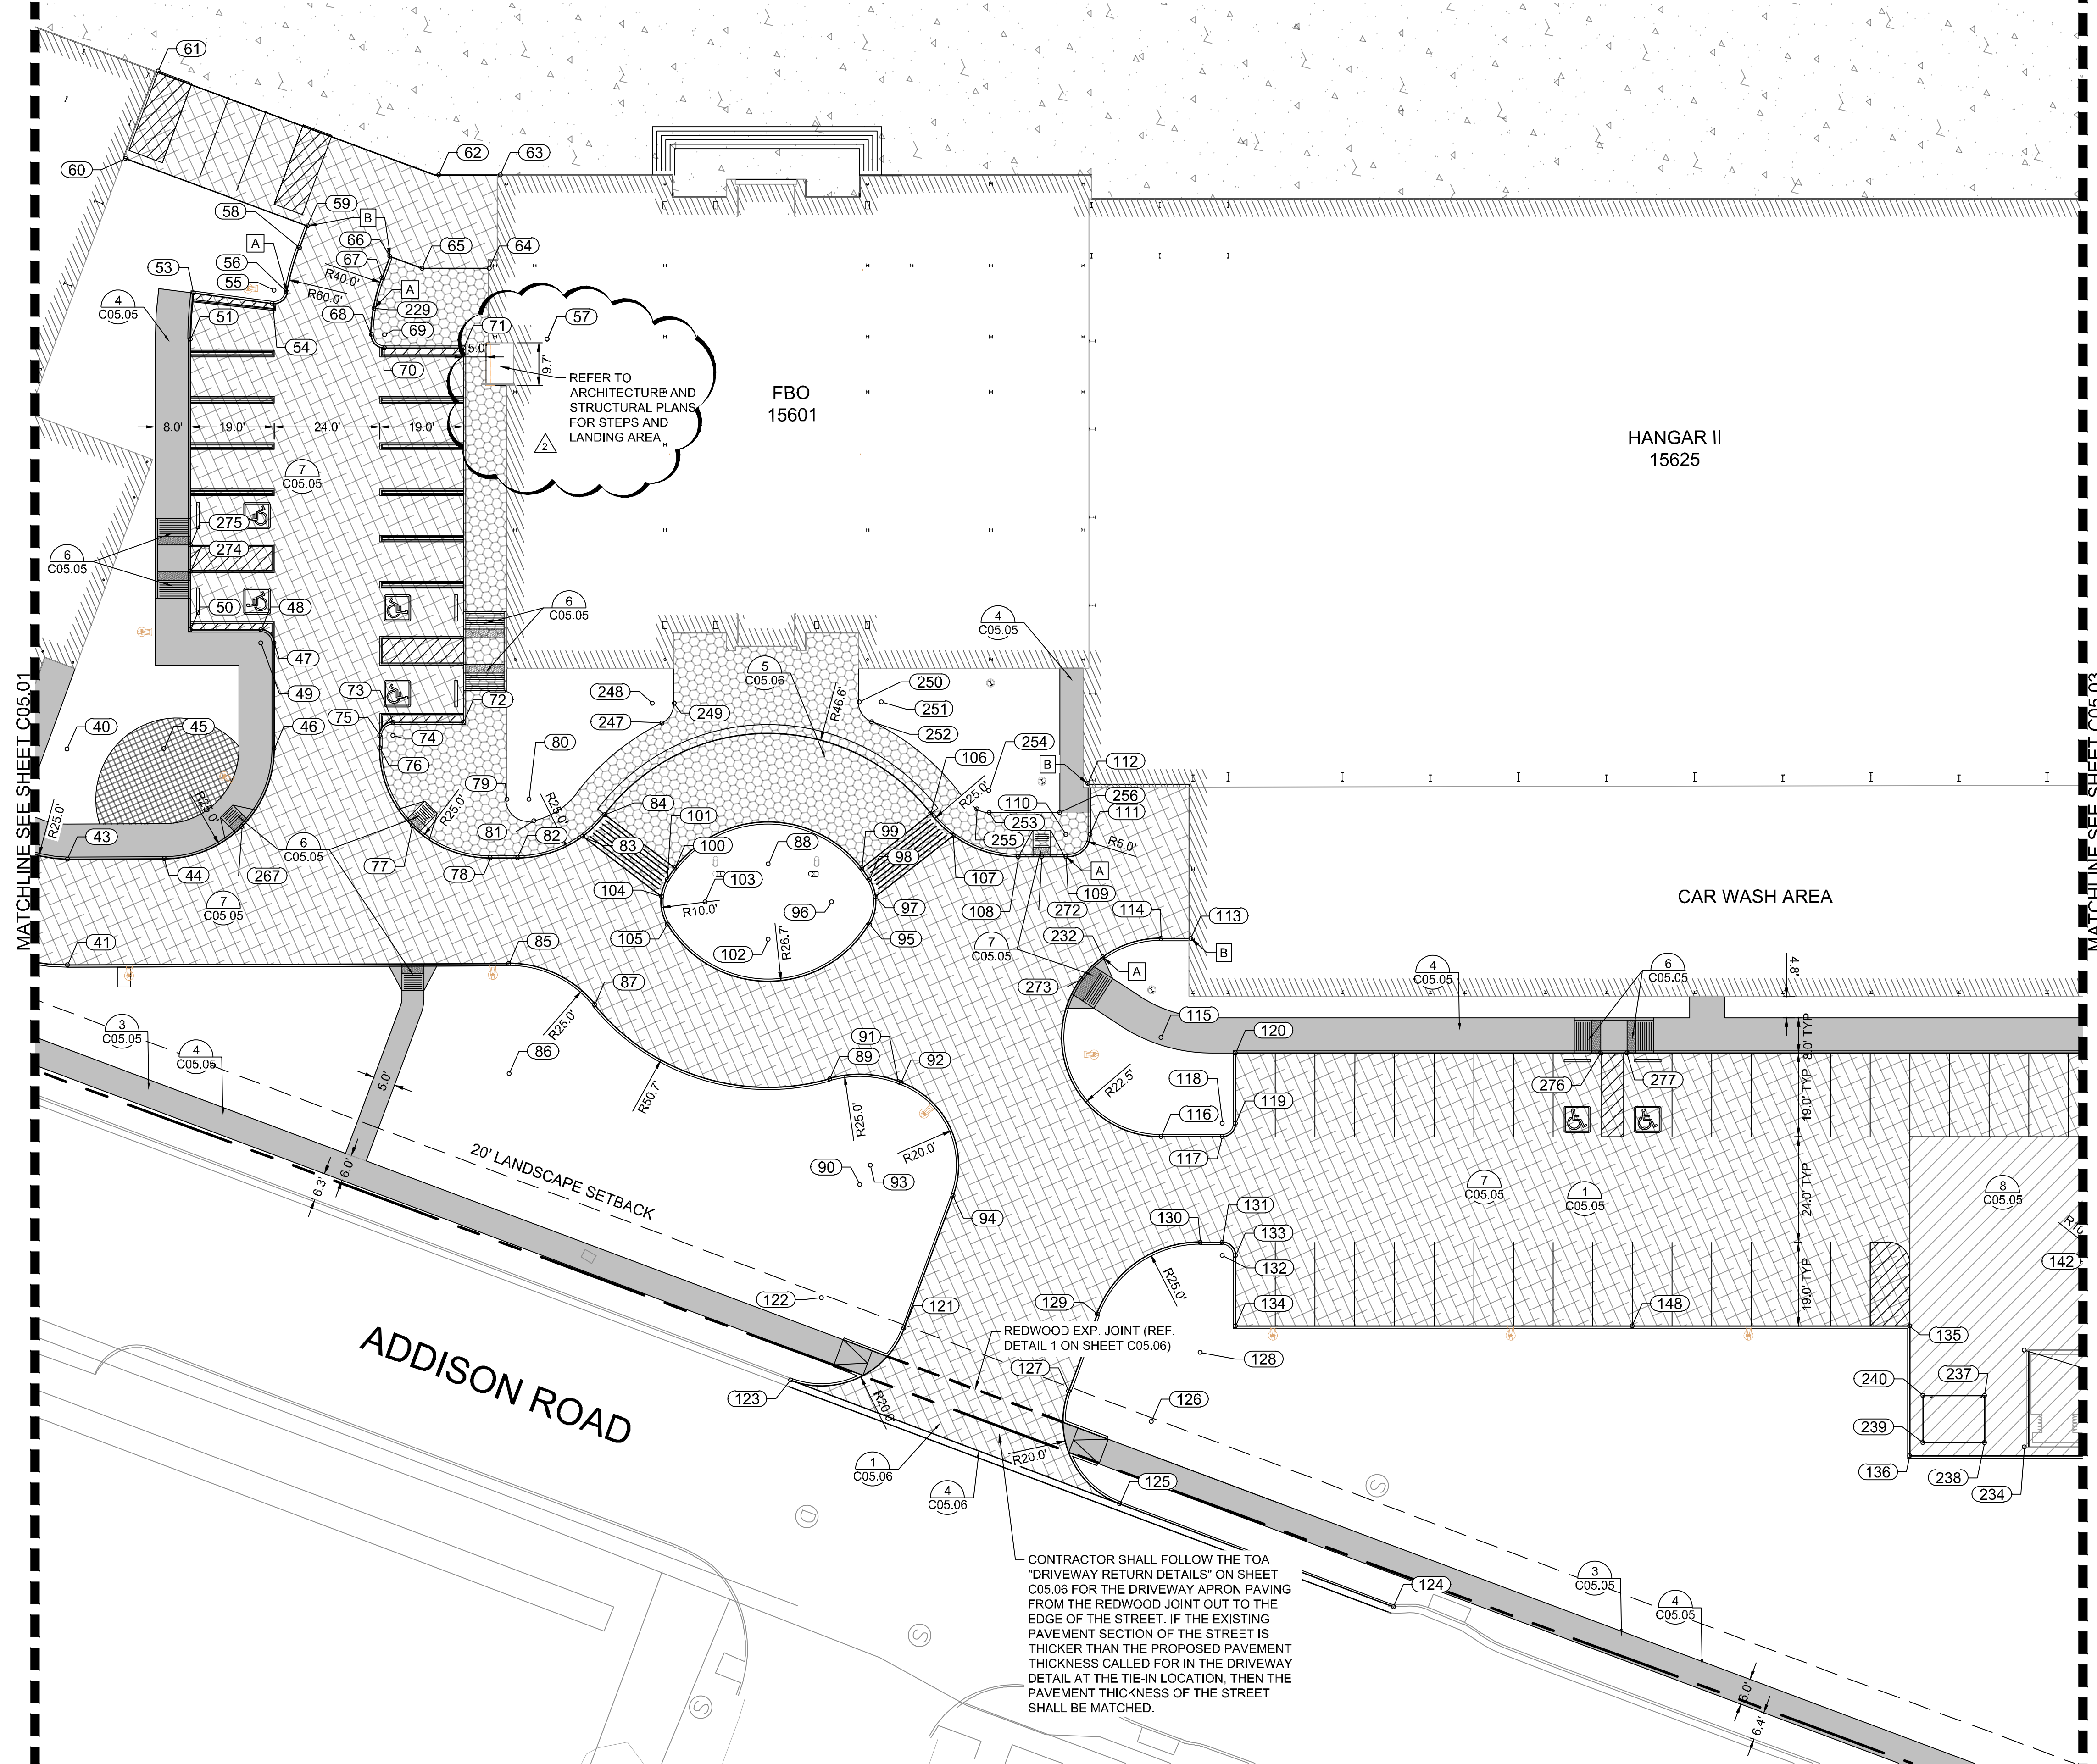

KEY PLAN

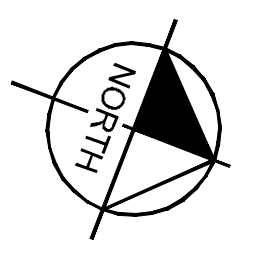

**Town of Addison
 Engineering Review
 Civil Approval**


Reviewed by: **Jenny Prazak, P.E.**
 Date: **05/19/2020**
 See letter for pre-construction instructions.

NOTES:

- [A] START OF CURB TRANSITION.
 - [B] END OF CURB TRANSITION.
1. ALL RADII 3' UNLESS OTHERWISE NOTED
 2. SEE GEOMETRY LANDSIDE POINT TABLE ON SHEET C05.04.



LEGEND

- PROPOSED 11.25" PCC APRON PAVEMENT
- PROPOSED 6" PCC LANDSIDE MEDIUM DUTY PAVEMENT
- PROPOSED STAMPED 6" PCC LANDSIDE PAVEMENT
- PROPOSED 5" SIDEWALK
- PROPOSED 7" PCC LANDSIDE HEAVY DUTY PAVEMENT
- PROPOSED LANDSCAPE FEATURE. REF. LANDSCAPE PLANS FOR DETAILS.
- DETAIL #
PAGE #

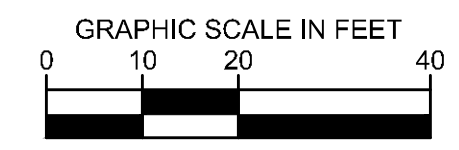


		<p>© 2019 KIMLEY-HORN AND ASSOCIATES, INC. 1400 WOODLICK FOREST DRIVE, SUITE 225 FORT WORTH, TEXAS 76104 PHONE: 281-475-2816 TBP# FIRM REGISTRATION F-928 WWW.KIMLEY-HORN.COM</p>		<p>04/30/20</p>	
<p>KHA PROJECT 067792503</p>	<p>DATE 2/21/2020</p>	<p>SCALE AS SHOWN</p>	<p>DESIGNED BY HCV</p>	<p>DRAWN BY EC EAC</p>	<p>CHECKED BY HCV</p>
<p>GEOMETRY LANDSIDE PLAN</p>		<p>ADDISON GALAXY FBO 15601 ADDISON RD. PREPARED FOR BLACK FOREST VENTURE</p>			
<p>SHEET NUMBER C05.02</p>		<p>ADDISON DALLAS, TEXAS</p>			

Plotted By: Acevedo, Elsie - Sheet: Set-Kha - Layout: C07.01 - April 29, 2020 09:52:09am - K:\WDL-Aviation\067792503 - Addison - Galaxy - FBO\ACAD.dwg - Sheets\C07.00 LANDSIDE JOINT LAYOUT PLAN.dwg
 This document, together with the concepts and designs presented herein, is an instrument of service, as an instrument of service, and shall be without liability to Kimley-Horn and Associates, Inc.

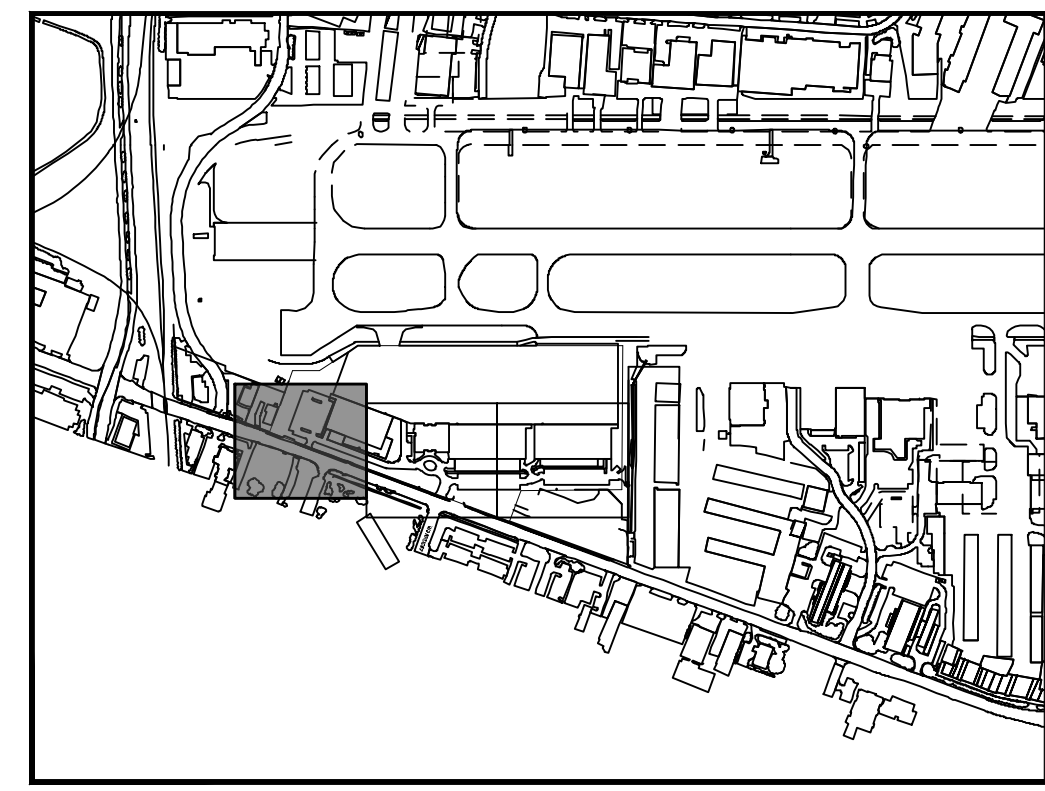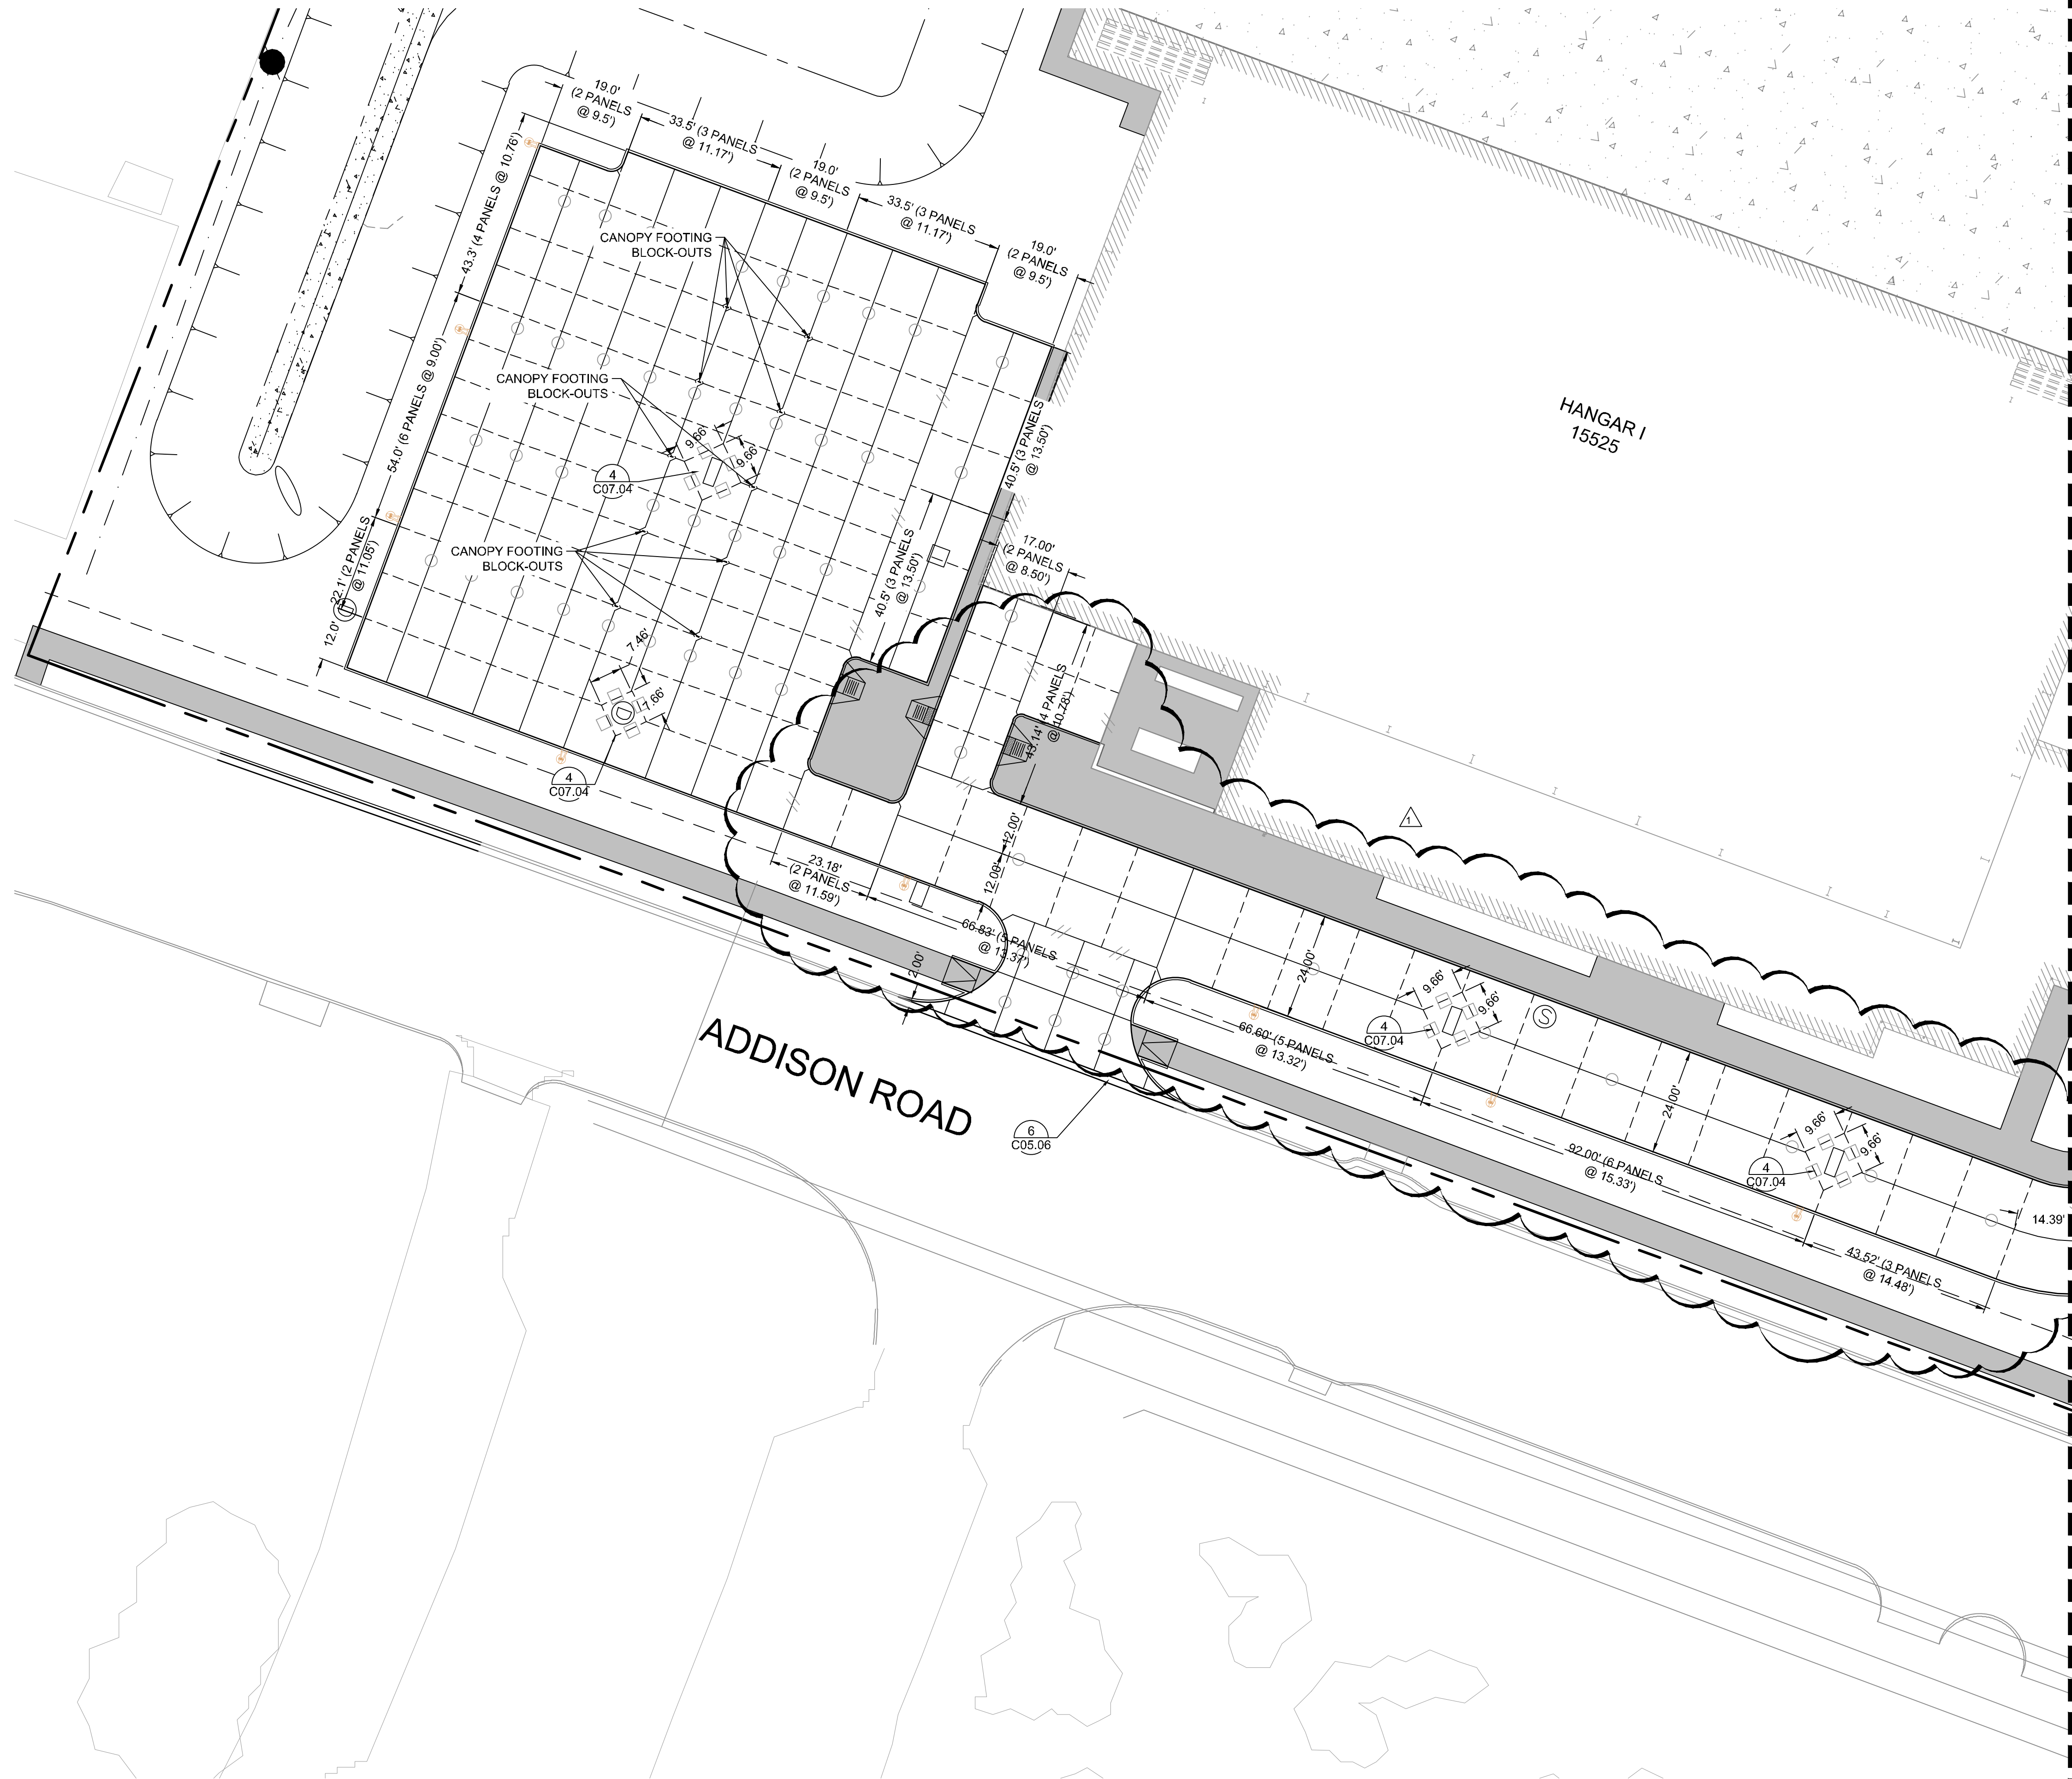

KEY PLAN

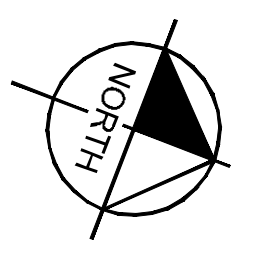


NOTES:

1. TYPE 'E1' JOINTS SHALL SURROUND ALL INLETS.
2. TYPE 'D' JOINTS SHALL BE INSTALLED FROM THE CORNER OF THE INLET TO THE CORNER/EDGE OF PANEL AS SHOWN ON THE PLANS.
3. INSTALL (2) 24 INCH #5 DEFORMED REBAR AT THE CORNERS OF ALL INLETS.
4. CONTRACTOR TO REFER TO TOWN OF ADDISON DETAILS FOR JOINT LOCATION AND SPACING.

LEGEND


- TRANSVERSE EXPANSION JOINT (NO DOWEL BARS TO BE INSTALLED)
- LONGITUDINAL BUTT JOINT
- TRANSVERSE EXPANSION JOINT AROUND INLET
- SAWED DUMMY JOINT

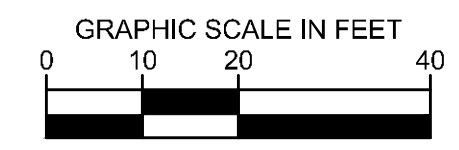

MATCHLINE SEE SHEET C07.02

No.	REVISIONS	DATE	BY
1	ASB-C003	04/30/2020	JM

Kimley»Horn
 © 2019 KIMLEY-HORN AND ASSOCIATES, INC.
 1400 WOODLACK FOREST DRIVE, SUITE 225
 FORT WORTH, TEXAS 76104
 PHONE: 281-475-2816
 TBP# FIRM REGISTRATION F-928
 WWW.KIMLEY-HORN.COM

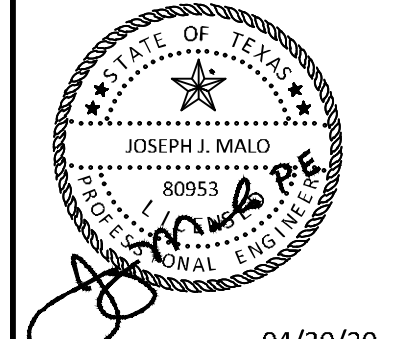



KHA PROJECT	067792503
DATE	2/21/2020
SCALE	AS SHOWN
DESIGNED BY	HCV
DRAWN BY	EC EAC
CHECKED BY	HCV

**LANDSIDE JOINT
LAYOUT PLAN**


ADDISON GALAXY FBO
 15601 ADDISON RD.
 PREPARED FOR
 BLACK FOREST VENTURE
 DALLAS, TEXAS
 ADDISON

SHEET NUMBER
C07.01

Plotted By: Acevedo, Elsie - Sheet Set: KHA - Layout: C07.02 - April 29, 2020 - 09:53:27am - K:\VDC\Aviation\067792503 - Addison - Galaxy FBO\ACAD\Draws\Sheets\C07.00 LANDSIDE JOINT LAYOUT PLAN.dwg
 This document, together with the concepts and designs presented herein, is intended only for the specific purpose and client for which it was prepared. Reuse or modification of this document without written authorization and adaptation by Kimley-Horn and Associates, Inc. shall be without liability to Kimley-Horn and Associates, Inc.

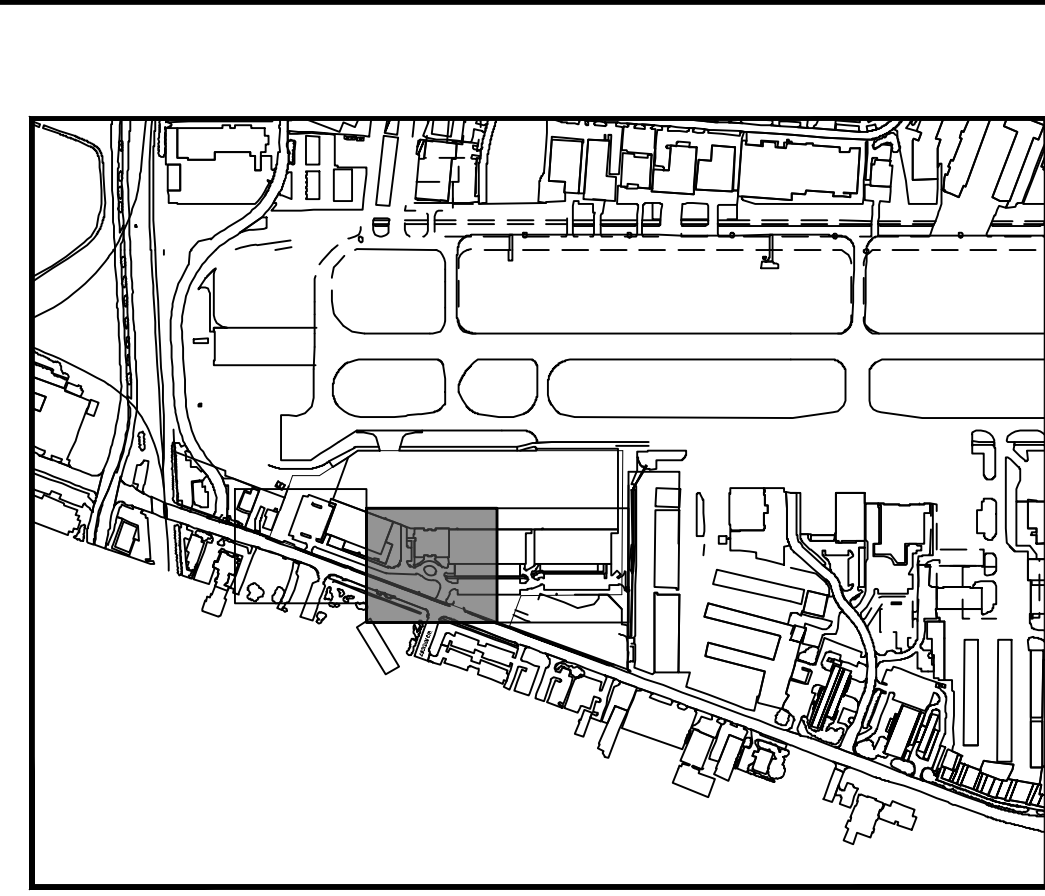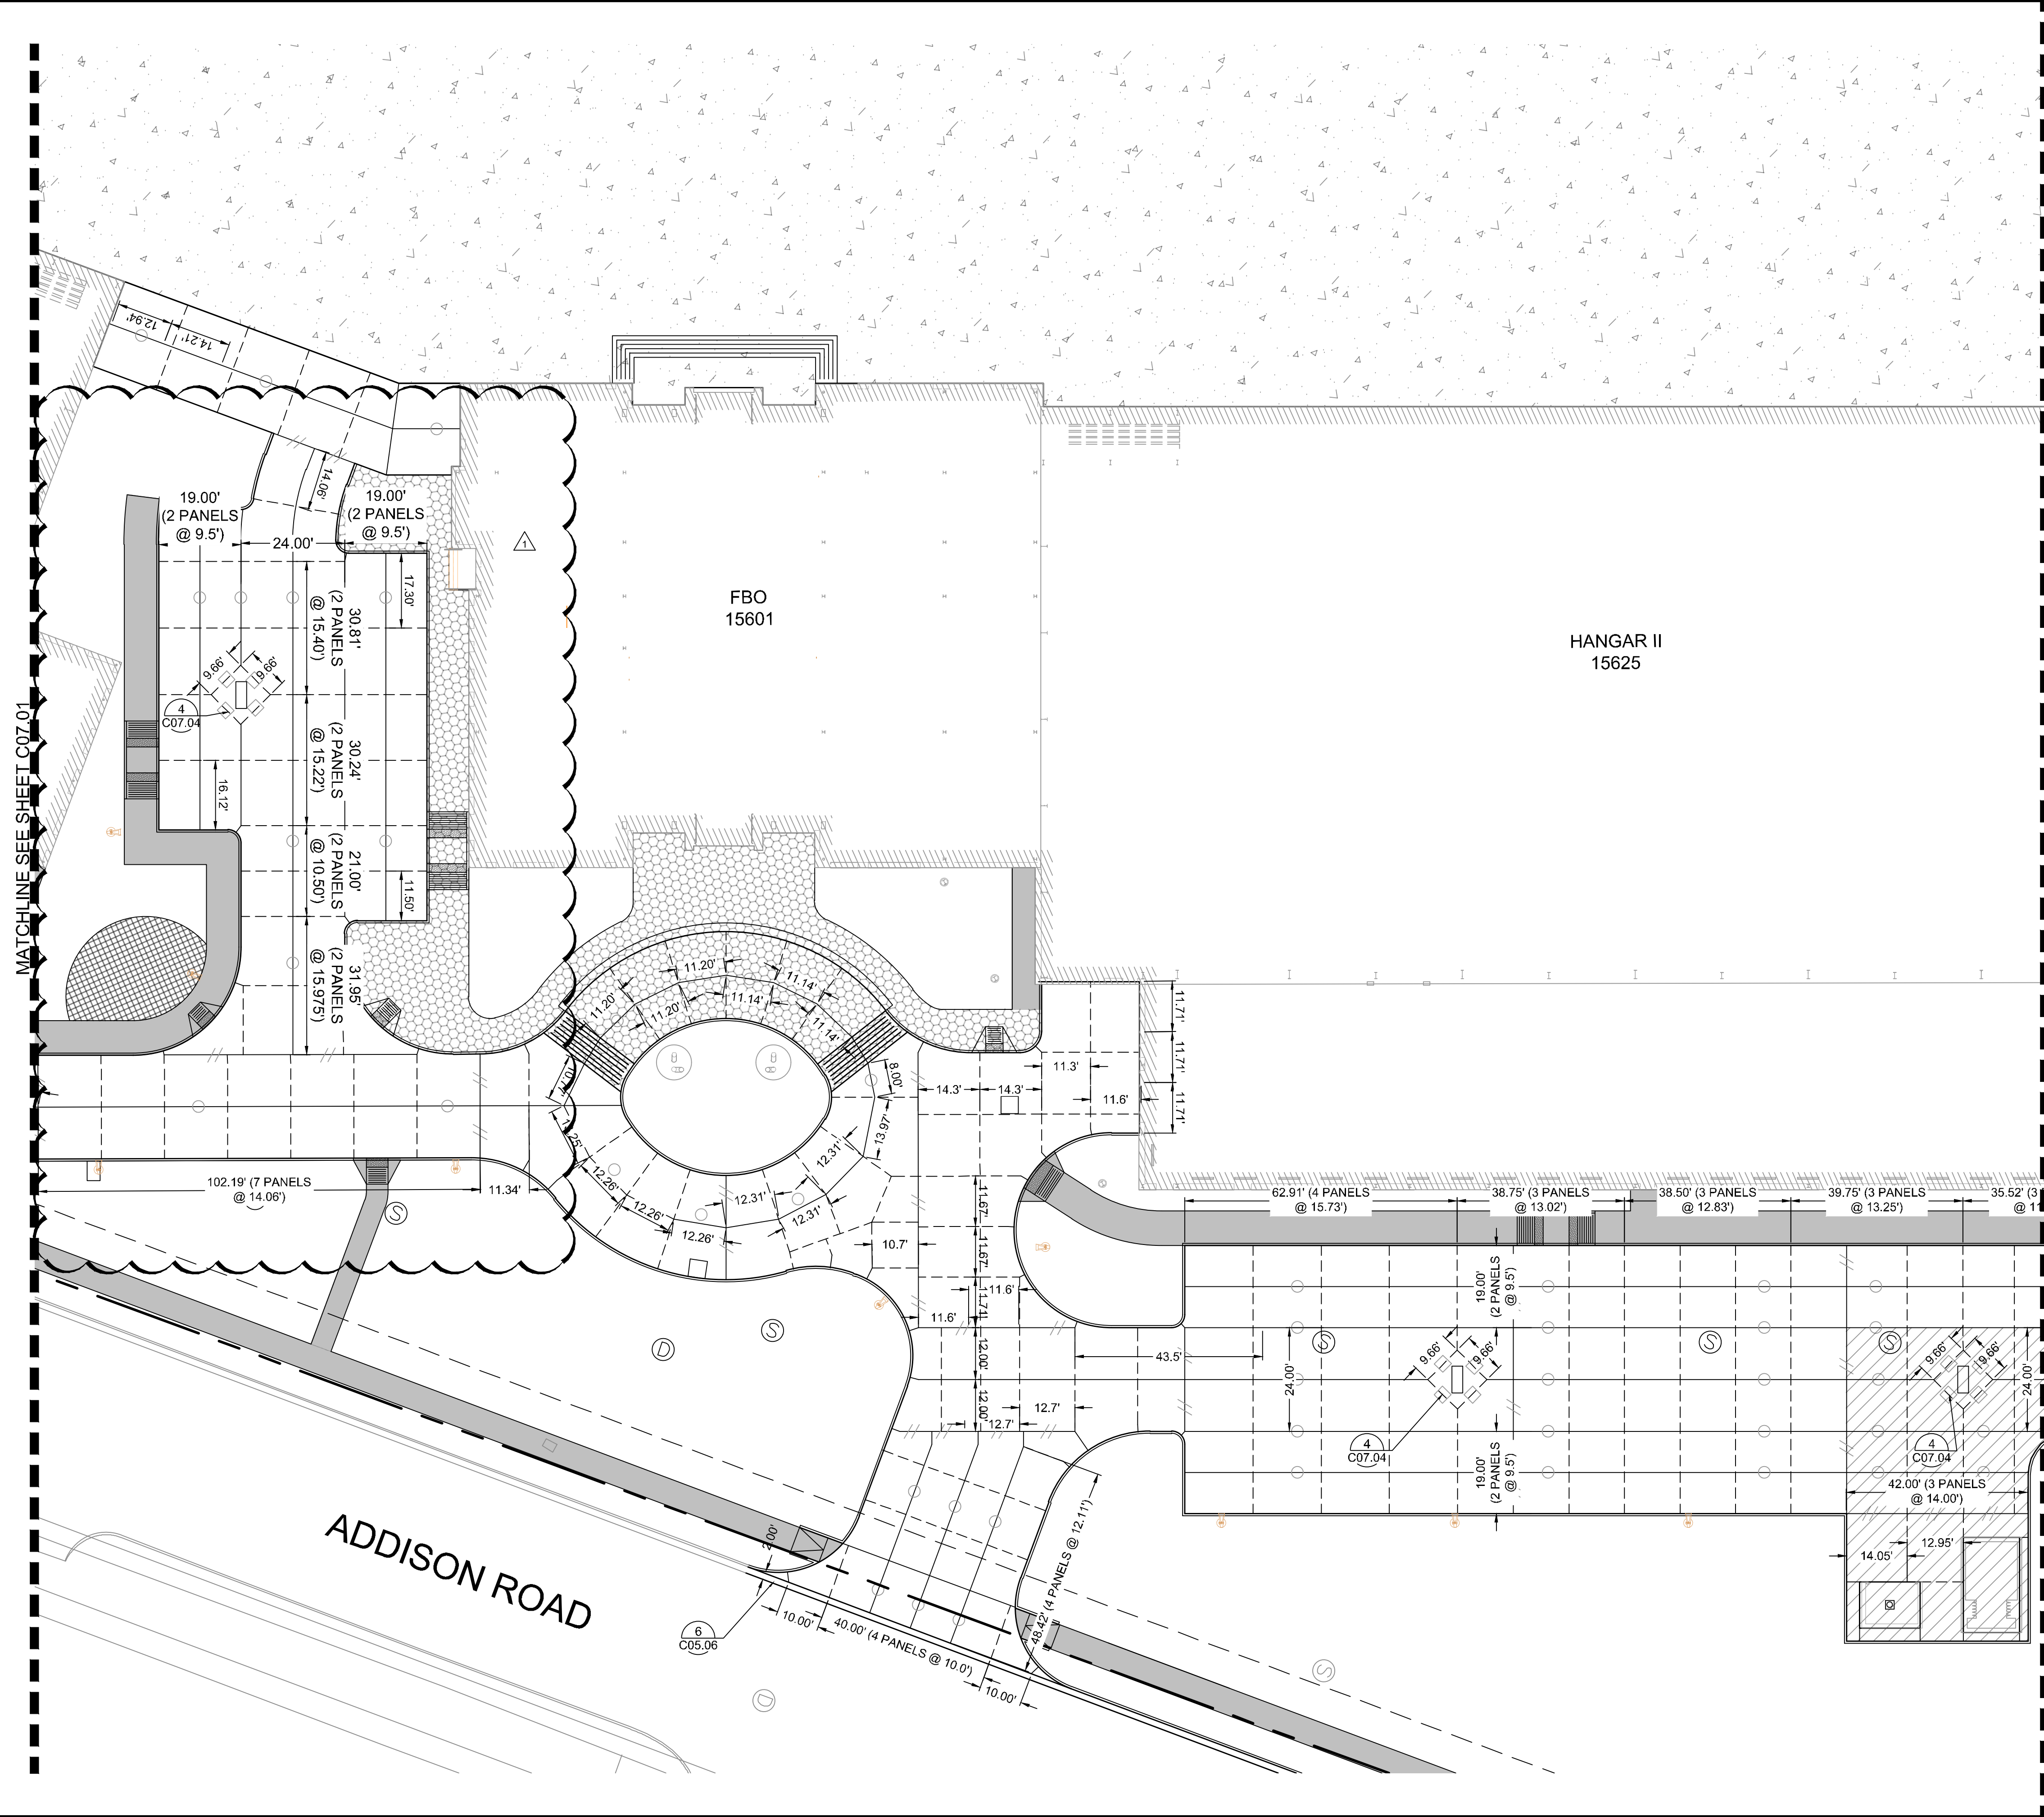

KEY PLAN

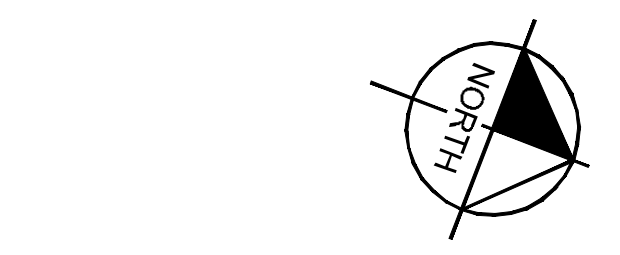


NOTES:

1. TYPE 'E1' JOINTS SHALL SURROUND ALL INLETS.
2. TYPE 'D' JOINTS SHALL BE INSTALLED FROM THE CORNER OF THE INLET TO THE CORNER/EDGE OF PANEL AS SHOWN ON THE PLANS.
3. INSTALL (2) 24 INCH #5 DEFORMED REBAR AT THE CORNERS OF ALL INLETS.
4. CONTRACTOR TO REFER TO TOWN OF ADDISON DETAILS FOR JOINT LOCATION AND SPACING.




LEGEND

- //— TRANSVERSE EXPANSION JOINT (NO DOWEL BARS TO BE INSTALLED)
- LONGITUDINAL BUTT JOINT
- - - □ - - - TRANSVERSE EXPANSION JOINT AROUND INLET
- - - - - SAWED DUMMY JOINT

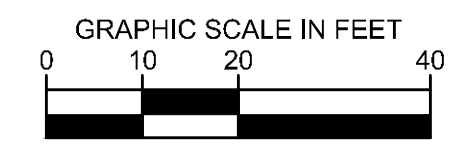

	© 2019 KIMLEY-HORN AND ASSOCIATES, INC. 1400 WOODLACK FOREST DRIVE, SUITE 225 FORT WORTH, TEXAS 76104 PHONE: 281-475-2816 TBPE FIRM REGISTRATION F-928 WWW.KIMLEY-HORN.COM
	04/30/20
LANDSIDE JOINT LAYOUT PLAN	
ADDISON GALAXY FBO 15601 ADDISON RD. PREPARED FOR BLACK FOREST VENTURE	DALLAS, TEXAS
SHEET NUMBER C07.02	

Plotted By: Acevedo, Elsieh Sheet: Set: KHA Layout: C09.01 April 30, 2020 07:58:23am K:\WDL_Aviation\067792503 - Addison Galaxy FBO\ACAD.dwg Sheets\C09.00 LANDSIDE PAVT ELEVATION PLAN.dwg
 This document, together with the concepts and designs presented herein, is an instrument of service, as an instrument of service, and shall be without liability to Kimley-Horn and Associates, Inc. if it is not signed and sealed by a Professional Engineer in the State of Texas.

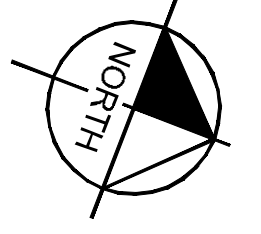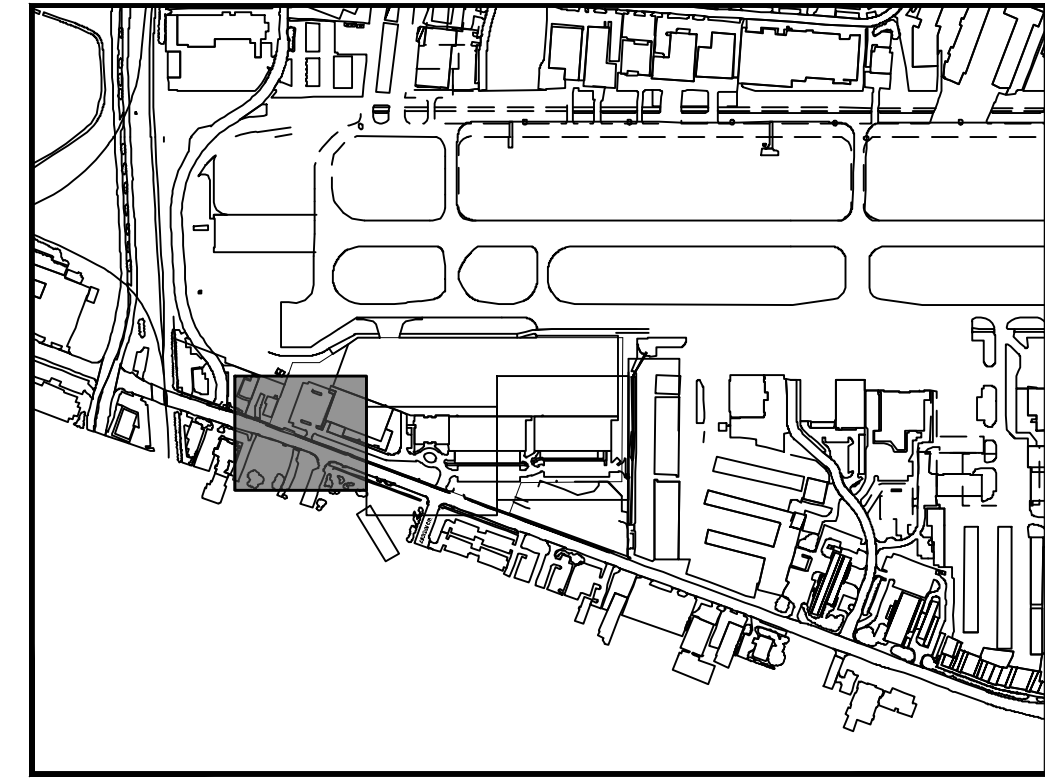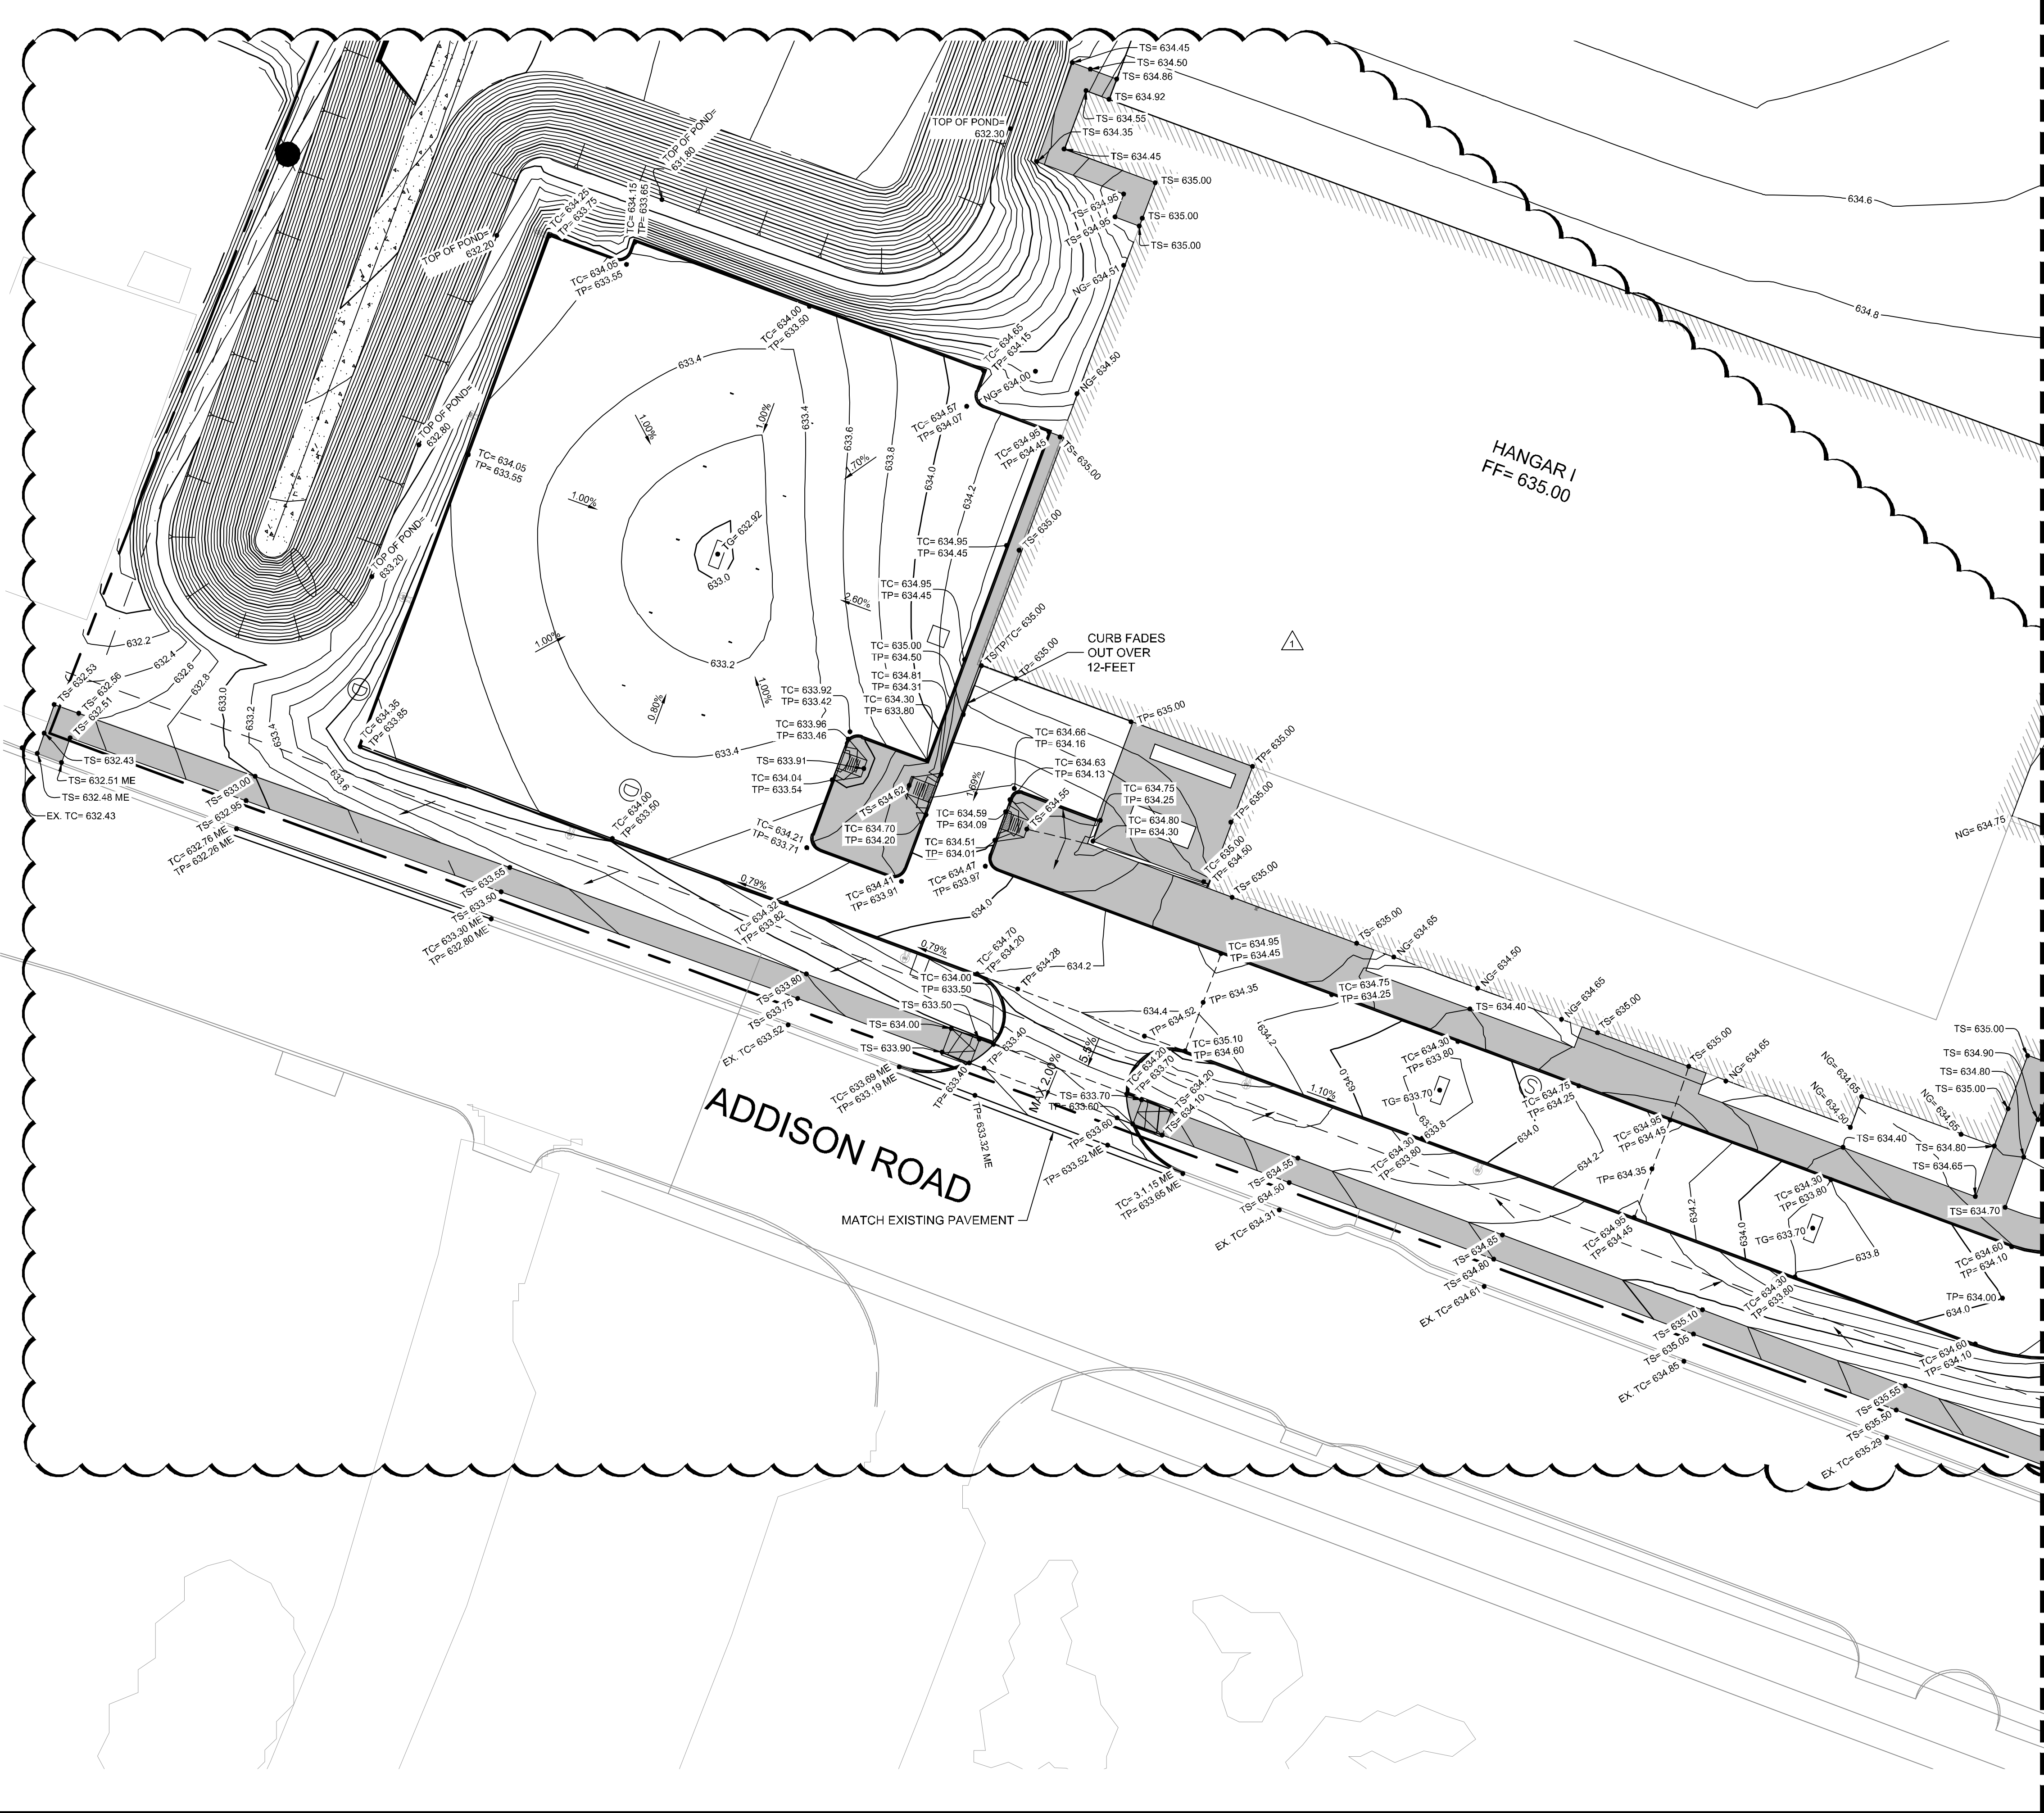


KEY PLAN

MATCHLINE SEE SHEET C09.02

- NOTES**
- ALL SIDEWALKS AND ACCESSIBLE ROUTES, INCLUDING DRIVEWAY CROSSWALKS, SHALL CONFORM TO ALL APPLICABLE AMERICANS WITH DISABILITIES ACT STANDARDS AND THE TEXAS ACCESSIBILITY STANDARDS. IF ANY DISCREPANCY IS DISCOVERED, THE CONTRACTOR SHALL NOTIFY THE ENGINEER PRIOR TO POURING ANY PAVEMENT.
 - ALL SIDEWALKS AND ACCESSIBLE ROUTES SHALL NOT EXCEED A RUNNING SLOPE OF 5% (1:20) WITHOUT A RAMP, AND SHALL NOT EXCEED A 2% CROSS SLOPE (1:50).
 - THE ACCESSIBLE PARKING AND PASSENGER LOADING AREAS SHALL NOT EXCEED A SLOPE OF 2% (1:50) IN ANY DIRECTION.


LEGEND

ME	MATCH EXISTING ELEVATION
TS	TOP OF SIDEWALK ELEVATION
NG	NATURAL GROUND ELEVATION
TP	TOP OF PAVEMENT ELEVATION
TC	TOP OF CURB ELEVATION
---	HIGH POINT
□	STORM SEWER INLETS

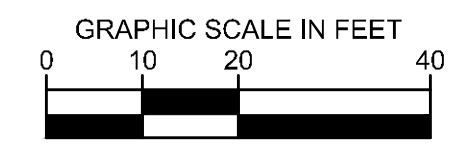

		© 2019 KIMLEY-HORN AND ASSOCIATES, INC. 1400 WOODLICK FOREST DRIVE, SUITE 225 HOUSTON, TEXAS 77057 PHONE: 281-475-2816 TBP FIRM REGISTRATION F-928 WWW.KIMLEY-HORN.COM	REVISIONS No. DATE BY
KHA PROJECT 067792503	DATE 2/21/2020	SCALE AS SHOWN DESIGNED BY HCV DRAWN BY EC EAC CHECKED BY HCV	04/30/20
LANDSIDE PAVEMENT ELEVATION PLAN		ADDISON DALLAS, TEXAS	
ADDISON GALAXY FBO 15601 ADDISON RD. PREPARED FOR BLACK FOREST VENTURE		SHEET NUMBER C09.01	


Plotted By: Acevedo, Elsieh Sheet: Set: KHA Layout: C09.02 May 08, 2020 01:27:17pm K:\V\Addison\Addison\067792503 - Addison Galaxy FBO\ACAD\dwg\Sheets\C09.00 LANDSIDE PAVT ELEVATION PLAN.dwg
 This document, together with the concepts and designs presented herein, is an instrument of service, as an instrument of service, and shall be without liability to Kimley-Horn and Associates, Inc.

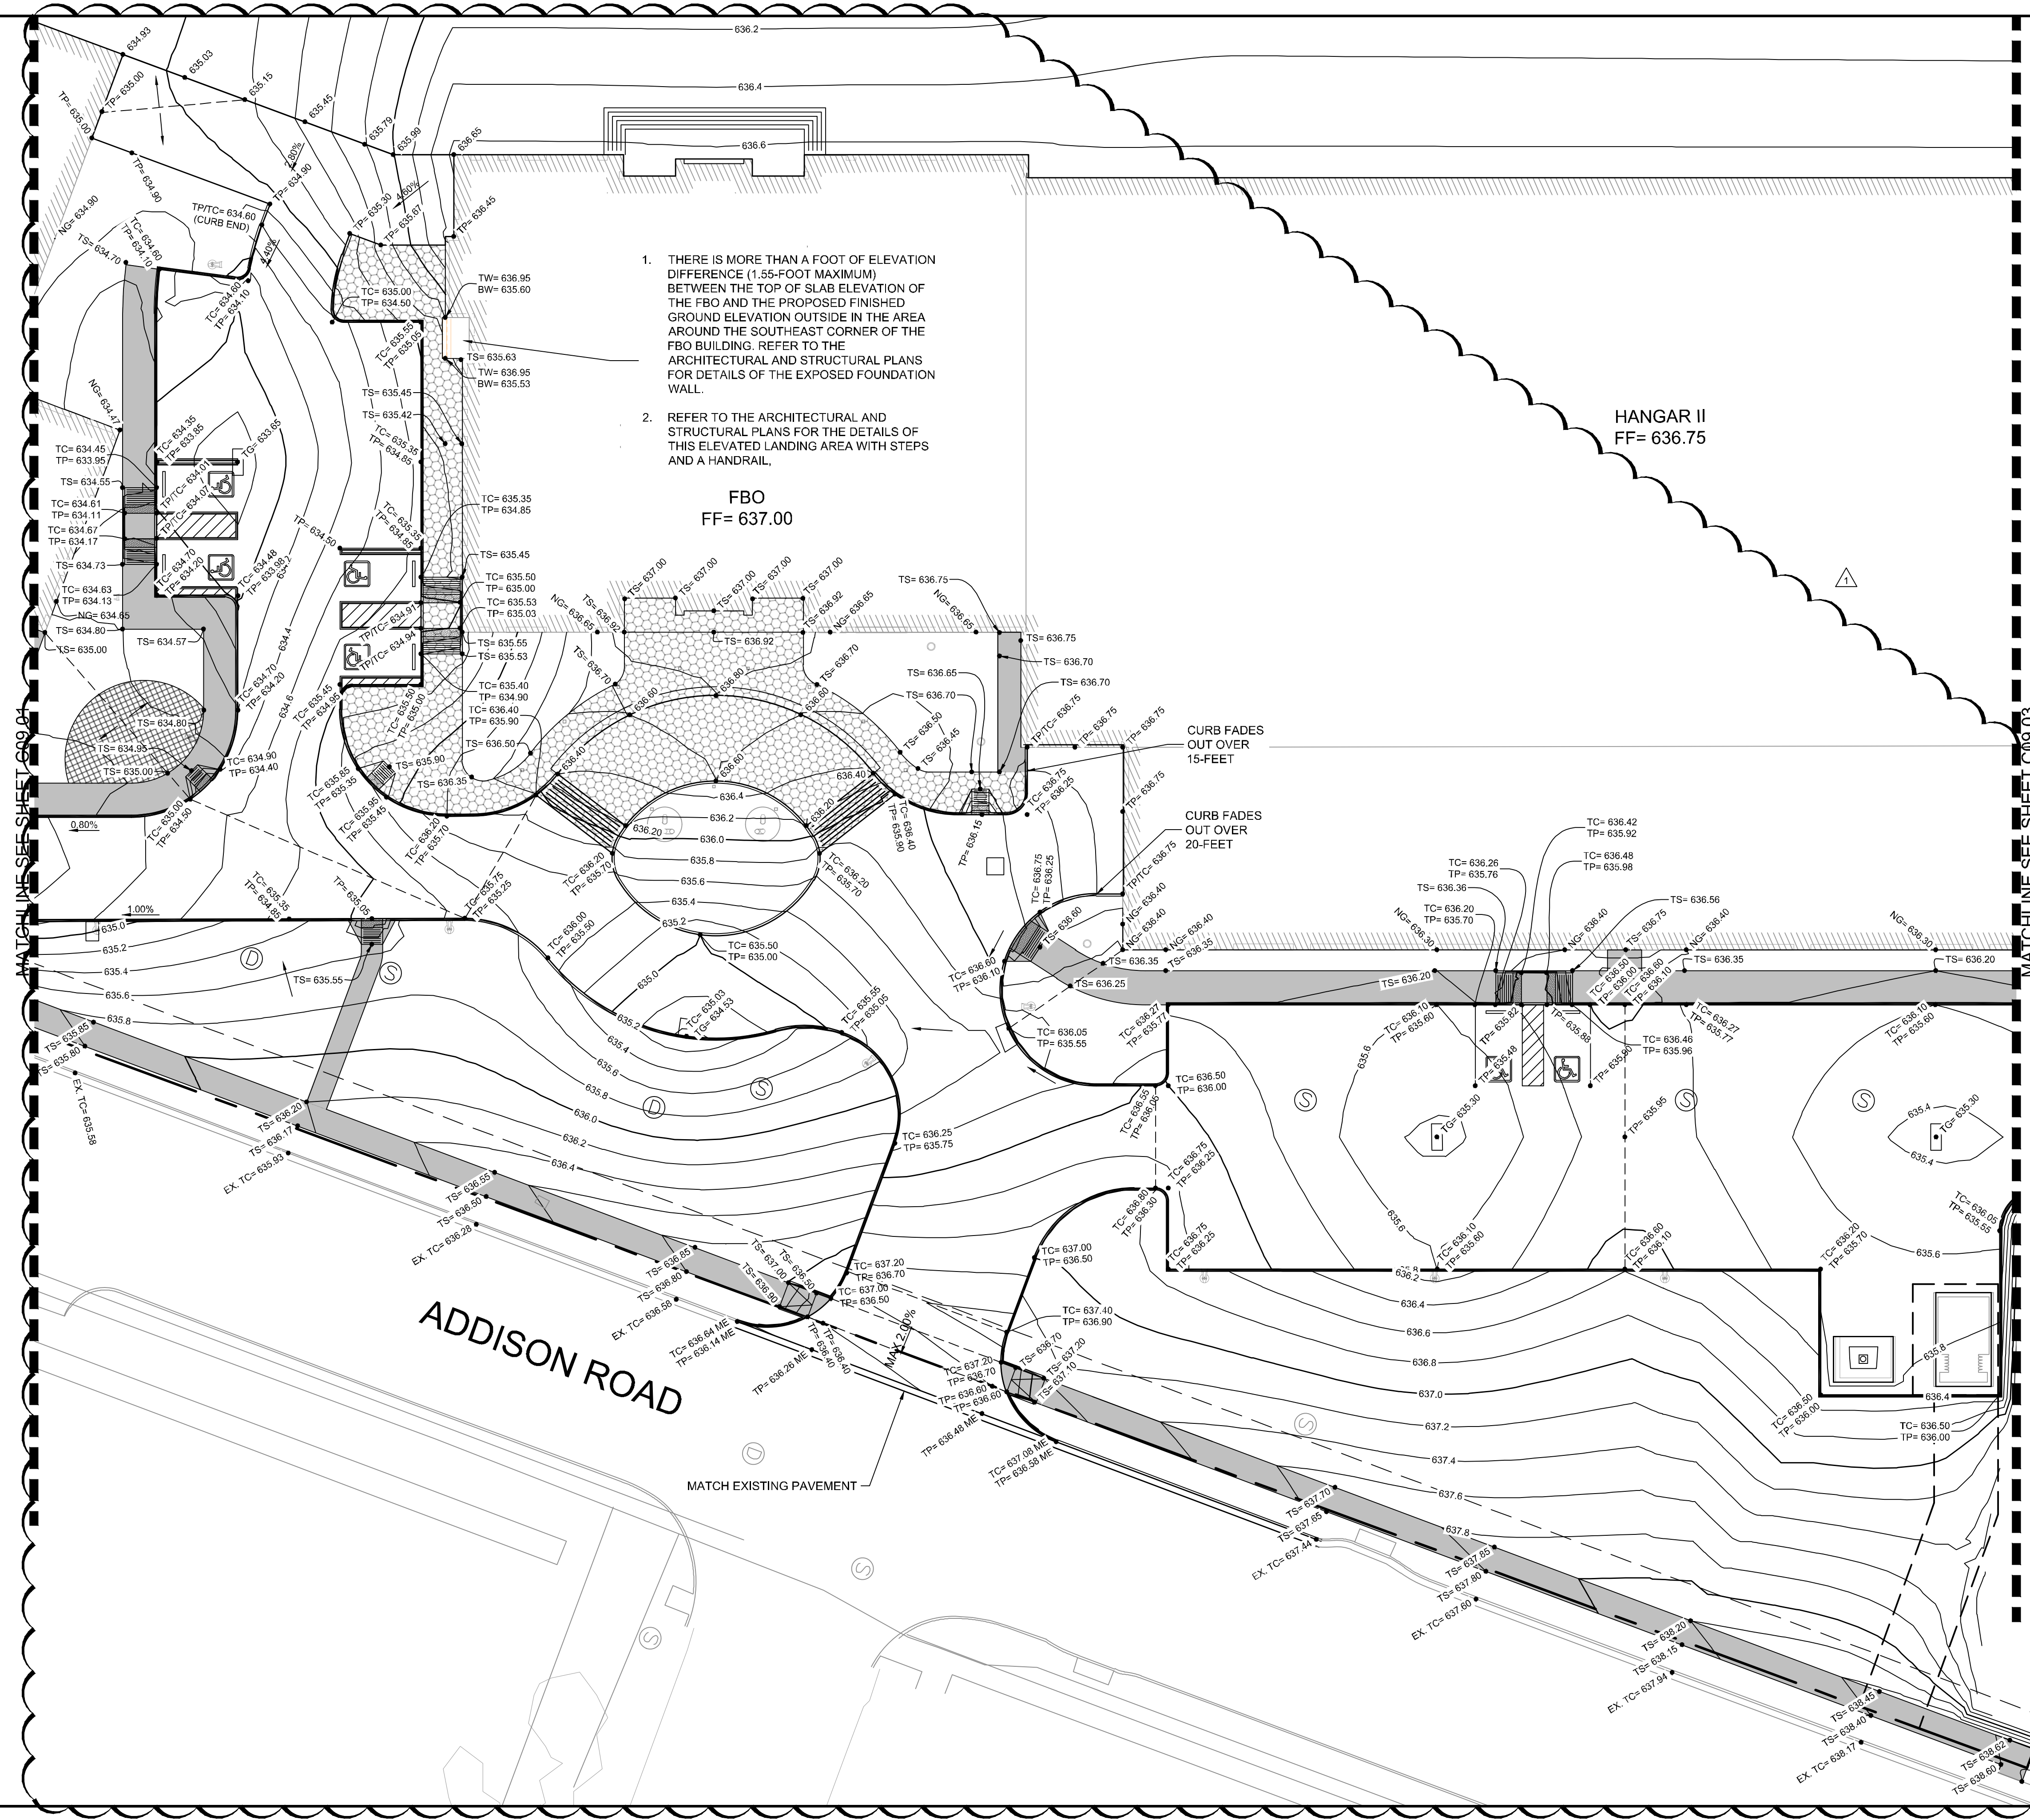


1. THERE IS MORE THAN A FOOT OF ELEVATION DIFFERENCE (1.55-FOOT MAXIMUM) BETWEEN THE TOP OF SLAB ELEVATION OF THE FBO AND THE PROPOSED FINISHED GROUND ELEVATION OUTSIDE IN THE AREA AROUND THE SOUTHEAST CORNER OF THE FBO BUILDING. REFER TO THE ARCHITECTURAL AND STRUCTURAL PLANS FOR DETAILS OF THE EXPOSED FOUNDATION WALL.
2. REFER TO THE ARCHITECTURAL AND STRUCTURAL PLANS FOR THE DETAILS OF THIS ELEVATED LANDING AREA WITH STEPS AND A HANDRAIL.

FBO
FF= 637.00

HANGAR II
FF= 636.75

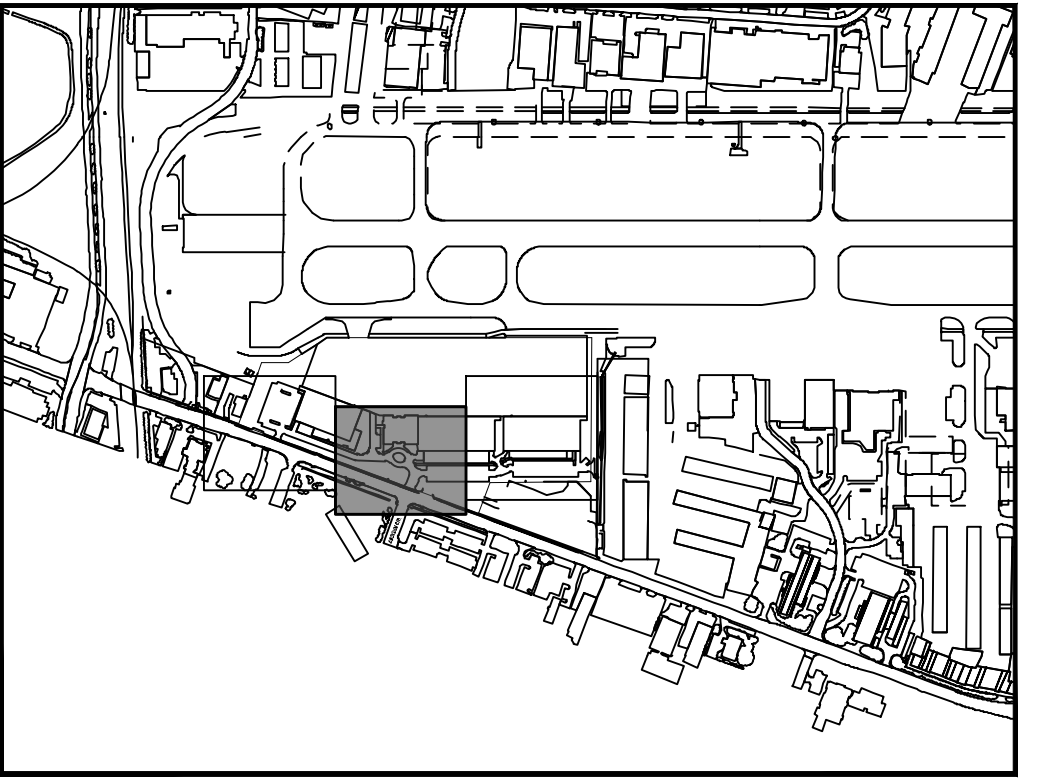

KEY PLAN

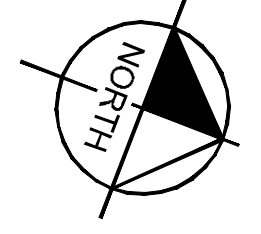


MATCHLINE SEE SHEET C09.03

MATCHLINE SEE SHEET C09.01

- NOTES**
1. ALL SIDEWALKS AND ACCESSIBLE ROUTES, INCLUDING DRIVEWAY CROSSWALKS, SHALL CONFORM TO ALL APPLICABLE AMERICANS WITH DISABILITIES ACT STANDARDS AND THE TEXAS ACCESSIBILITY STANDARDS. IF ANY DISCREPANCY IS DISCOVERED, THE CONTRACTOR SHALL NOTIFY THE ENGINEER PRIOR TO POURING ANY PAVEMENT.
 2. ALL SIDEWALKS AND ACCESSIBLE ROUTES SHALL NOT EXCEED A RUNNING SLOPE OF 5% (1:20) WITHOUT A RAMP, AND SHALL NOT EXCEED A 2% GROSS SLOPE (1:50).
 3. THE ACCESSIBLE PARKING AND PASSENGER LOADING AREAS SHALL NOT EXCEED A SLOPE OF 2% (1:50) IN ANY DIRECTION.

- LEGEND**
- ME MATCH EXISTING ELEVATION
 - TS TOP OF SIDEWALK ELEVATION
 - NG NATURAL GROUND ELEVATION
 - TP TOP OF PAVEMENT ELEVATION
 - TC TOP OF CURB ELEVATION
 - - - HIGH POINT
 - STORM SEWER INLETS


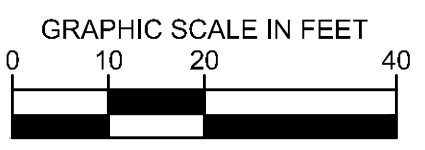


KHA PROJECT 067792503	DATE 2/21/2020	DESIGNED BY AS SHOWN	DRAWN BY EC EAC	CHECKED BY HCV	DATE 04/30/20	BY
<p>ADDISON GALAXY FBO 15601 ADDISON RD. PREPARED FOR BLACK FOREST VENTURE</p>						
<p>LANDSIDE PAVEMENT ELEVATION PLAN</p>						
<p>ADDISON DALLAS, TEXAS</p>						
<p>SHEET NUMBER C09.02</p>						


Kimley»Horn

© 2019 KIMLEY-HORN AND ASSOCIATES, INC.
 1400 WOODLICK FOREST DRIVE, SUITE 225
 HOUSTON, TEXAS 77057
 PHONE: 281-475-2816
 TBE FIRM REGISTRATION F-928
 WWW.KIMLEY-HORN.COM

Plotted By: Acevedo, Elsieh Sheet: Set: KHA Layout: C09.03 April 30, 2020 08:09:09am K:\VDC\A\action_067792503 - Addison Galaxy FBO\ACAD\Drawings\Sheets\C09.00 LANDSIDE PAVT ELEVATION PLAN.dwg
 This document, together with the concepts and designs presented herein, is an instrument of service, as an instrument of service, in that it was prepared, revised, or amended in whole or in part, for the specific purpose and client for which it was prepared. Reuse of any information contained herein without written authorization and adaptation by Kimley-Horn and Associates, Inc. shall be without liability to Kimley-Horn and Associates, Inc.

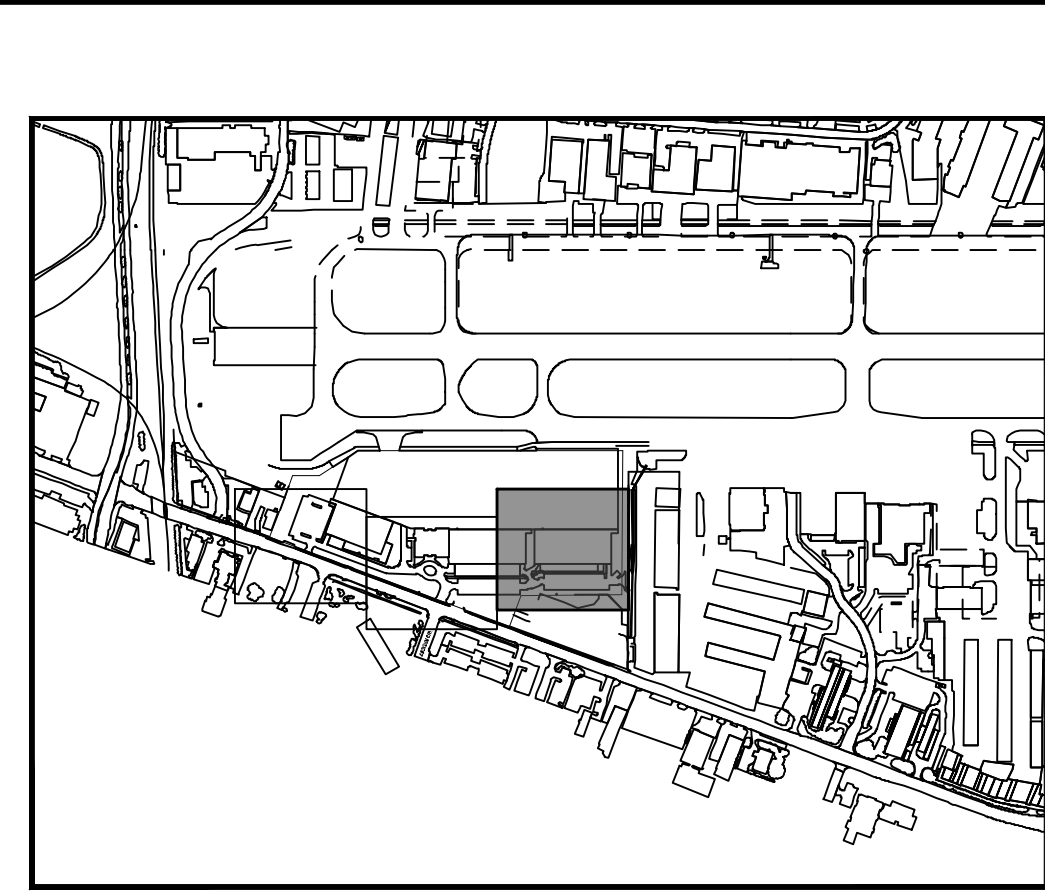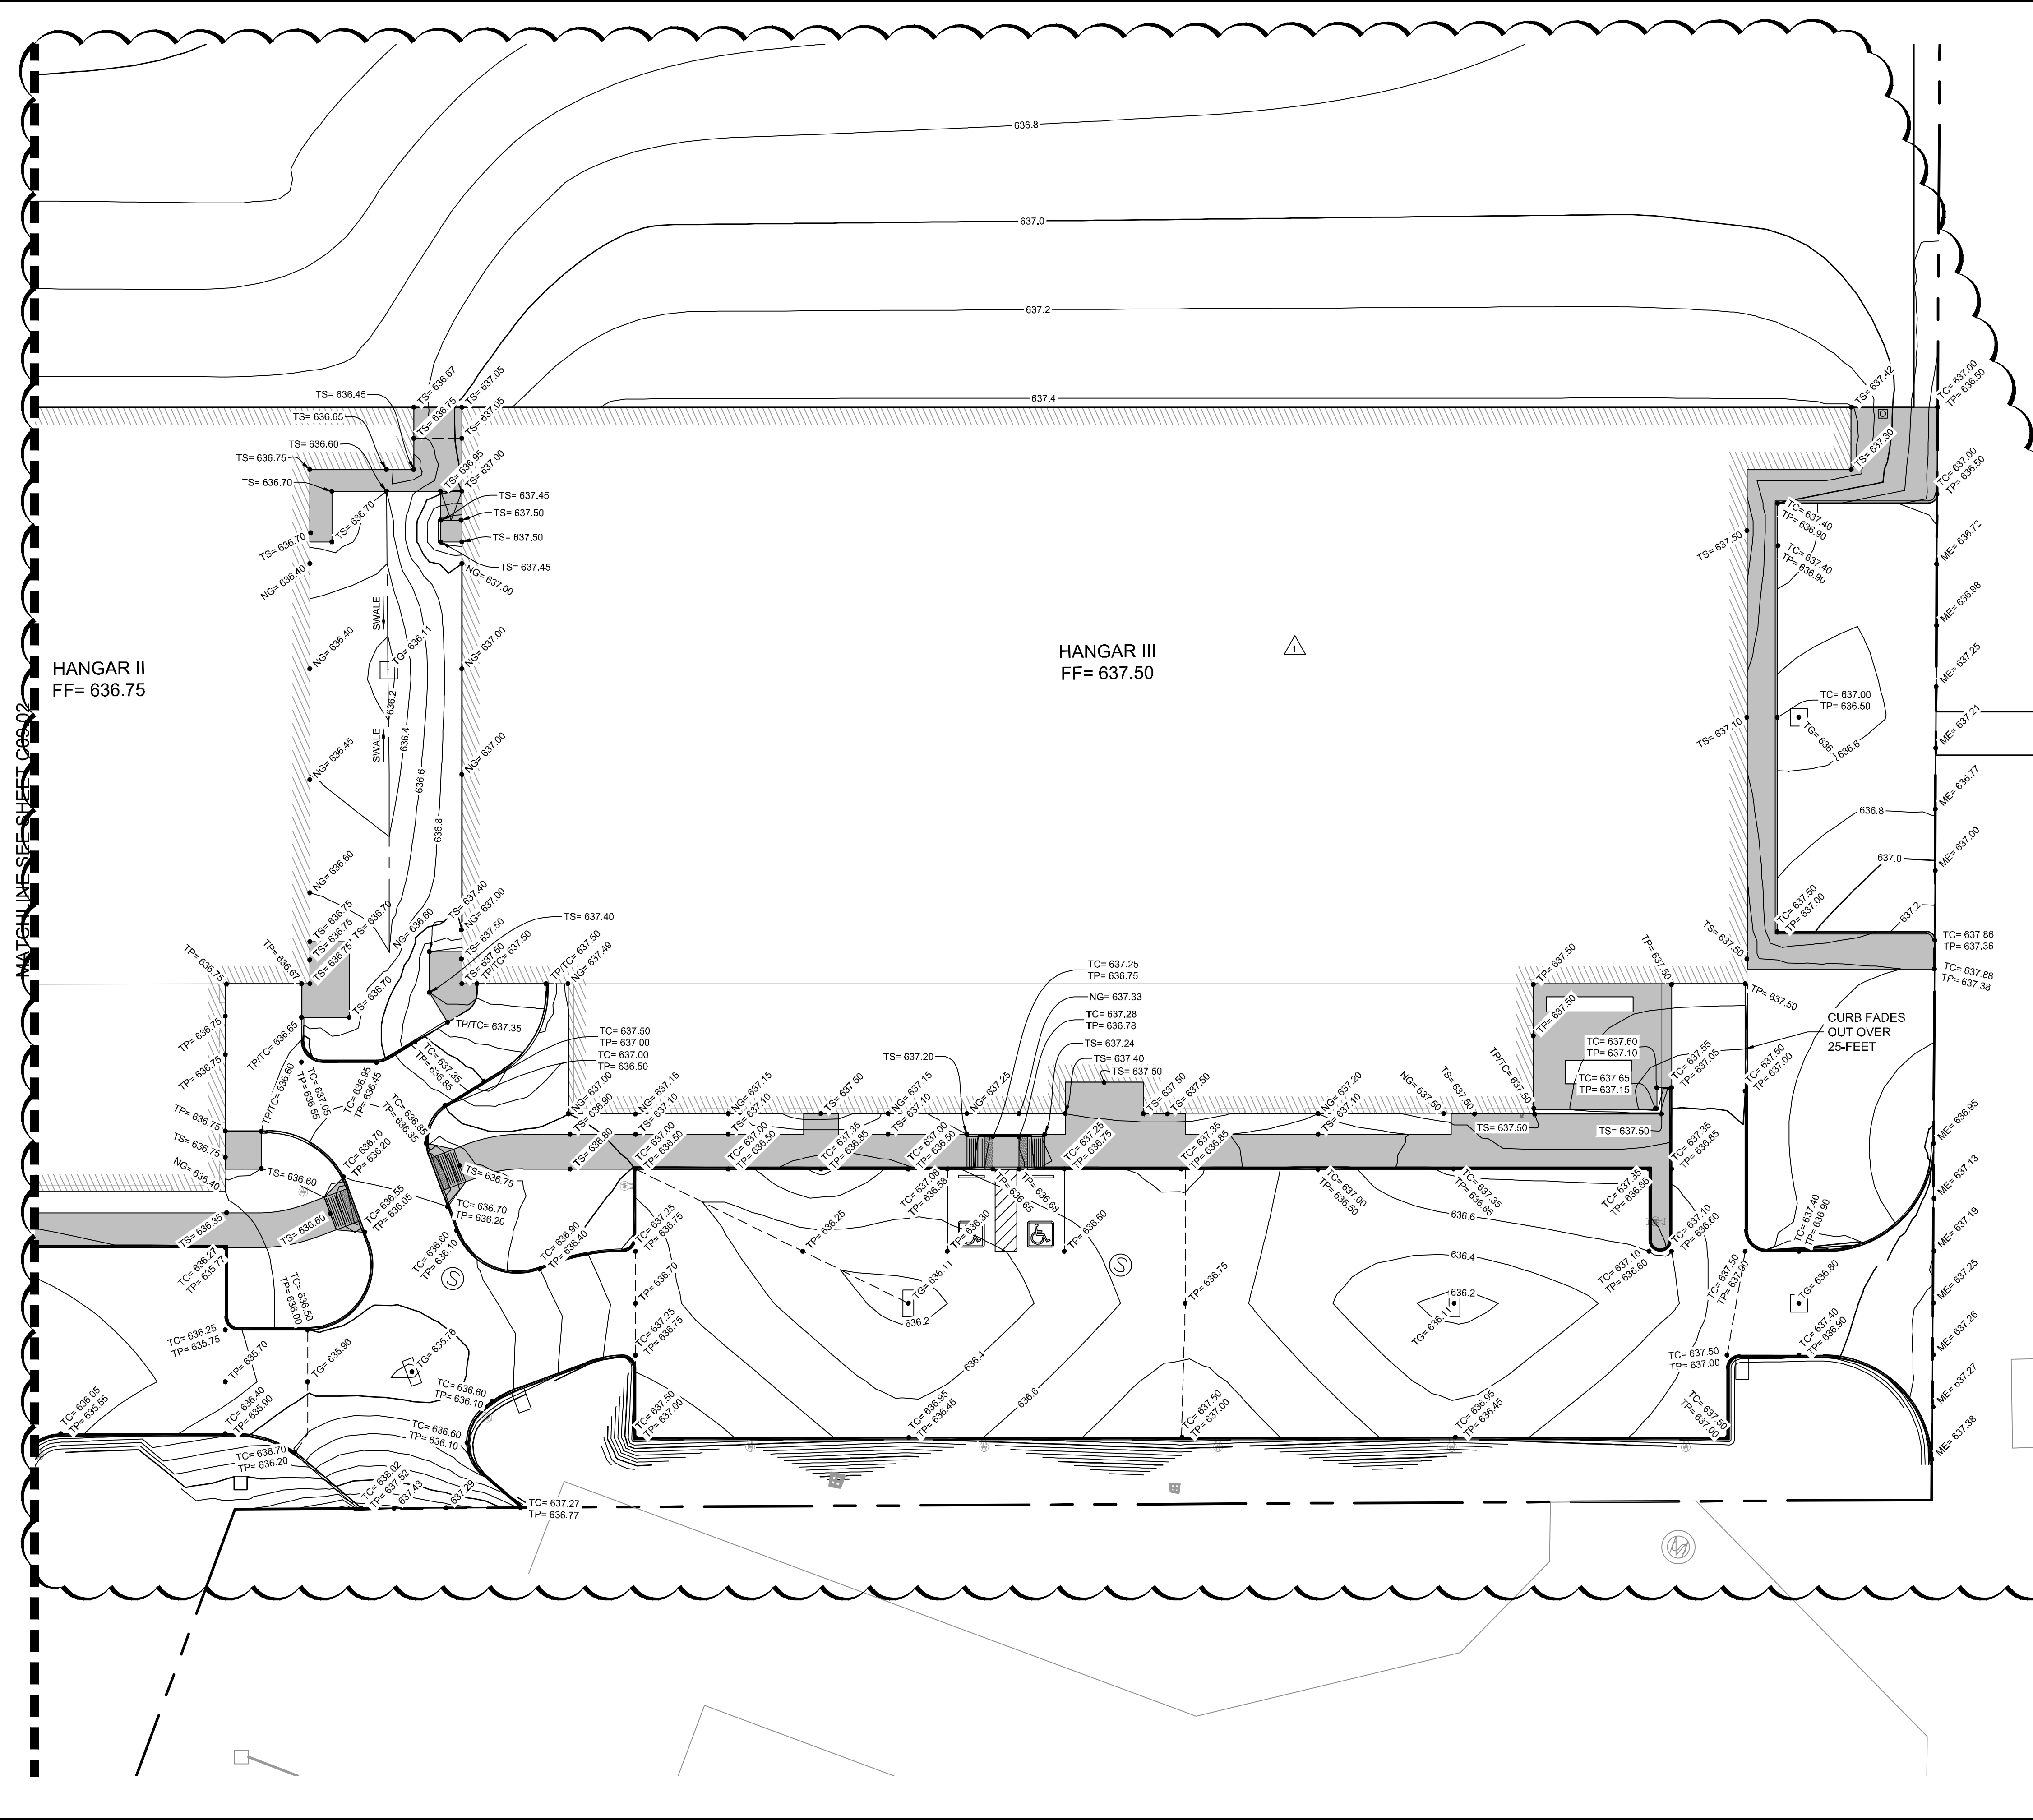

KEY PLAN

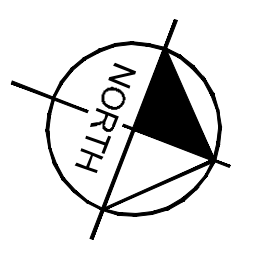


NOTES

1. ALL SIDEWALKS AND ACCESSIBLE ROUTES, INCLUDING DRIVEWAY CROSSWALKS, SHALL CONFORM TO ALL APPLICABLE AMERICANS WITH DISABILITIES ACT STANDARDS AND THE TEXAS ACCESSIBILITY STANDARDS. IF ANY DISCREPANCY IS DISCOVERED, THE CONTRACTOR SHALL NOTIFY THE ENGINEER PRIOR TO POURING ANY PAVEMENT.
2. ALL SIDEWALKS AND ACCESSIBLE ROUTES SHALL NOT EXCEED A RUNNING SLOPE OF 5% (1:20) WITHOUT A RAMP, AND SHALL NOT EXCEED A 2% CROSS SLOPE (1:50).
3. THE ACCESSIBLE PARKING AND PASSENGER LOADING AREAS SHALL NOT EXCEED A SLOPE OF 2% (1:50) IN ANY DIRECTION.

LEGEND


- ME MATCH EXISTING ELEVATION
- TP TOP OF PAVEMENT ELEVATION
- TC TOP OF CURB ELEVATION
- HIGH POINT
- STORM SEWER INLETS

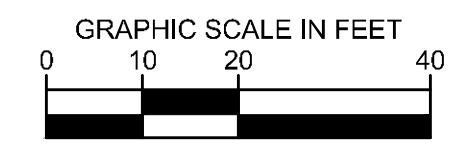

	© 2019 KIMLEY-HORN AND ASSOCIATES, INC. 1400 WOODLICK FOREST DRIVE, SUITE 225 HOUSTON, TEXAS 77057 PHONE: 281-475-2816 TBP# FIRM REGISTRATION F-928 WWW.KIMLEY-HORN.COM
	04/30/20
KHA PROJECT 067792503	DATE 2/21/2020
SCALE AS SHOWN	DESIGNED BY HCV
DRAWN BY EC EAC	CHECKED BY HCV
ADDISON GALAXY FBO 15601 ADDISON RD. PREPARED FOR BLACK FOREST VENTURE	DALLAS, TEXAS
SHEET NUMBER C09.03	REVISIONS No. DATE BY


Plotted By: Acevedo, Elsie. Sheet: Set: Kha. Layout: C10.02. April 30, 2020. 08:20:52am. K:\WDL-Aviation\067792503 - Addison Galaxy FBO\ACAD.dwg. Sheets\C10.00 GRADING PLAN.dwg. This document, together with the concepts and designs presented herein, is intended only for the specific purpose and client for which it was prepared. Reuse of and improper reliance on this document without written authorization and adaptation by Kimley-Horn and Associates, Inc. shall be without liability to Kimley-Horn and Associates, Inc.

MATCHLINE SEE SHEET C10.01

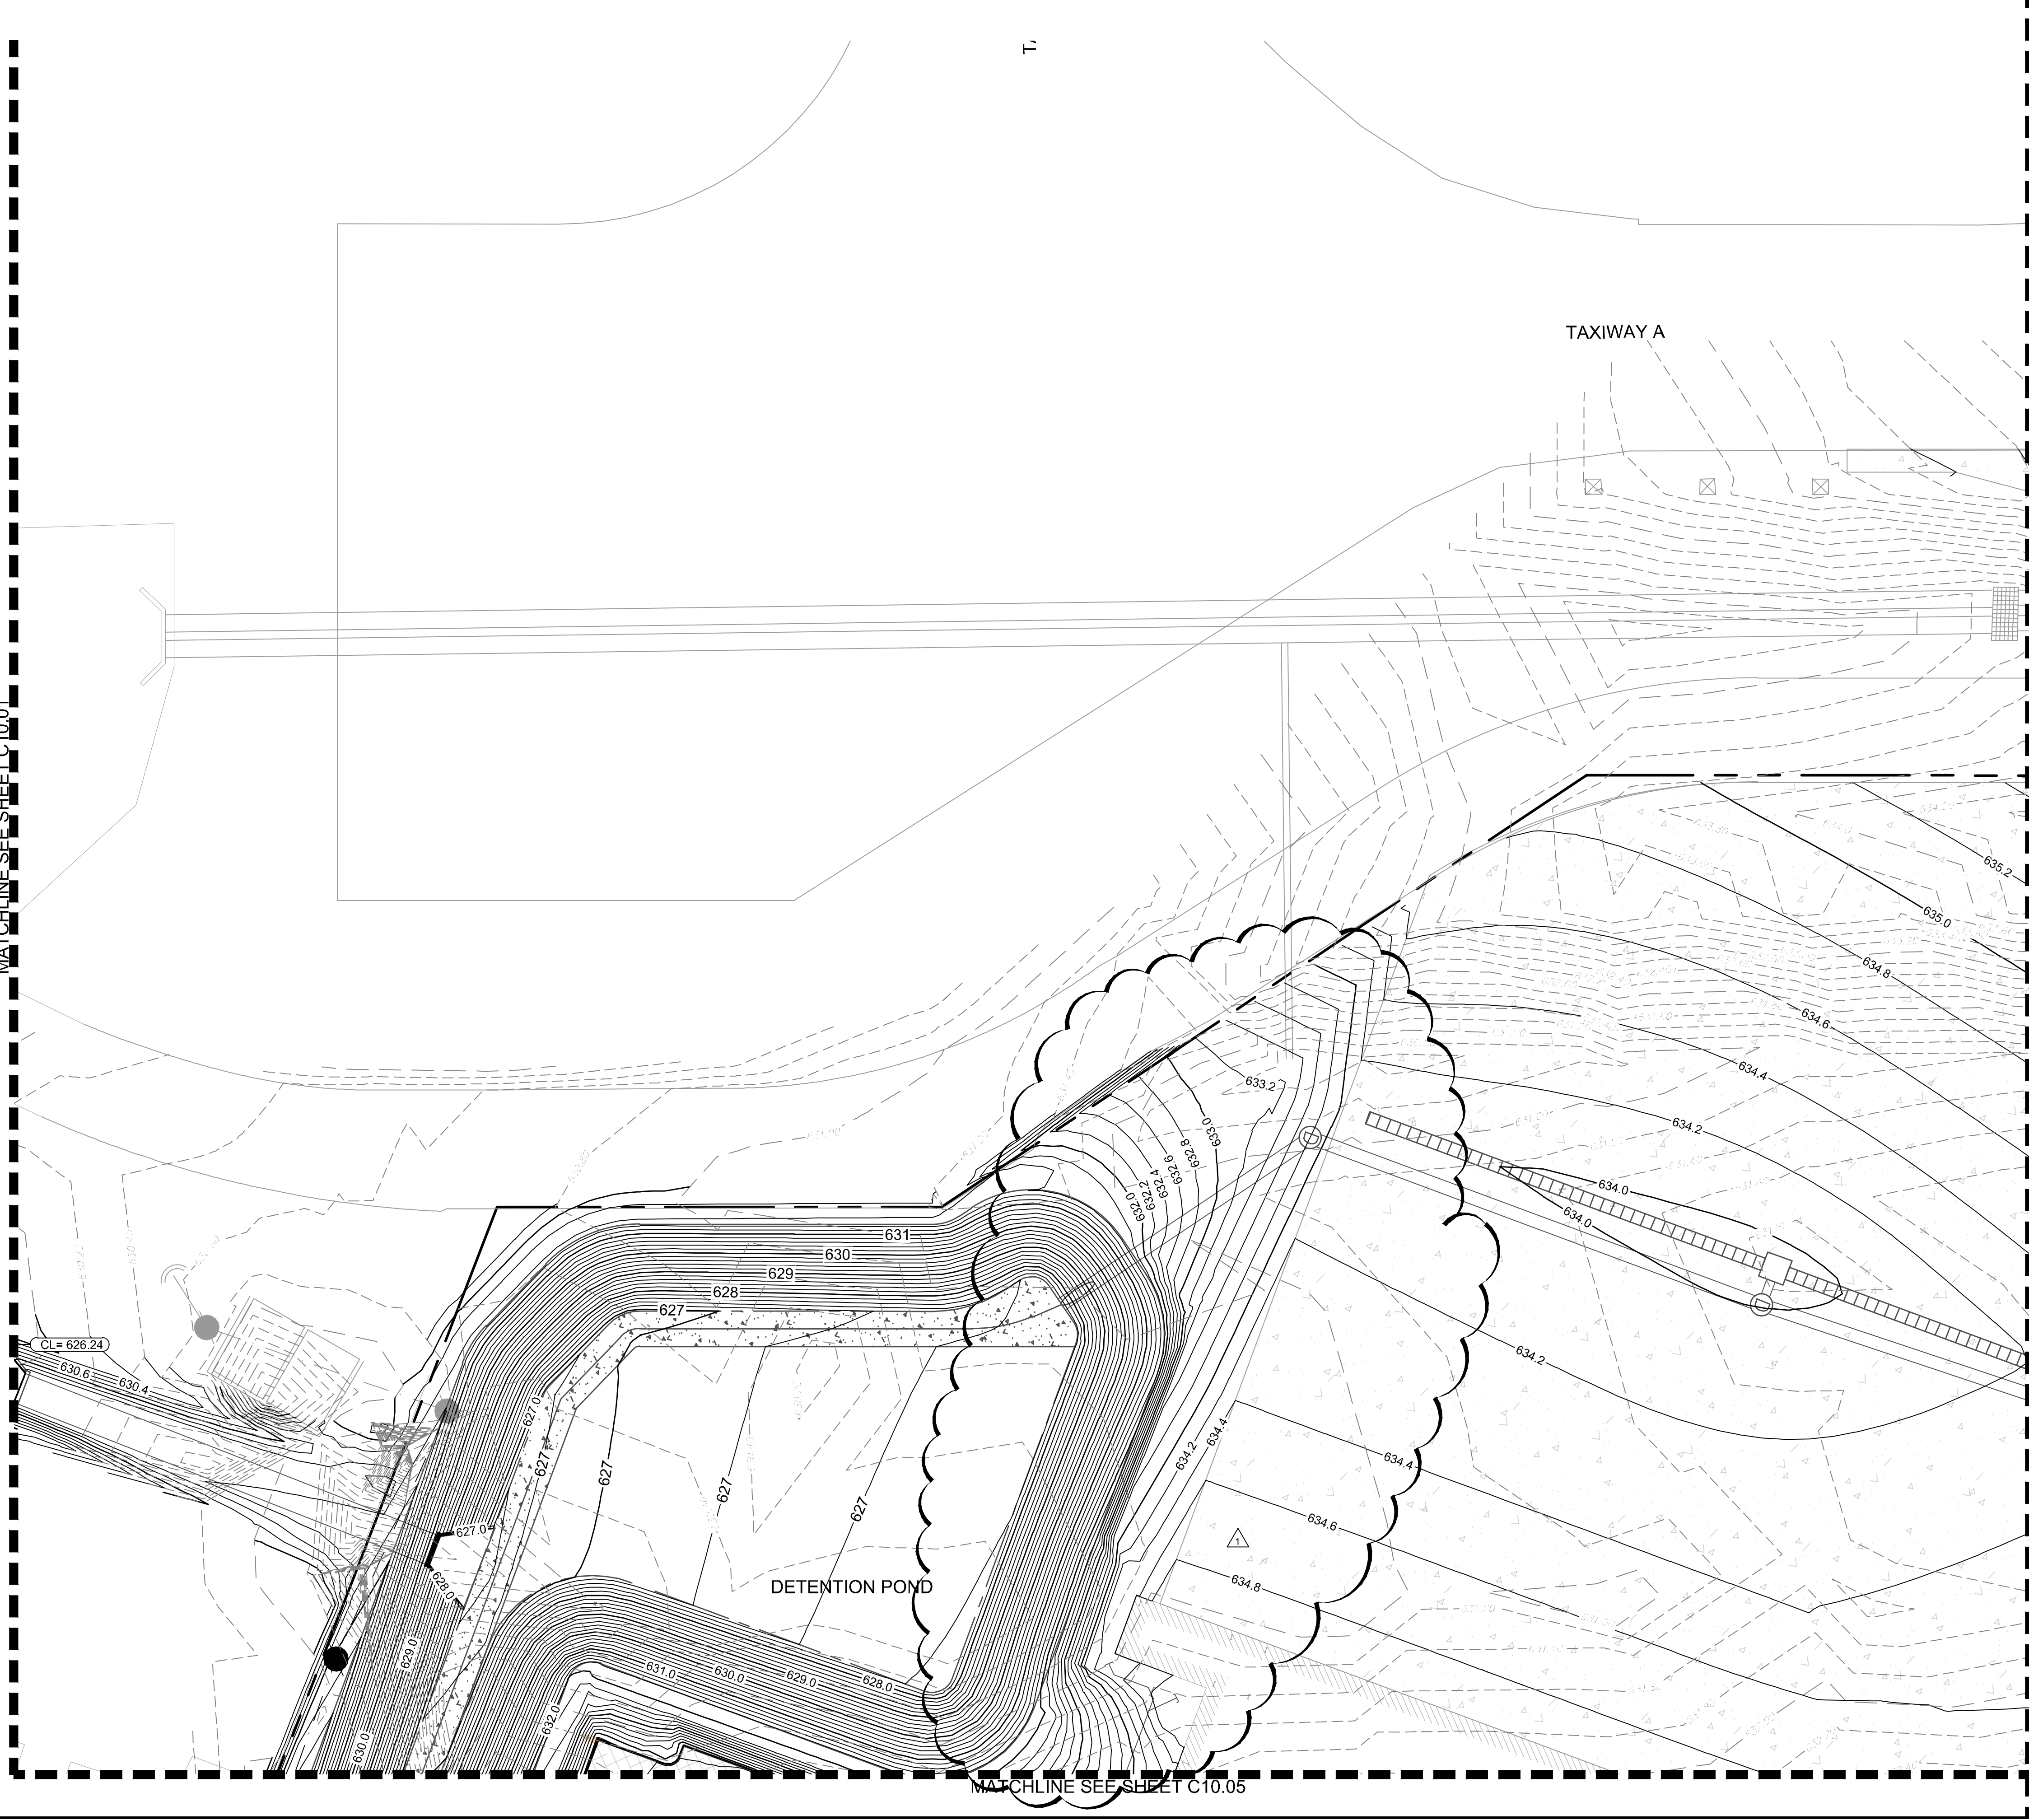


MATCHLINE SEE SHEET C10.05

MATCHLINE SEE SHEET C10.03

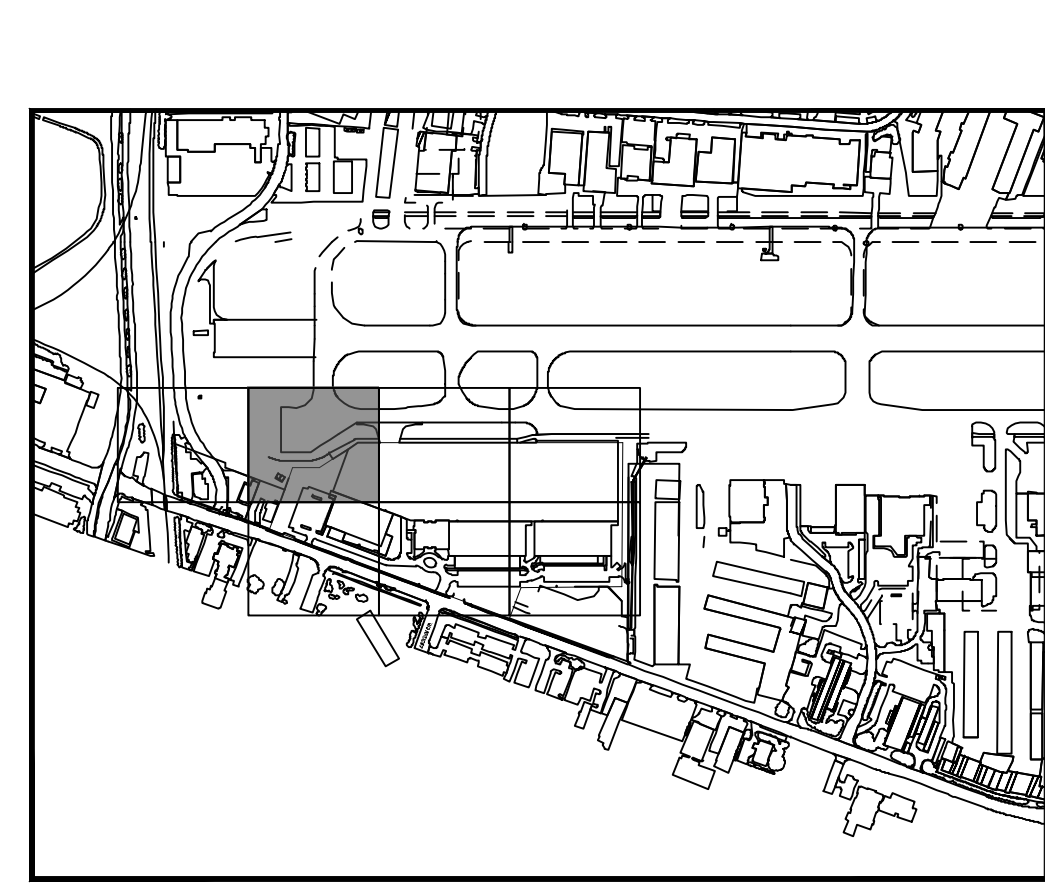


KEY PLAN

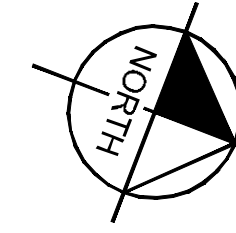


LEGEND

- 629.20 EXISTING CONTOURS
- 636.20 PROPOSED CONTOURS
- TRENCH DRAIN
- DRAINAGE INLET
- DRAINAGE MANHOLE

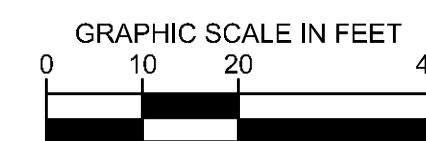

No.	REVISIONS	DATE	BY
1	ASB-C003	04/30/2020	JM

Kimley»Horn
 © 2019 KIMLEY-HORN AND ASSOCIATES, INC.
 1400 WOODLICK FOREST DRIVE, SUITE 225
 DALLAS, TEXAS 75244
 PHONE: 281-475-2816
 TBP# FIRM REGISTRATION F-928
 WWW.KIMLEY-HORN.COM

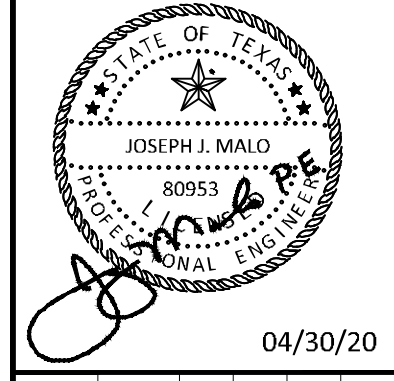

KHA PROJECT	067792503
DATE	2/21/2020
SCALE	AS SHOWN
DESIGNED BY	HCV
DRAWN BY	EC EAC
CHECKED BY	HCV



GRADING PLAN

ADDISON GALAXY FBO
 15601 ADDISON RD.
 PREPARED FOR
 BLACK FOREST VENTURE


ADDISON DALLAS, TEXAS

SHEET NUMBER
C10.02

Plotted By: Acevedo, Eileth Sheet: Set-Kha Layout: C10.05 April 30, 2020 08:25:03am K:\WDL_Aviation\067792503 - Addison Galaxy FBO\CAD\dwg\Sheets\C10.00 GRADING PLAN.dwg
This document, together with the concepts and designs presented herein, is an instrument of service, as an instrument of service, in and to the extent authorized and approved by Kimley-Horn and Associates, Inc. shall be without liability to Kimley-Horn and Associates, Inc.

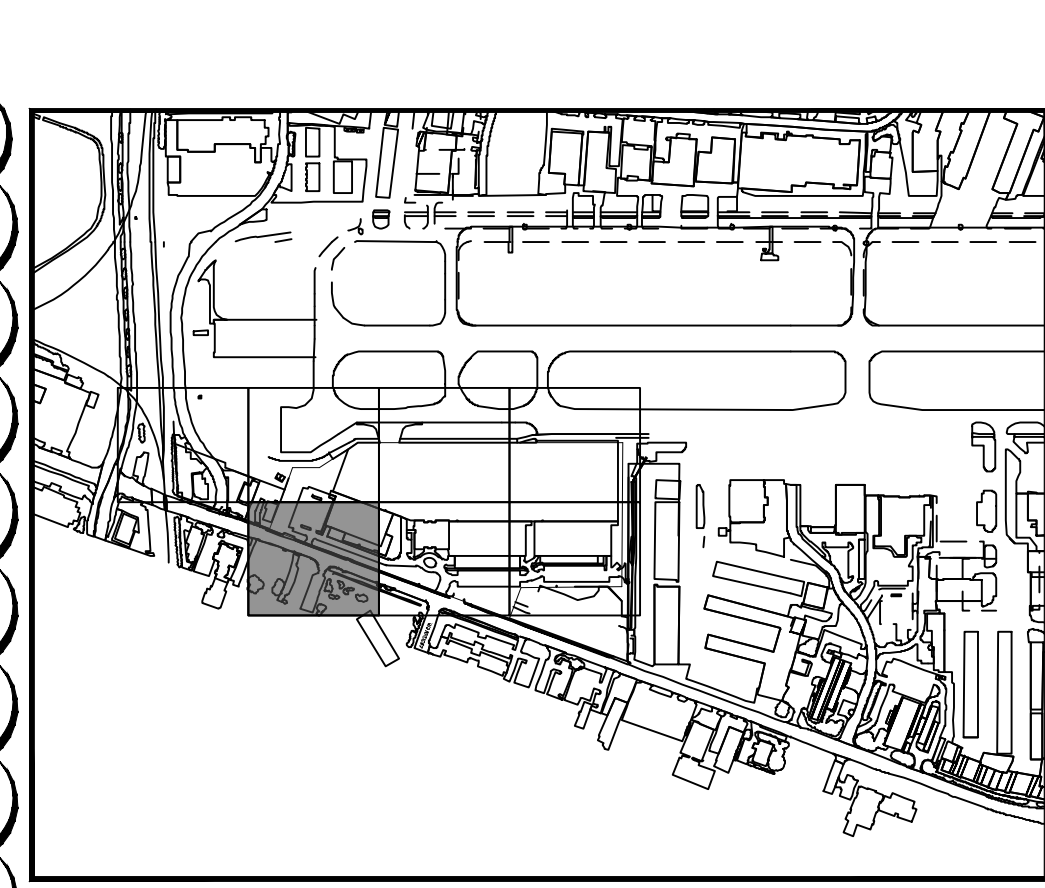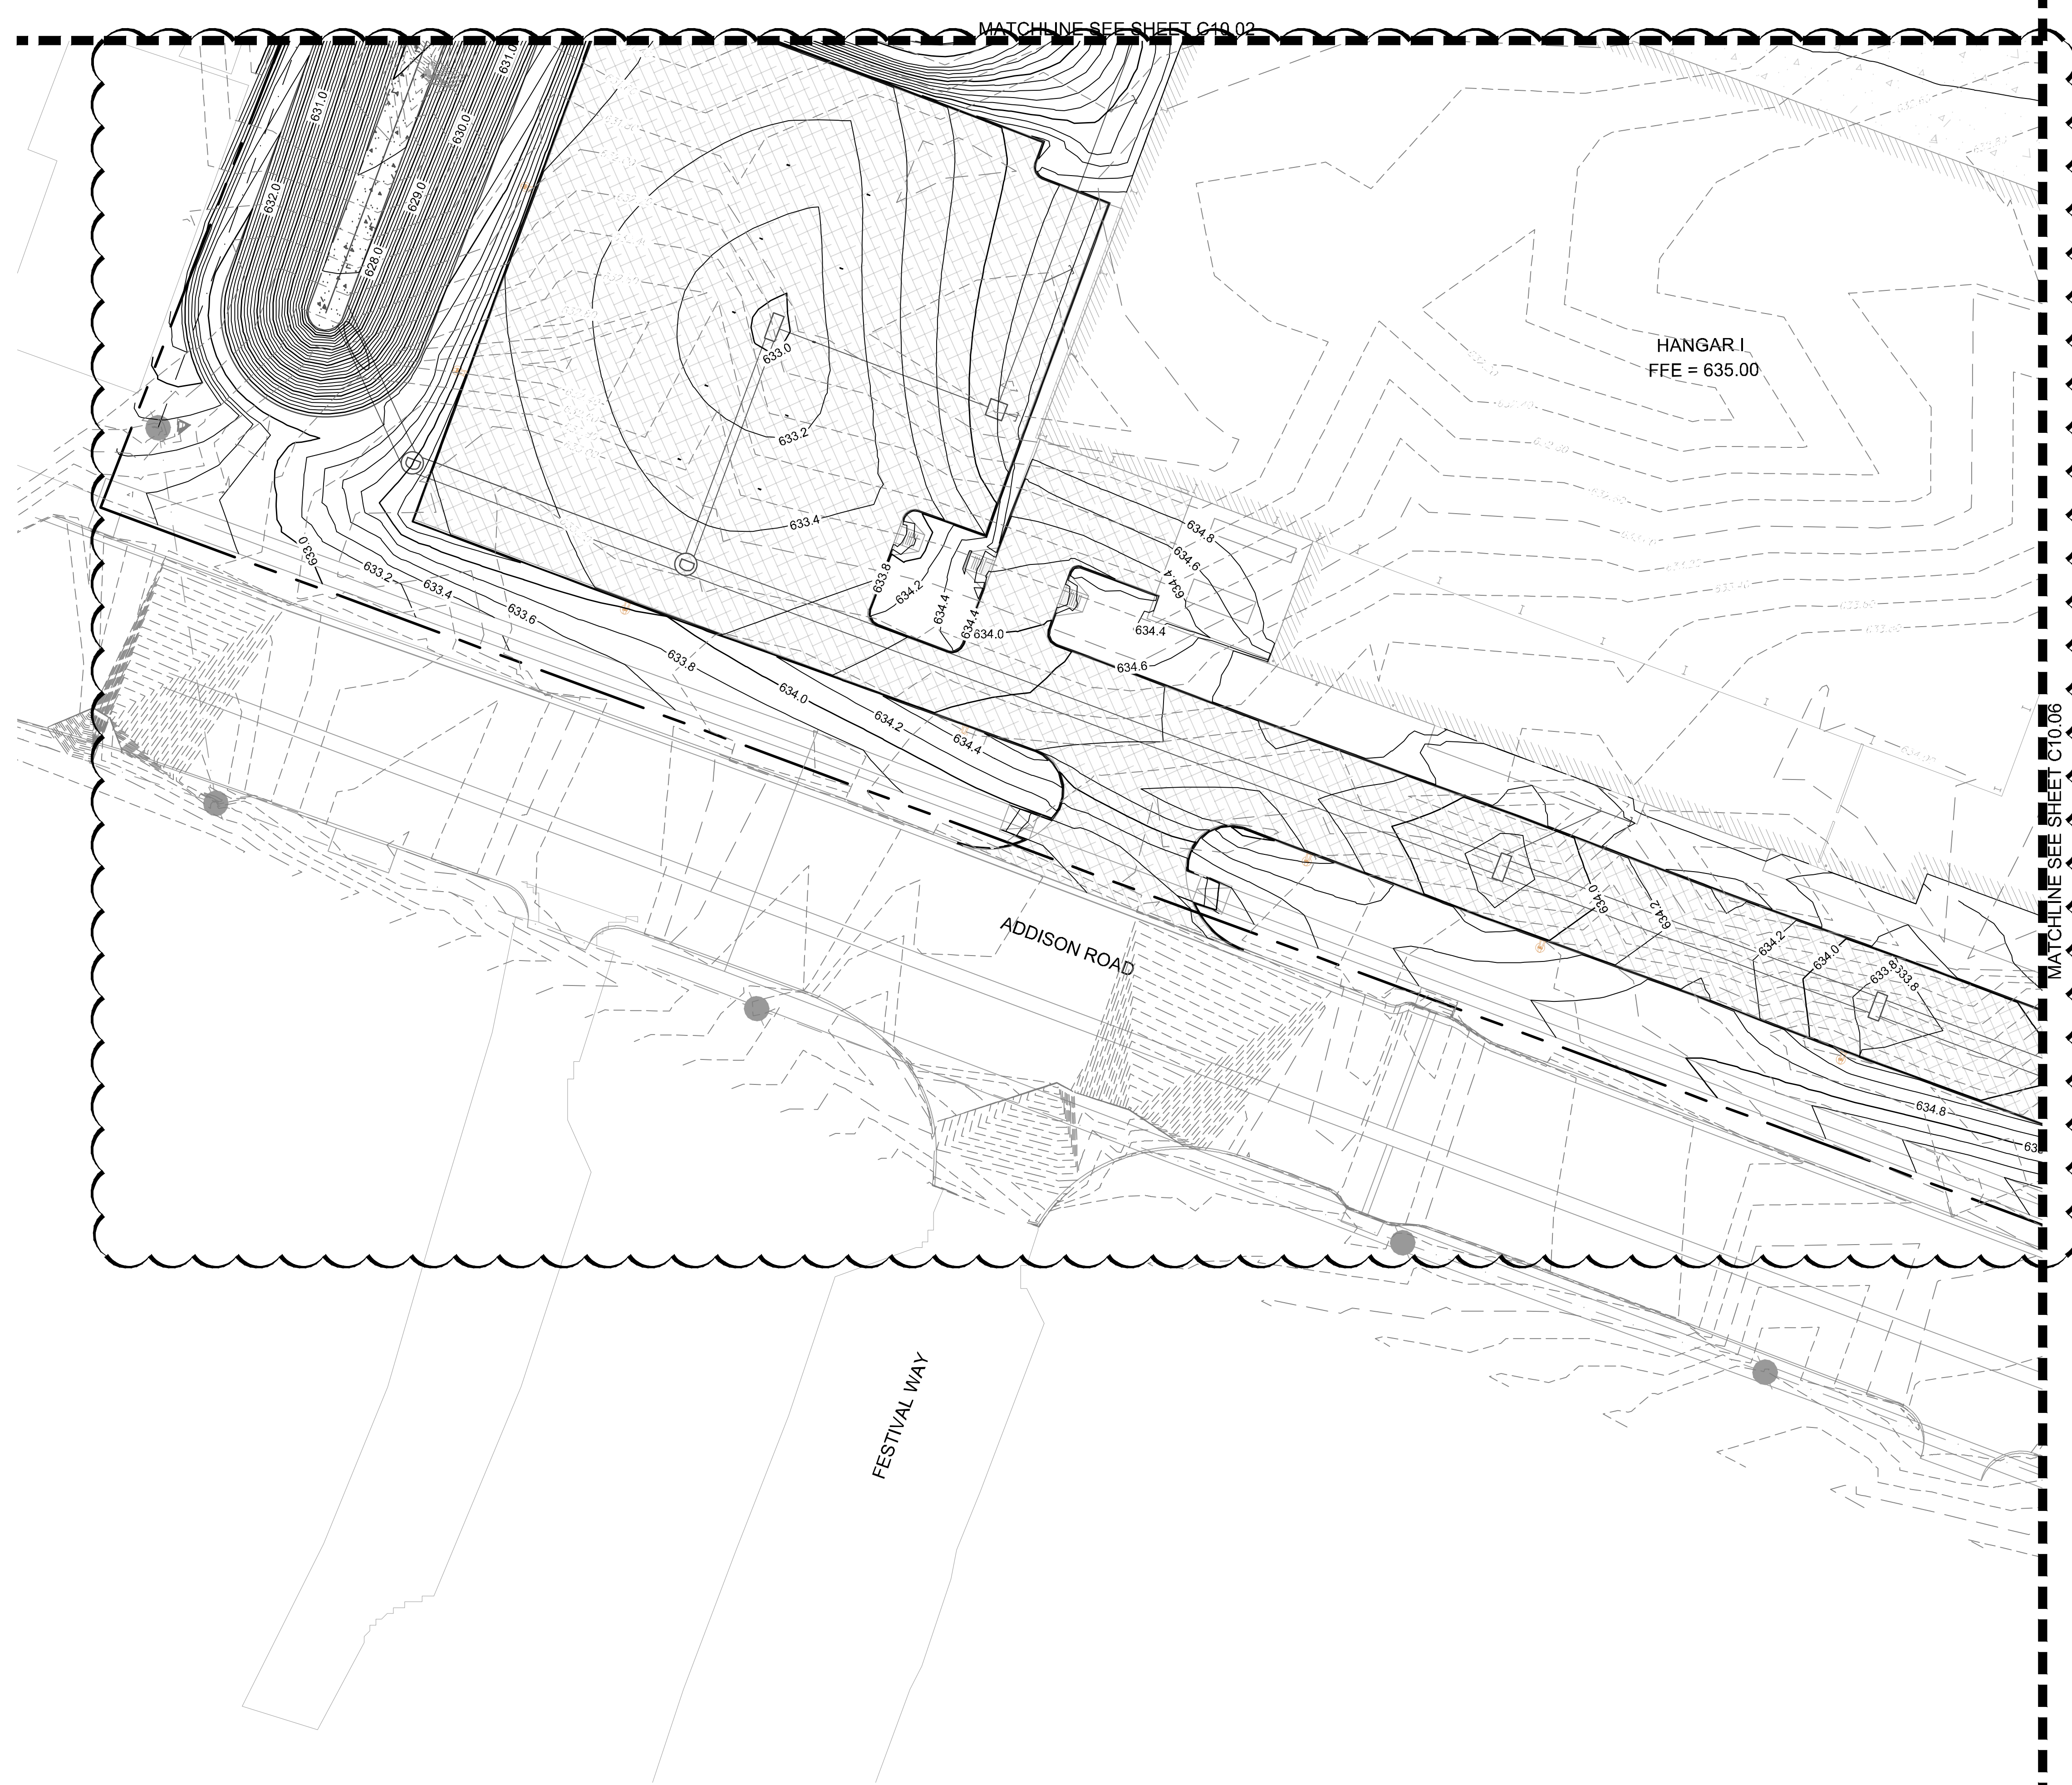


KEY PLAN

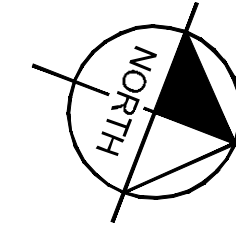


LEGEND

- EXISTING CONTOURS
- PROPOSED CONTOURS
- TRENCH DRAIN
- DRAINAGE INLET
- DRAINAGE MANHOLE

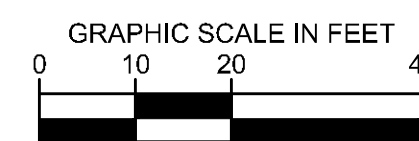

No.	REVISIONS	DATE	BY
1			

Kimley»Horn
© 2019 KIMLEY-HORN AND ASSOCIATES, INC.
1400 WOODLACK FOREST DRIVE, SUITE 225
DALLAS, TEXAS 75243
PHONE: 214-475-2816
TBPE FIRM REGISTRATION F-928
WWW.KIMLEY-HORN.COM

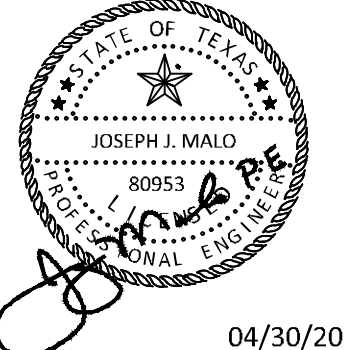



KHA PROJECT	067792503
DATE	2/21/2020
SCALE	AS SHOWN
DESIGNED BY	HCV
DRAWN BY	EC EAC
CHECKED BY	HCV

GRADING PLAN


ADDISON GALAXY FBO
15601 ADDISON RD.
PREPARED FOR
BLACK FOREST VENTURE
DALLAS, TEXAS

SHEET NUMBER
C10.05

Plotted By: Acevedo, Elsieh Sheet: Set: K10 Layout: C10.06 May 08, 2020 12:58:15pm K:\V\Addison\067792503 - Addison Galaxy FBO\ACAD\Draw\Sheets\C10.00 GRADING PLAN.dwg
 This document, together with the concepts and designs presented herein, is an instrument of service, as an instrument of service, is intended only for the specific purpose and client for which it was prepared. Reuse of and/or improper reliance on this document without written authorization and approval by Kimley-Horn and Associates, Inc. shall be without liability to Kimley-Horn and Associates, Inc.

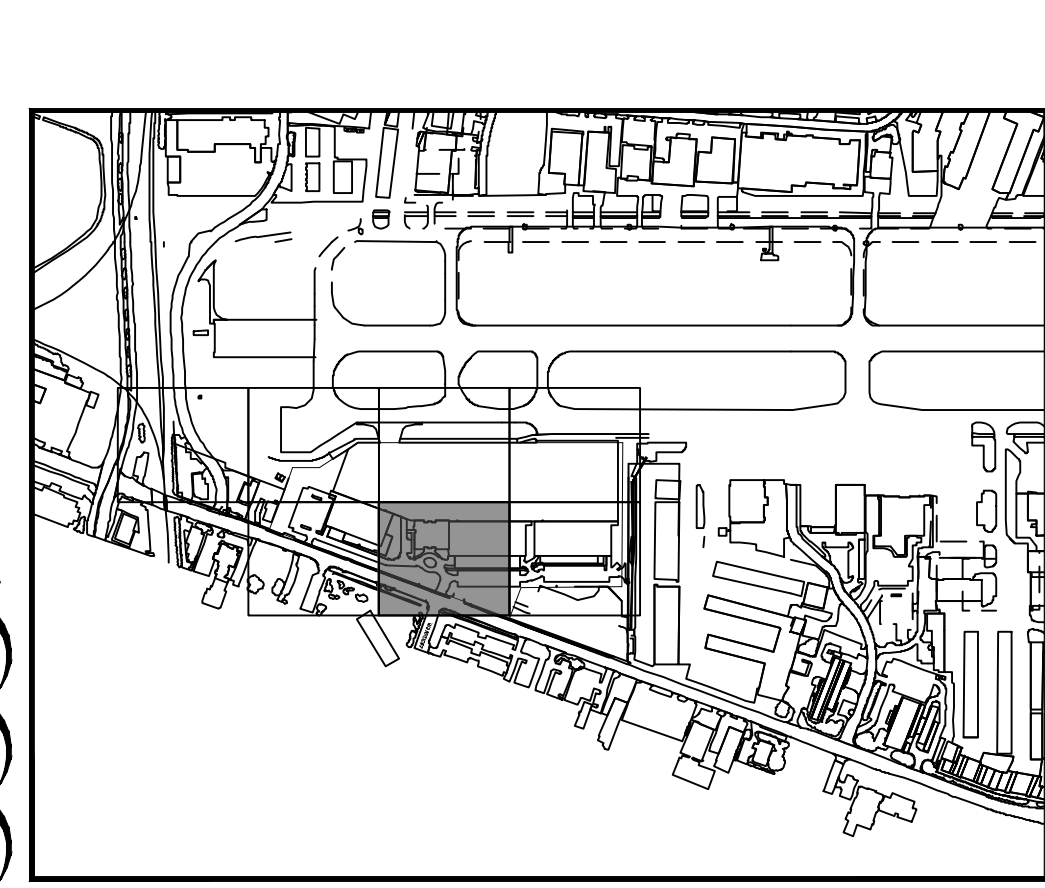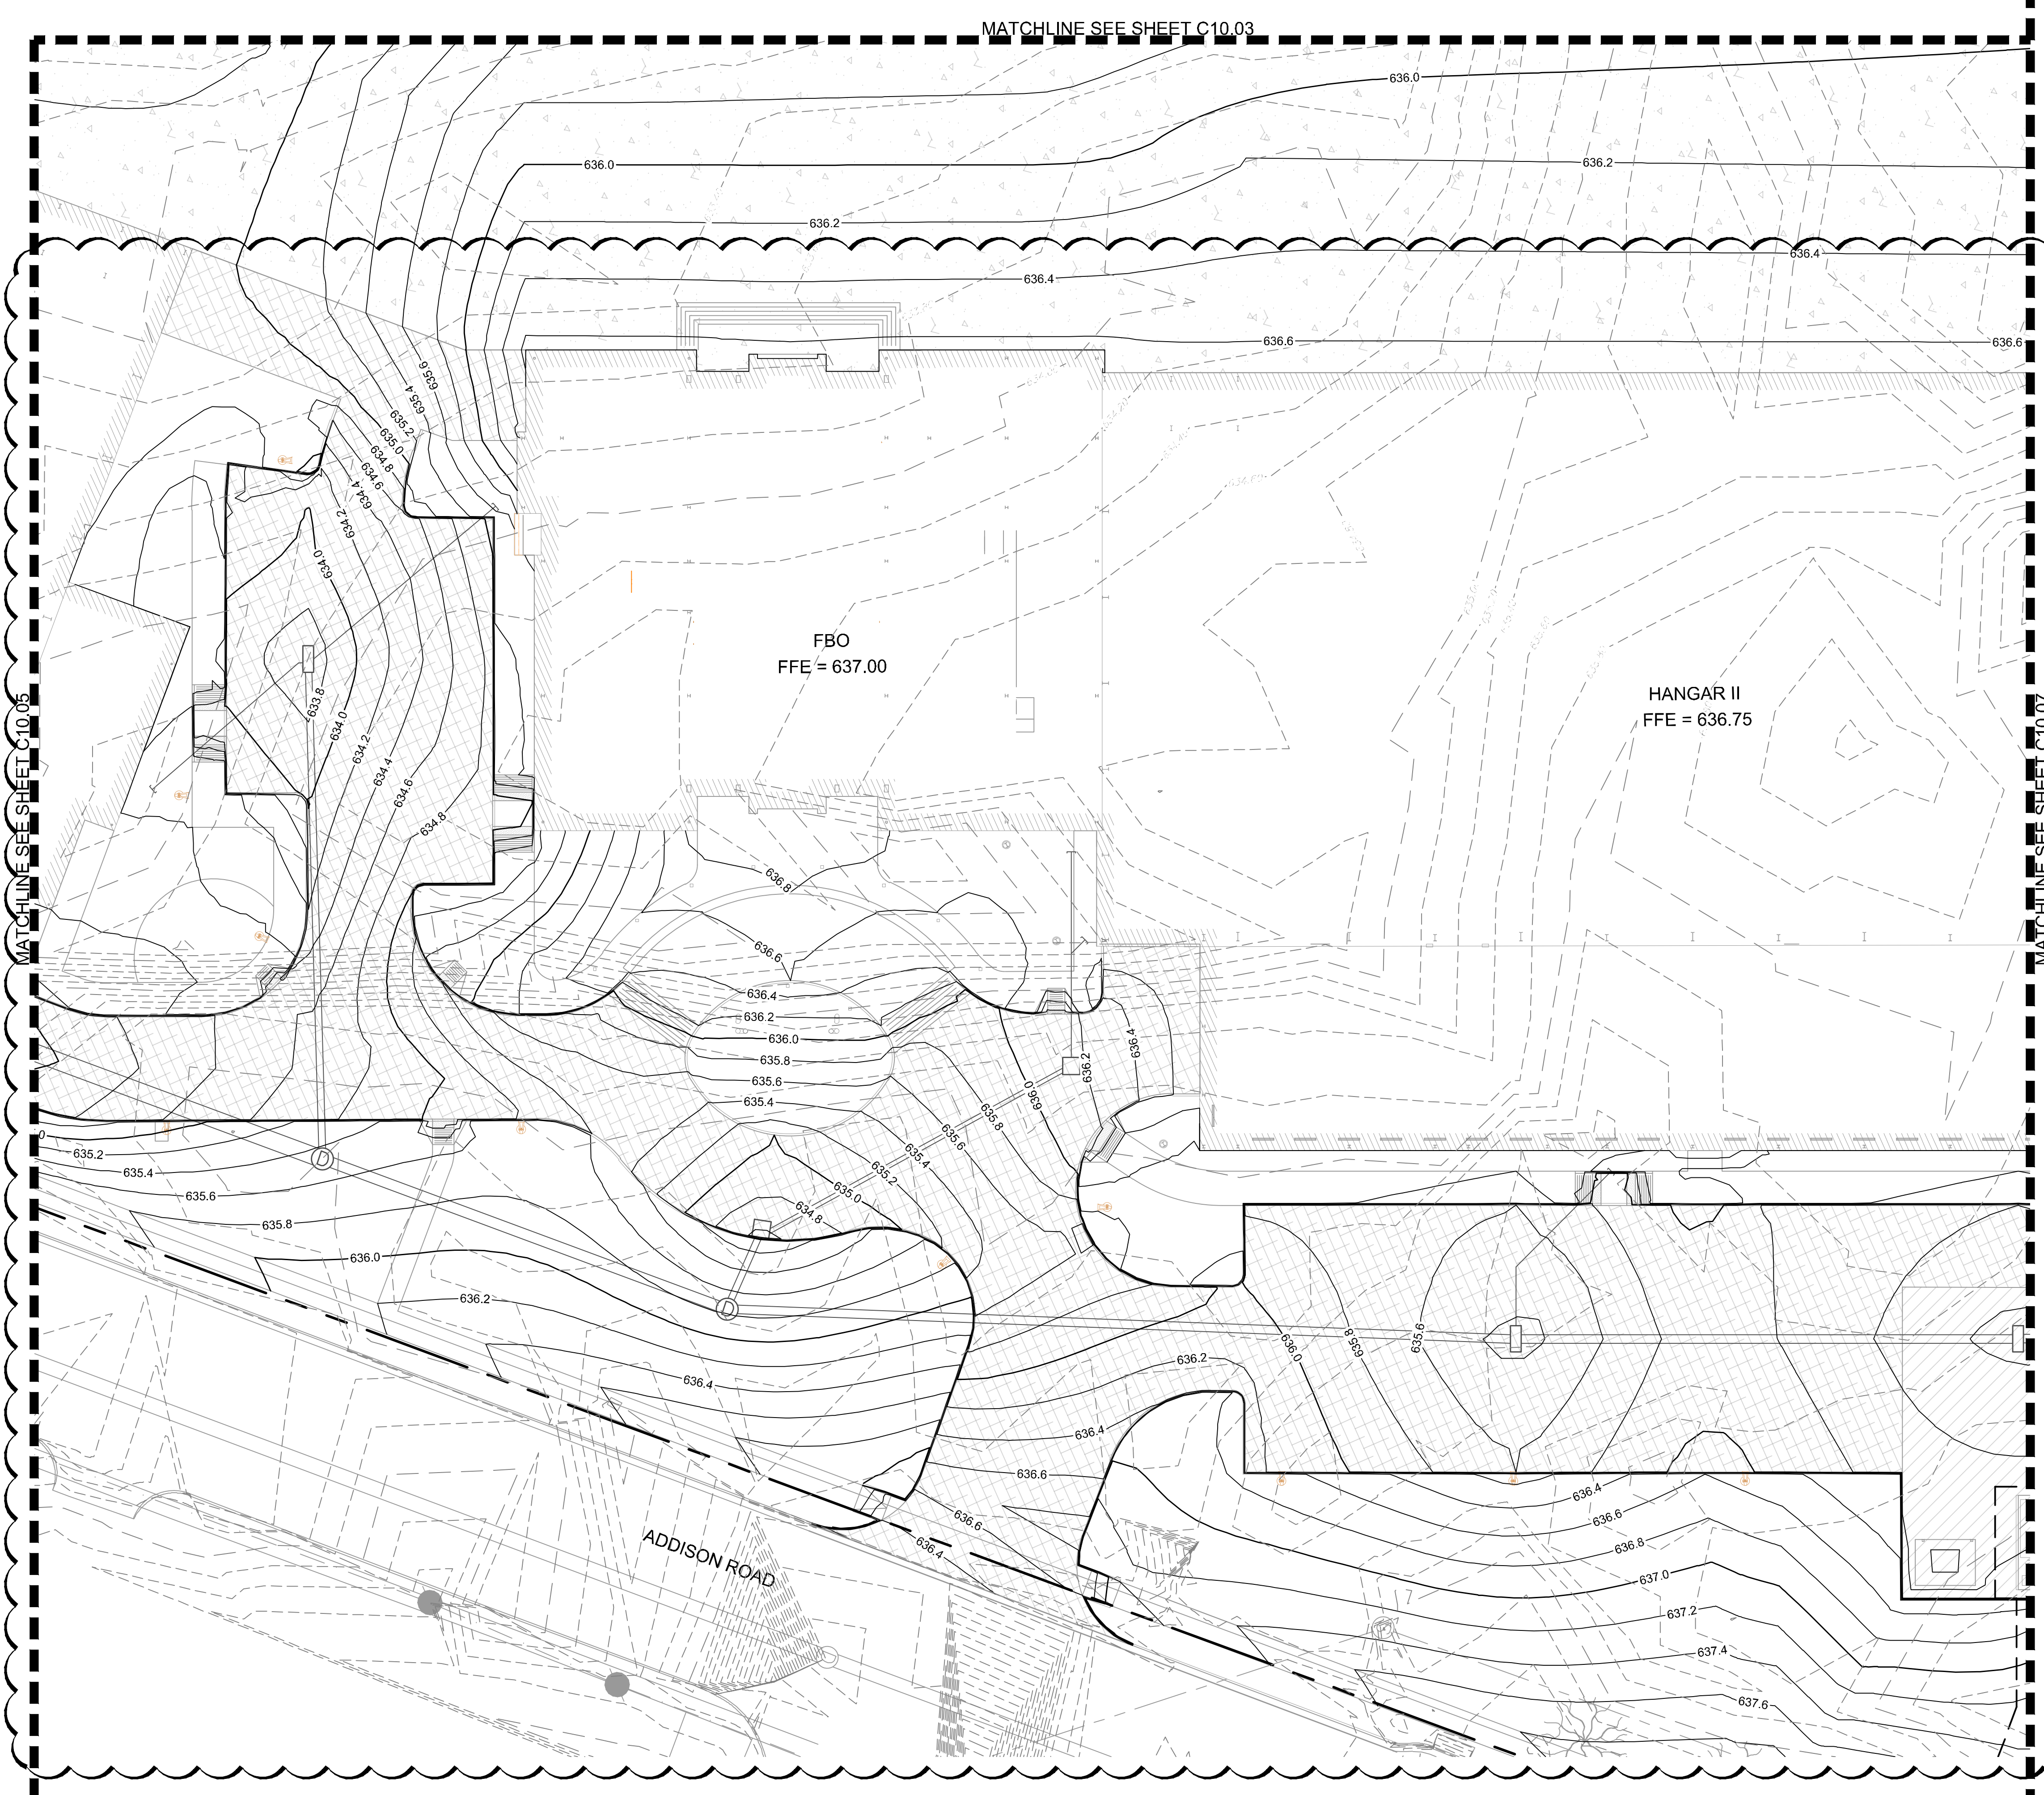


KEY PLAN

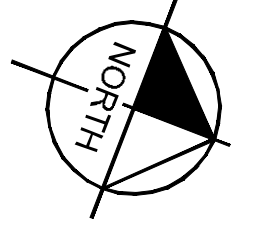

△

LEGEND


- 629.20 EXISTING CONTOURS
- 636.20 PROPOSED CONTOURS
- TRENCH DRAIN
- DRAINAGE INLET
- DRAINAGE MANHOLE

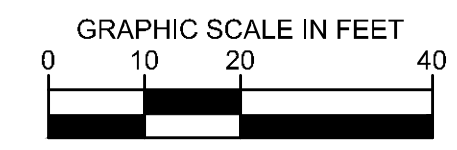

No.	REVISIONS	DATE	BY

Kimley»Horn

© 2019 KIMLEY-HORN AND ASSOCIATES, INC.
 1400 WOODLICK FOREST DRIVE, SUITE 225
 DALLAS, TEXAS 75244
 PHONE: 281-475-2816
 TBP# FIRM REGISTRATION F-928
 WWW.KIMLEY-HORN.COM

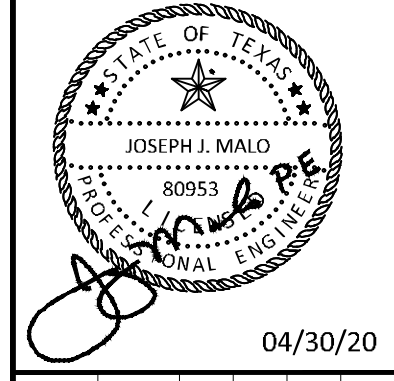

KHA PROJECT	067792503
DATE	2/21/2020
SCALE	AS SHOWN
DESIGNED BY	HCV
DRAWN BY	EC EAC
CHECKED BY	HCV

GRADING PLAN

ADDISON GALAXY FBO
 15601 ADDISON RD.
 PREPARED FOR
 BLACK FOREST VENTURE



DALLAS, TEXAS
 ADDISON

SHEET NUMBER
C10.06


Plotted By: Acevedo, Elsie - Sheet Set: Khs - Layout: C10.07 - April 30, 2020 08:30:42am K:\WDL-Aviation\067792503 - Addison_Galaxy_FBO\CAD\DWG\Sheets\C10.00_GRADING_PLAN.dwg
 This document, together with the concepts and designs presented herein, is an instrument of service, as an instrument of service, and is intended only for the specific purpose and client for which it was prepared. Reuse of any information contained herein without the written authorization and approval by Kimley-Horn and Associates, Inc. shall be without liability to Kimley-Horn and Associates, Inc.

MATCHLINE SEE SHEET C10.06

MATCHLINE SEE SHEET C10.04

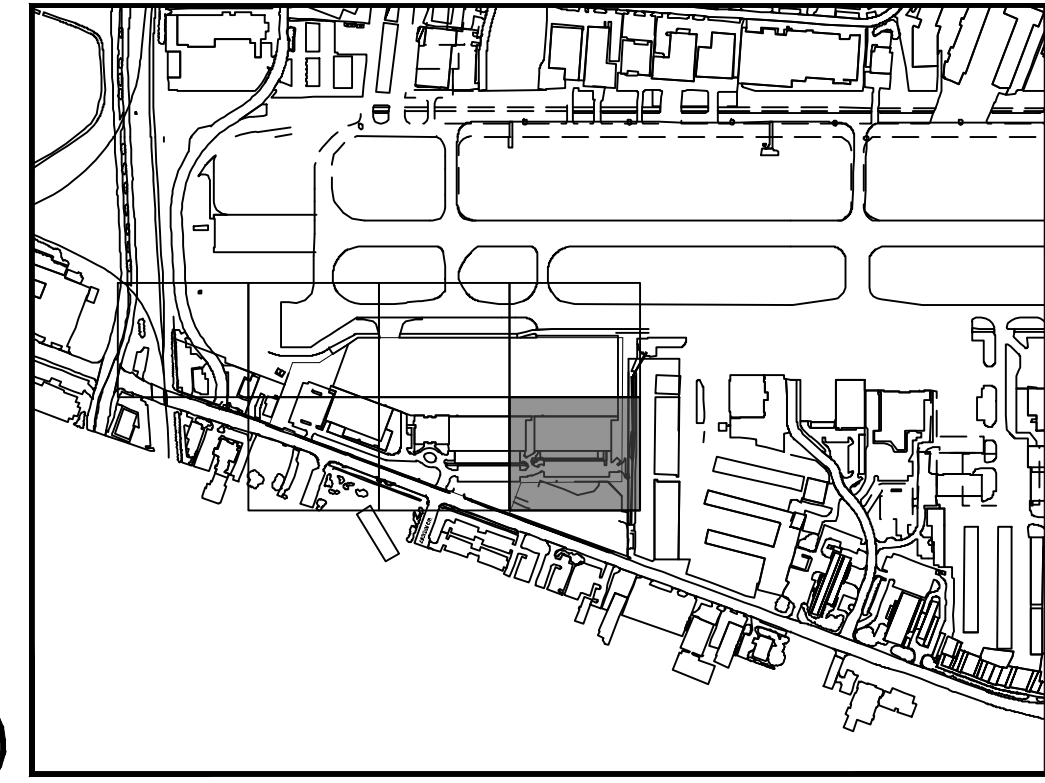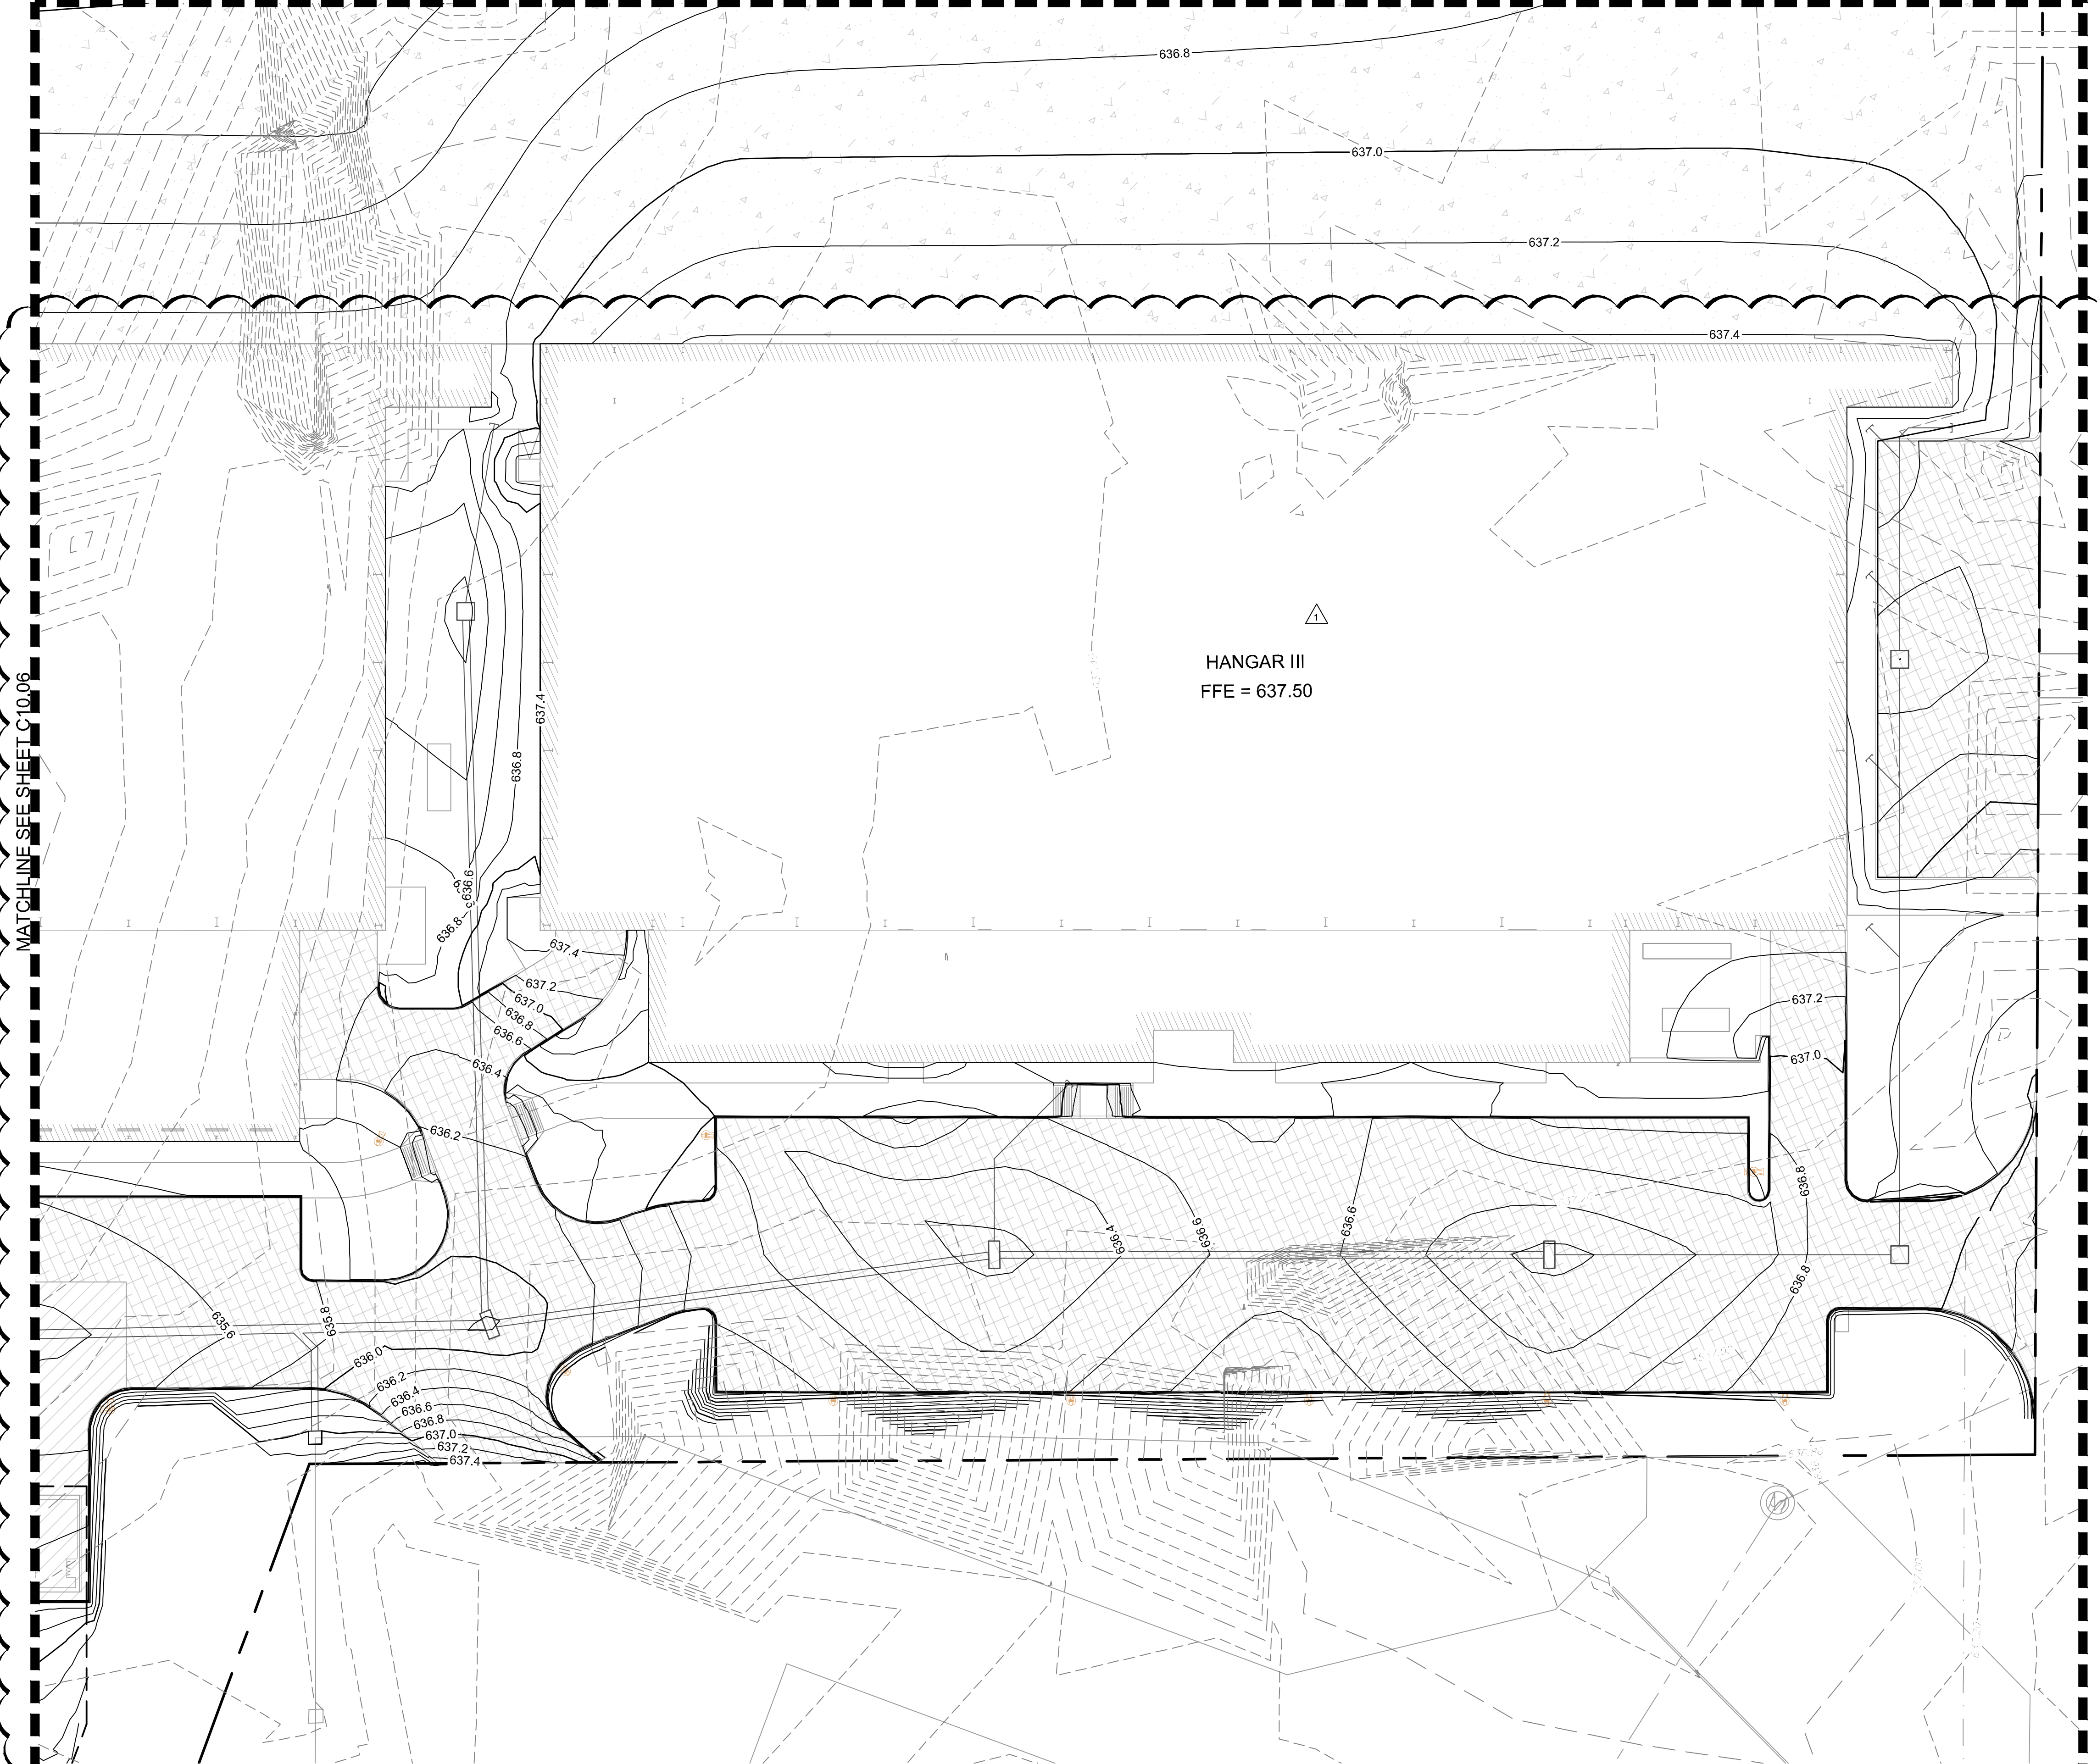


KEY PLAN

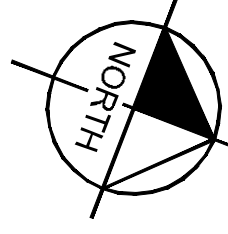



LEGEND

- 629.20 EXISTING CONTOURS
- 636.20 PROPOSED CONTOURS
- TRENCH DRAIN
- DRAINAGE INLET
- DRAINAGE MANHOLE

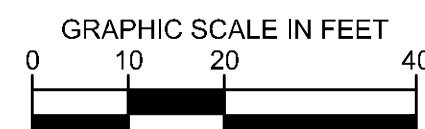


	<p>Kimley»Horn</p> <p>© 2019 KIMLEY-HORN AND ASSOCIATES, INC. 1400 WOODLICK FOREST DRIVE, SUITE 225 ADDISON, TEXAS 75001 PHONE: 281-475-2816 TBPE FIRM REGISTRATION F-928 WWW.KIMLEY-HORN.COM</p>	<p>04/30/2020 JM</p>	<table border="1" style="width: 100%; border-collapse: collapse;"> <thead> <tr> <th>No.</th> <th>REVISIONS</th> <th>DATE</th> <th>BY</th> </tr> </thead> <tbody> <tr> <td> </td> <td> </td> <td> </td> <td> </td> </tr> </tbody> </table>	No.	REVISIONS	DATE	BY					<p>GRADING PLAN</p>
No.	REVISIONS	DATE	BY									
<p>KHA PROJECT 067792503</p>	<p>DATE 2/21/2020</p>	<p>SCALE AS SHOWN</p>	<p>DESIGNED BY HCV</p>	<p>DRAWN BY EC EAC</p>	<p>CHECKED BY HCV</p>							
<p>ADDISON GALAXY FBO 15601 ADDISON RD. PREPARED FOR BLACK FOREST VENTURE</p>		<p>ADDISON DALLAS, TEXAS</p>		<p>SHEET NUMBER C10.07</p>								

Plotted By: Acevedo, Elsie Sheet: Set-Kha Layout: C12.05 April 30, 2020 11:57:40am K:\WOL_Aviation\067792503 - Addison Galaxy FBO\ACAD.dwg Sheets\C12.00_DRAINAGE_PLAN.dwg
 This document, together with the concepts and designs presented herein, is an instrument of service, is intended only for the specific purpose and client for which it was prepared. Reuse of any information contained herein without the written authorization and approval by Kimley-Horn and Associates, Inc. shall be without liability to Kimley-Horn and Associates, Inc.

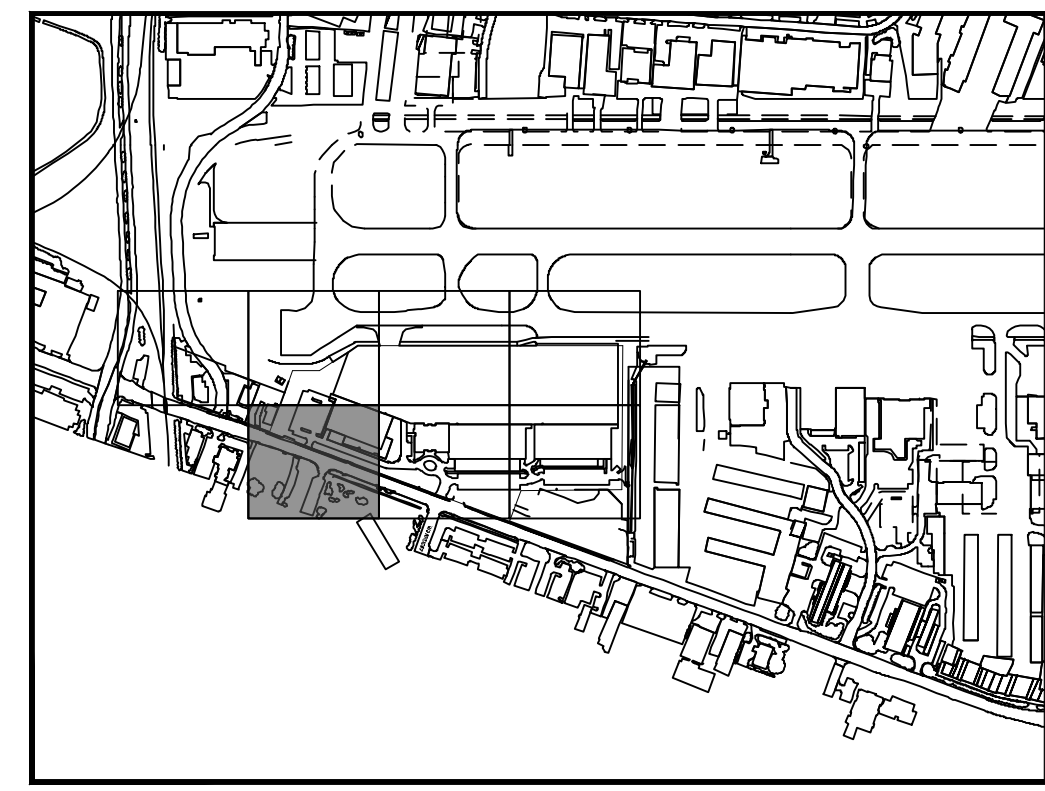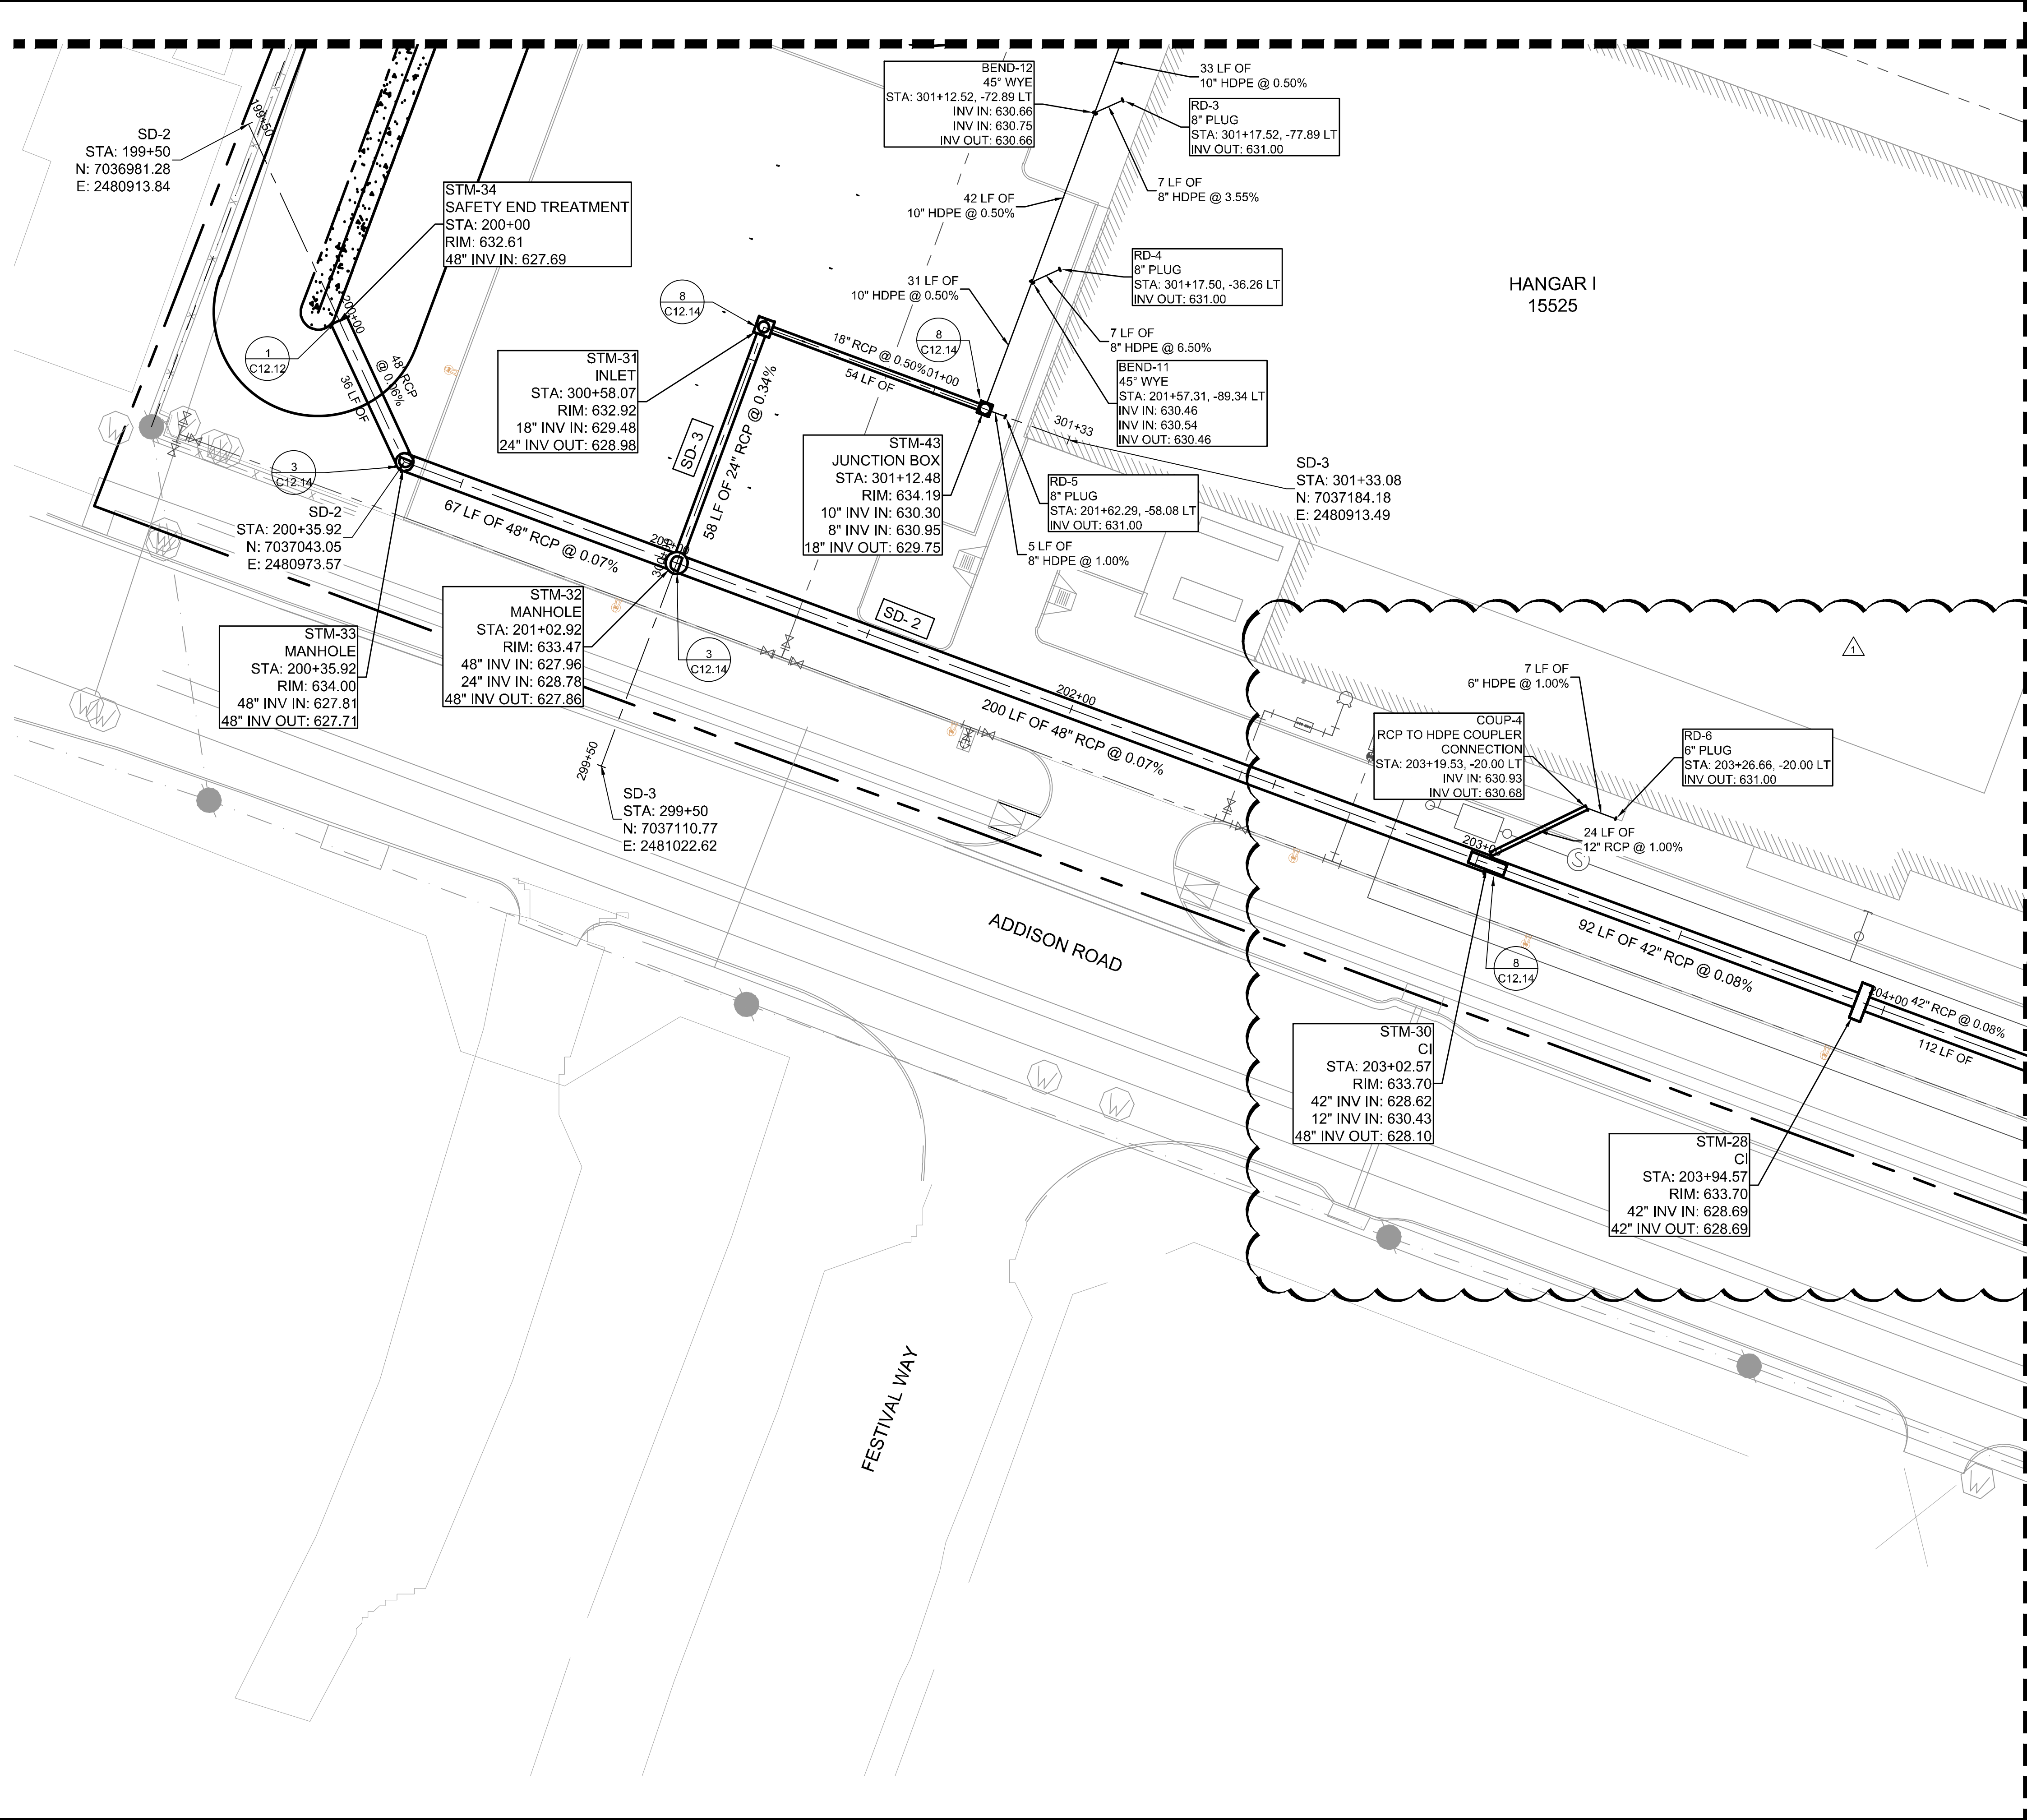

KEY PLAN

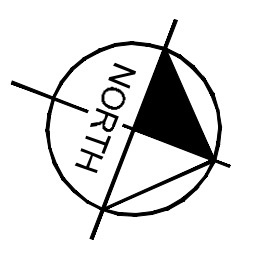


- NOTE
- AIRCRAFT RATED STRUCTURES SHALL BE CAPABLE OF SUPPORTING A MINIMUM OF 100,000 LBS.
 - SEE MEP FOR ROOF DRAIN CONNECTIONS.
 - SEE DETAIL 2 ON SHEET C12.10 FOR STORM DRAIN PIPE BEDDING.
 - UTILITY CROSSINGS ARE TO BE CONCRETE ENCASED AT ALL TIMES IN ORDER TO PROTECT AGAINST WEIGHT AND FUTURE SETTLING.
 - STORM DRAIN PIPE WITHIN AIRSIDE MUST BE CLASS V.
 - ALL HDPE STORM PIPES CONNECTED TO ROOF DRAINS ARE CONSIDERED PRIVATE AND WILL NOT BE MAINTAINED BY THE TOWN OF ADDISON.
 - STORM DRAIN INLETS WITHIN THE LANDSIDE AREA WILL BE FOUR GRATE INLET DETAIL SD-D32.

THIS PLAN CONFORMS WITH DESIGN STANDARDS INCLUDED IN THE TOWN OF ADDISON TRANSPORTATION PLAN, WATER SYSTEM REQUIREMENTS, WASTE WATER SYSTEM REQUIREMENTS, AND DRAINAGE CRITERIA MANUAL.

FLOOD PLAIN NOTE:
 NO FLOODPLAIN EXISTS ONSITE PER FEMA FIRM 48113C0180K, DATED 07/07/2014. THIS SITE IS LOCATED IN UNSHADED ZONE X, AREAS DETERMINED TO BE OUTSIDE THE 0.2% ANNUAL CHANGE FLOOD PLAIN.

LEGEND

- TRENCH DRAIN
- DRAINAGE INLET
- DRAINAGE MANHOLE


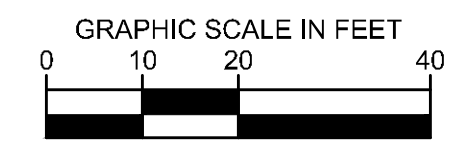


MATCHLINE SEE SHEET C12.06


	04/30/2020	JM			
ASB-C003					
© 2019 KIMLEY-HORN AND ASSOCIATES, INC. 1400 WOODLICK FOREST DRIVE, SUITE 225 FORT WORTH, TEXAS 76104 PHONE: 281-475-2816 TBPB FIRM REGISTRATION F-928 WWW.KIMLEY-HORN.COM					
KHA PROJECT 067792503	DATE 2/21/2020	SCALE AS SHOWN	DESIGNED BY HCV	DRAWN BY EC EAC	CHECKED BY HCV
STORM DRAINAGE PLAN SD-2 AND 3					
ADDISON GALAXY FBO 15601 ADDISON RD. PREPARED FOR BLACK FOREST VENTURE					
DALLAS, TEXAS					
ADDISON					
SHEET NUMBER C12.05					
No. REVISIONS DATE BY					

Plotted By: Acevedo, Elsie - Sheet: Set: KHA - Layout: C12.06 - April 30, 2020 09:16:41 am K:\VOL_Aviation\067792503 - Addison Galaxy FBO\ACAD.dwg - Sheets\C12.00_DRAINAGE_PLAN.dwg
 This document, together with the concepts and designs presented herein, is intended only for the specific purpose and client for which it was prepared. Reuse or improper reliance on this document without written authorization and approval by Kimley-Horn and Associates, Inc. shall be without liability to Kimley-Horn and Associates, Inc.

MATCHLINE SEE SHEET C12.03

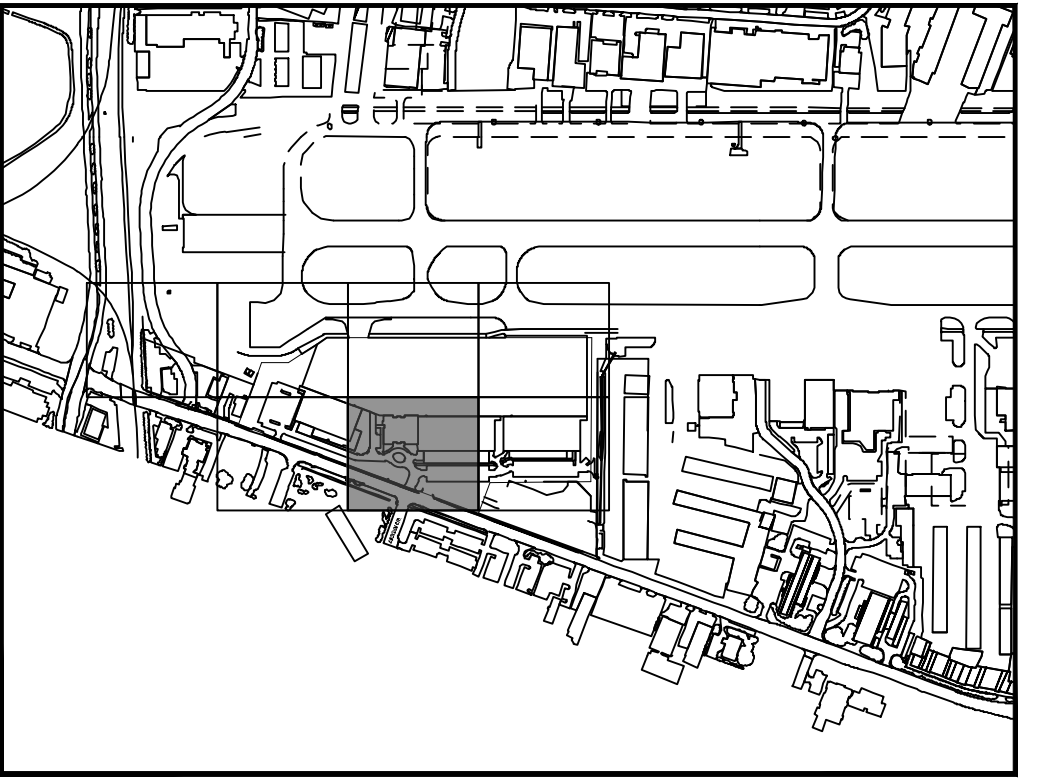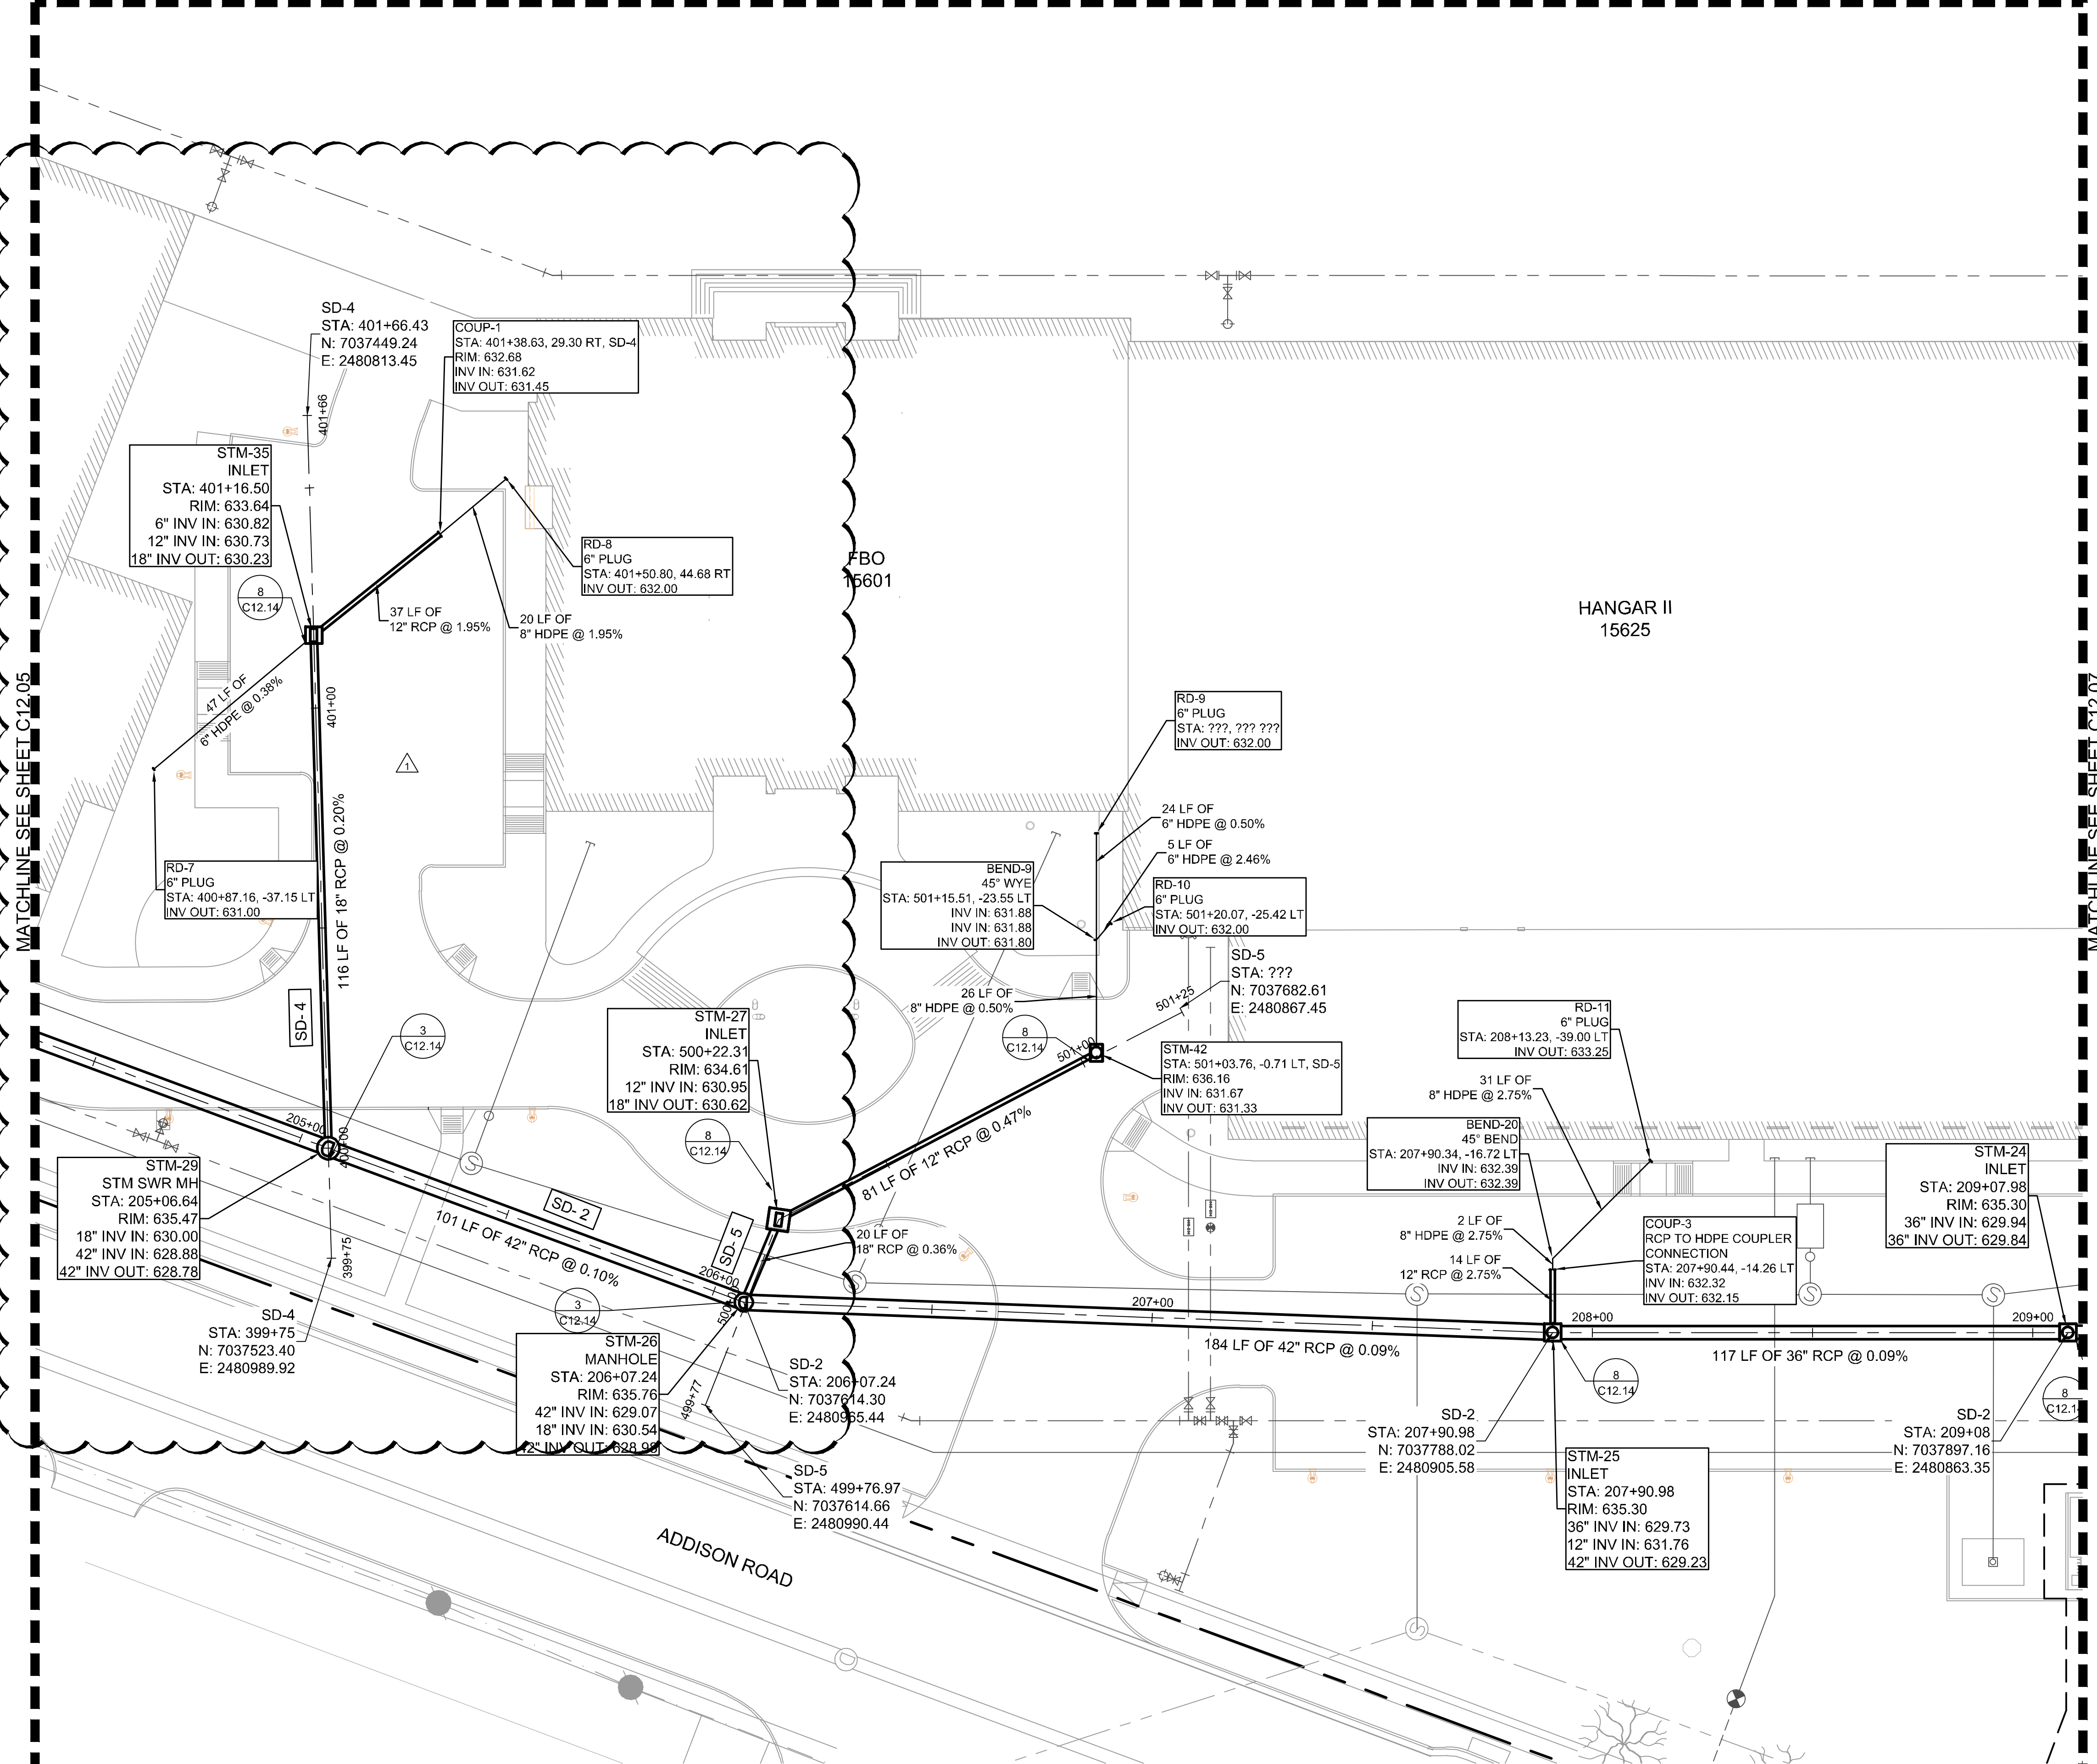

KEY PLAN

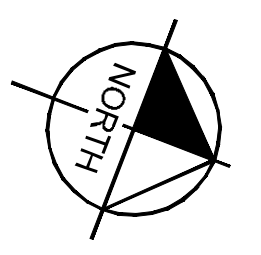

- NOTE**
- AIRCRAFT RATED STRUCTURES SHALL BE CAPABLE OF SUPPORTING A MINIMUM OF 100,000 LBS.
 - SEE MEP FOR ROOF DRAIN CONNECTIONS.
 - SEE DETAIL 2 ON SHEET C12.10 FOR STORM DRAIN PIPE BEDDING.
 - UTILITY CROSSINGS ARE TO BE CONCRETE ENCASED AT ALL TIMES IN ORDER TO PROTECT AGAINST WEIGHT AND FUTURE SETTLING.
 - STORM DRAIN PIPE WITHIN AIRSIDE MUST BE CLASS V.
 - ALL HDPE STORM PIPES CONNECTED TO ROOF DRAINS ARE CONSIDERED PRIVATE AND WILL NOT BE MAINTAINED BY THE TOWN OF ADDISON.
 - STORM DRAIN INLETS WITHIN THE LANDSIDE AREA WILL BE FOUR GRATE INLET DETAIL SD-D32.

THIS PLAN CONFORMS WITH DESIGN STANDARDS INCLUDED IN THE TOWN OF ADDISON TRANSPORTATION PLAN, WATER SYSTEM REQUIREMENTS, WASTE WATER SYSTEM REQUIREMENTS, AND DRAINAGE CRITERIA MANUAL.

FLOOD PLAIN NOTE:
 NO FLOODPLAIN EXISTS ONSITE PER FEMA FIRM 48113C0180K, DATED 07/07/2014. THIS SITE IS LOCATED IN UNSHADED ZONE X, AREAS DETERMINED TO BE OUTSIDE THE 0.2% ANNUAL CHANGE FLOOD PLAIN.

LEGEND


- TRENCH DRAIN
- DRAINAGE INLET
- DRAINAGE MANHOLE



No.	REVISIONS	DATE	BY

Kimley»Horn

© 2019 KIMLEY-HORN AND ASSOCIATES, INC.
 1400 WOODLACK FOREST DRIVE, SUITE 225
 FORT WORTH, TEXAS 76104
 PHONE: 281-475-2816
 TBP# FIRM REGISTRATION F-928
 WWW.KIMLEY-HORN.COM

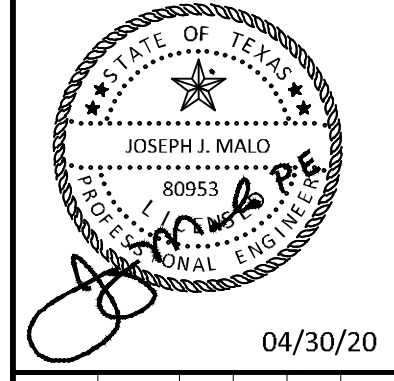

KHA PROJECT	067792503
DATE	2/21/2020
SCALE	AS SHOWN
DESIGNED BY	HCV
DRAWN BY	EC
CHECKED BY	HCV


STORM DRAINAGE PLAN SD-2, 4, AND 5

ADDISON GALAXY FBO
 15601 ADDISON RD.
 PREPARED FOR
BLACK FOREST VENTURE


DALLAS, TEXAS

Plotted By: Acevedo, Eleth Sheet: Set-Kno Layout: C12.08 April 30, 2020 11:19:42am K:\VOLI_Aviation\067792503 - Addison Galaxy FBO\ACAD.dwg Sheets\C12.08 DRAINAGE PROFILES.dwg
 This document, together with the concepts and designs presented herein, is an instrument of service, and its use is intended only for the specific purpose and client for which it was prepared. Reuse of any information contained herein without the written authorization and approval of Kimley-Horn and Associates, Inc. shall be without liability to Kimley-Horn and Associates, Inc.


SD-1

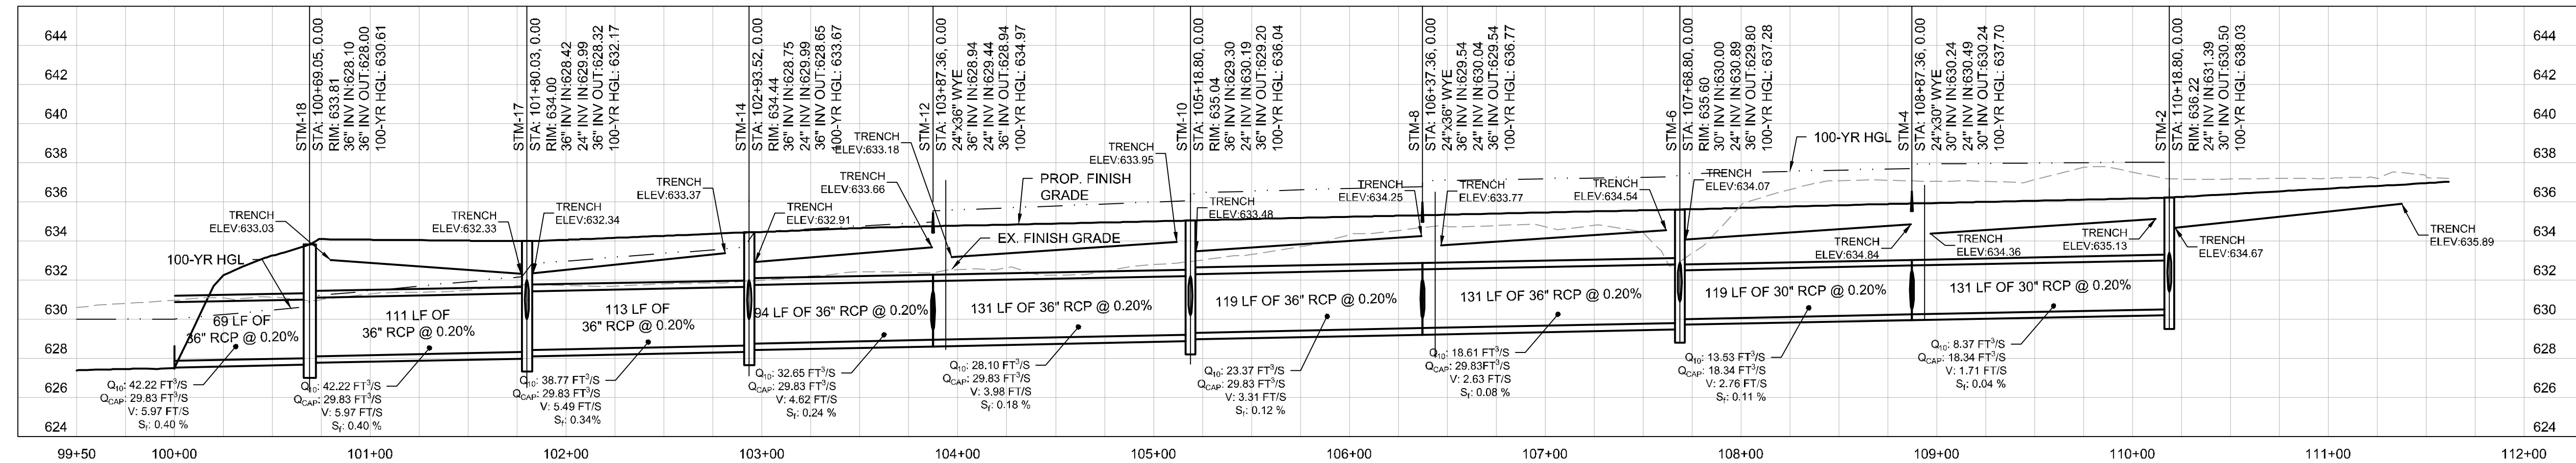


SD-2

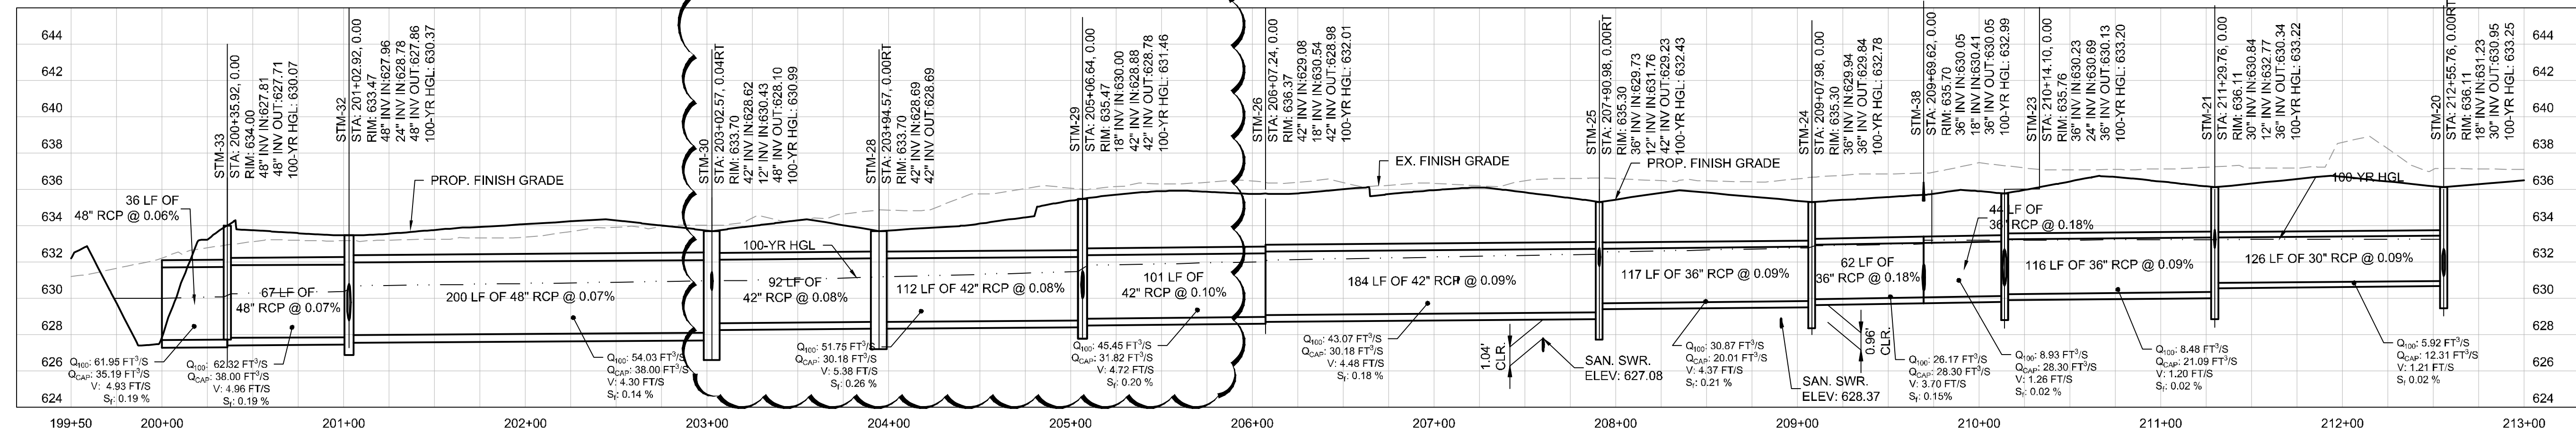


SD-3

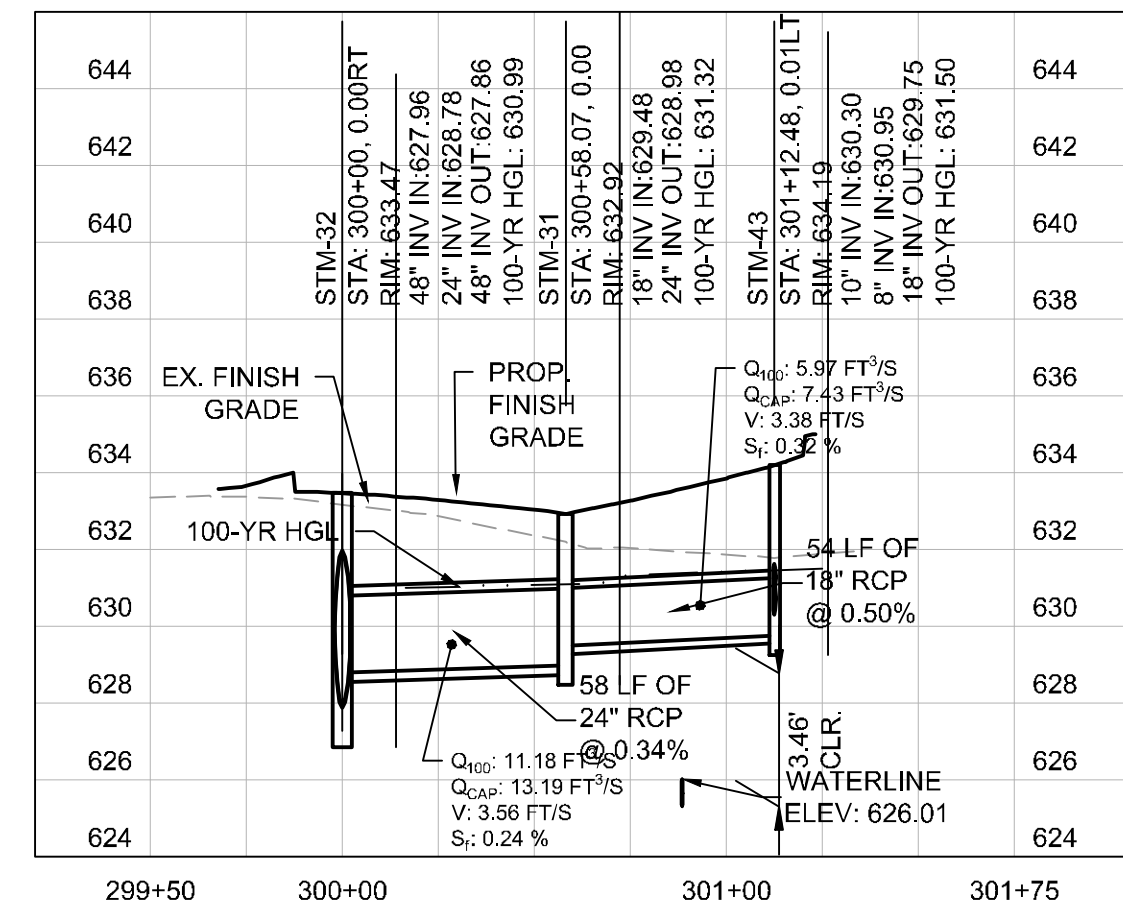


SD-4

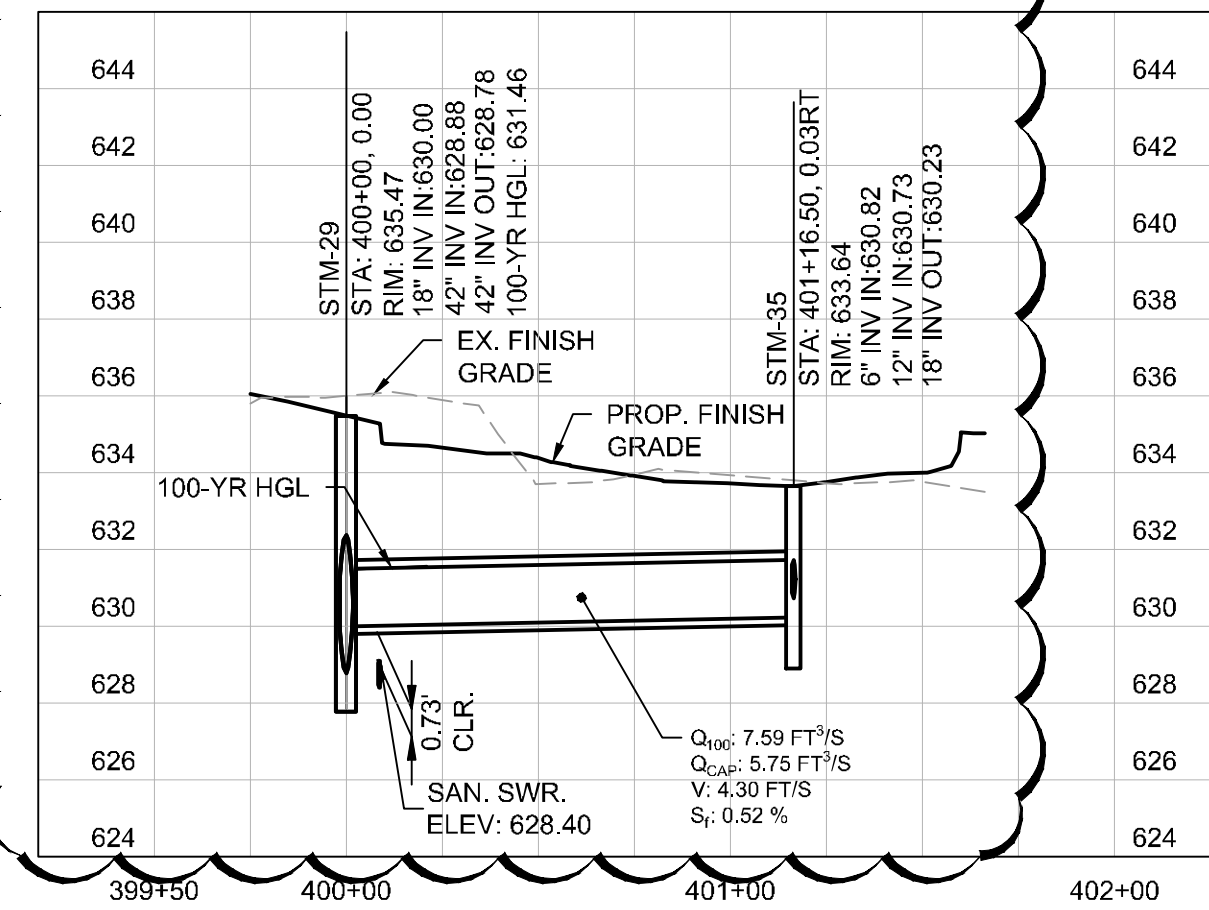


SD-5

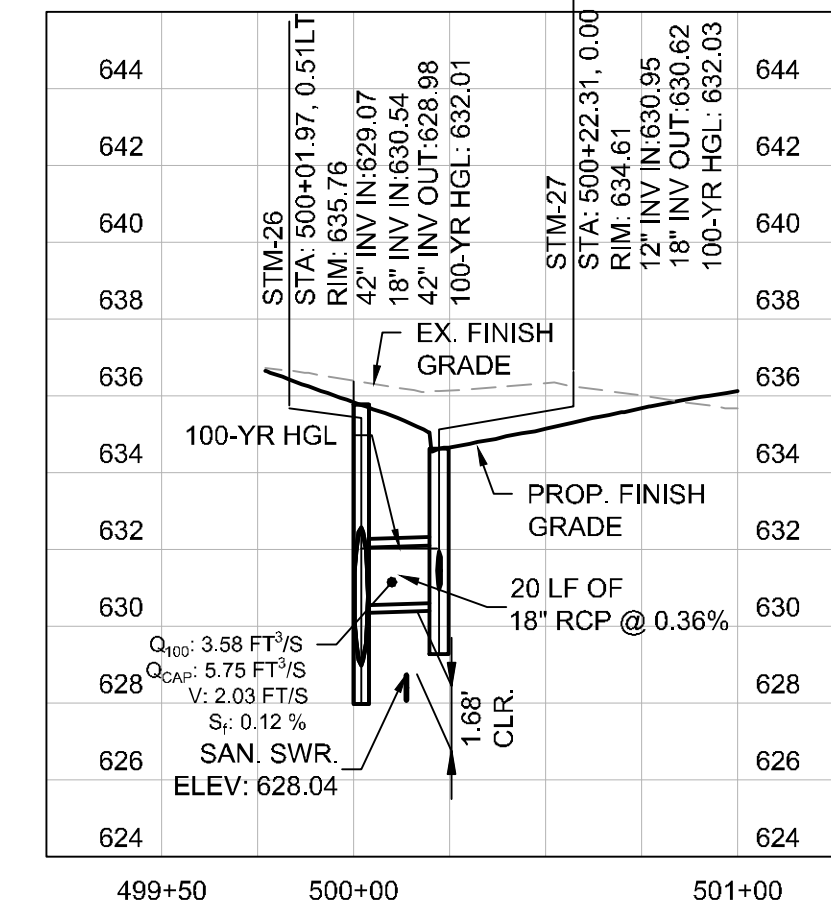


SD-6

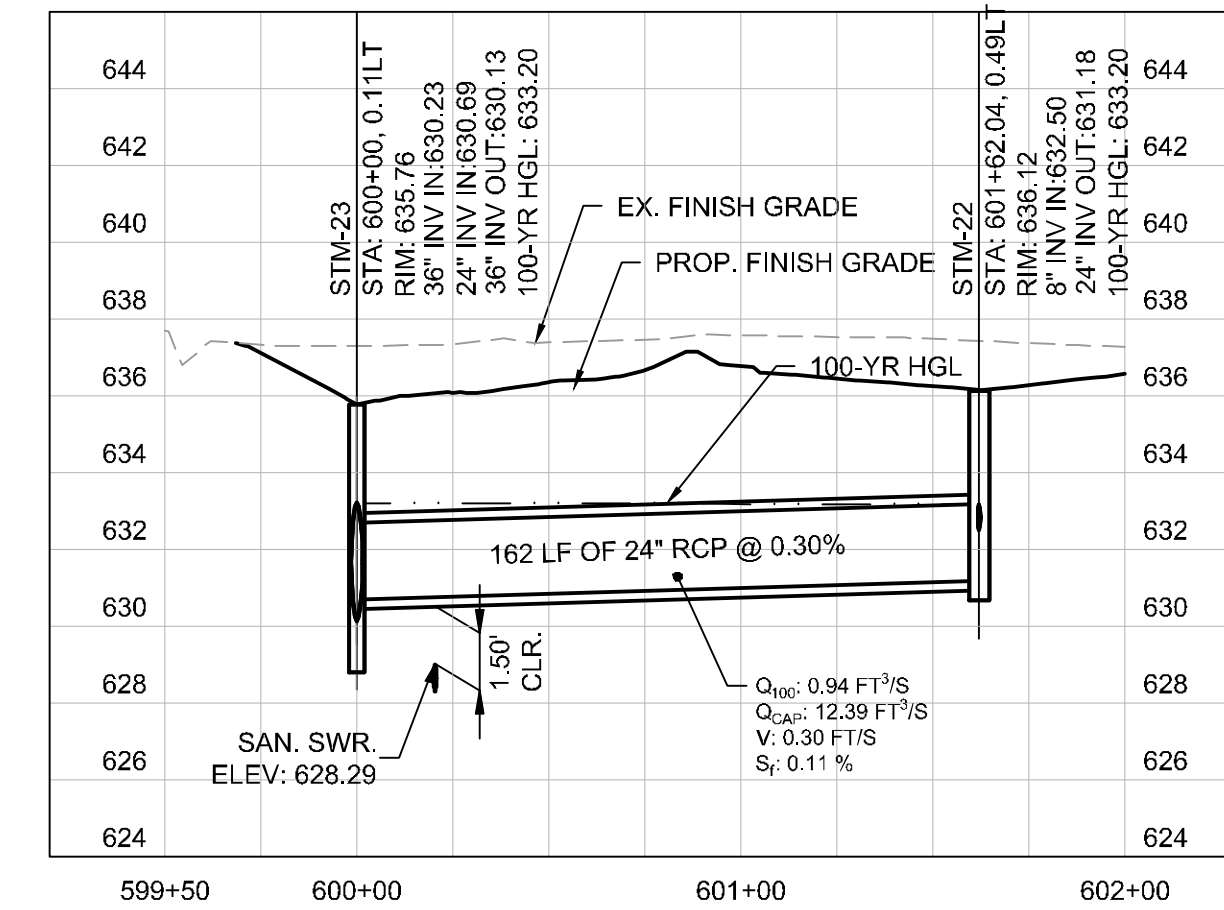

SD-7

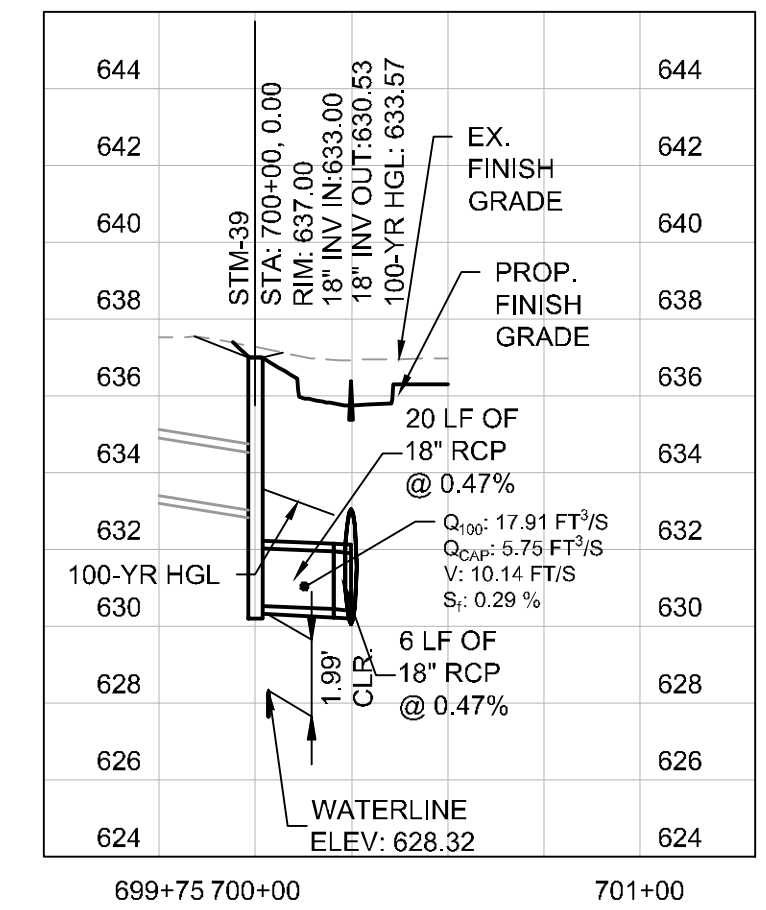

- NOTE:
- ALL RCP PIPES FOR SD-1 MUST BE CLASS V.
 - CONCRETE ENCASE ALL UTILITY CROSSING AT ALL TIMES TO PROTECT AGAINST WEIGHT AND FUTURE SETTLING.

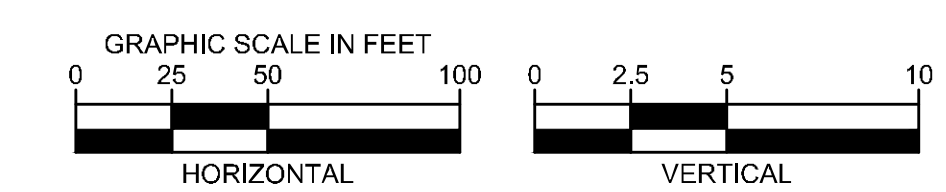

Kimley Horn
 © 2019 KIMLEY-HORN AND ASSOCIATES, INC.
 1400 WOODLICK FOREST DRIVE, SUITE 225
 DALLAS, TEXAS 75244
 PHONE: 281-475-2816
 TBP# FIRM REGISTRATION F-928
 WWW.KIMLEY-HORN.COM

ADDISON GALAXY FBO
 15601 ADDISON RD.
 PREPARED FOR:
BLACK FOREST VENTURE

DALLAS, TEXAS
 ADDISON



KHA PROJECT: 067792503
 DATE: 2/21/2020
 SCALE: AS SHOWN
 DESIGNED BY: HCV
 DRAWN BY: EC EAC
 CHECKED BY: HCV

STATE OF TEXAS
 JOSEPH J. MALI
 80953
 PROFESSIONAL ENGINEER
 04/30/20


SHEET NUMBER
C12.08

No.	REVISIONS	DATE	BY

Plotted By: Acevedo, Elsie. Sheet: Set-Kha - Layout-C13.01 April 30, 2020 11:41:56am K:\VLD\Aviation\067792503 - Addison Galaxy FBO\ACAD\Draw Sheets\C13.00 SANITARY SEWER.dwg
 This document, together with the concepts and designs presented herein, is intended only for the specific purpose and client for which it was prepared. Reuse or improper reliance on this document without written authorization and adaptation by Kimley-Horn and Associates, Inc. shall be without liability to Kimley-Horn and Associates, Inc.

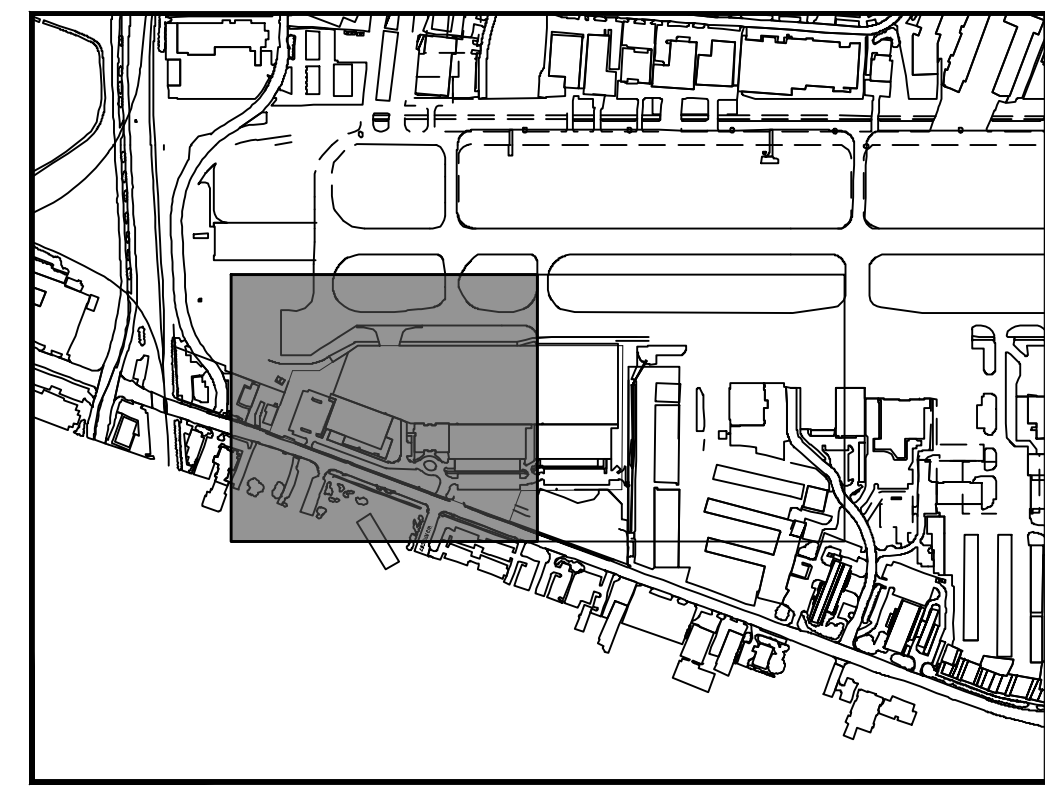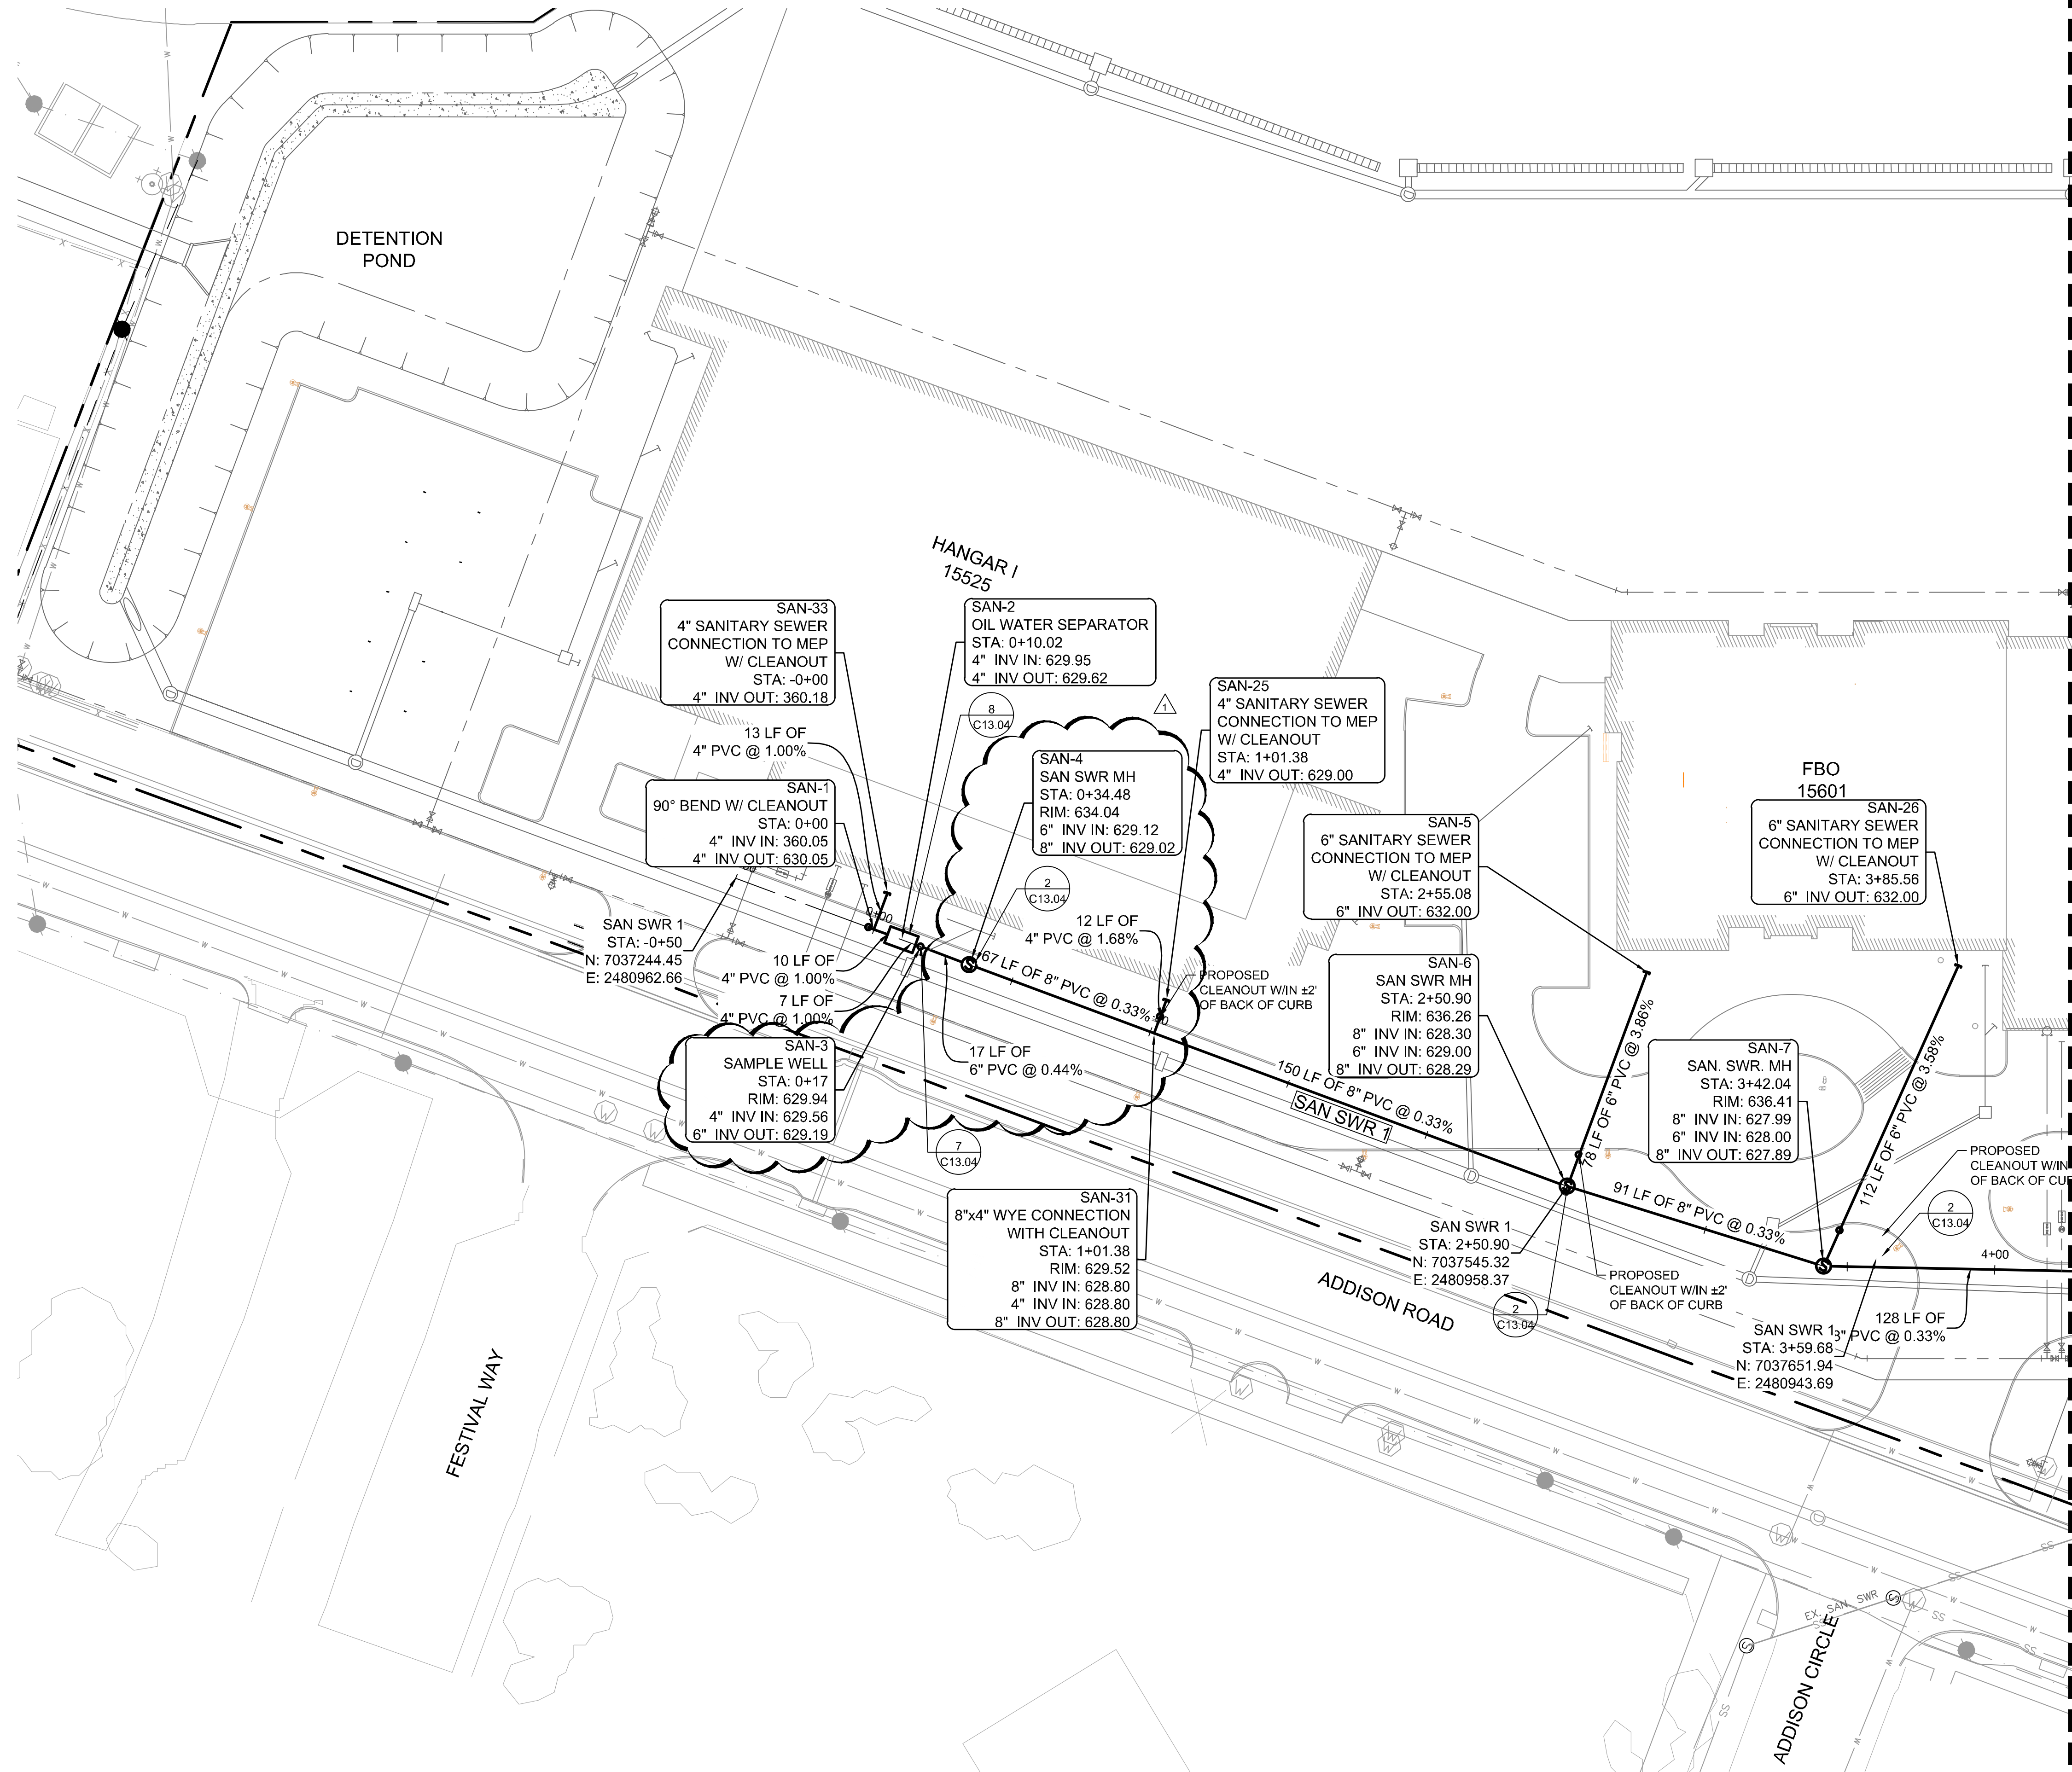

KEY PLAN

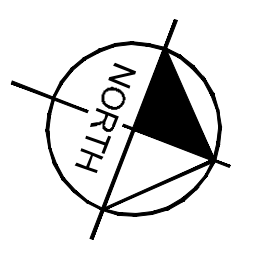


NOTES:


- SEE DETAIL 1 ON C13.04 FOR SANITARY SEWER PIPE EMBANKMENT.
- SANITARY SEWER MANHOLE DETAIL 2 CAN BE SUBSTITUTED WITH SANITARY SEWER MANHOLE DETAIL 3 ON SHEET C13.04.
- SEE MEP, PLUMBING PLANS FOR SANITARY SEWER CONNECTION.
- CONCRETE ENCASE UTILITY CROSSINGS AT ALL TIMES TO PROTECT AGAINST WEIGHT AND FUTURE SETTLING.

THIS PLAN CONFORMS WITH DESIGN STANDARDS INCLUDED IN THE TOWN OF ADDISON TRANSPORTATION PLAN, WATER SYSTEM REQUIREMENTS, WASTE WATER SYSTEM REQUIREMENTS, AND DRAINAGE CRITERIA MANUAL.

LEGEND

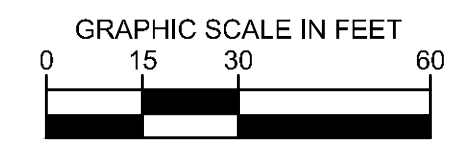

Kimley»Horn
 © 2019 KIMLEY-HORN AND ASSOCIATES, INC.
 TBP# FIRM REGISTRATION F-928
 WWW.KIMLEY-HORN.COM

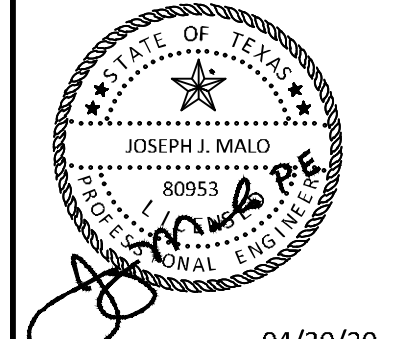

KHA PROJECT	067792503
DATE	2/21/2020
SCALE	AS SHOWN
DESIGNED BY	HCV
DRAWN BY	EC EAC
CHECKED BY	HCV

SANITARY SEWER PLAN
SAN SWR 1


ADDISON GALAXY FBO
 15601 ADDISON RD.
 PREPARED FOR
BLACK FOREST VENTURE

DALLAS, TEXAS


SHEET NUMBER
C13.01

No.	REVISIONS	DATE	BY


Plotted By: Acevedo, Elsie. Sheet: Set-Kho. Layout: C13.03. April 30, 2020 11:26:42am. K:\VOL_Aviation\067792503 - Addison Galaxy FBO\ACAD.dwg. Sheets: C13.00. SANITARY SEWER PROFILE.dwg. This document, together with the concepts and designs presented herein, is an instrument of service, and its preparation and use are subject to the terms and conditions of the contract between the client and Kimley-Horn and Associates, Inc. All rights are reserved. Kimley-Horn and Associates, Inc. shall be without liability to Kimley-Horn and Associates, Inc.

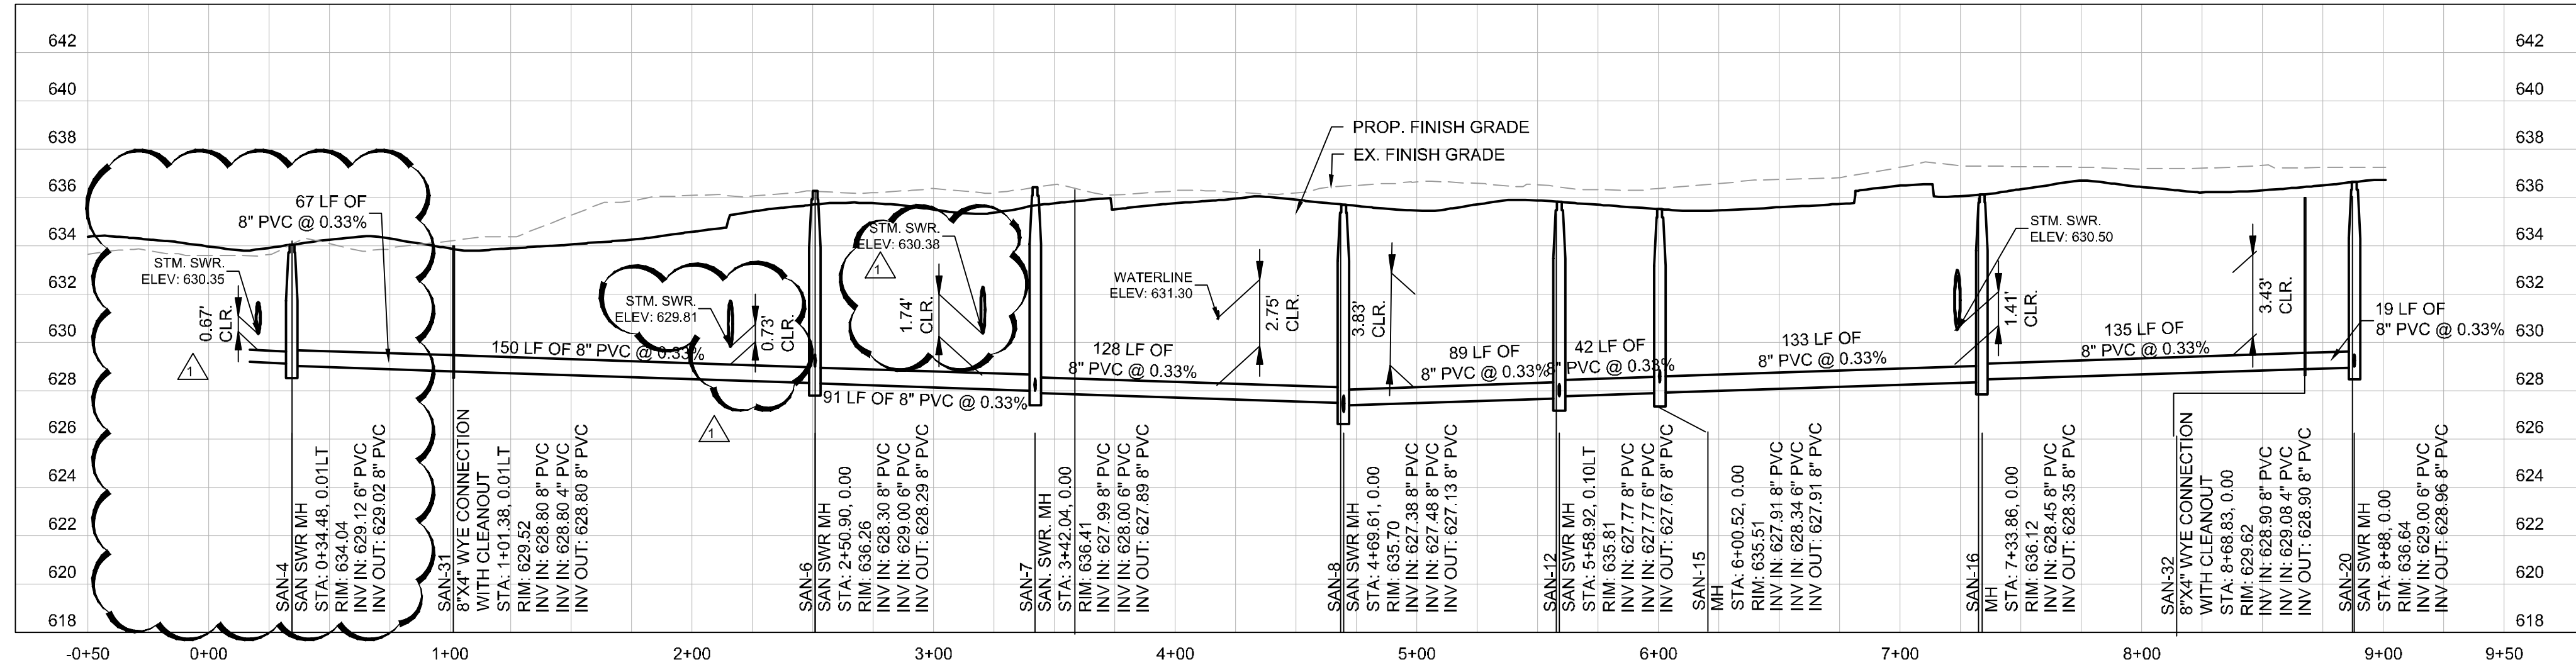


SAN SWR 1

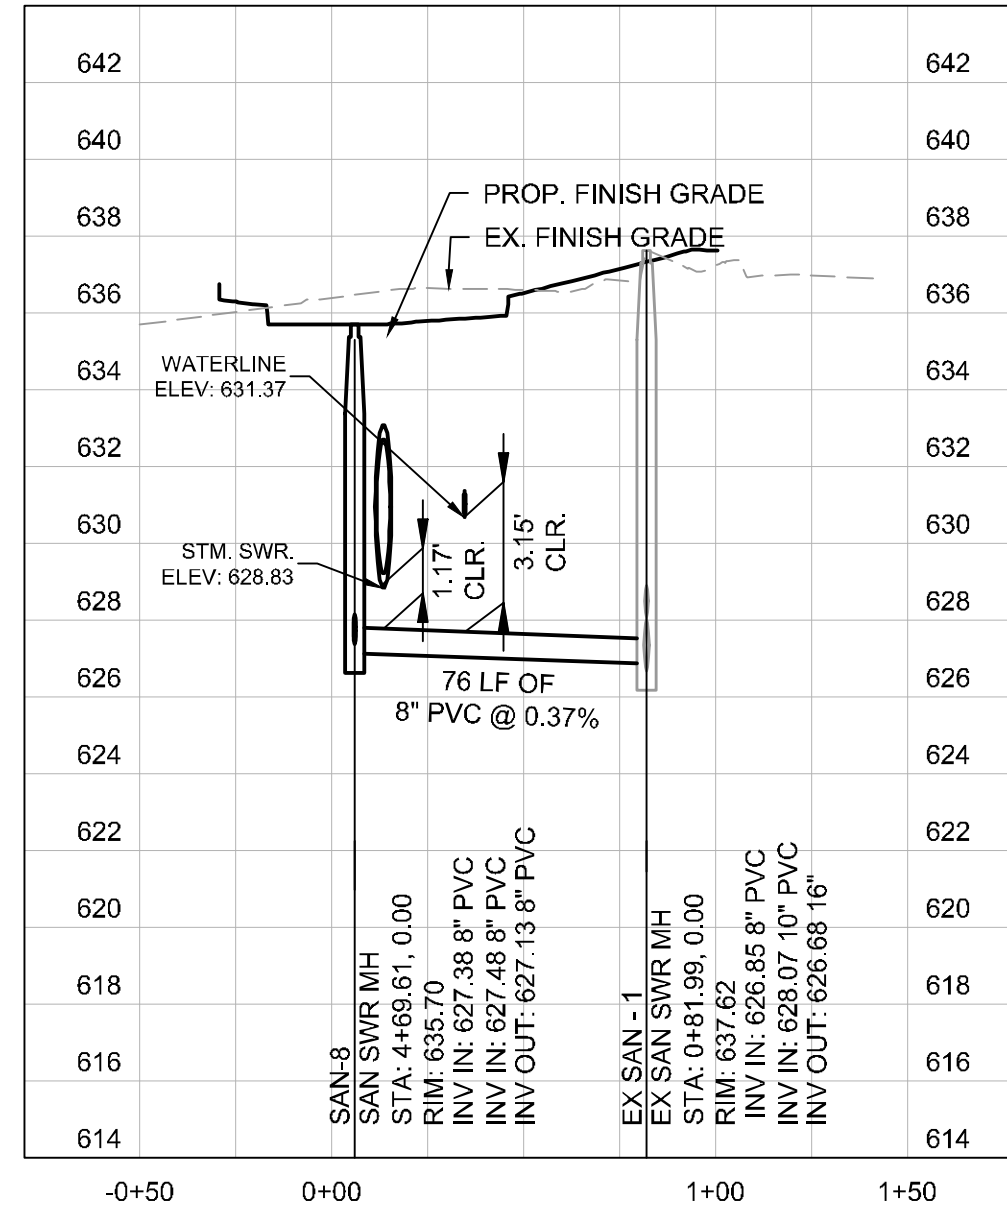

SAN SWR 2

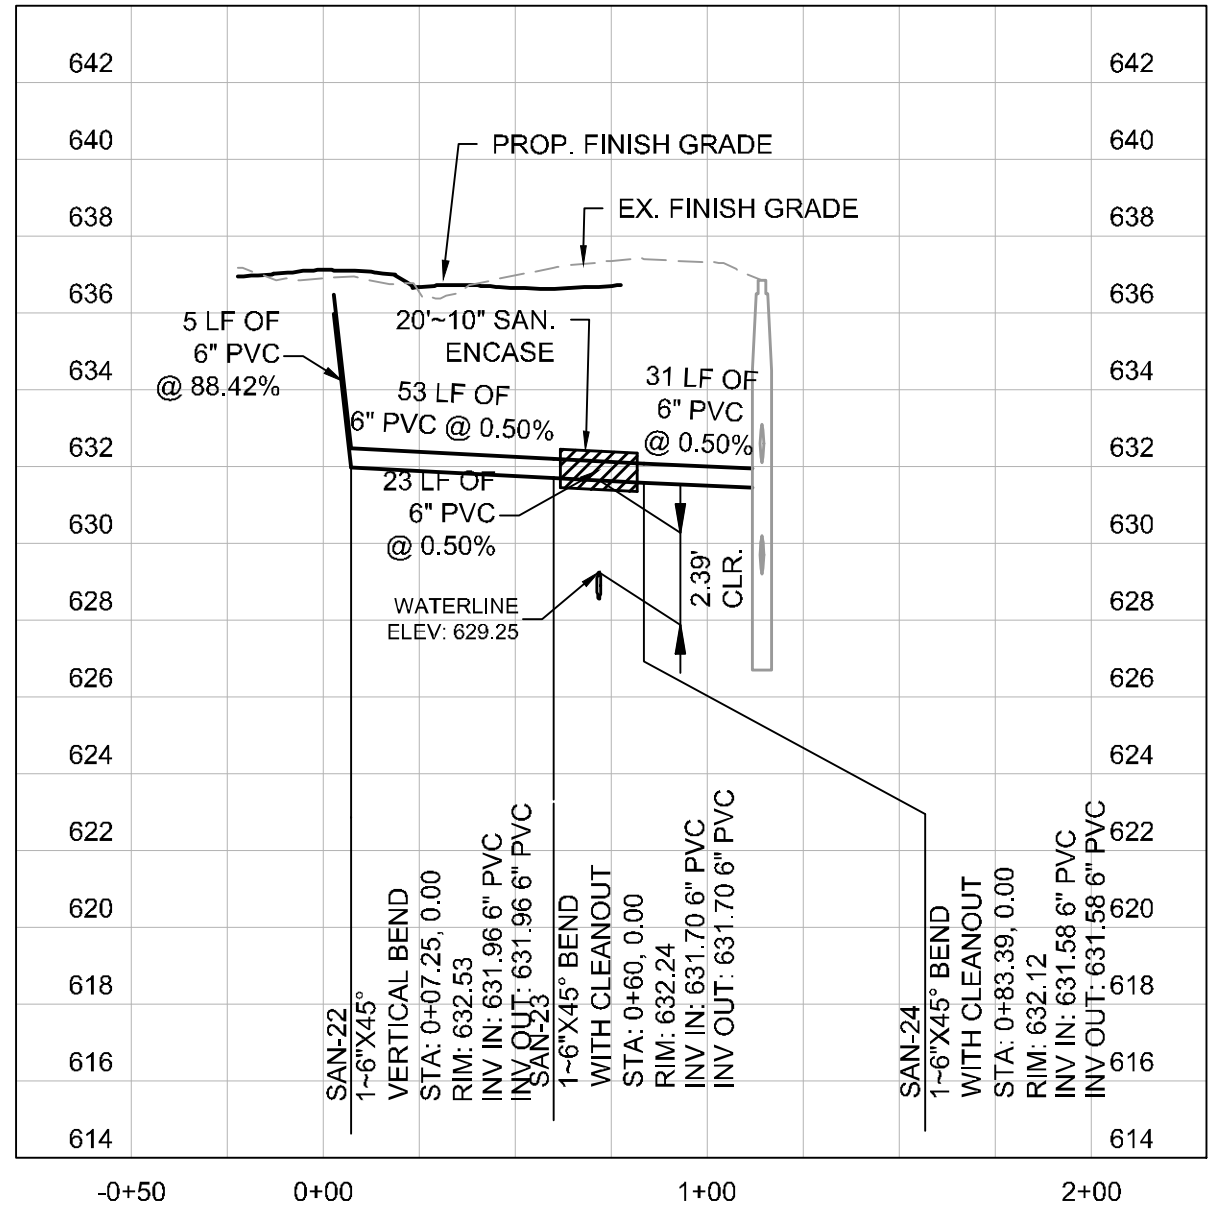


SAN SWR 3

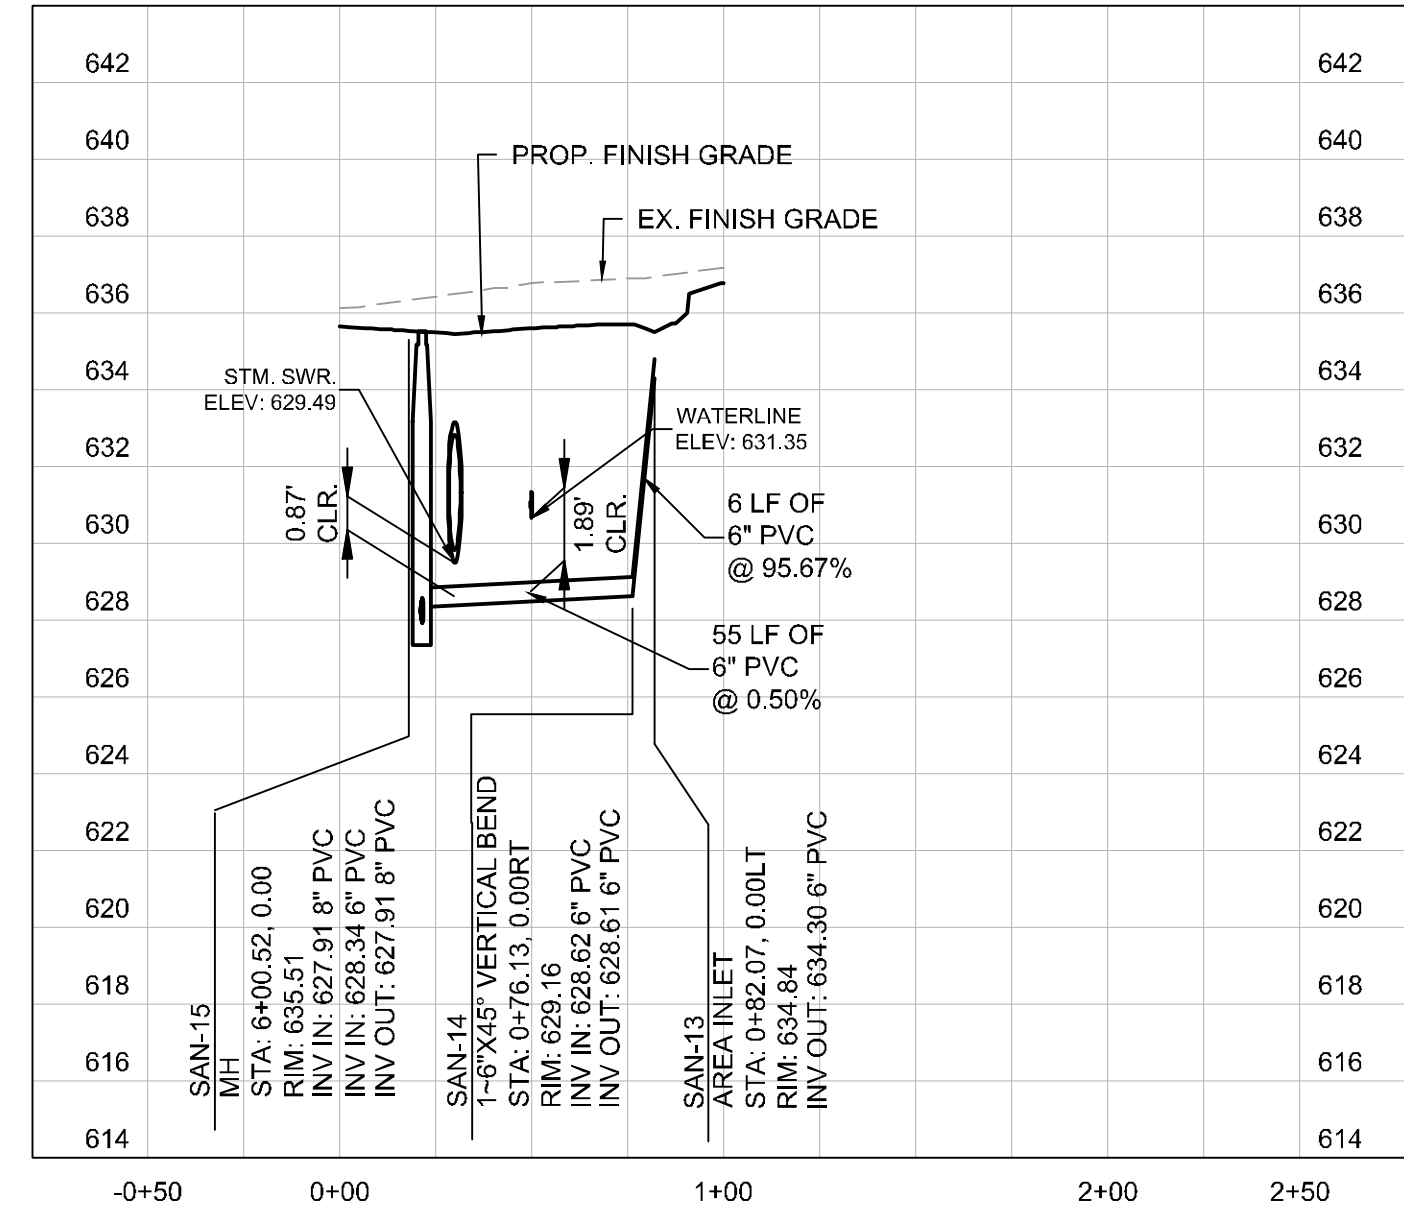

SAN SWR 4


NOTE:
CONCRETE ENCASE UTILITY CROSSINGS AT ALL TIMES TO PROTECT AGAINST WEIGHT AND FUTURE SETTLING.

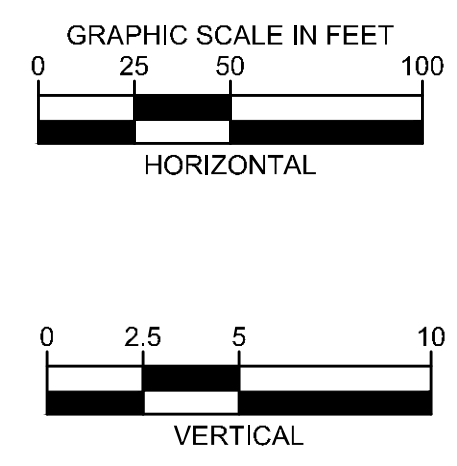

No.	REVISIONS	DATE	BY
1	ASB-C003	04/30/2020	JM

Kimley»Horn

© 2019 KIMLEY-HORN AND ASSOCIATES, INC.
1400 WOODLICK FOREST DRIVE, SUITE 225
DALLAS, TEXAS 75243
PHONE: 281-475-2816
WWW.KIMLEY-HORN.COM

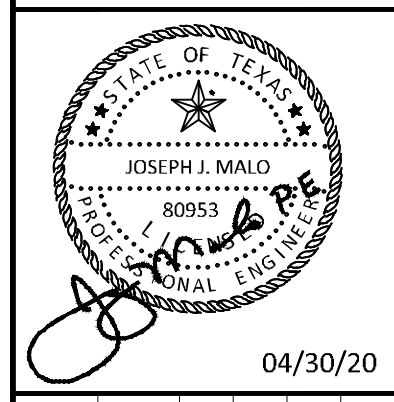



KHA PROJECT	067792503
DATE	2/21/2020
SCALE	AS SHOWN
DESIGNED BY	HCV
DRAWN BY	EC EAC
CHECKED BY	HCV

SANITARY SEWER PROFILE

ADDISON GALAXY FBO
15601 ADDISON RD.
PREPARED FOR
BLACK FOREST VENTURE
DALLAS, TEXAS
ADDISON

SHEET NUMBER
C13.03

Plotted By: Lockwood, Lorian Sheet Set: khs Layout: LP 1.01 LANDSCAPE PLAN April 30, 2020 10:40:47 am \\wlfip01\Data\Projects\WDL\Aviation\067792503 - Addison Galaxy FBO\ACAD\Draws\Sheets\Landscapes\ - LANDSCAPE PLAN.dwg
 This document, together with the concepts and designs presented herein, is intended only for the specific purpose and client for which it was prepared. Reuse of any information on this document without written authorization and adaptation by Kimley-Horn and Associates, Inc. shall be without liability to Kimley-Horn and Associates, Inc.

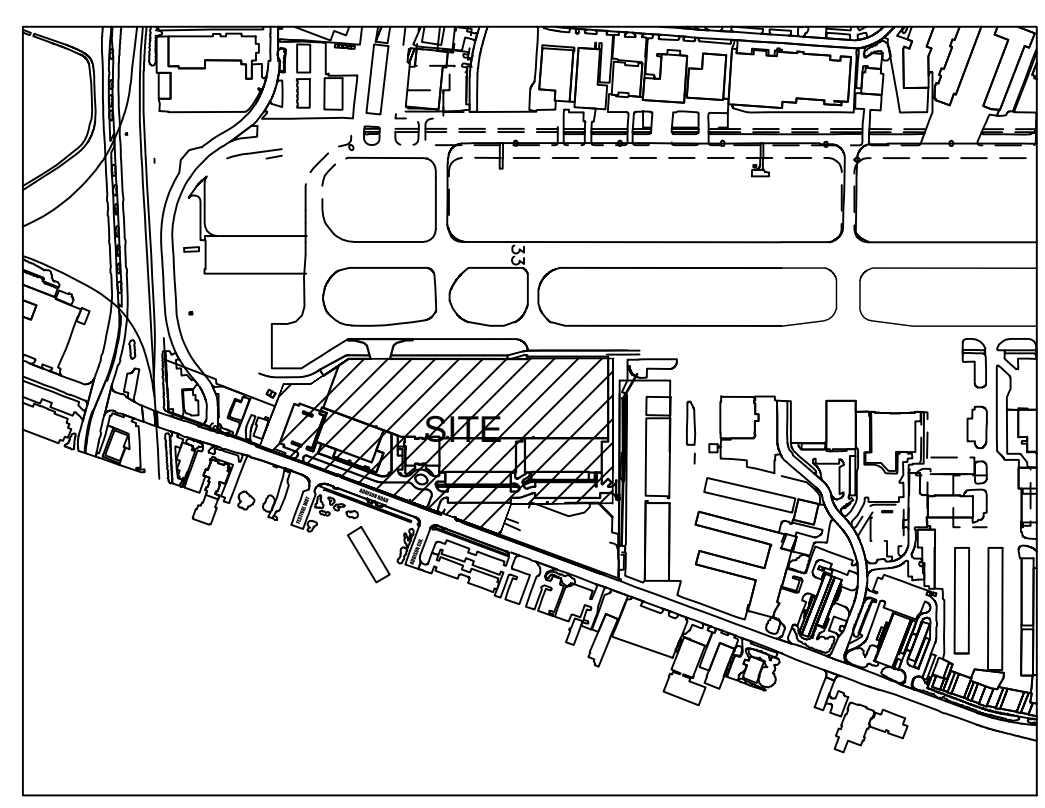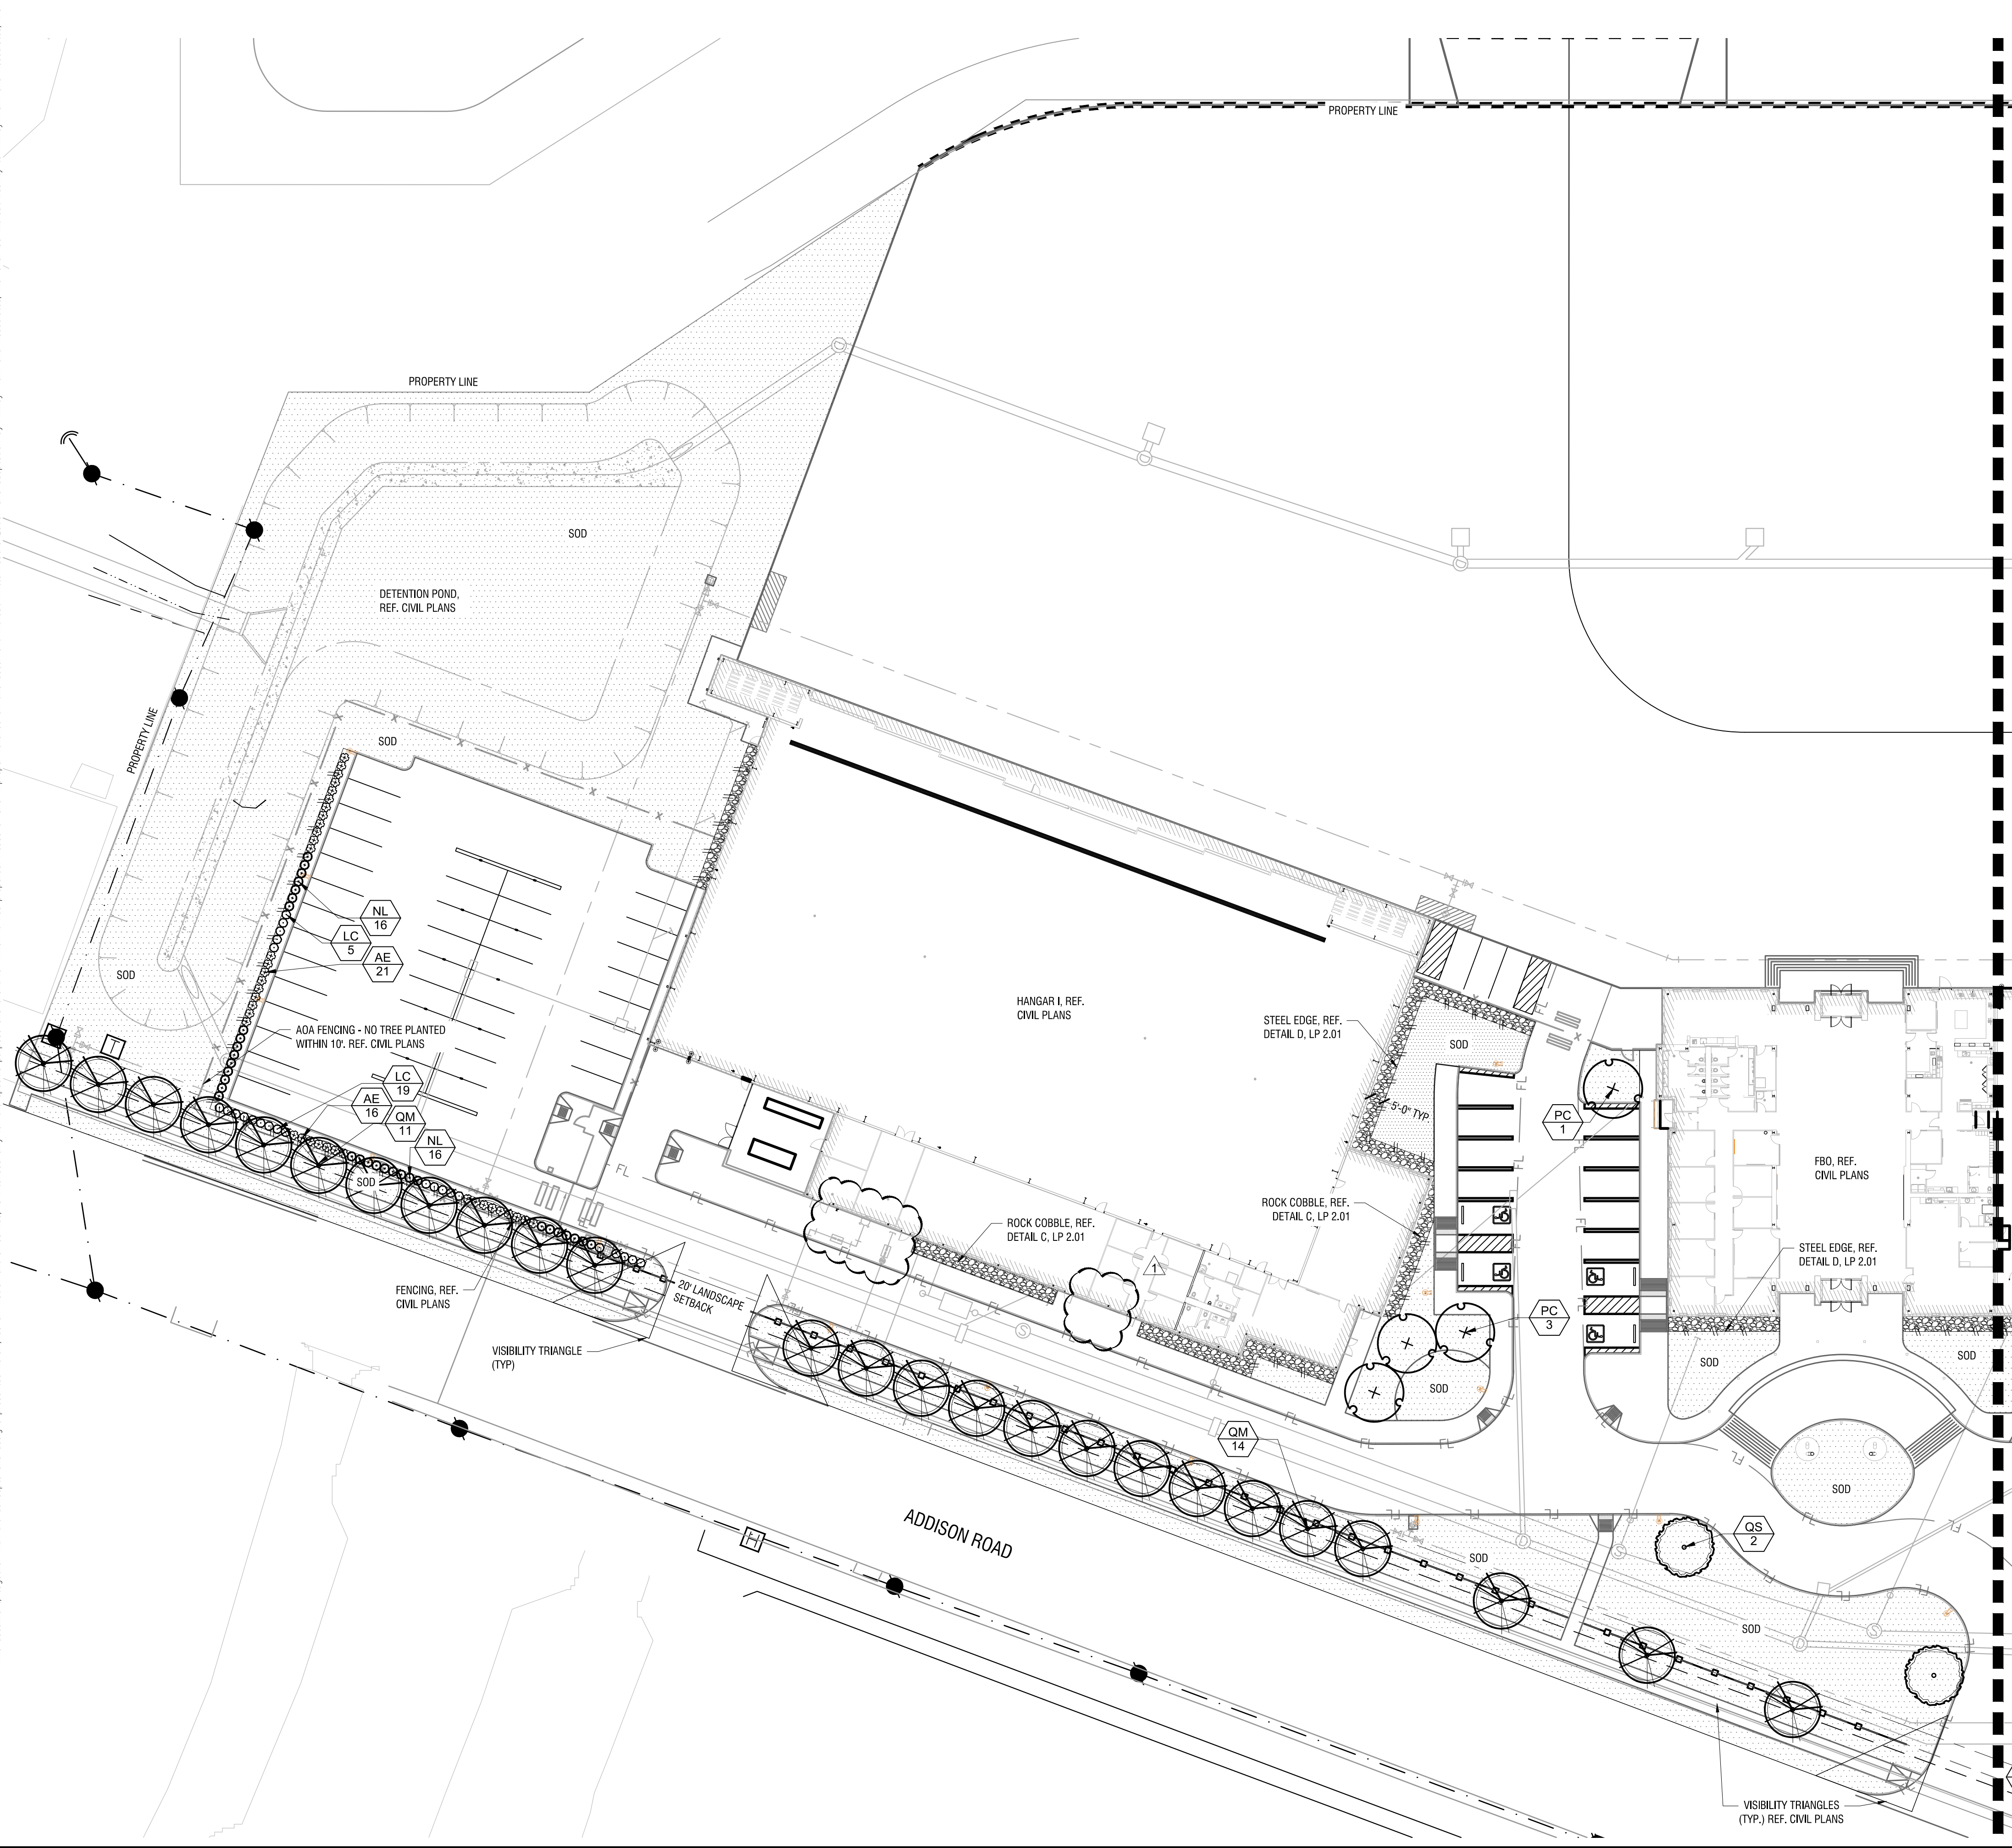

KEY PLAN

Town of Addison, TX Landscape Requirements - Article XXI


Landscaping Requirements	Required	Provided
Minimum landscape area should be 10% of the total site area 683,194 SF x 10% = 68,319 SF	68,319 SF (10%)	78,296 SF (11%)
Street landscape buffers shall be one 4" caliper shade tree for each 30 LF of frontage and evergreen shrubs planted 3-3.5 feet on center 990 LF / 30 LF = 33 Trees	33 Trees	29 New Trees + 4 Existing Trees
Surface Screening and Buffering Surface parking lot screening must be at least 3.5 feet higher than the finished elevation of the adjacent parking lot. Evergreen shrub planted three feet on center in a single row in a bed at least 42 inches wide. The perimeter parking lot landscape strip shall be at least 5 feet wide for sites larger than 10,000 SF. Minimum requirement for perimeter landscaping 5 feet wide and greater shall be one 4" caliper shade tree for each 35 LF of perimeter and one shrub planted 3-3.5 feet on center.	Yes	Yes
Surface Parking Lot Landscaping The required percentage of interior parking lot landscaping shall be 5% for 7,000 - 49,999 SF of interior parking area. 48,994 SF Interior Parking x 5% = 2,429 SF Planting Area	2,429 SF Planting Area	2,779 SF Planting Area
Large shade trees must be provided in each parking lot at minimum average density of one shade tree for each ten required parking spaces on the lot. 155 Parking Spaces / 10 = 16 Trees	16 Trees	16 Trees
No required parking space may be located further than 50 feet from the trunk of shade tree, or further than 75 feet from two or more shade trees.	Yes	N/A per existing site plan

PLANT LEGEND

- TRESS
- PC PISTACIA CHINENSIS / CHINESE PISTACHE
- QM QUERCUS MUEHLBERGERII / CHINKAPIN OAK
- OS QUERCUS SHUMARDII / SHUMARD RED OAK
- SHRUBS
- AE ABELIA X GRANDIFLORA 'EDWARD GOUCHER' / GLOSSY ABELIA
- LC LOROPETALUM CHINENSIS 'PURPLE DIAMOND' / PURPLE DIAMOND LOROPETALUM
- NL NANDINA DOMESTICA 'LEMON LIME' / LEMON LIME NANDINA
- GROUND COVERS
- SOD CYNODON DACTYLON / COMMON BERMAUDA GRASS
- RR RIVER ROCK

REF. LP 2.01 FOR MASTER PLANT SCHEDULE AND NOTES

NO IRRIGATION TO BE LOCATED WITHIN 5'-0" OF BUILDING FOUNDATION PER GEOTECH REPORT.

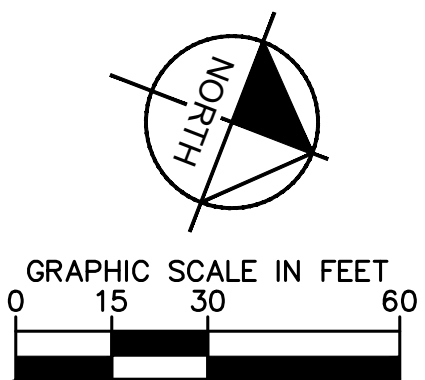

ADDISON GALAXY FBO

15.67 ACRES
EDWARD COOK SURVEY
ABSTRACT NO. 326
SUBMITTED: 10/23/2019

OWNER:
Black Forest Ventures
25 Waterway Ave
Suite 225
The Woodlands, TX 77380

CIVIL ENGINEER:
Kimley Horn
1400 Woodloch Drive
Suite 225
The Woodlands, TX 77380
Phone: (281) 475-2816

LANDSCAPE ARCHITECT:
Kimley»Horn
13455 Noel Rd.
Two Galleria Office Tower
Suite 700
Dallas, TX 75240
Contact: Patrick B. Hart, PLA
Phone: (972) 770-1300

ADDENDUM #1	ADDENDUM #5	ADDENDUM #6	ADDENDUM #8	ASI-C003	No.	REVISIONS	DATE	BY

Kimley»Horn

© 2015 KIMLEY-HORN AND ASSOCIATES, INC.
1400 WOODLOCH DRIVE, SUITE 225
THE WOODLANDS, TX 77380
PHONE: (281) 475-2816
TBP# FIRM REGISTRATION F-928
WWW.KIMLEY-HORN.COM

04/30/2020

LANDSCAPE PLAN

ADDISON GALAXY FBO
15601 ADDISON RD.
PREPARED FOR
BLACK FOREST VENTURE

DALLAS, TEXAS

ADDISON