




Plotted By: Acevedo, Elsie. Sheet Set: KHA - Layout: C17.04 - February 12, 2020 - 11:06:24am. K:\WDL-Avid\Avid\06792503 - Addison Galaxy FBO\CAD\Drawings\C17.00 FENCE DETAILS.dwg
 This document, together with the concepts and designs presented herein, is an instrument of service, as on instrument of service, and shall be without liability to Kimley-Horn and Associates, Inc. should be without liability to Kimley-Horn and Associates, Inc.

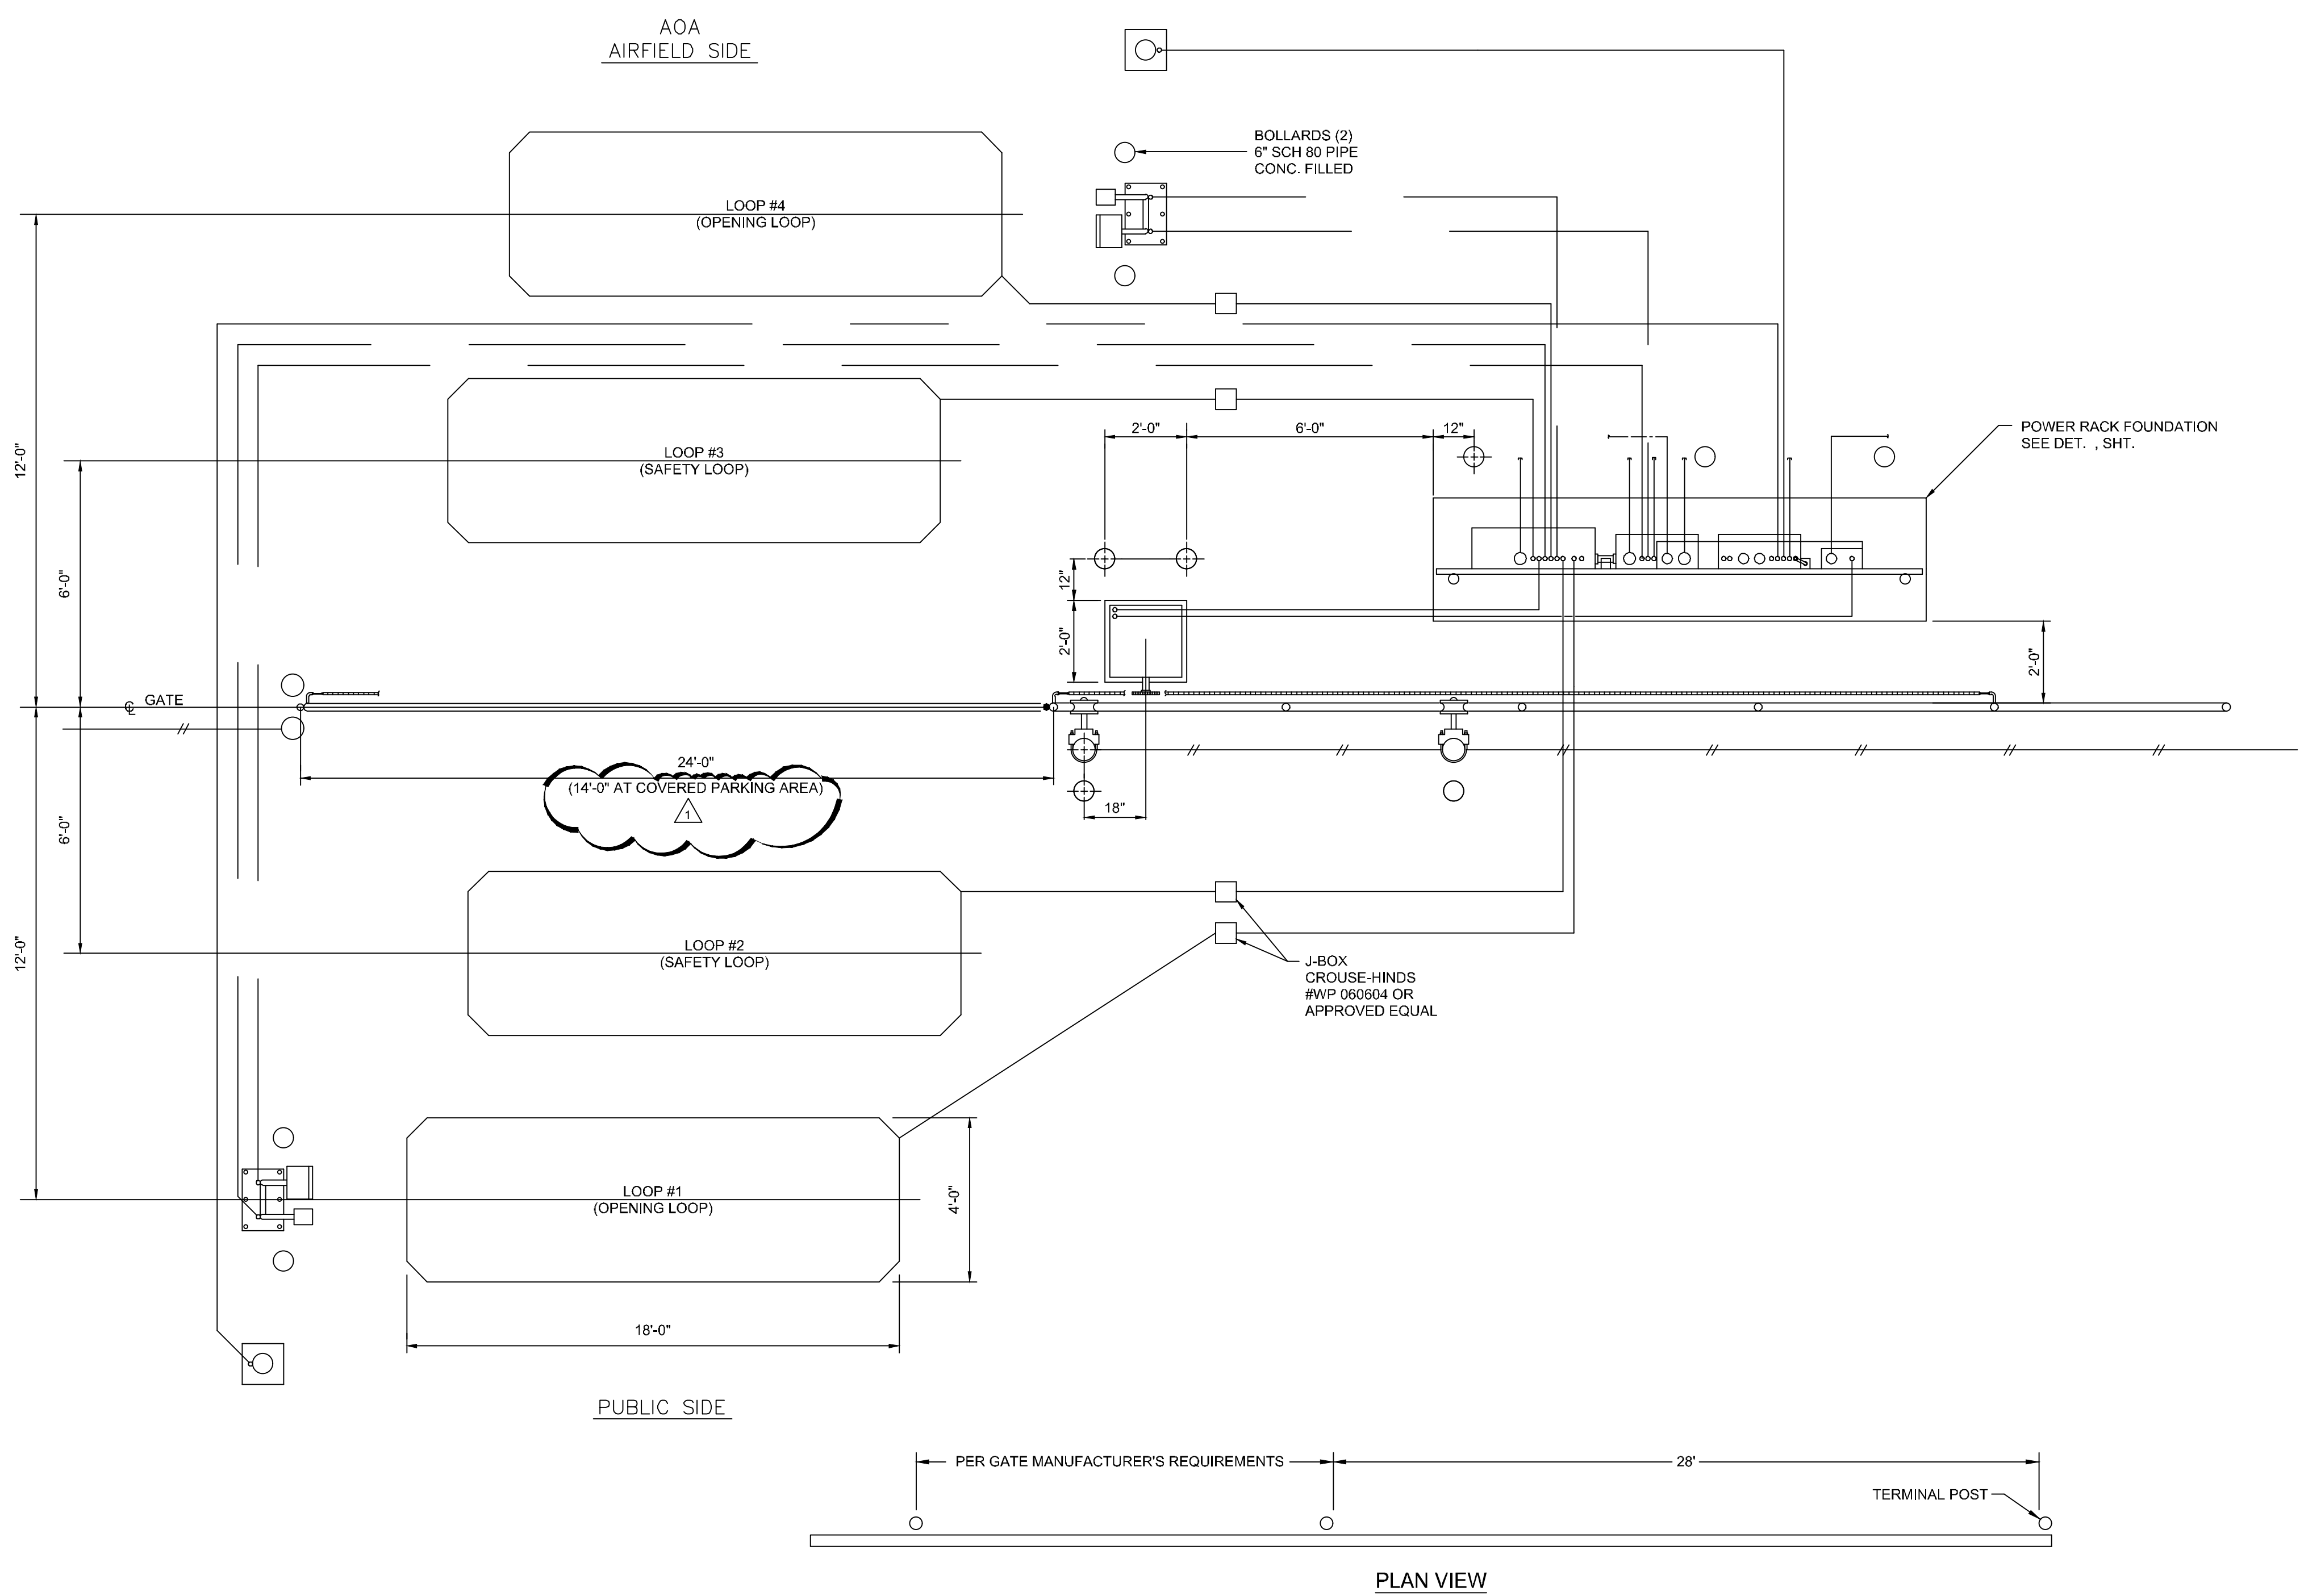

1 PLAN VIEW
 NO SCALE
 EXIT LOOP SAFETY SENSOR & SLIDING GATE

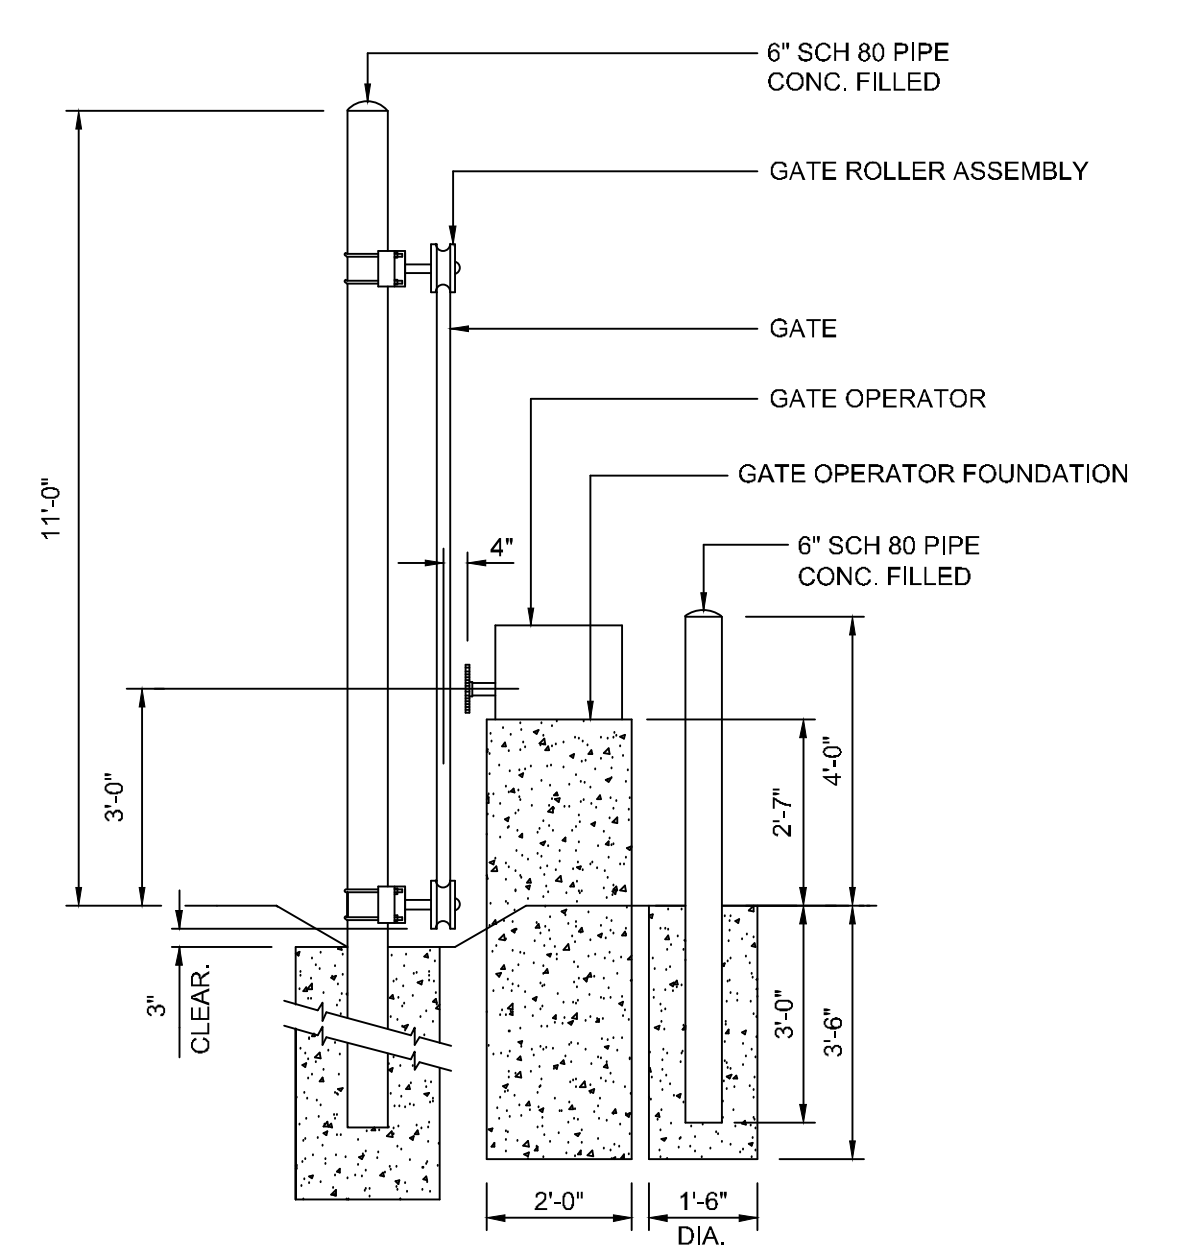

2 DETAIL
 NO SCALE
 CANTILEVER SLIDE GATE DETAIL

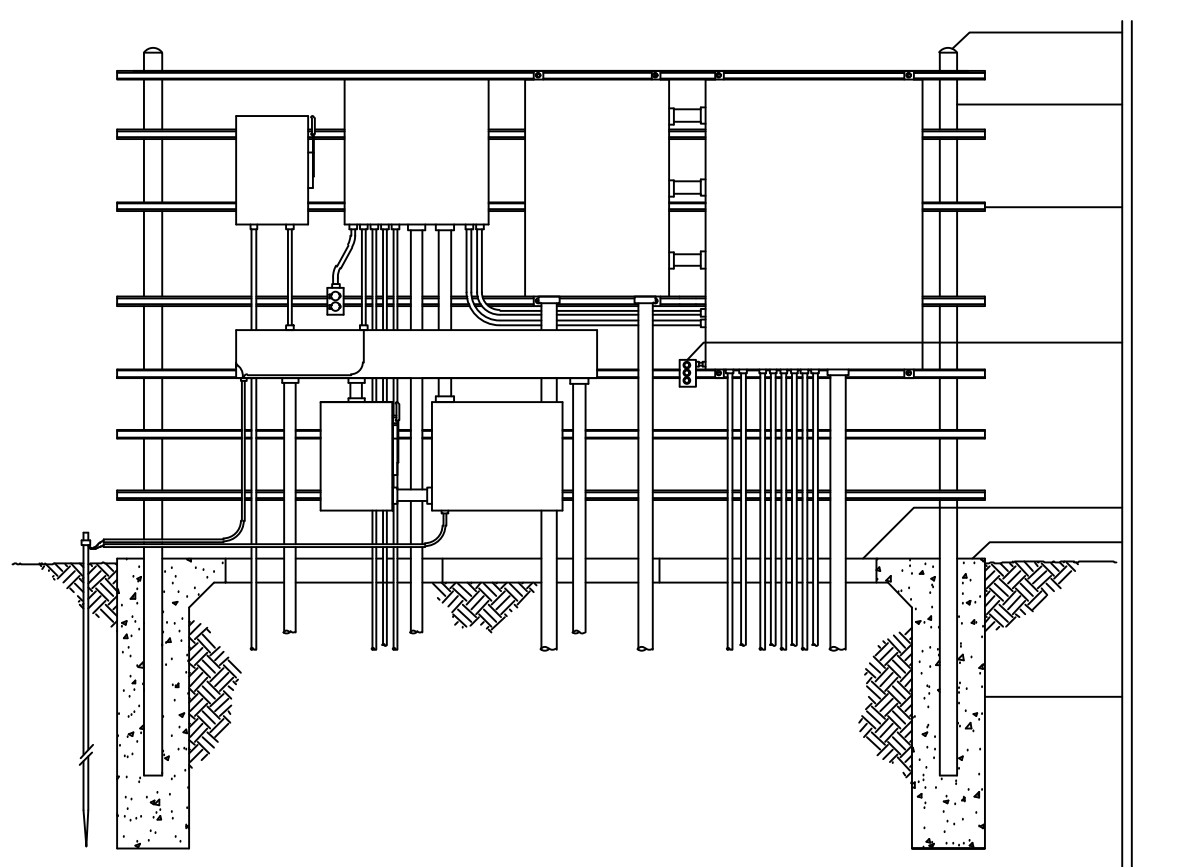


3 DETAIL
 NO SCALE
 POWER RACK FOUNDATION DETAIL
 (SEE MEP FOR ELECTRICAL EQUIPMENT)

No.	REVISIONS	DATE	BY

Kimley»Horn

© 2019 KIMLEY-HORN AND ASSOCIATES, INC.
 TBPE FIRM REGISTRATION F-928
 WWW.KIMLEY-HORN.COM

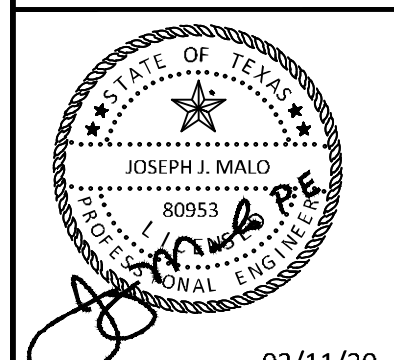

KHA PROJECT	067792503
DATE	12/11/2019
SCALE	AS SHOWN
DESIGNED BY	HCV
DRAWN BY	EC EAC
CHECKED BY	HCV

FENCE DETAILS

ADDISON GALAXY FBO
 15601 ADDISON RD.
 PREPARED FOR
BLACK FOREST VENTURE

ADDISON DALLAS, TEXAS

SHEET NUMBER
C17.04