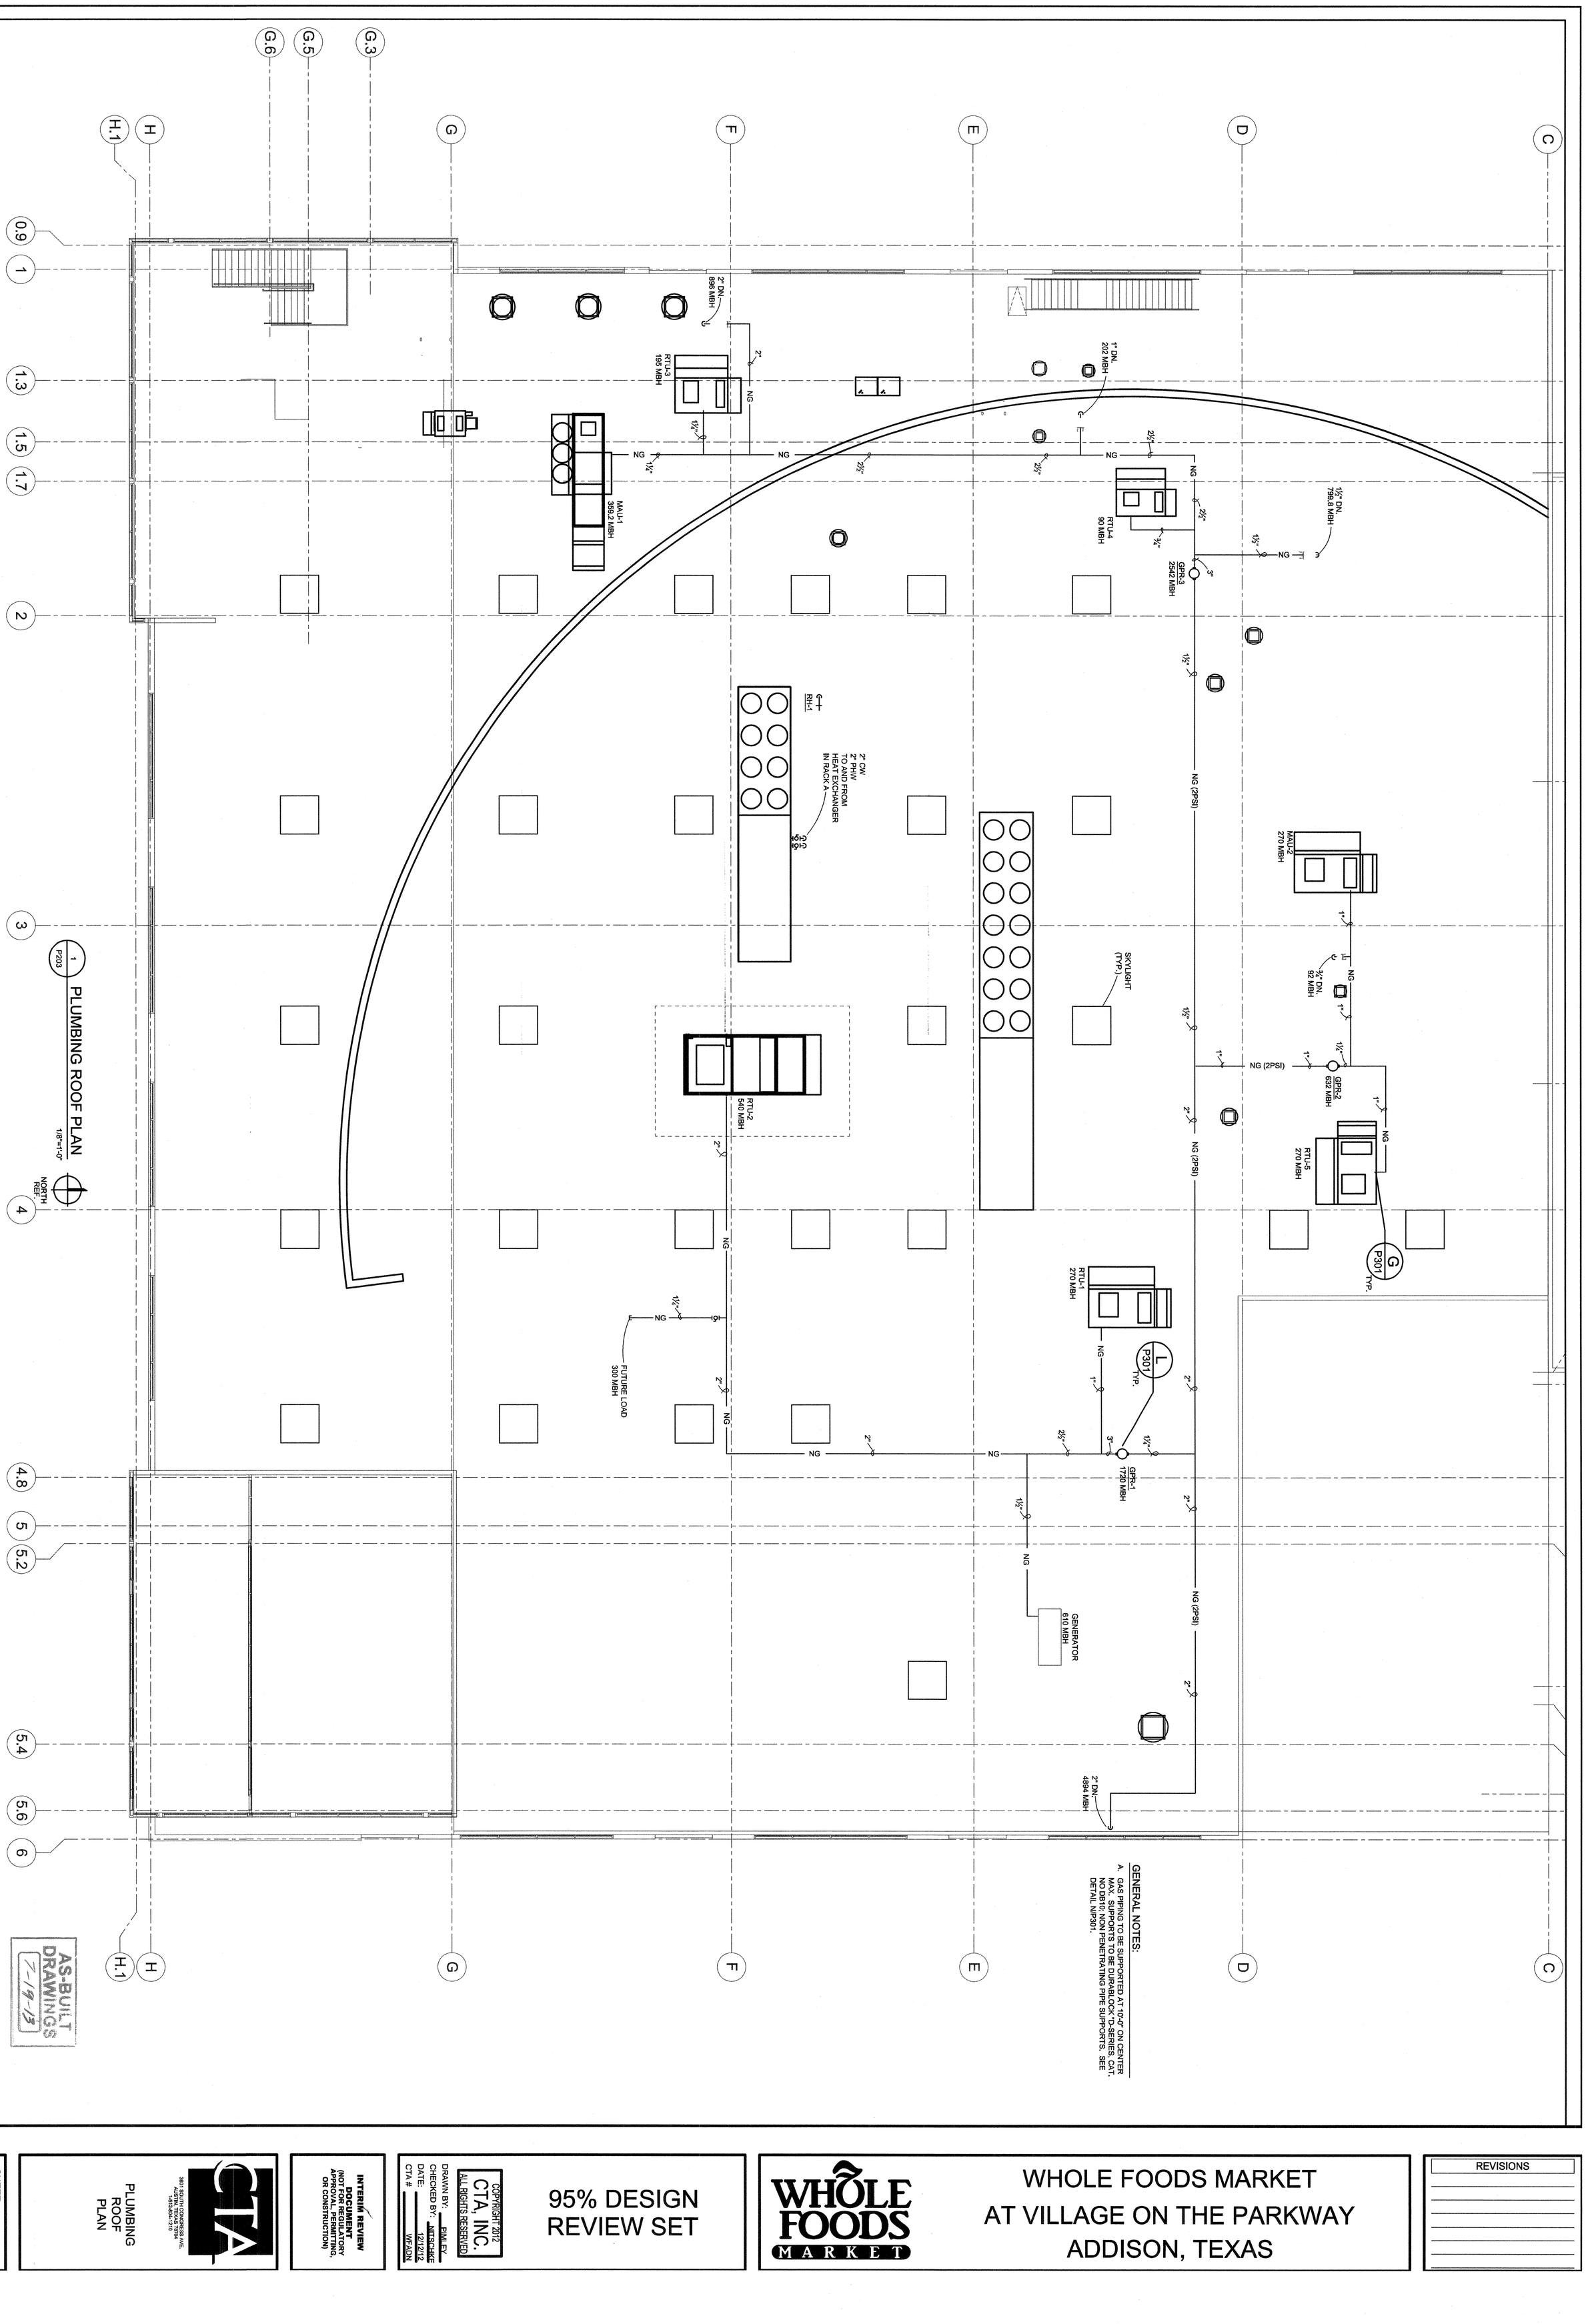

GENERAL NOTES:

A. GAS PIPING TO BE SUPPORTED AT 10'-0" ON CENTER MAX. SUPPORTS TO BE DURABLOCK 'D-SERIES, CAT. NO DB10; NON PENETRATING PIPE SUPPORTS. SEE DETAIL N/P301.

AS-BUILT DRAWINGS 7-19-13

INTERIM REVIEW DOCUMENT (NOT FOR REGULATORY APPROVAL, PERMITTING, OR CONSTRUCTION)

95% DESIGN REVIEW SET

COPYRIGHT 2012 CTA, INC. ALL RIGHTS RESERVED

DRAWN BY: PIM/LFY
CHECKED BY: MTS/CHKE
DATE: 12/12/12
CTA # WFADN

CTA
3809 SOUTH CONGRESS AVE.
AUSTIN, TEXAS 78704
1-512-834-1210

PLUMBING ROOF PLAN

SHEET P203

WHOLE FOODS MARKET
AT VILLAGE ON THE PARKWAY
ADDISON, TEXAS

REVISIONS