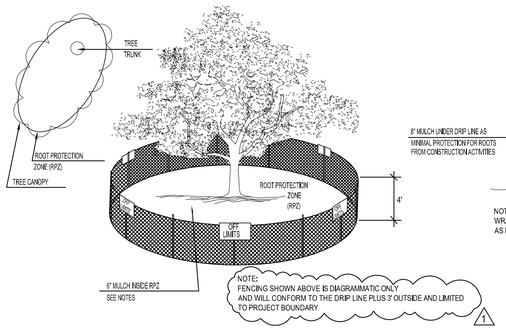

01 TREE PROTECTION FENCE A
NOT TO SCALE

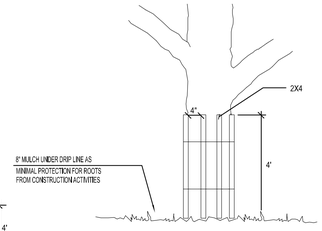

02 TREE PROTECTION FENCE B
NOT TO SCALE

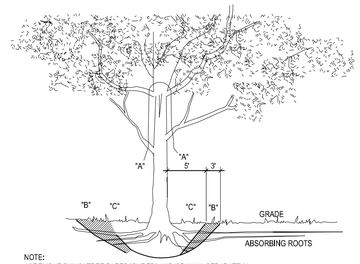

03 TREE REMOVAL DIAGRAM
NOT TO SCALE

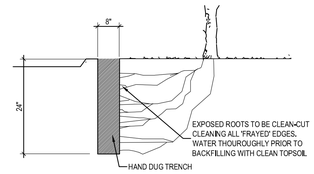

04 ROOT PRUNING DETAIL
N.T.S.

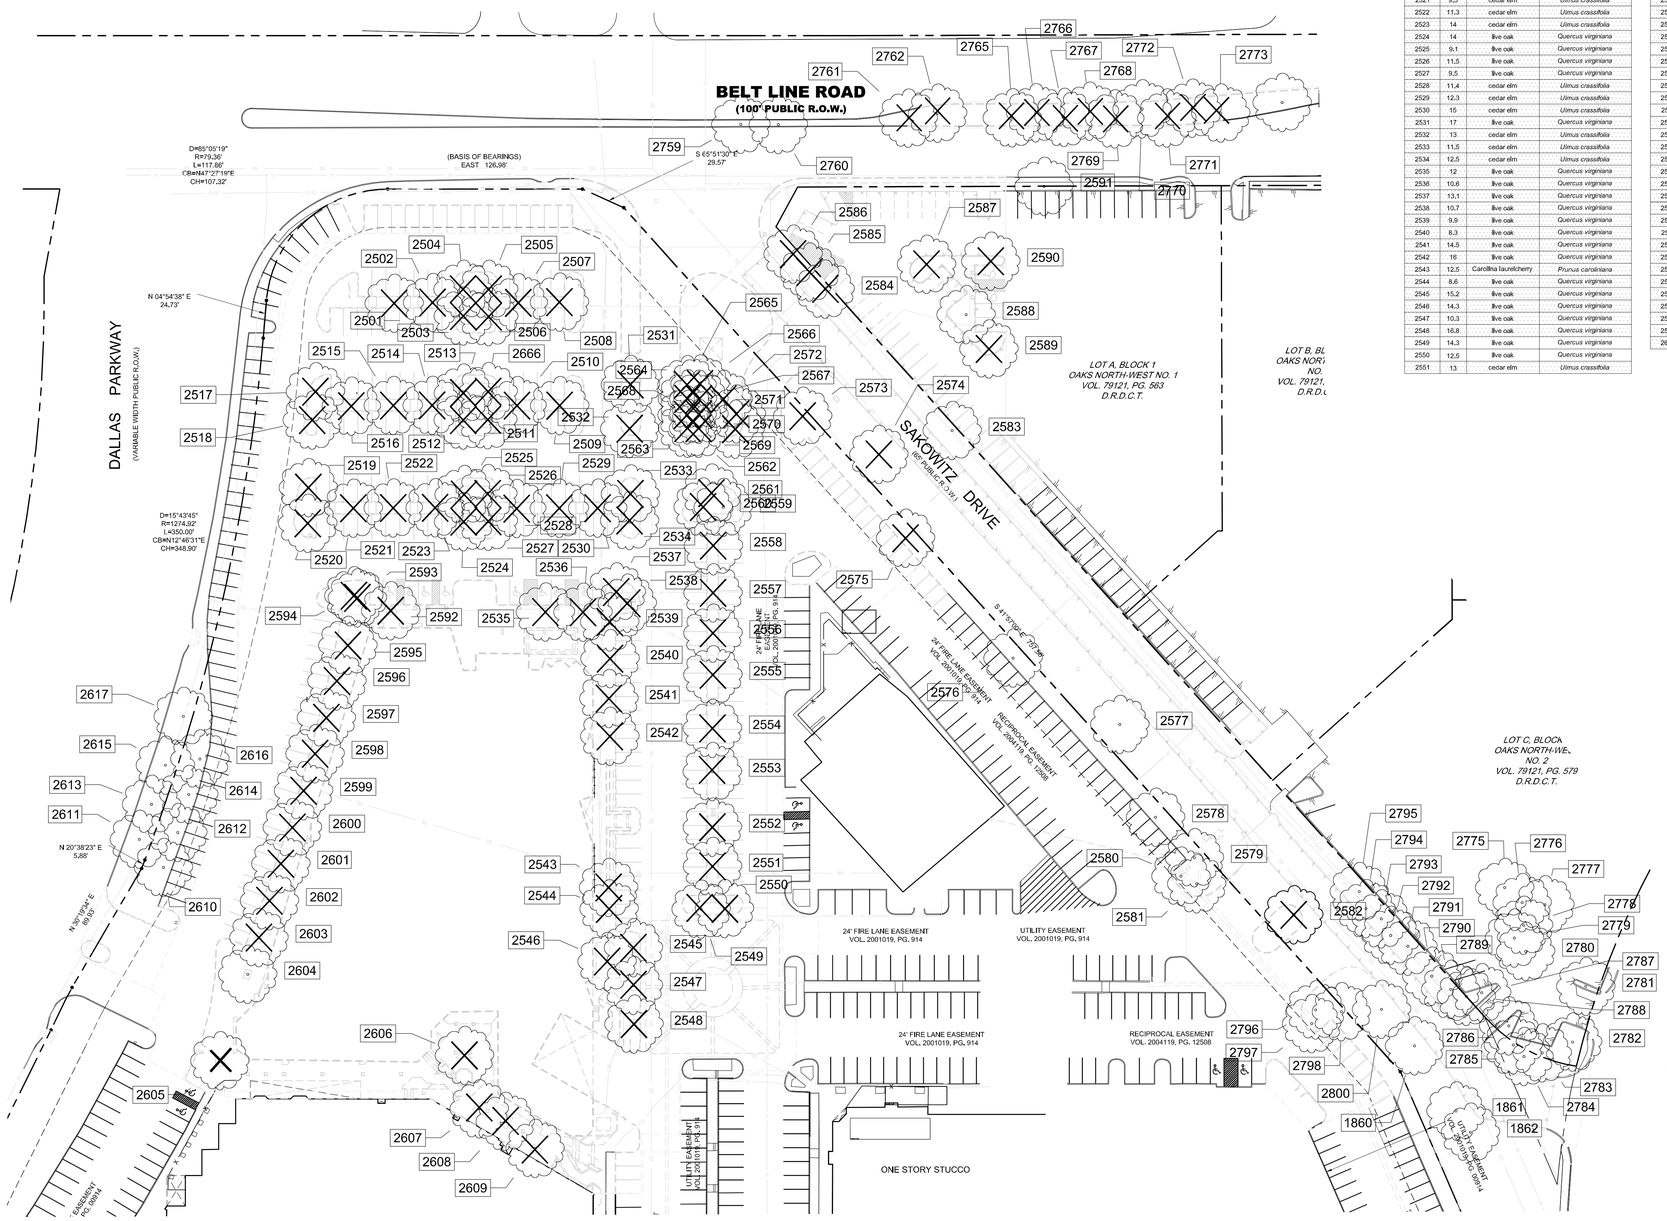

TAG#	DBH	COMMON NAME	SPECIES
2501	14.5	cedar elm	*Ulmus crassifolia*
2502	12.7	cedar elm	*Ulmus crassifolia*
2503	12.7	live oak	*Quercus virginiana*
2504	11.5	live oak	*Quercus virginiana*
2505	13.9	live oak	*Quercus virginiana*
2506	10.1	live oak	*Quercus virginiana*
2507	12.9	cedar elm	*Ulmus crassifolia*
2508	11.8	cedar elm	*Ulmus crassifolia*
2509	13.7	cedar elm	*Ulmus crassifolia*
2510	14	cedar elm	*Ulmus crassifolia*
2511	12.2	live oak	*Quercus virginiana*
2512	13	live oak	*Quercus virginiana*
2513	12.3	live oak	*Quercus virginiana*
2514	11.2	cedar elm	*Ulmus crassifolia*
2515	14.9	cedar elm	*Ulmus crassifolia*
2516	13.3	cedar elm	*Ulmus crassifolia*
2517	13.8	cedar elm	*Ulmus crassifolia*
2518	11.7	cedar elm	*Ulmus crassifolia*
2519	12.7	cedar elm	*Ulmus crassifolia*
2520	12.4	cedar elm	*Ulmus crassifolia*
2521	9.5	cedar elm	*Ulmus crassifolia*
2522	11.3	cedar elm	*Ulmus crassifolia*
2523	14	cedar elm	*Ulmus crassifolia*
2524	14	live oak	*Quercus virginiana*
2525	9.1	live oak	*Quercus virginiana*
2526	11.5	live oak	*Quercus virginiana*
2527	9.5	live oak	*Quercus virginiana*
2528	11.4	cedar elm	*Ulmus crassifolia*
2529	12.3	cedar elm	*Ulmus crassifolia*
2530	15	cedar elm	*Ulmus crassifolia*
2531	17	live oak	*Quercus virginiana*
2532	13	cedar elm	*Ulmus crassifolia*
2533	11.5	cedar elm	*Ulmus crassifolia*
2534	12.5	cedar elm	*Ulmus crassifolia*
2535	12	live oak	*Quercus virginiana*
2536	10.6	live oak	*Quercus virginiana*
2537	13.1	live oak	*Quercus virginiana*
2538	10.7	live oak	*Quercus virginiana*
2539	9.9	live oak	*Quercus virginiana*
2540	8.3	live oak	*Quercus virginiana*
2541	14.5	live oak	*Quercus virginiana*
2542	16	live oak	*Quercus virginiana*
2543	12.5	Carolina laurelcherry	*Prunus caroliniana*
2544	8.6	live oak	*Quercus virginiana*
2545	15.2	live oak	*Quercus virginiana*
2546	14.3	live oak	*Quercus virginiana*
2547	10.3	live oak	*Quercus virginiana*
2548	16.8	live oak	*Quercus virginiana*
2549	14.3	live oak	*Quercus virginiana*
2550	12.5	live oak	*Quercus virginiana*
2551	13	cedar elm	*Ulmus crassifolia*

TAG#	DBH	COMMON NAME	SPECIES
2552	11.5	cedar elm	*Ulmus crassifolia*
2553	12.5	cedar elm	*Ulmus crassifolia*
2554	11.6	cedar elm	*Ulmus crassifolia*
2555	11.9	cedar elm	*Ulmus crassifolia*
2556	13.6	cedar elm	*Ulmus crassifolia*
2557	13.5	cedar elm	*Ulmus crassifolia*
2558	12	cedar elm	*Ulmus crassifolia*
2559	16	live oak	*Quercus virginiana*
2560	17	live oak	*Quercus virginiana*
2561	12.5	live oak	*Quercus virginiana*
2562	4	redcedar	*Juniperus sp.*
2563	4	redcedar	*Juniperus sp.*
2564	4	redcedar	*Juniperus sp.*
2565	4	redcedar	*Juniperus sp.*
2566	3	redcedar	*Juniperus sp.*
2567	3	redcedar	*Juniperus sp.*
2568	5	redcedar	*Juniperus sp.*
2569	6	redcedar	*Juniperus sp.*
2570	3	redcedar	*Juniperus sp.*
2571	3	redcedar	*Juniperus sp.*
2572	3	redcedar	*Juniperus sp.*
2573	23	live oak	*Quercus virginiana*
2574	18	cedar elm	*Ulmus crassifolia*
2575	16.5	live oak	*Quercus virginiana*
2576	21.8	live oak	*Quercus virginiana*
2577	14.3	cedar elm	*Ulmus crassifolia*
2578	25.5	live oak	*Quercus virginiana*
2579	17.5	live oak	*Quercus virginiana*
2580	20	live oak	*Quercus virginiana*
2581	12.4	live oak	*Quercus virginiana*
2582	14.5	cedar elm	*Ulmus crassifolia*
2583	16.8	live oak	*Quercus virginiana*
2584	14.7	live oak	*Quercus virginiana*
2585	10	live oak	*Quercus virginiana*
2586	14.1	live oak	*Quercus virginiana*
2587	15	cedar elm	*Ulmus crassifolia*
2588	17.7	live oak	*Quercus virginiana*
2589	27.5	live oak	*Quercus virginiana*
2590	13.2	cedar elm	*Ulmus crassifolia*
2591	15	live oak	*Quercus virginiana*
2592	11.4	live oak	*Quercus virginiana*
2593	14	live oak	*Quercus virginiana*
2594	8.2	live oak	*Quercus virginiana*
2595	8.8	live oak	*Quercus virginiana*
2596	8.5	live oak	*Quercus virginiana*
2597	7.8	live oak	*Quercus virginiana*
2598	15.5	live oak	*Quercus virginiana*
2599	10.6	live oak	*Quercus virginiana*
2600	12	live oak	*Quercus virginiana*

TAG#	DBH	COMMON NAME	
2601	8.7	live oak	*Quercus virginiana*
2602	9.5	live oak	*Quercus virginiana*
2603	12.5	live oak	*Quercus virginiana*
2604	18.2	live oak	*Quercus virginiana*
2605	12.3	sweetgum	*Liquidambar styraciflua*
2606	12.5	live oak	*Quercus virginiana*
2607	13.2	live oak	*Quercus virginiana*
2608	10.2	sweetgum	*Liquidambar styraciflua*
2609	8	yaupon	*Ilex vomitoria*
2610	21	live oak	*Quercus virginiana*
2611	16.6	live oak	*Quercus virginiana*
2612	18.2	live oak	*Quercus virginiana*
2613	19.6	live oak	*Quercus virginiana*
2614	13.5	live oak	*Quercus virginiana*
2615	18	live oak	*Quercus virginiana*
2616	16.7	live oak	*Quercus virginiana*
2617	12.7	live oak	*Quercus virginiana*
2618	9.3	sweetgum	*Liquidambar styraciflua*
2619	11.5	sweetgum	*Liquidambar styraciflua*
2620	12.4	sweetgum	*Liquidambar styraciflua*
2621	9.2	live oak	*Quercus virginiana*
2622	7.7	cedar elm	*Ulmus crassifolia*
2623	8.6	cedar elm	*Ulmus crassifolia*
2624	6.2	cedar elm	*Ulmus crassifolia*
2625	7.8	cedar elm	*Ulmus crassifolia*
2626	7.2	cedar elm	*Ulmus crassifolia*
2627	6.3	cedar elm	*Ulmus crassifolia*
2628	9	cedar elm	*Ulmus crassifolia*
2629	9	cedar elm	*Ulmus crassifolia*
2630	13.3	live oak	*Quercus virginiana*
2631	6.9	live oak	*Quercus virginiana*
TAG#	**DBH**	**COMMON NAME**	
2632	9.3	sweetgum	*Liquidambar styraciflua*
2633	10	sweetgum	*Liquidambar styraciflua*
2634	8.6	sweetgum	*Liquidambar styraciflua*
2635	7.5	sweetgum	*Liquidambar styraciflua*
2636	8.5	sweetgum	*Liquidambar styraciflua*
2637	12	live oak	*Quercus virginiana*
2638	12.5	live oak	*Quercus virginiana*
2639	11.4	cedar elm	*Ulmus crassifolia*
2640	9	cedar elm	*Ulmus crassifolia*
2641	7.2	cedar elm	*Ulmus crassifolia*
2642	8.8	cedar elm	*Ulmus crassifolia*
2643	9.1	cedar elm	*Ulmus crassifolia*
2644	9.5	cedar elm	*Ulmus crassifolia*
2645	7.6	cedar elm	*Ulmus crassifolia*
2646	13.3	live oak	*Quercus virginiana*
2647	12.2	live oak	*Quercus virginiana*
2648	11.6	live oak	*Quercus virginiana*
2649	15.3	live oak	*Quercus virginiana*
2650	12.6	live oak	*Quercus virginiana*
2651	13.5	live oak	*Quercus virginiana*
2652	14.7	live oak	*Quercus virginiana*
2653	7.8	live oak	*Quercus virginiana*
2654	12.8	live oak	*Quercus virginiana*
2655	10	live oak	*Quercus virginiana*
2656	11.6	live oak	*Quercus virginiana*
2657	6.7	live oak	*Quercus virginiana*
2658	8	live oak	*Quercus virginiana*
2659	15.2	live oak	*Quercus virginiana*
2660	18.2	live oak	*Quercus virginiana*
2661	13	live oak	*Quercus virginiana*
2662	14.5	live oak	*Quercus virginiana*
2663	17.8	live oak	*Quercus virginiana*
2664	6.2	yaupon	*Ilex vomitoria*
2665	18	live oak	*Quercus virginiana*
2666	10	live oak	*Quercus virginiana*

EXISTING TREE NOTES

1. Existing trees to remain shall be protected during construction from tree structure damage and compaction of soil under and around dripline (canopy) of tree.
2. If any root structure is damaged during adjacent excavation/construction, notify the Architect immediately. It is recommended that a licensed Arborist be secured for the treatment of any possible tree wounds.
3. No disturbance of the soil greater than 4" shall be located closer to the tree trunk than 1/2 the distance of the drip line to the tree trunk. A minimum of 75% of the drip line and root zone shall be preserved at natural grade.
4. Any fine grading done within the critical root zones of the protected trees must be done with light machinery such as a bobcat or light tractor. No earth moving equipment with tracks is allowed within the critical root zone of the trees.
5. Material Storage: No materials intended for use in construction or waste materials accumulated due to excavation or demolition shall be placed within the limits of the dripline of any tree.
6. Equipment Cleaning/Liquid Disposal: No equipment may be cleaned, toxic solutions, or other liquid chemicals shall be deposited within the limits of the dripline of a tree. This would include but not be limited to paint, oil, solvents, asphalt, concrete, mortar, primers, etc.
7. Tree Attachments: No signs, wires or other attachments, other than those of a protective nature shall be attached to any tree.
8. Vehicular Traffic: No vehicular and construction equipment traffic or parking is allowed within the limits of the dripline of trees.
9. Boring of Utilities: May be permitted under protected trees in certain circumstances. The minimum length of the bore shall be the width of the tree's canopy and shall be a minimum depth of forty-eight (48") inches.
10. Trenching: Any irrigation trenching which must be done within the critical root zone of a tree shall be dug by hand and enter the area in a radial manner.
11. Tree Flagging: All trees to be removed from the site shall be flagged by the Contractor with bright red vinyl tape (3" width) wrapped around the main trunk at a height of four (4) feet above grade. Flagging shall be approved by Landscape Architect prior to any tree removal. Contractor shall contact Landscape Architect with 72 hour notice to schedule on-site meeting.
12. Protective Fencing: All trees to remain, as noted on drawings, shall have protective fencing located at the tree's dripline. The protective fencing to be chain link fence with a four (4) foot approximate height. The protective fencing will be located as indicated on the Tree Protection Detail(s). 1
13. Bark Protection: In situations where a tree remains in the immediate area of intended construction, the tree shall be protected by enclosing the entire circumference of the tree's trunk with lumber encircled with wire or other means that does not damage the tree. Refer to Tree Protection Detail(s).
14. Construction Pruning: In a case where a low hanging limb is broken during the course of construction, the Contractor shall notify the Landscape Architect immediately. In no instance shall the Contractor prune any portion of the damaged tree without the prior approval by the Landscape Architect.

EXISTING TREE PRUNING NOTES

1. Contractor shall provide a Class 'B' pruning on all existing trees.
2. This shall include at a minimum: removal of dead, dying, diseased weak branches,along main trunk structure and within branching area.
3. Contractor shall include deep root feeding and invigoration of existing trees. This shall be organic based nutrients based for root growth and leaf growth stimulation.
4. Contractor shall be required to chip all removed branches, leafs, etc.

EXISTING TREE LEGEND

EXISTING TREE TO REMAIN

EXISTING TREE TO BE REMOVED

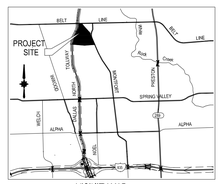

VICINITY MAP
(NOT TO SCALE)

RECORD DRAWINGS (October 2013)
Information Provided By:
BOB MOORE CONSTRUCTION

01 EXISTING TREE PLAN
SCALE: 1" = 40'-0"

0 20 40 80

CALL BEFORE YOU DIG! 1-800-245-4545 TEXAS ONE CALL SYSTEM

Good Fulton & Farrell Architects
2808 Fairmount Street
Suite 300
Dallas, Texas 75201
214.303.1500/Tel
214.303.1512/Fax
www.gff.com

© Good Fulton & Farrell 2009

smr
landscape architects, inc.
1708 N. Griffin Street
Dallas, Texas 75202
Tel 214.871.0383
Fax 214.871.0545
Email smr@smr4a.com

VILLAGE ON THE PARKWAY

5100 BELT LINE ROAD
Addison, Texas 75254

No.	Date	Item
1	09.21.12	CITY COMMENTS

REVISIONS

BDA Drawn
BDA Checked
BDA Approved

REGISTERED LANDSCAPE ARCHITECT BRIAN D. ADAMS STATE OF TEXAS
09.21.12

EXISTING TREE PLAN

Project No.	11013.03
Date	05.25.12
Last Revision	

L1.00